




F 132+00

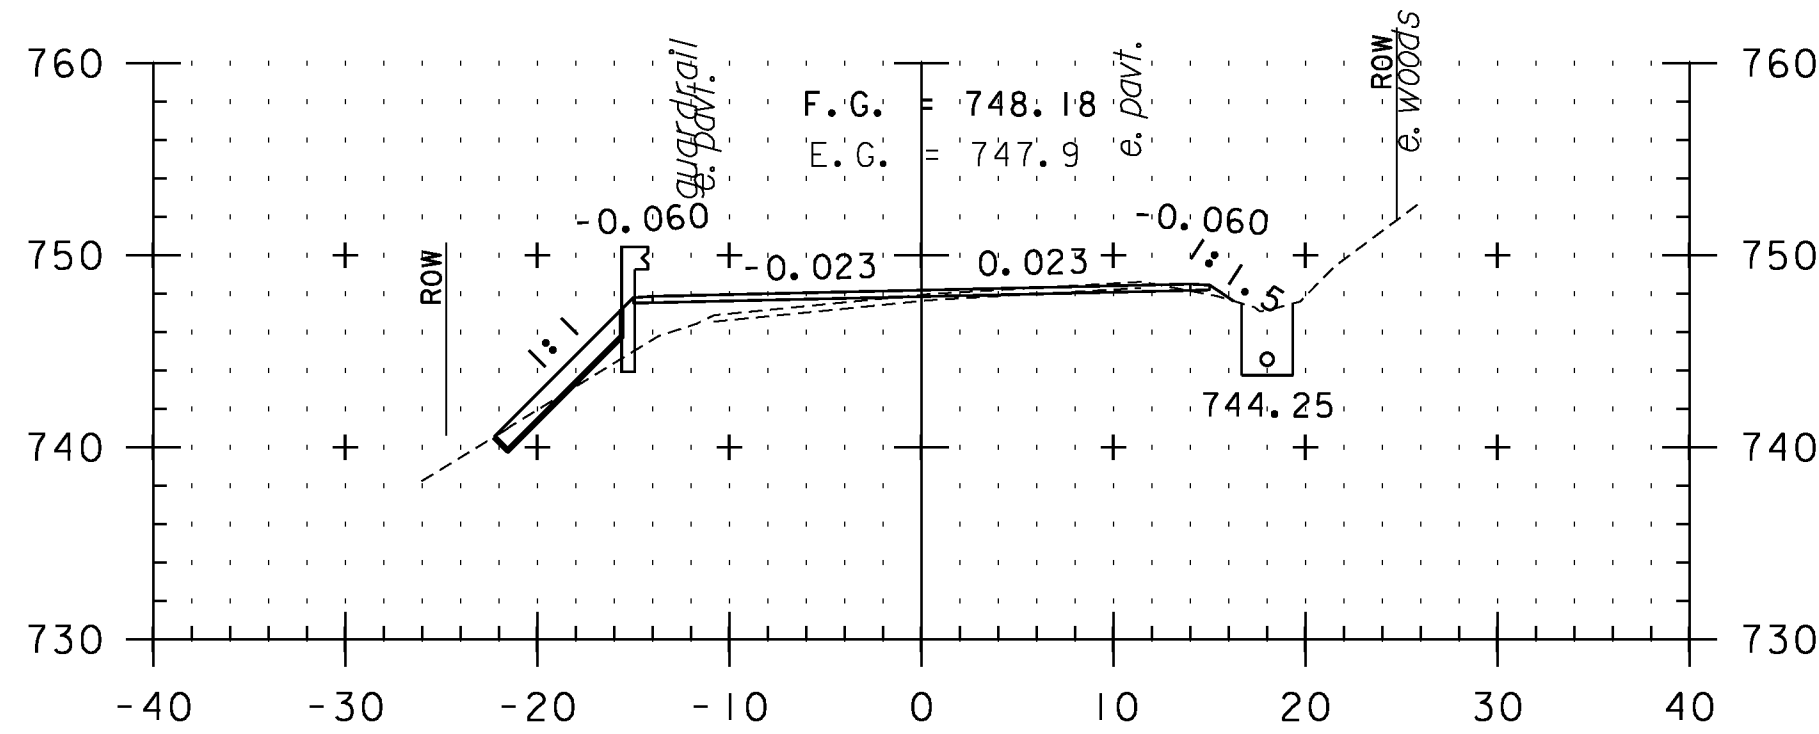


F 133+50

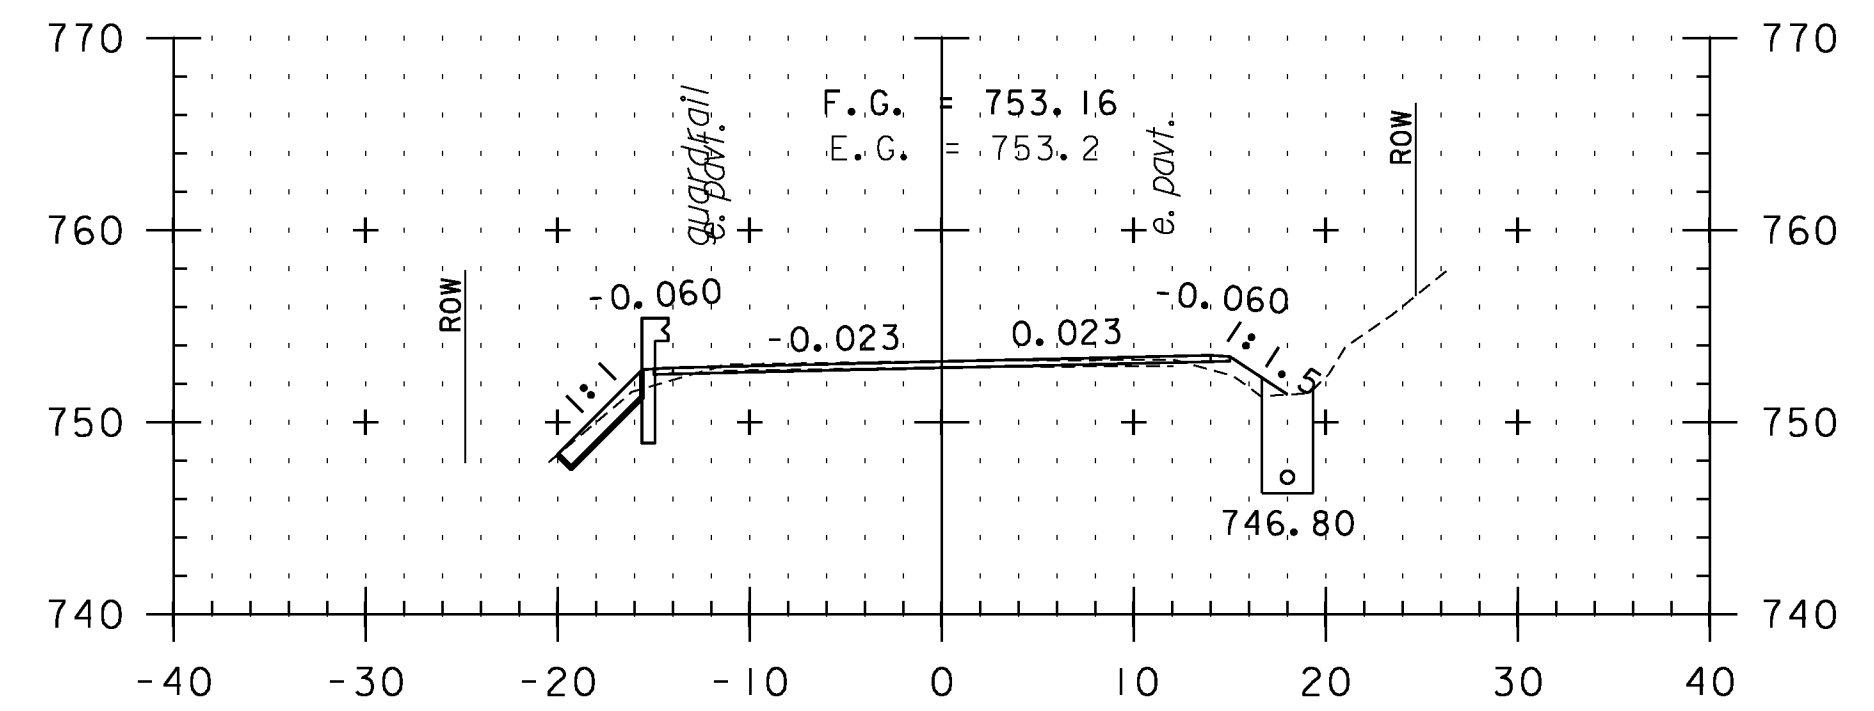


F 135+00

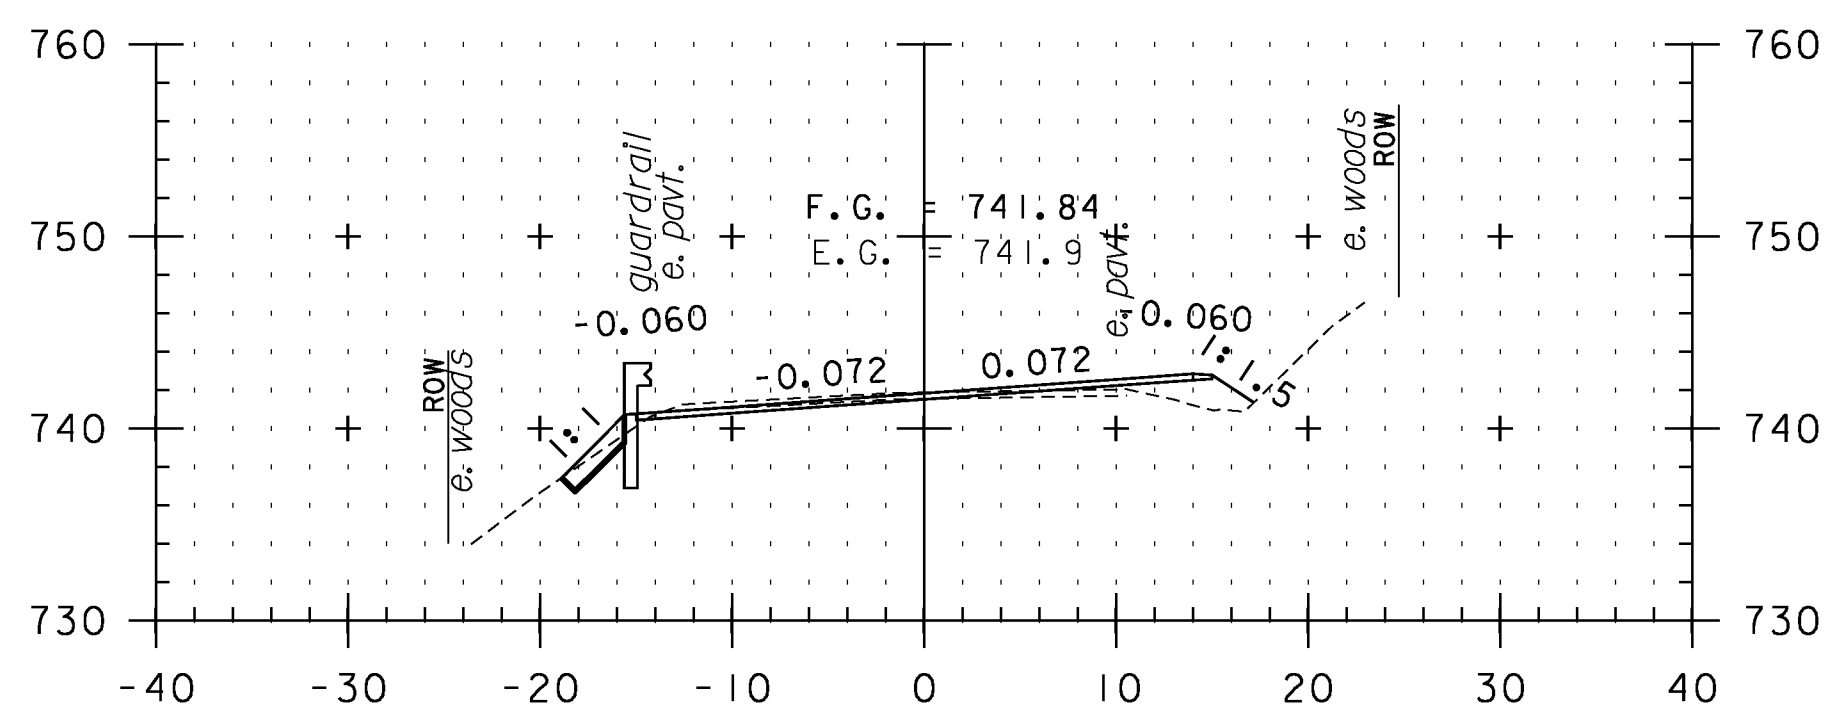


F 131+50

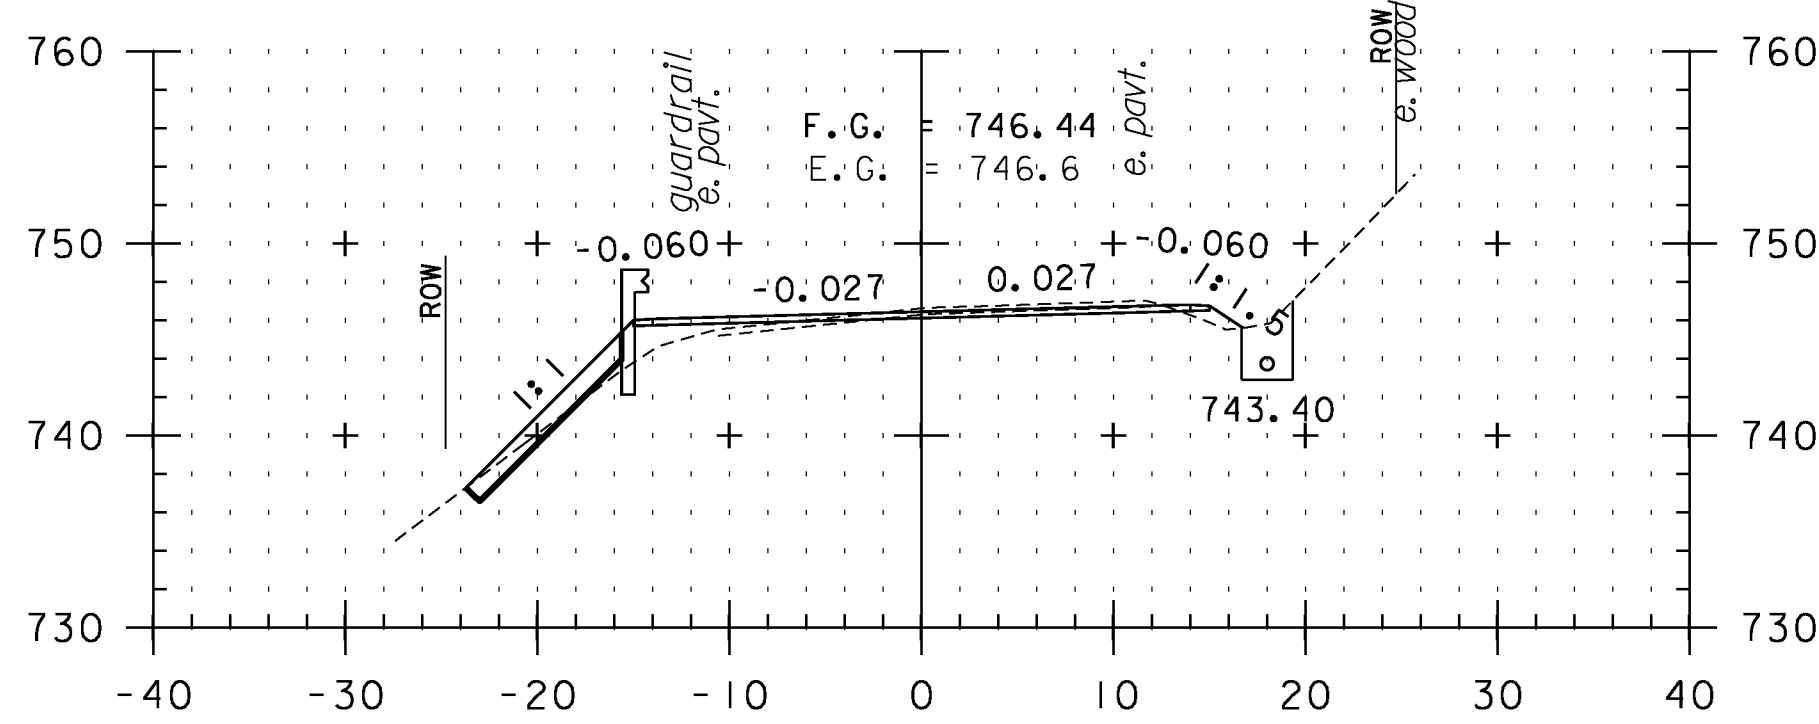


F 133+00

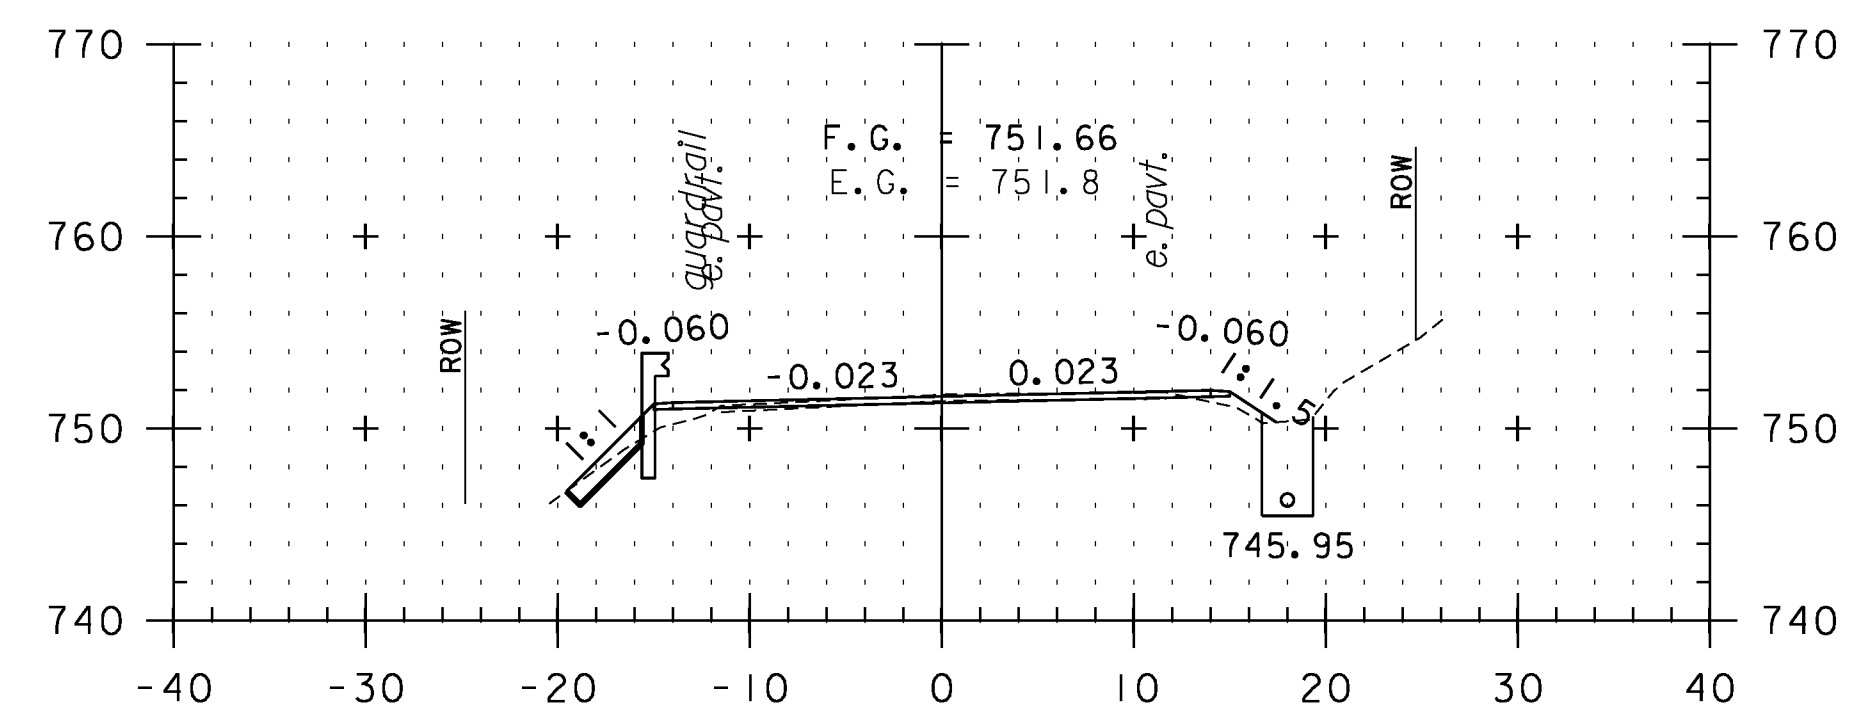


F 134+50

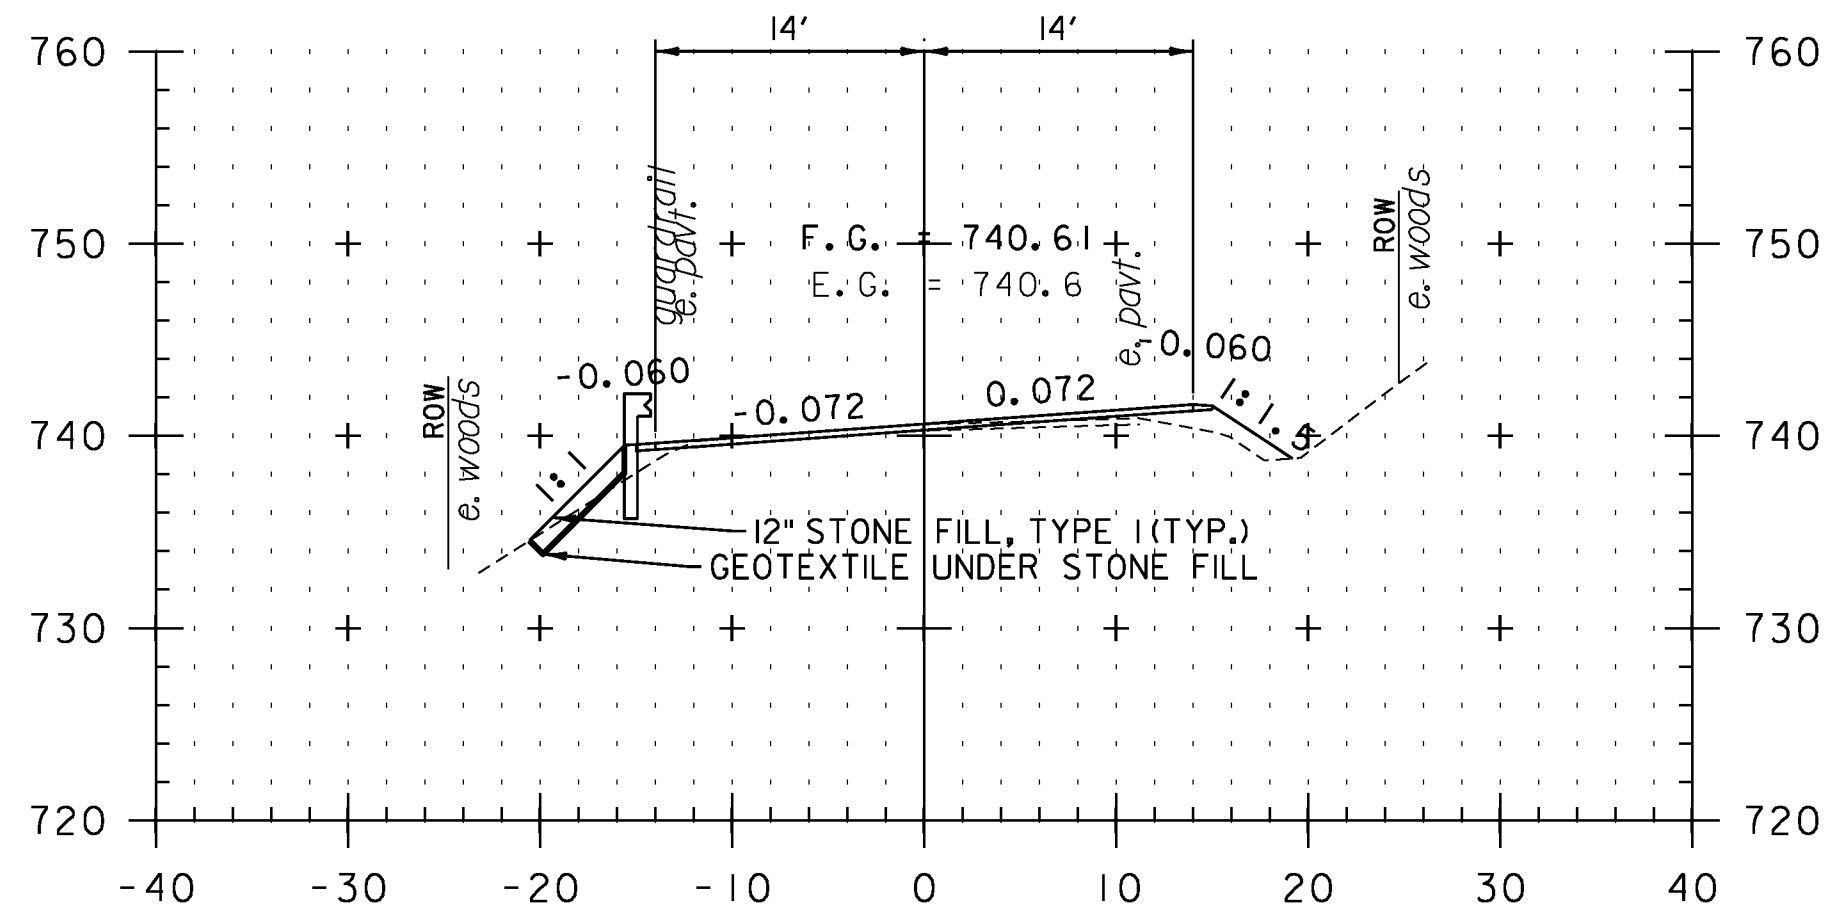

F 131+00

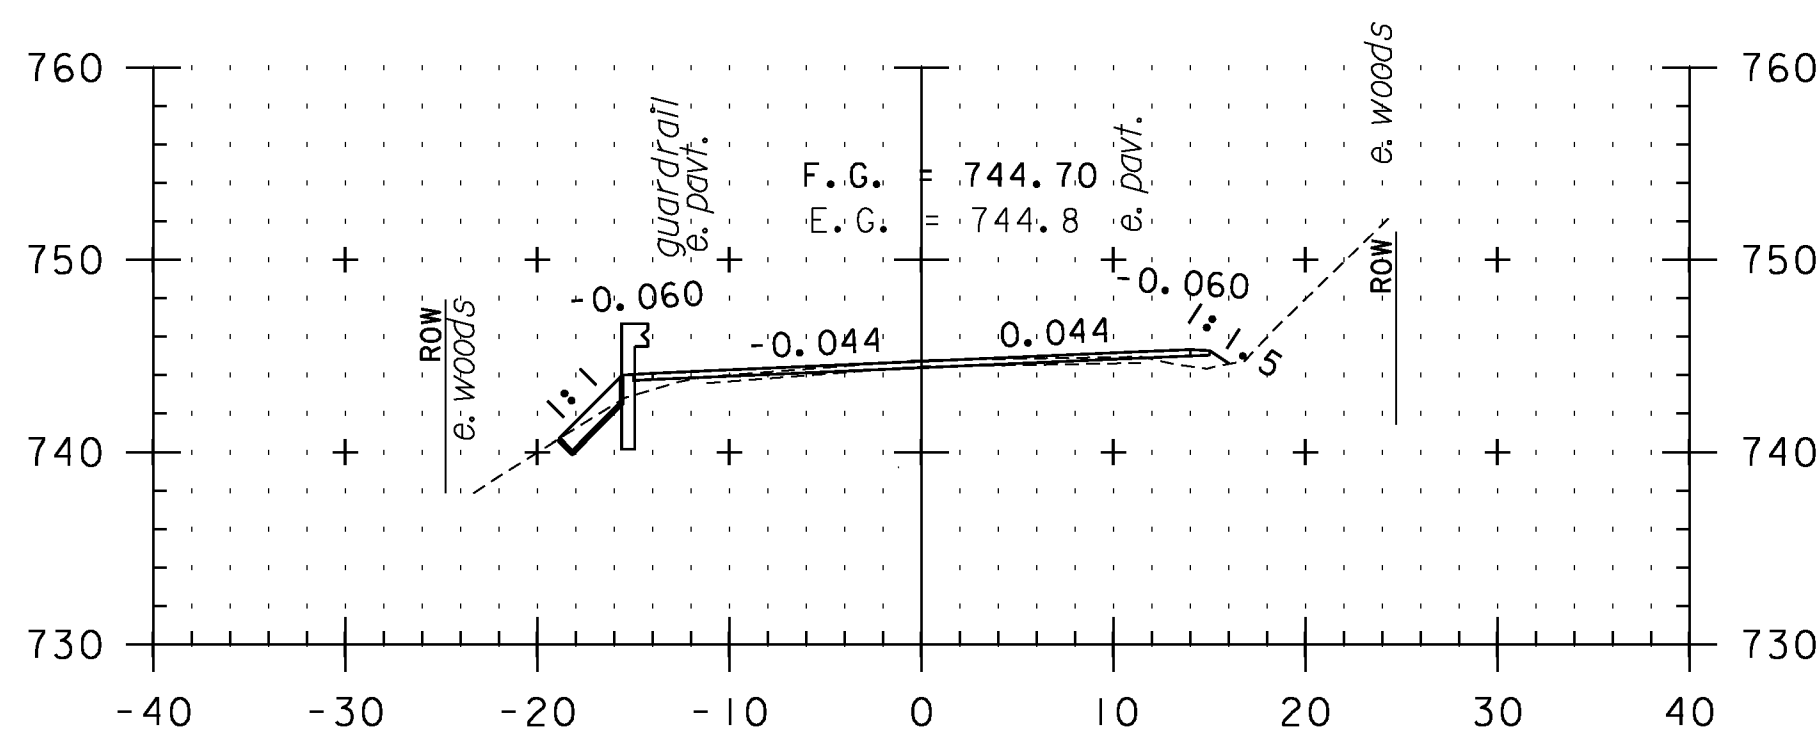


F 132+50

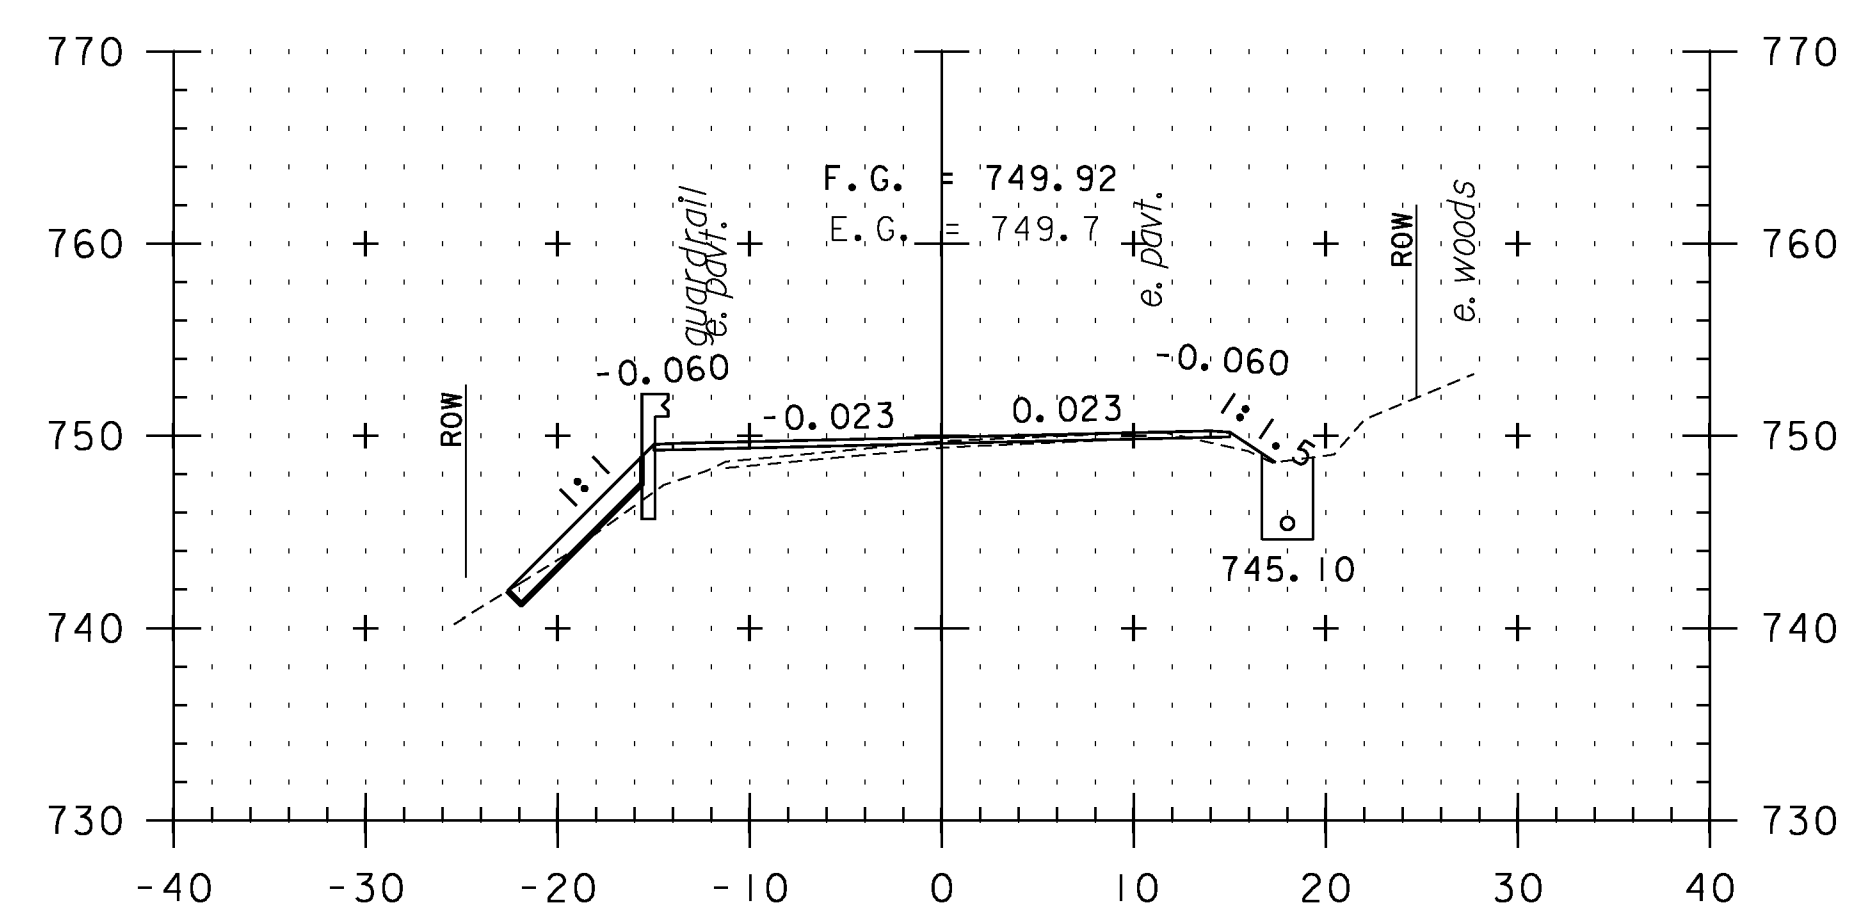

F 134+00

CROSS SECTION SHEET 83

STA. F131+00 TO STA. F135+00

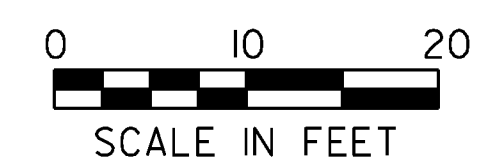

PROJECT NAME: VERSHIRE-THETFORD	PLOT DATE: 1/29/2013
PROJECT NUMBER: STP 2911(I)	DRAWN BY: SNG
FILE NAME: pl0c224.dgn	CHECKED BY: PTS
PROJECT LEADER: PTS	SHEET 191 OF 232
DESIGNED BY: NULL	
IPARM FILE NAME: IOC224_I91	