




F 136+50

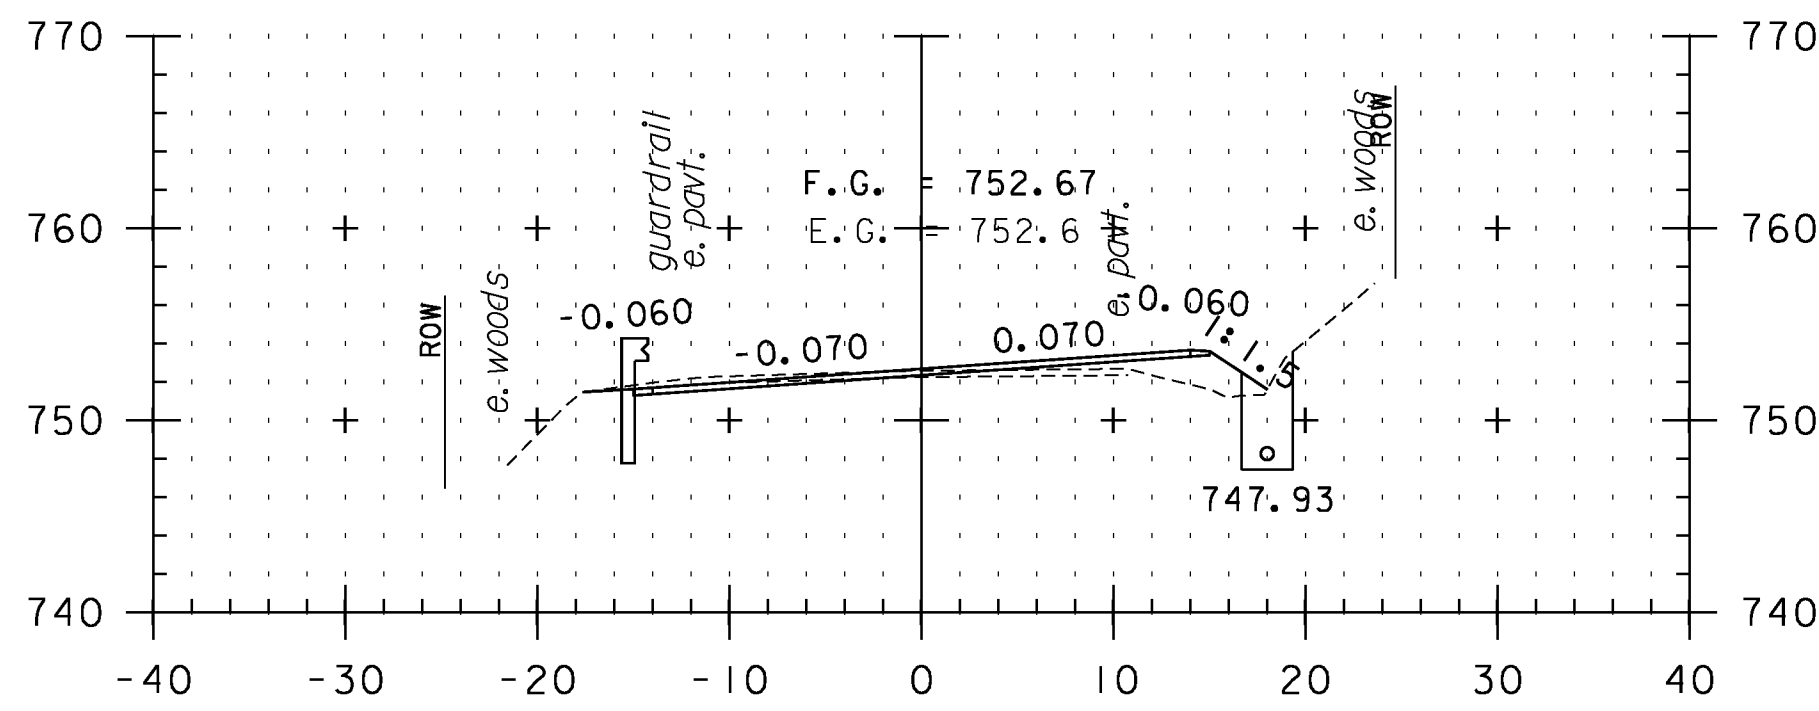


F 138+00

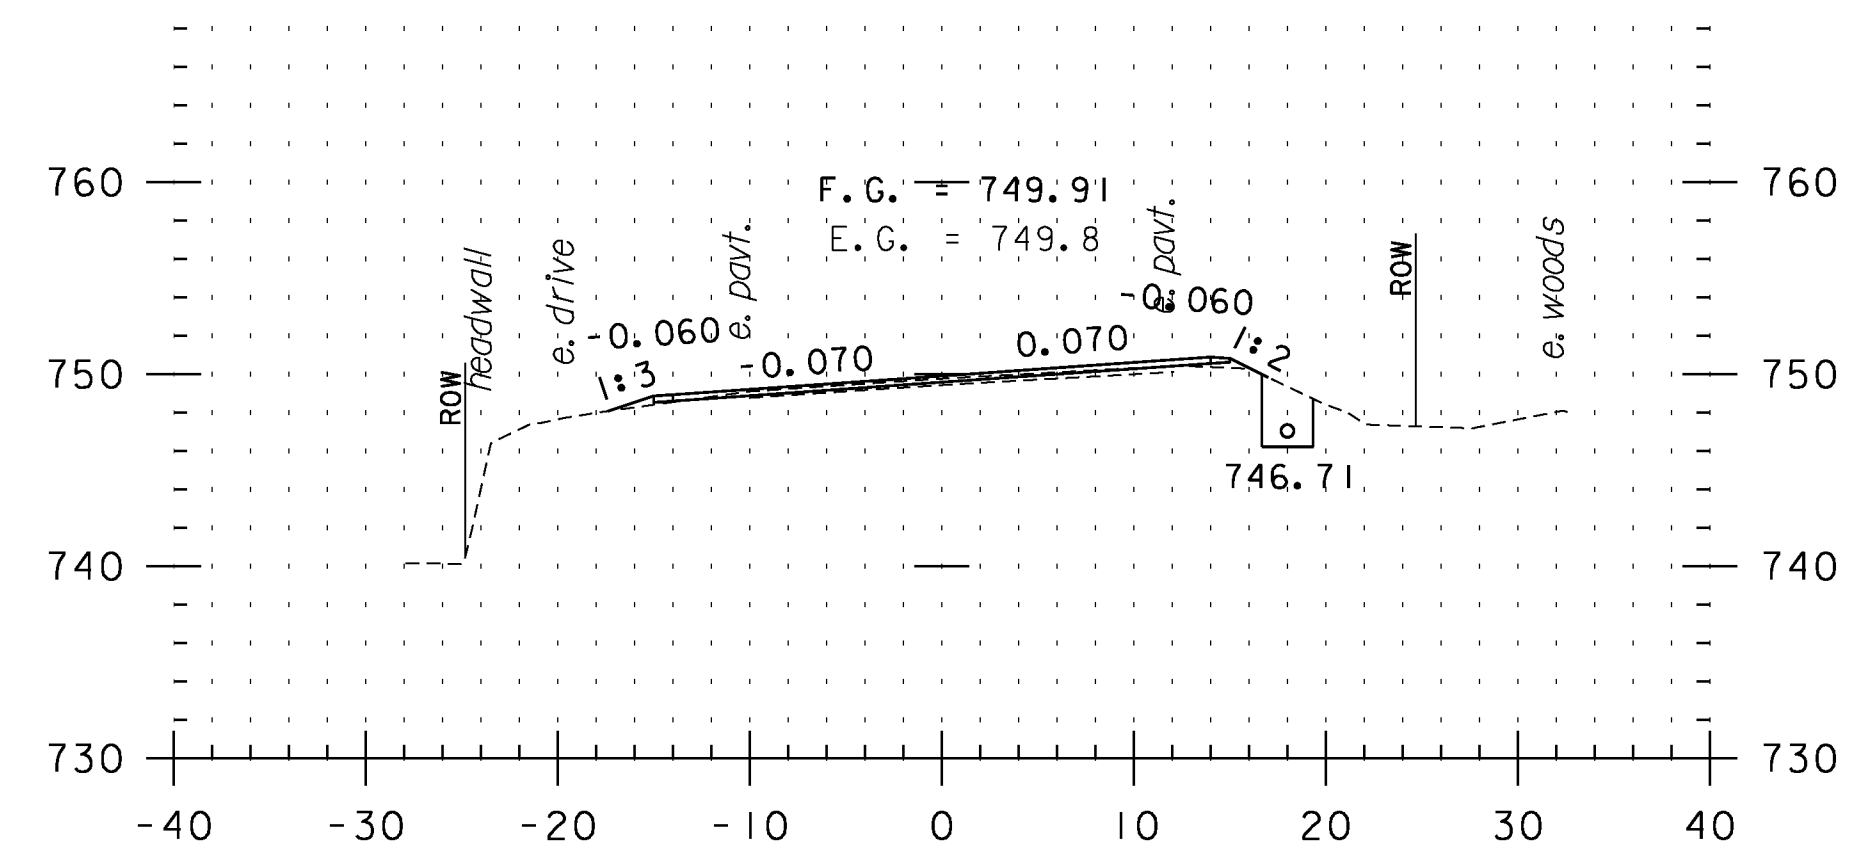


F 139+50

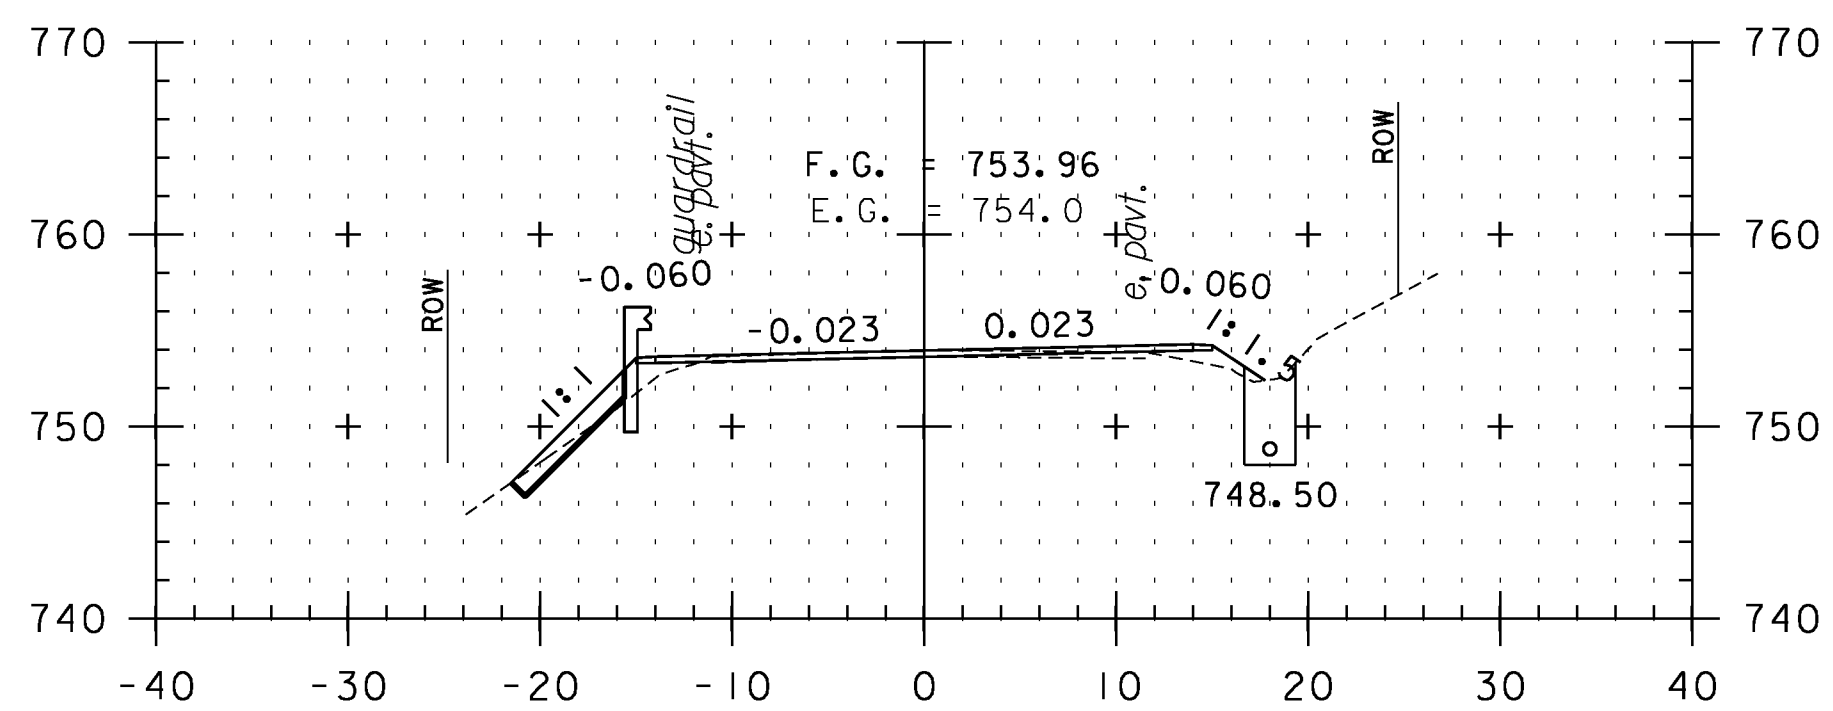


F 136+00

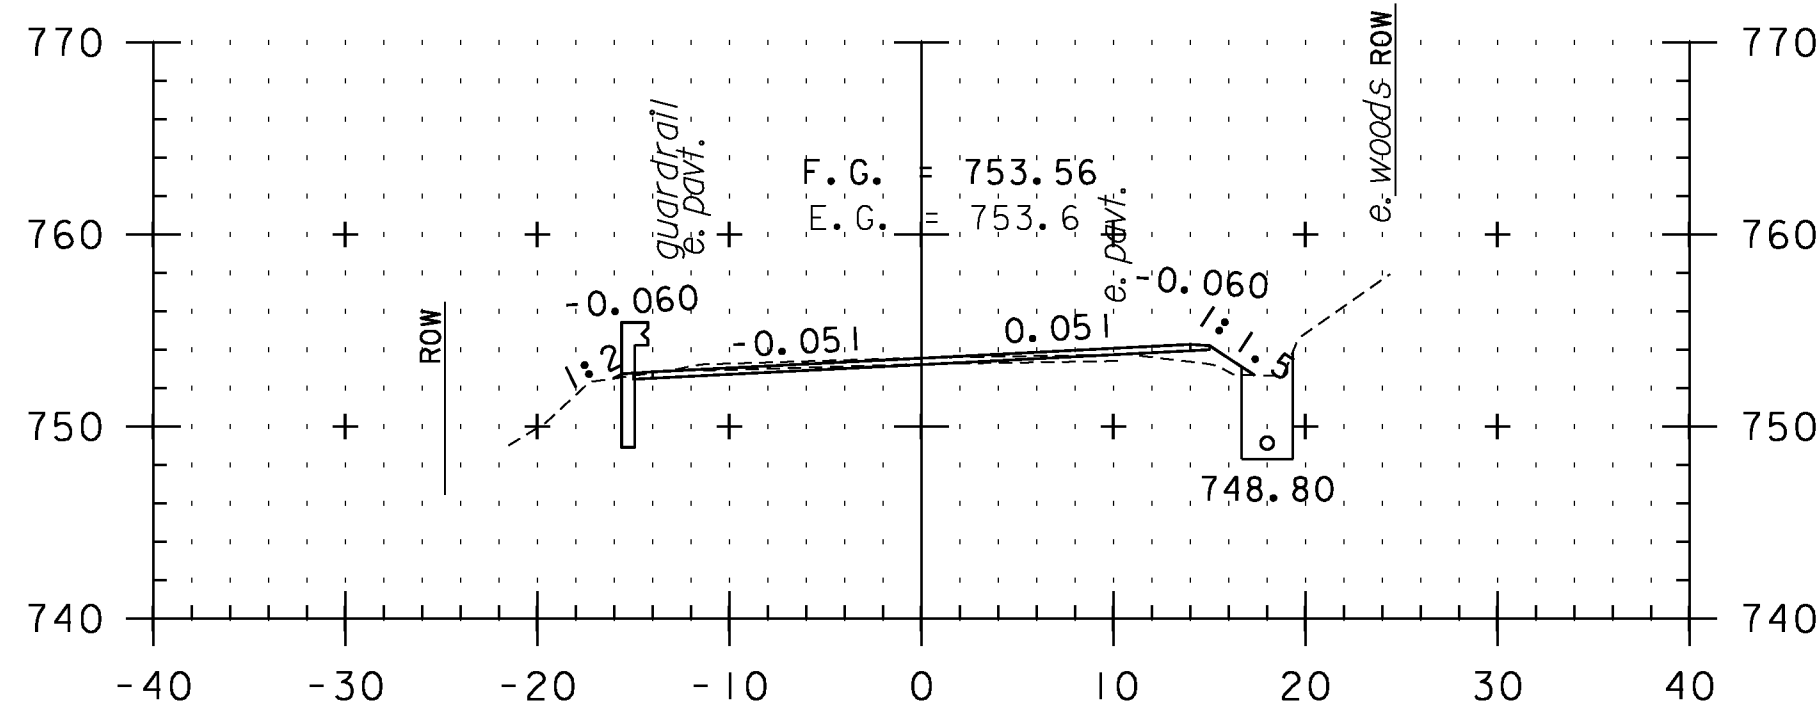


F 137+50

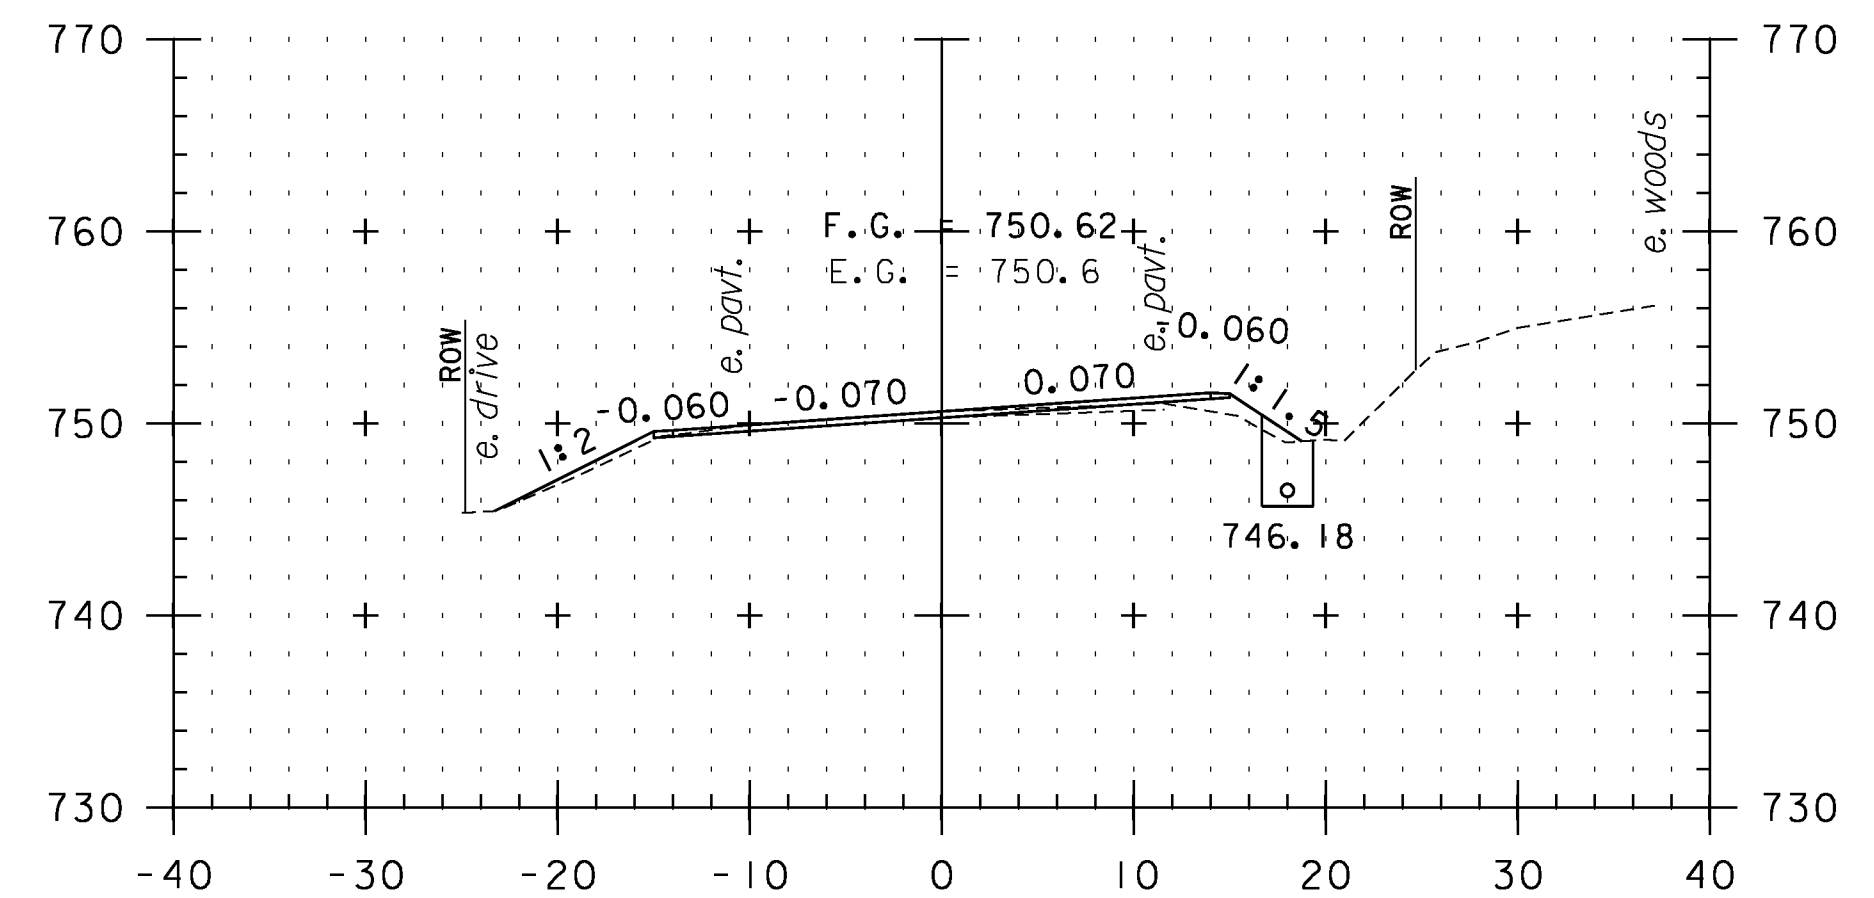


F 139+00

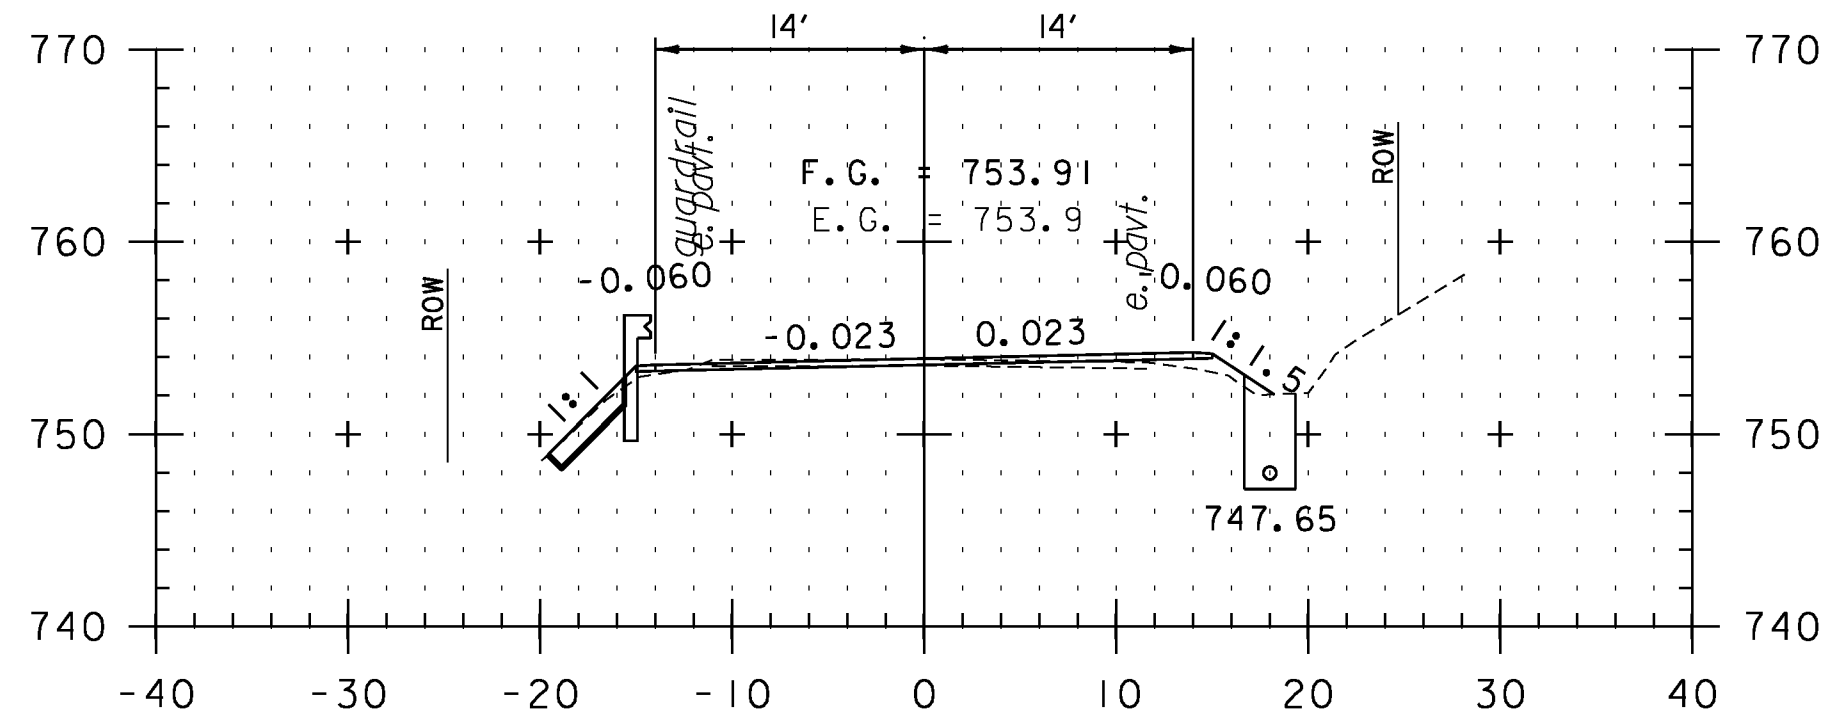

F 135+50

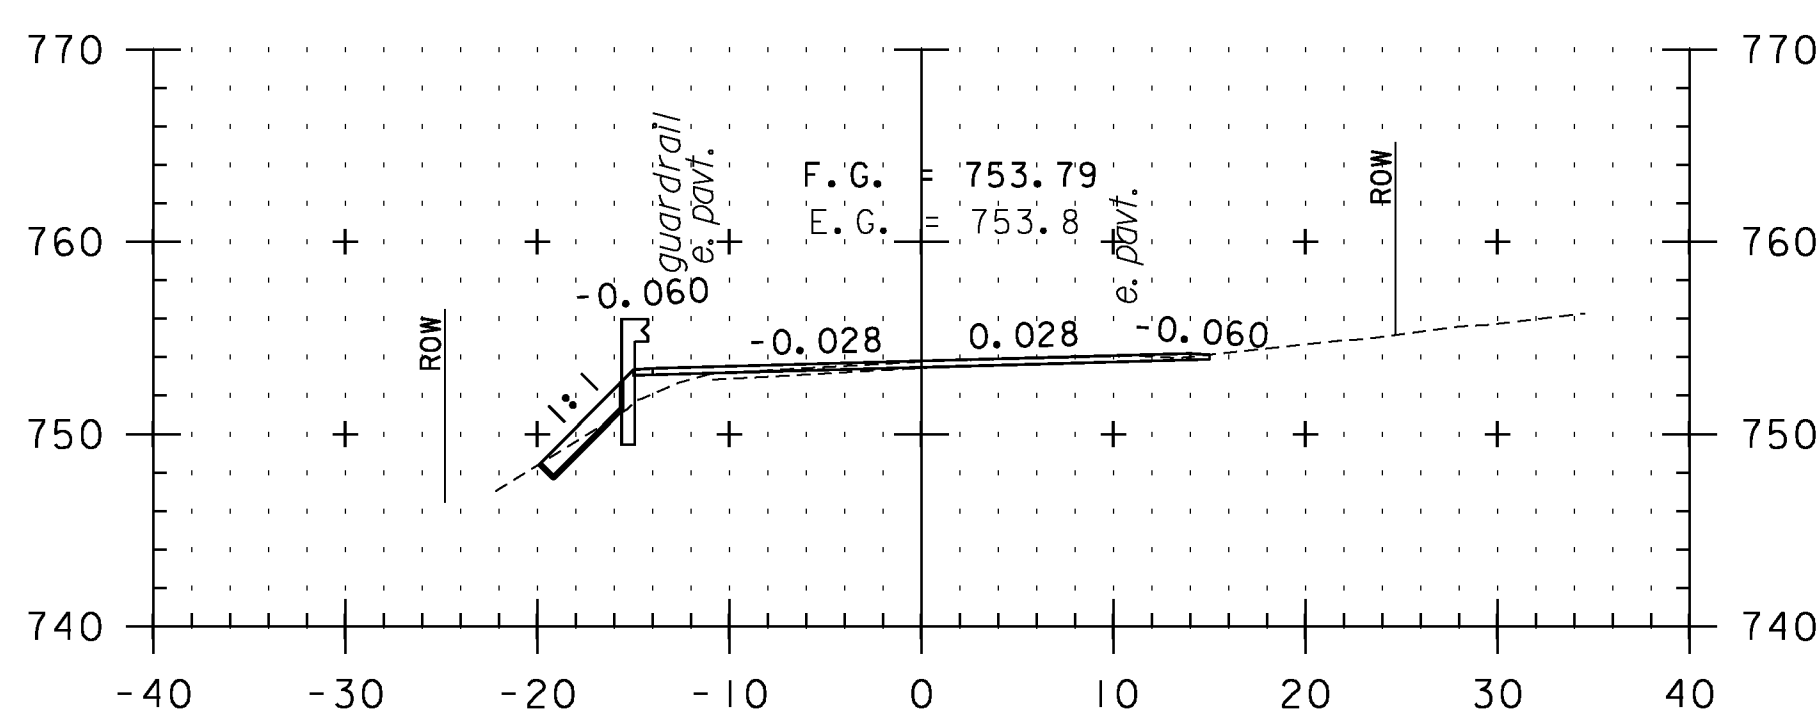

F 137+00

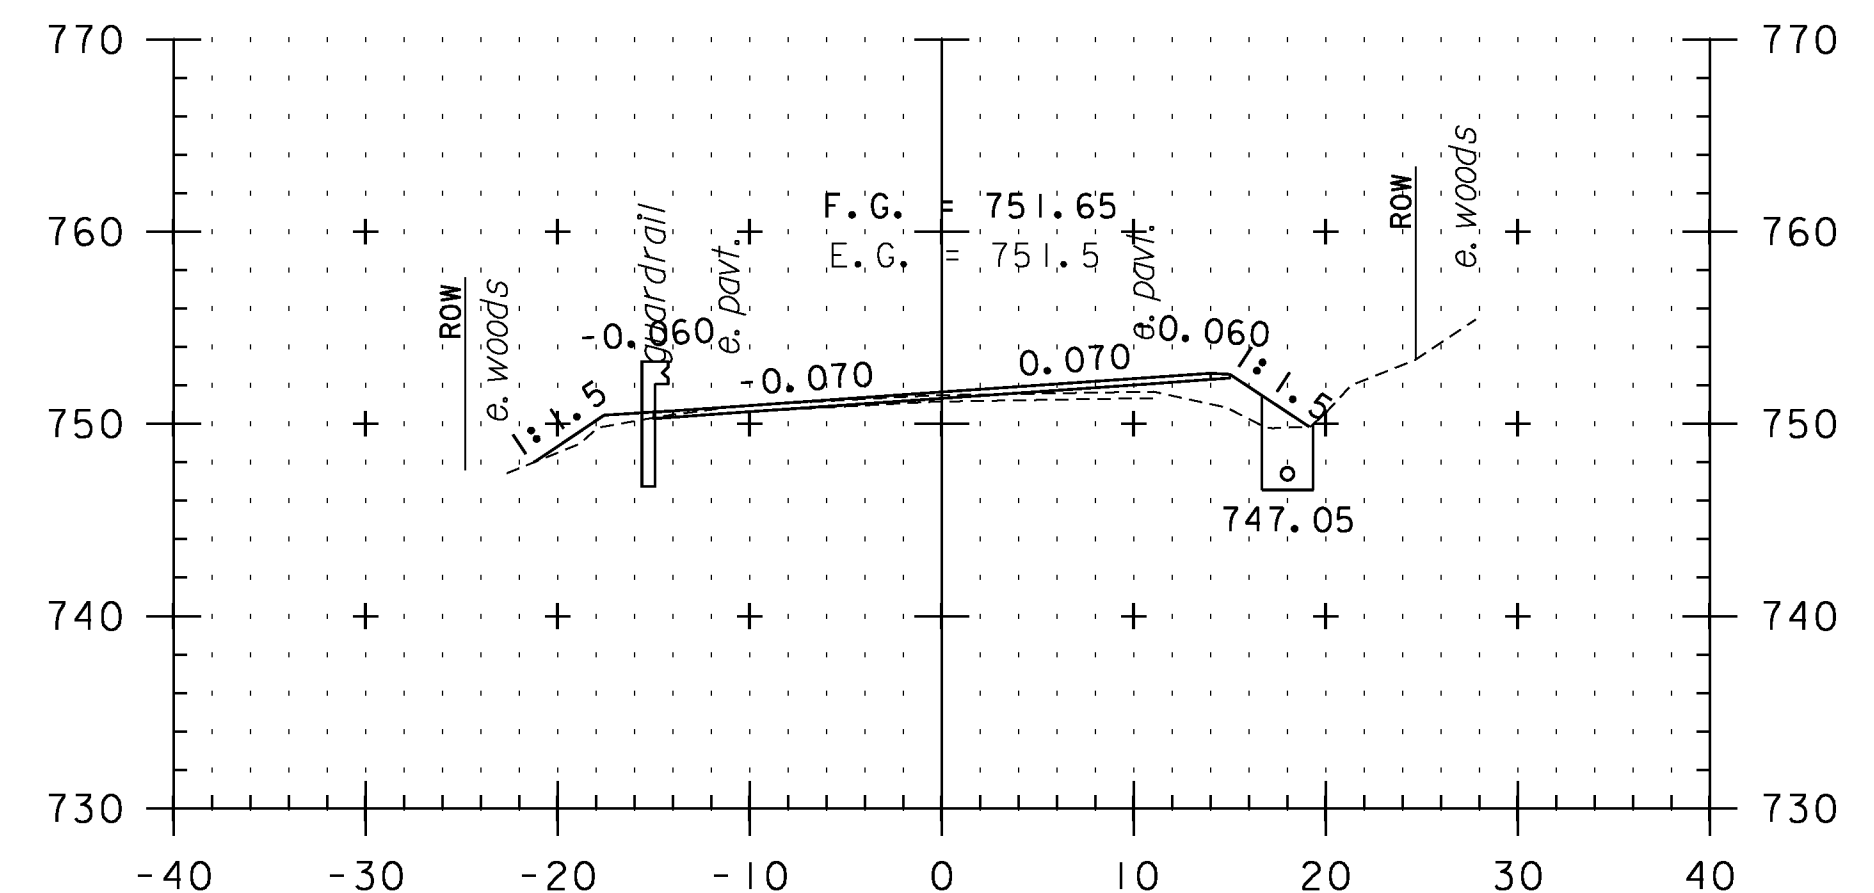

F 138+50

CROSS SECTION SHEET 84

STA. F135+50 TO STA. F139+50



PROJECT NAME: VERSHIRE-THETFORD	PLOT DATE: 1/29/2013
PROJECT NUMBER: STP 2911(I)	DRAWN BY: SNG
FILE NAME: pl0c224.dgn	CHECKED BY: PTS
PROJECT LEADER: PTS	SHEET 192 OF 232
DESIGNED BY: NLL	
IPARM FILE NAME: IOC224_I92	