




F 141+00

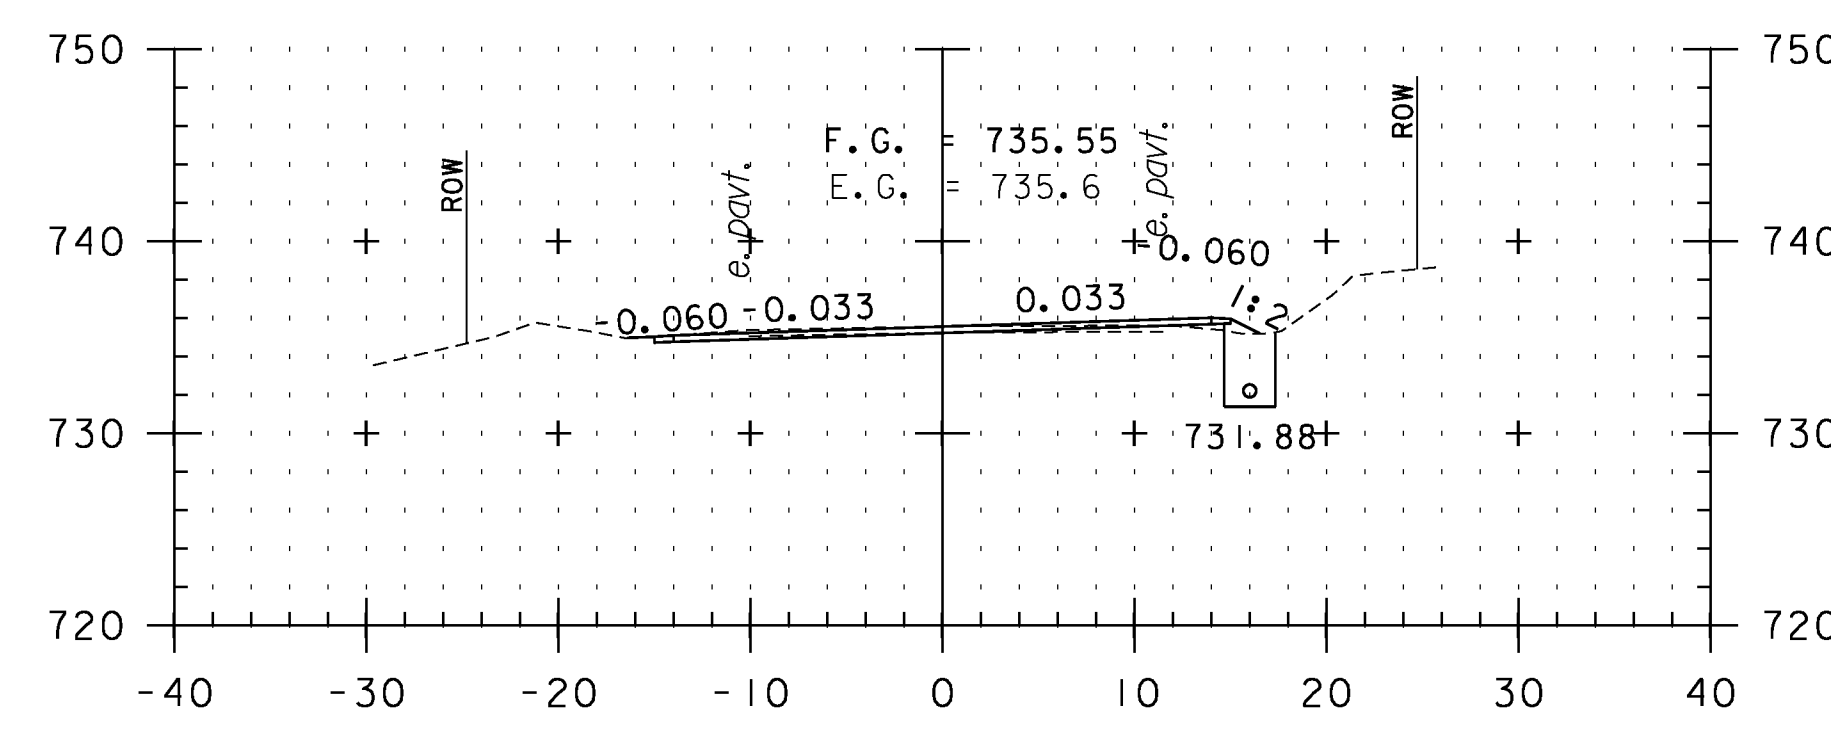


F 142+50

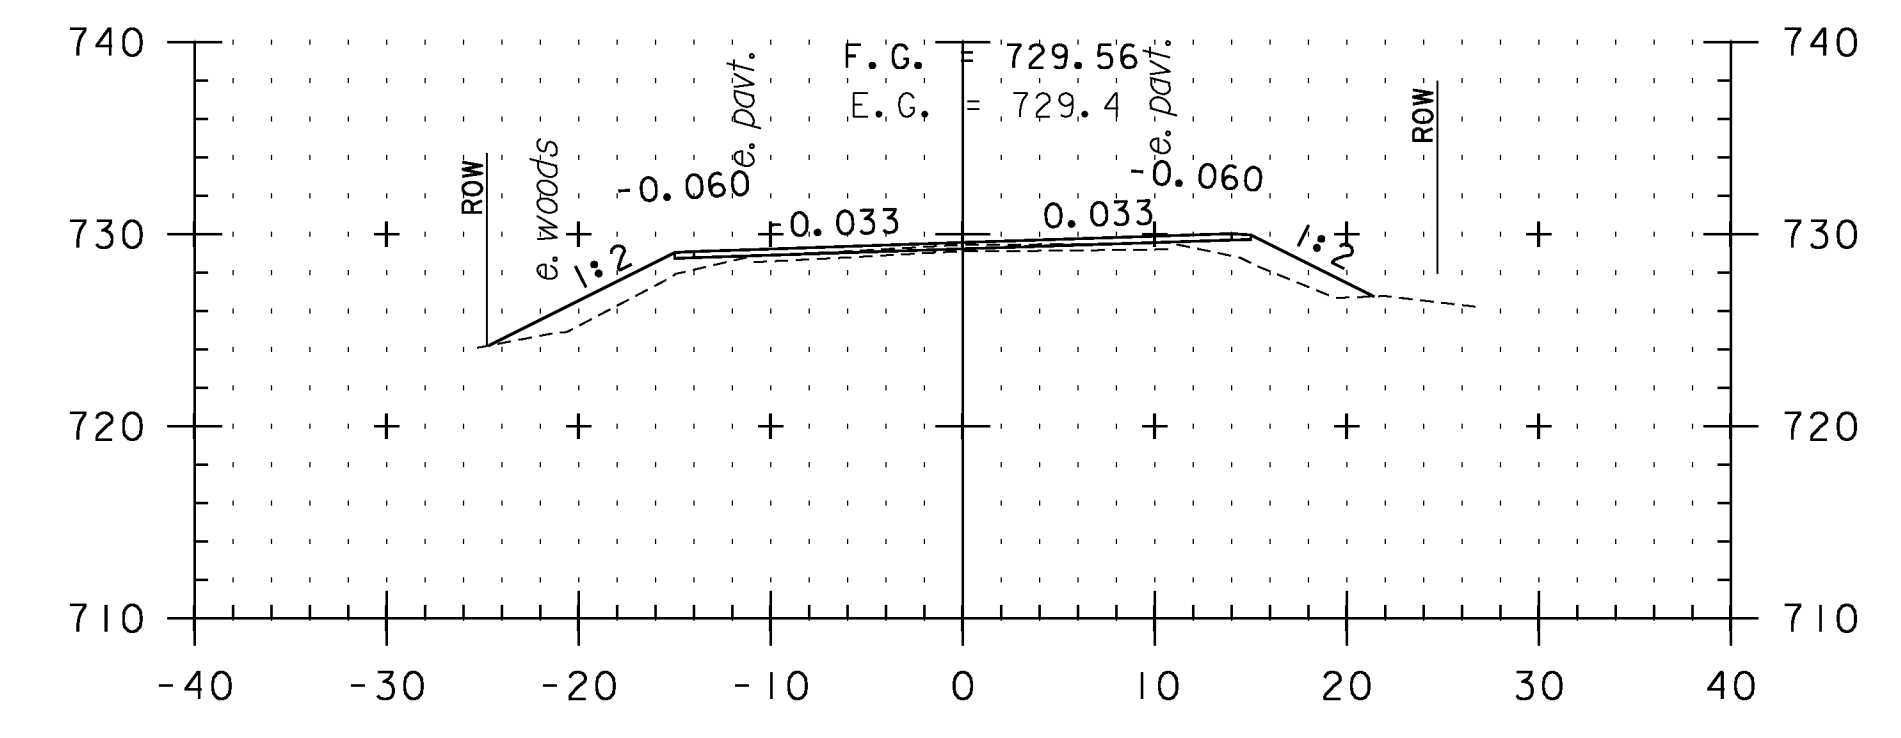


F 144+00

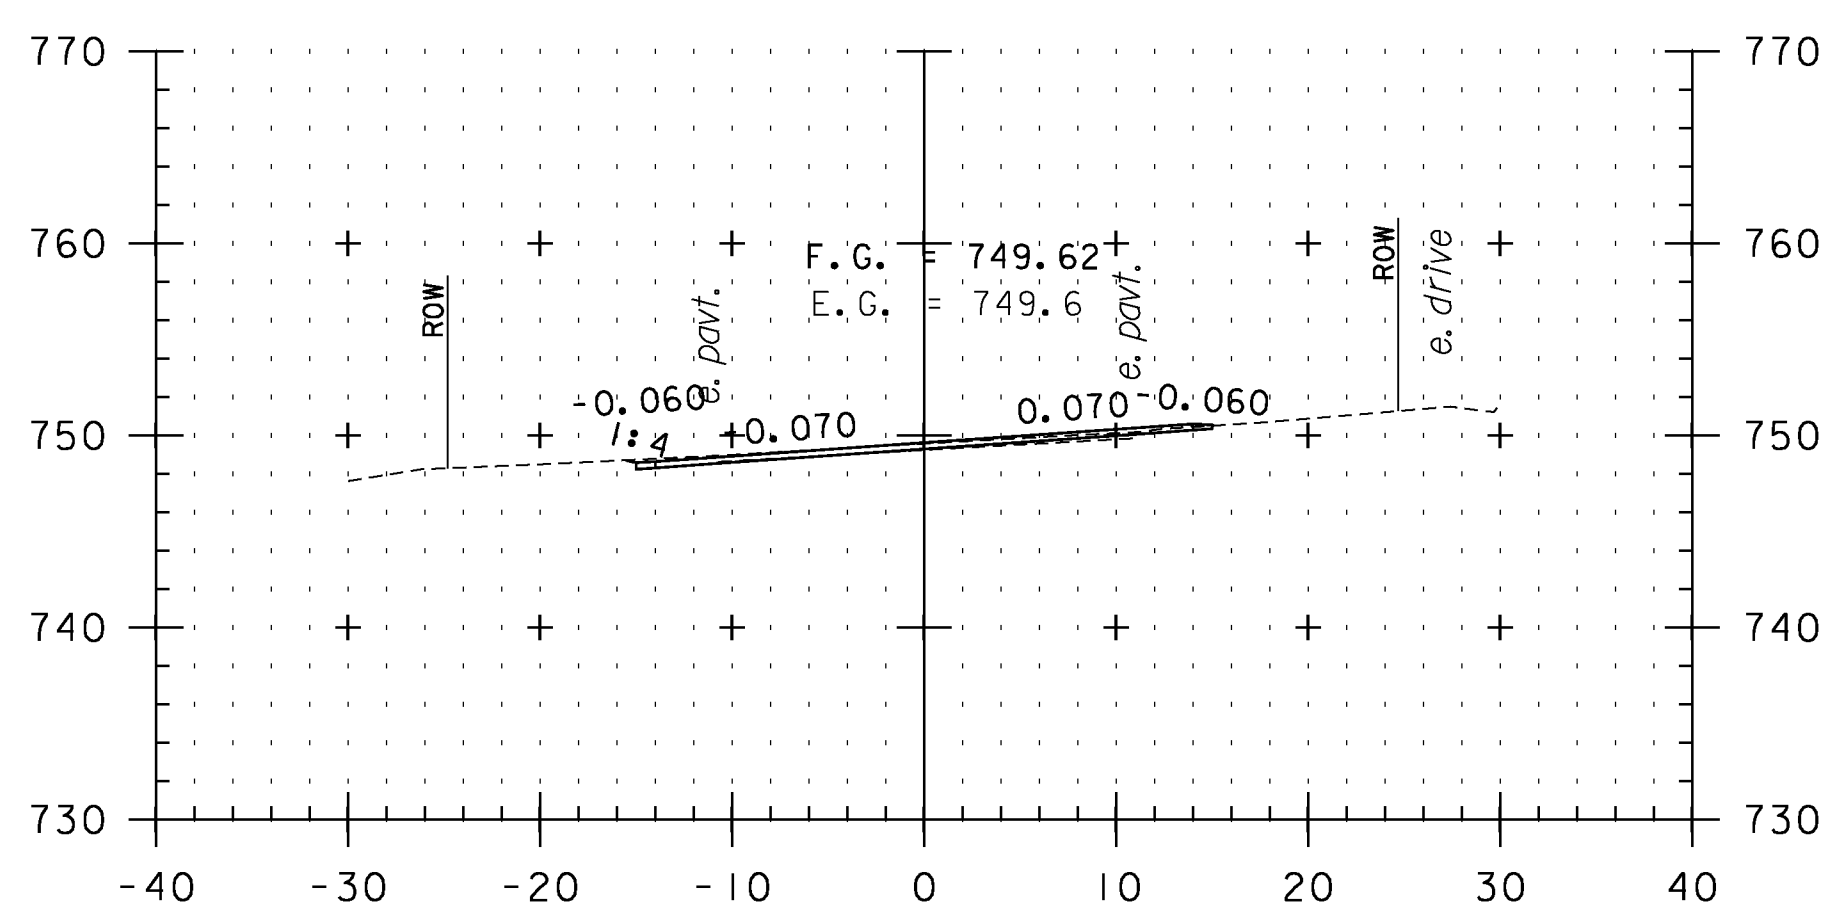


F 140+50

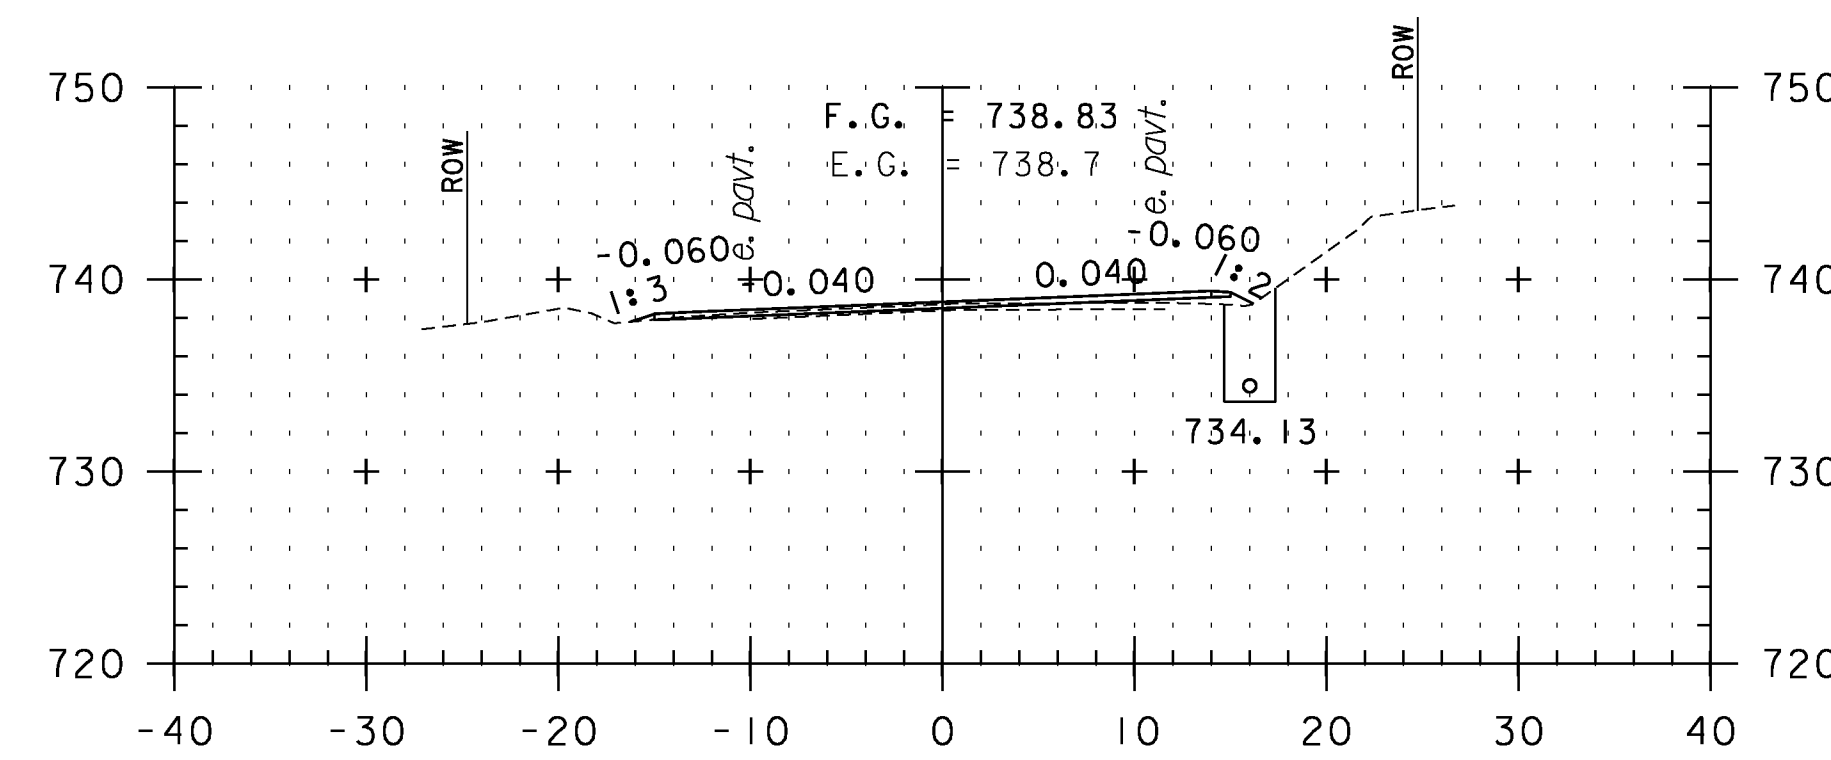


F 142+00

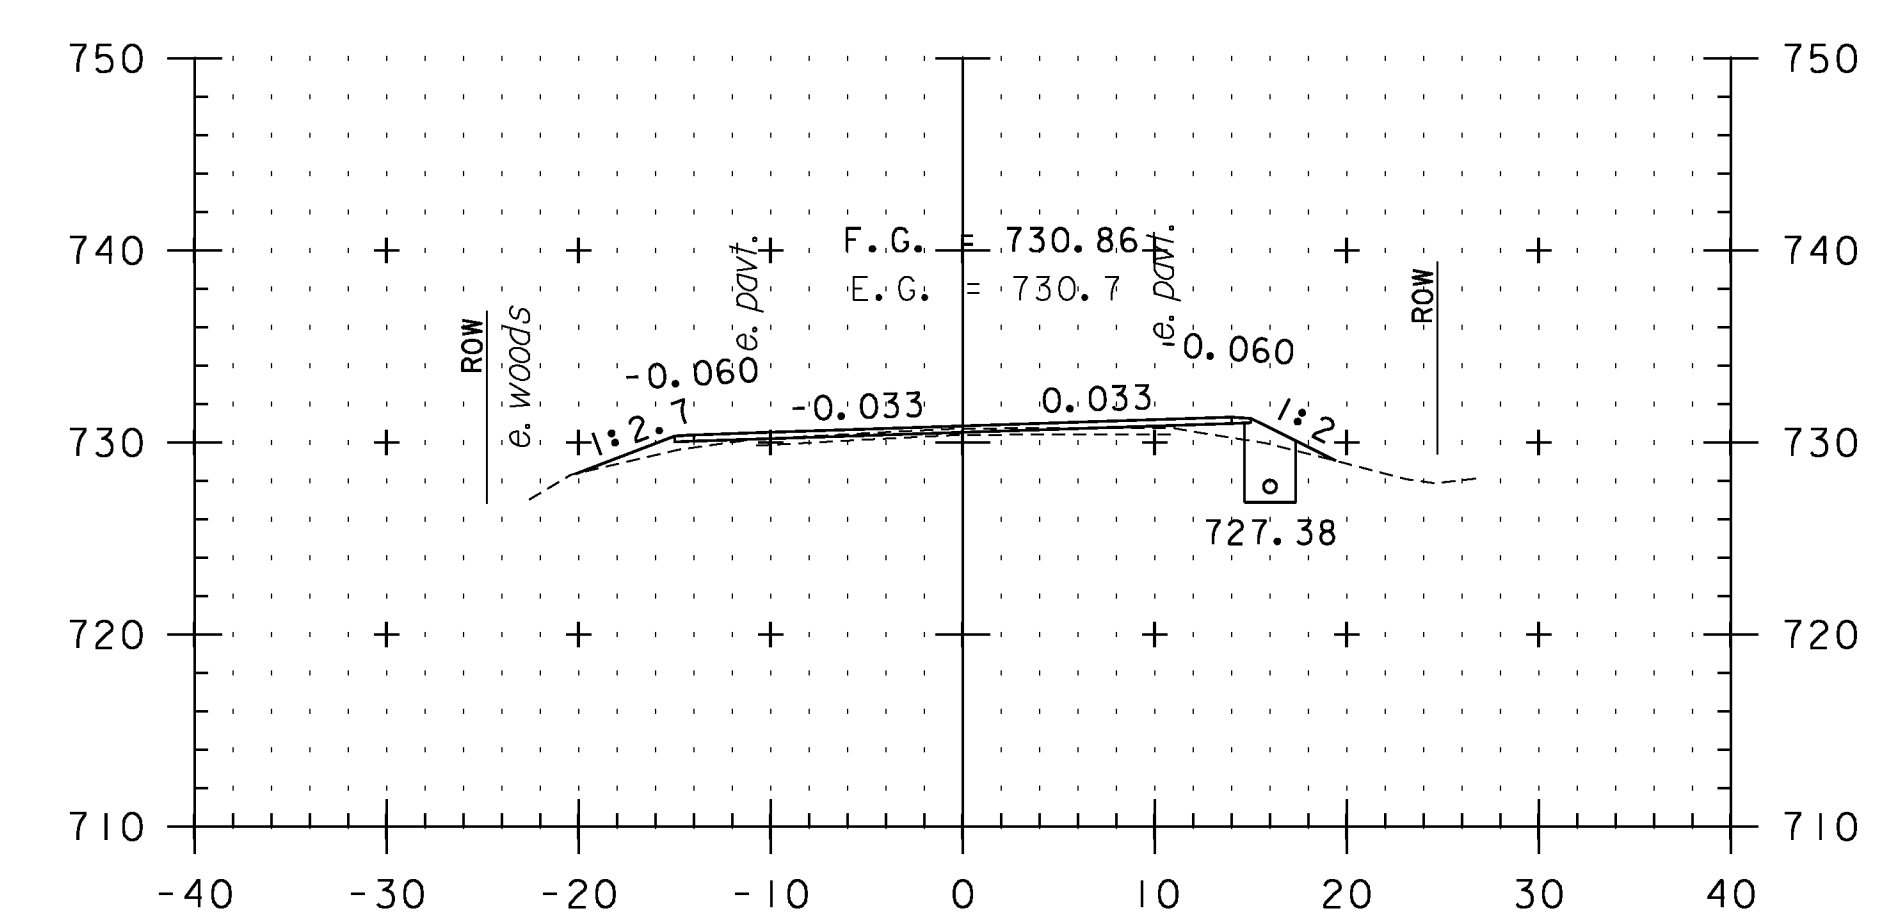


F 143+50

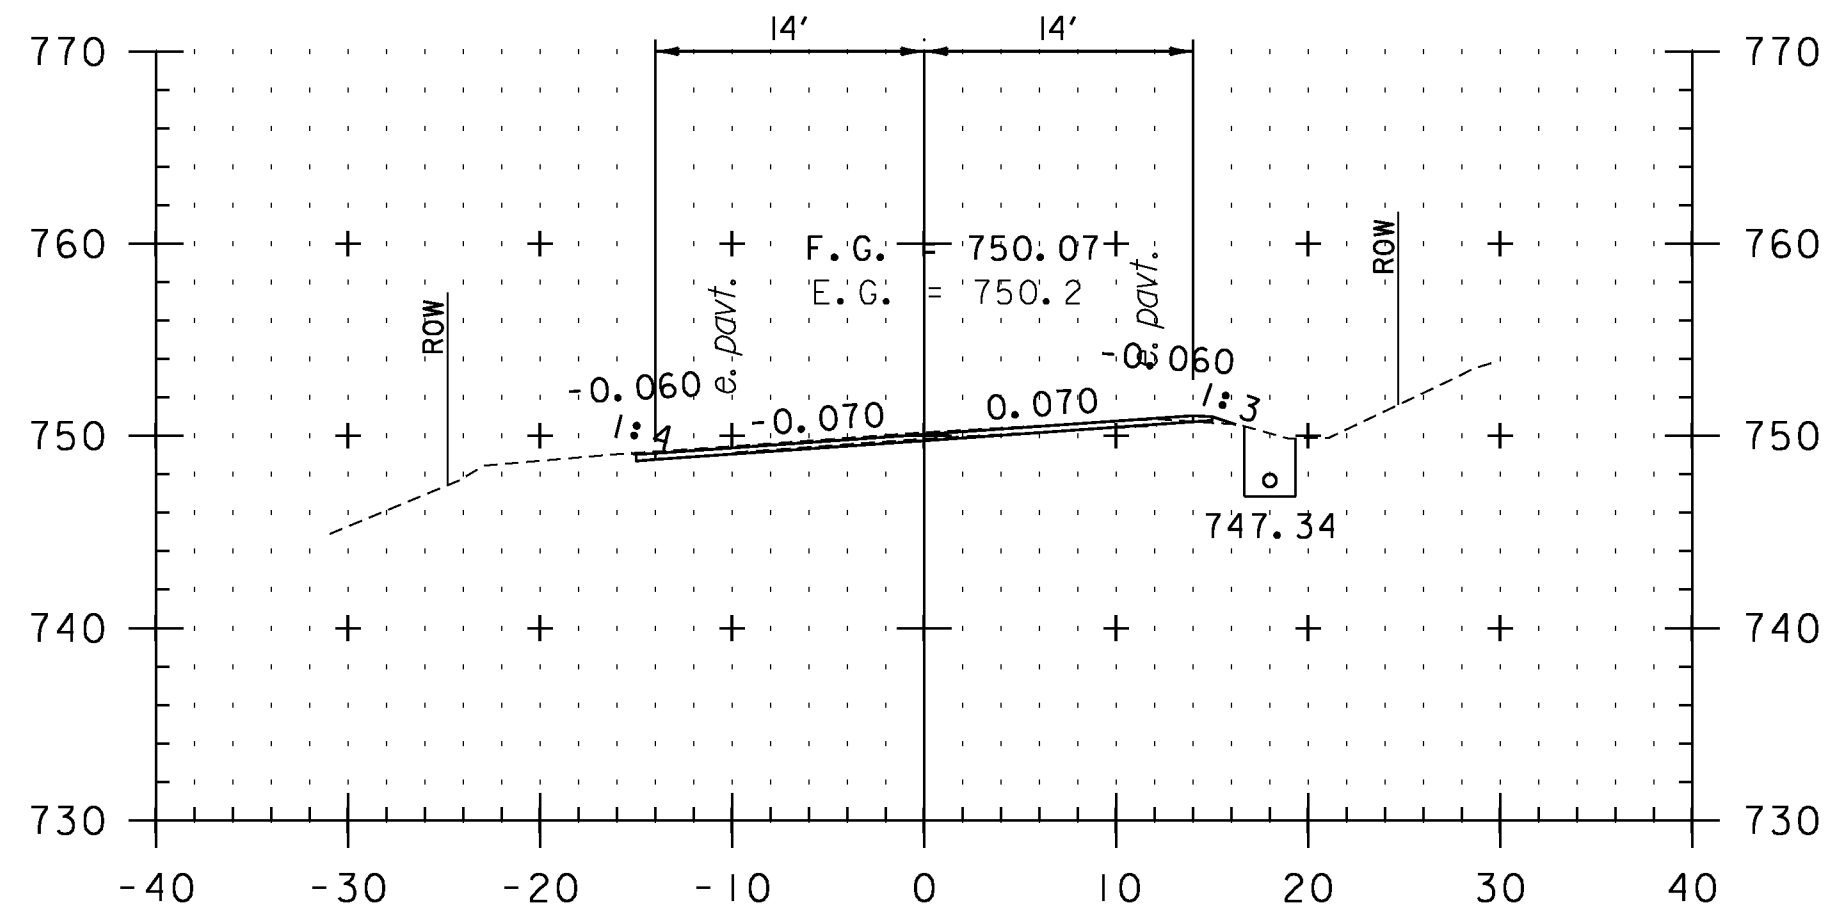

F 140+00

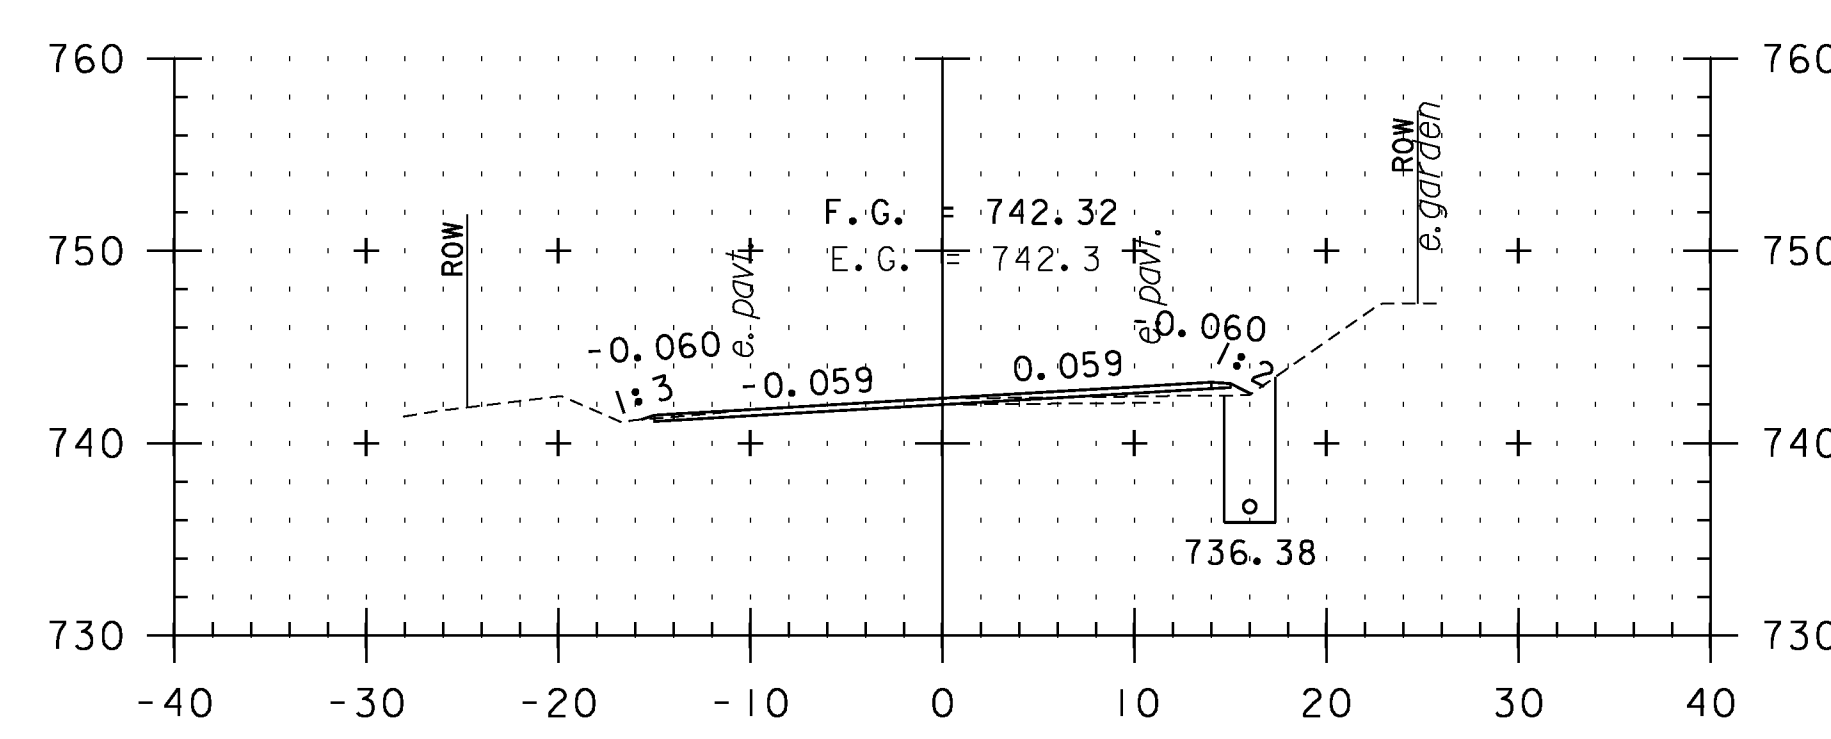


F 141+50

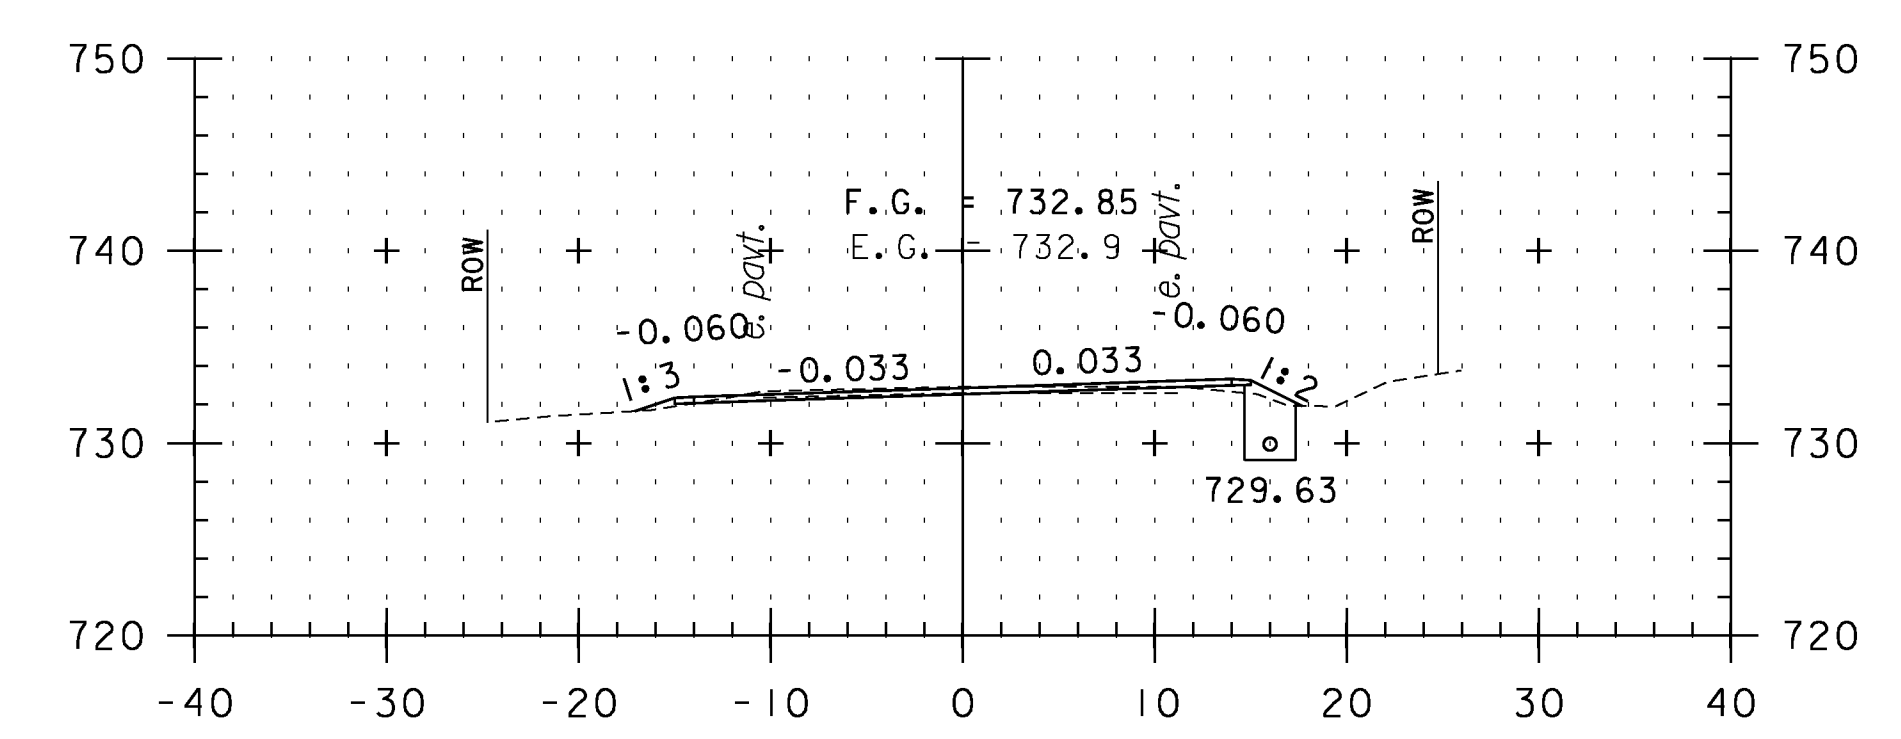

F 143+00

CROSS SECTION SHEET 85

STA. F140+00 TO STA. F144+00

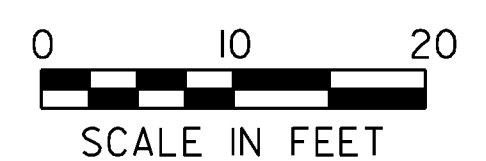

PROJECT NAME: VERSHIRE-THETFORD	PLOT DATE: 1/29/2013
PROJECT NUMBER: STP 2911(I)	DRAWN BY: SNG
FILE NAME: pl0c224.dgn	CHECKED BY: PTS
PROJECT LEADER: PTS	SHEET 193 OF 232
DESIGNED BY: NLL	
IPARM FILE NAME: IOC224_193	