




F 145+50

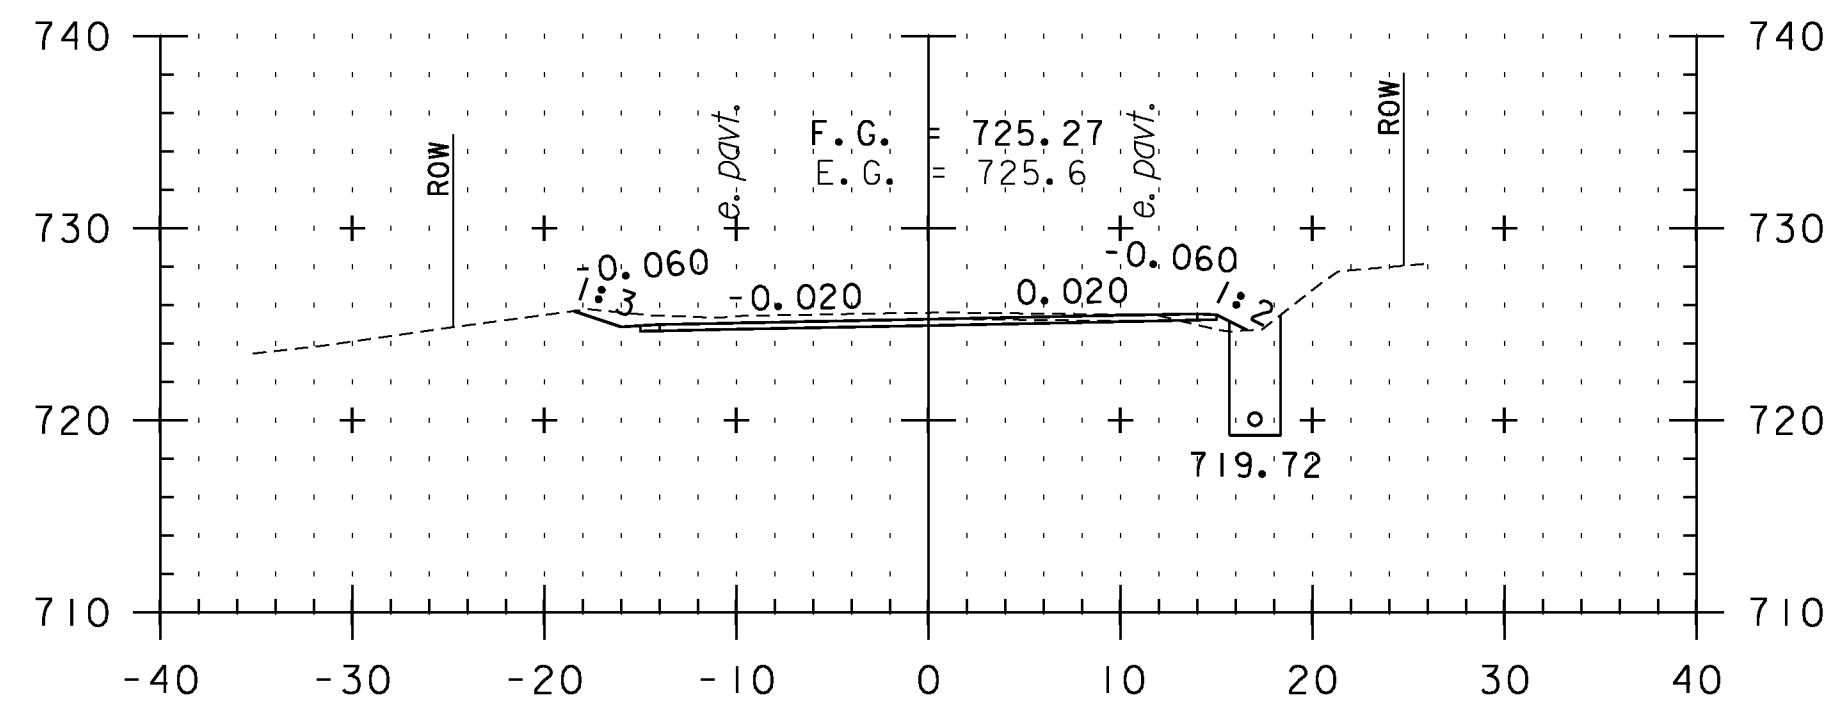


F 147+00

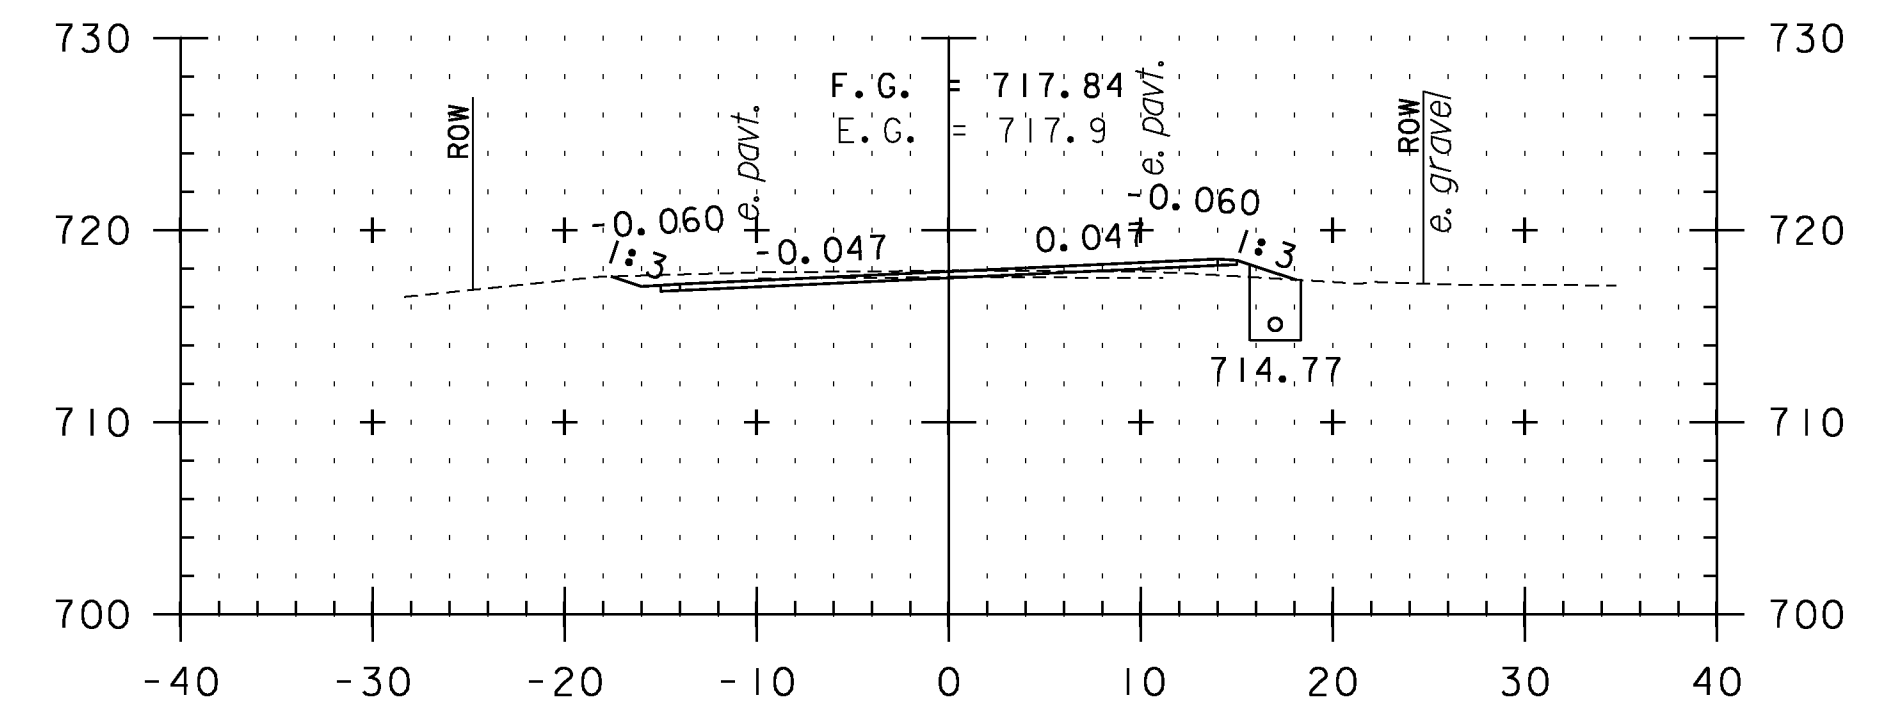


F 148+50

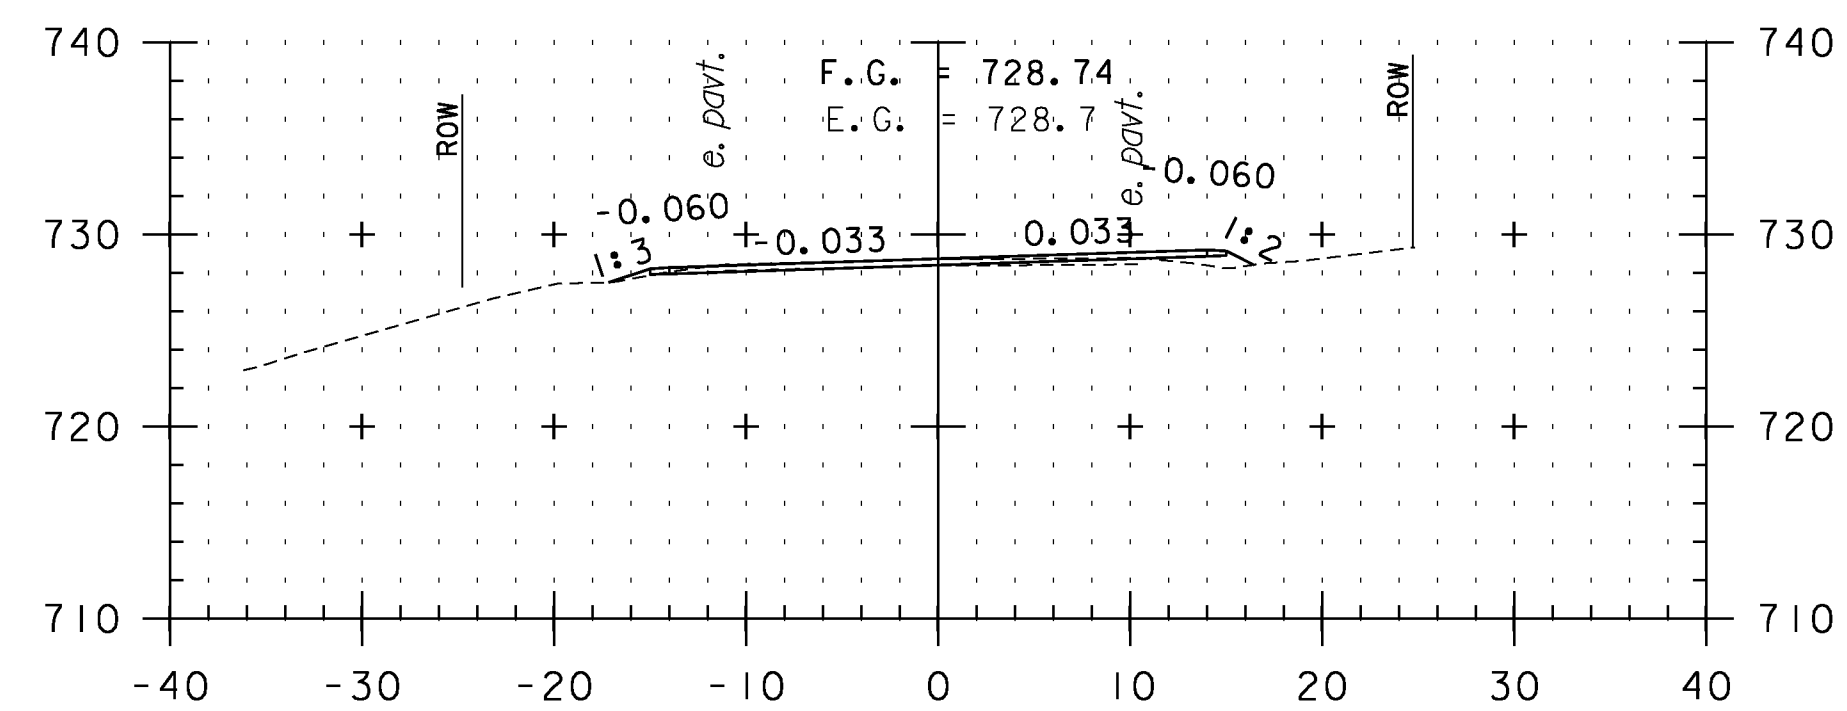


F 145+00

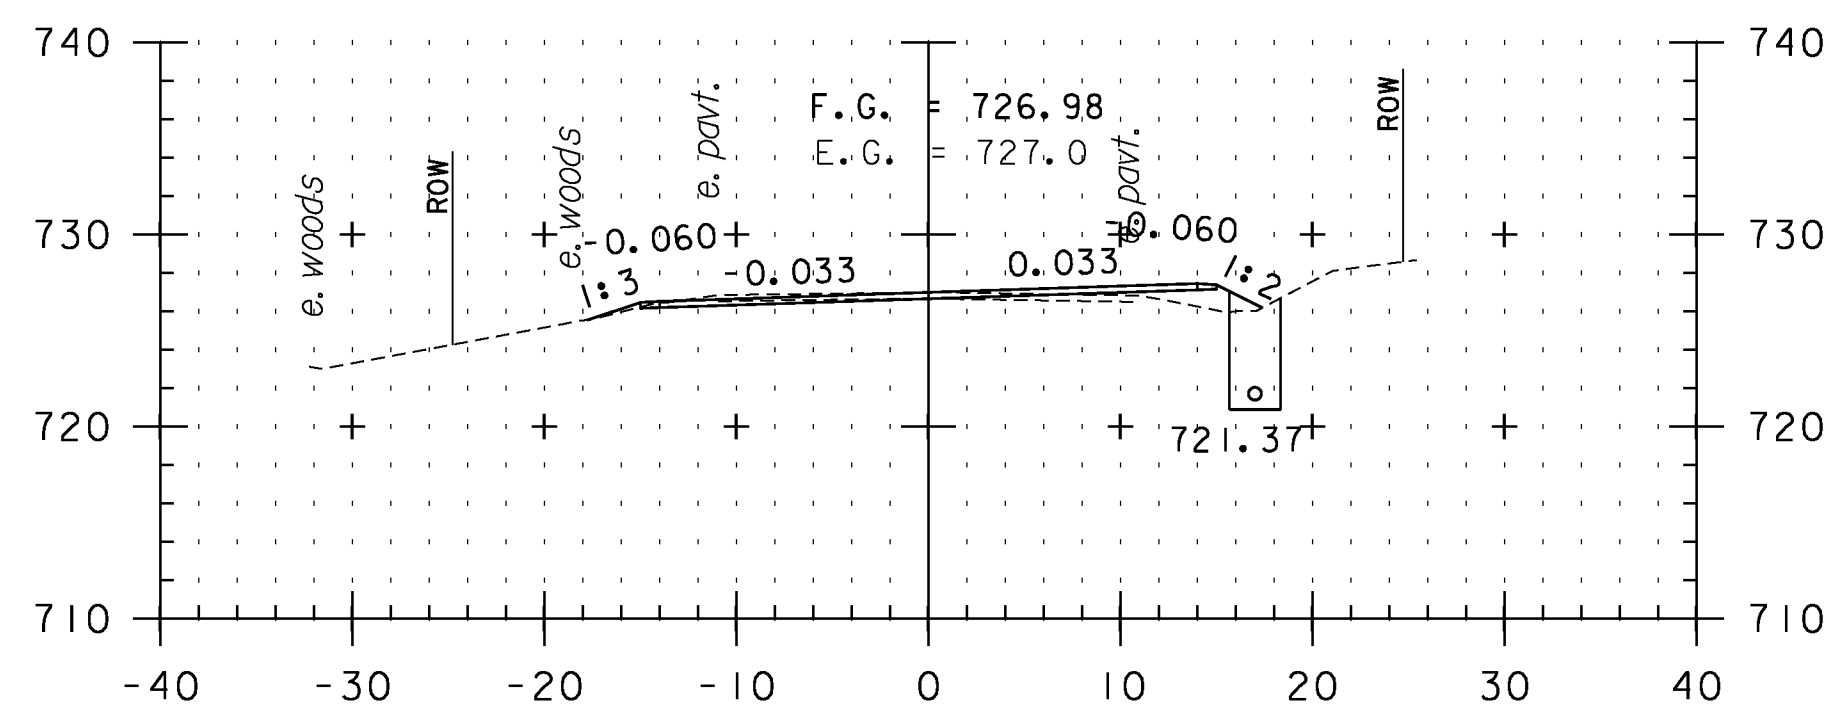


F 146+50

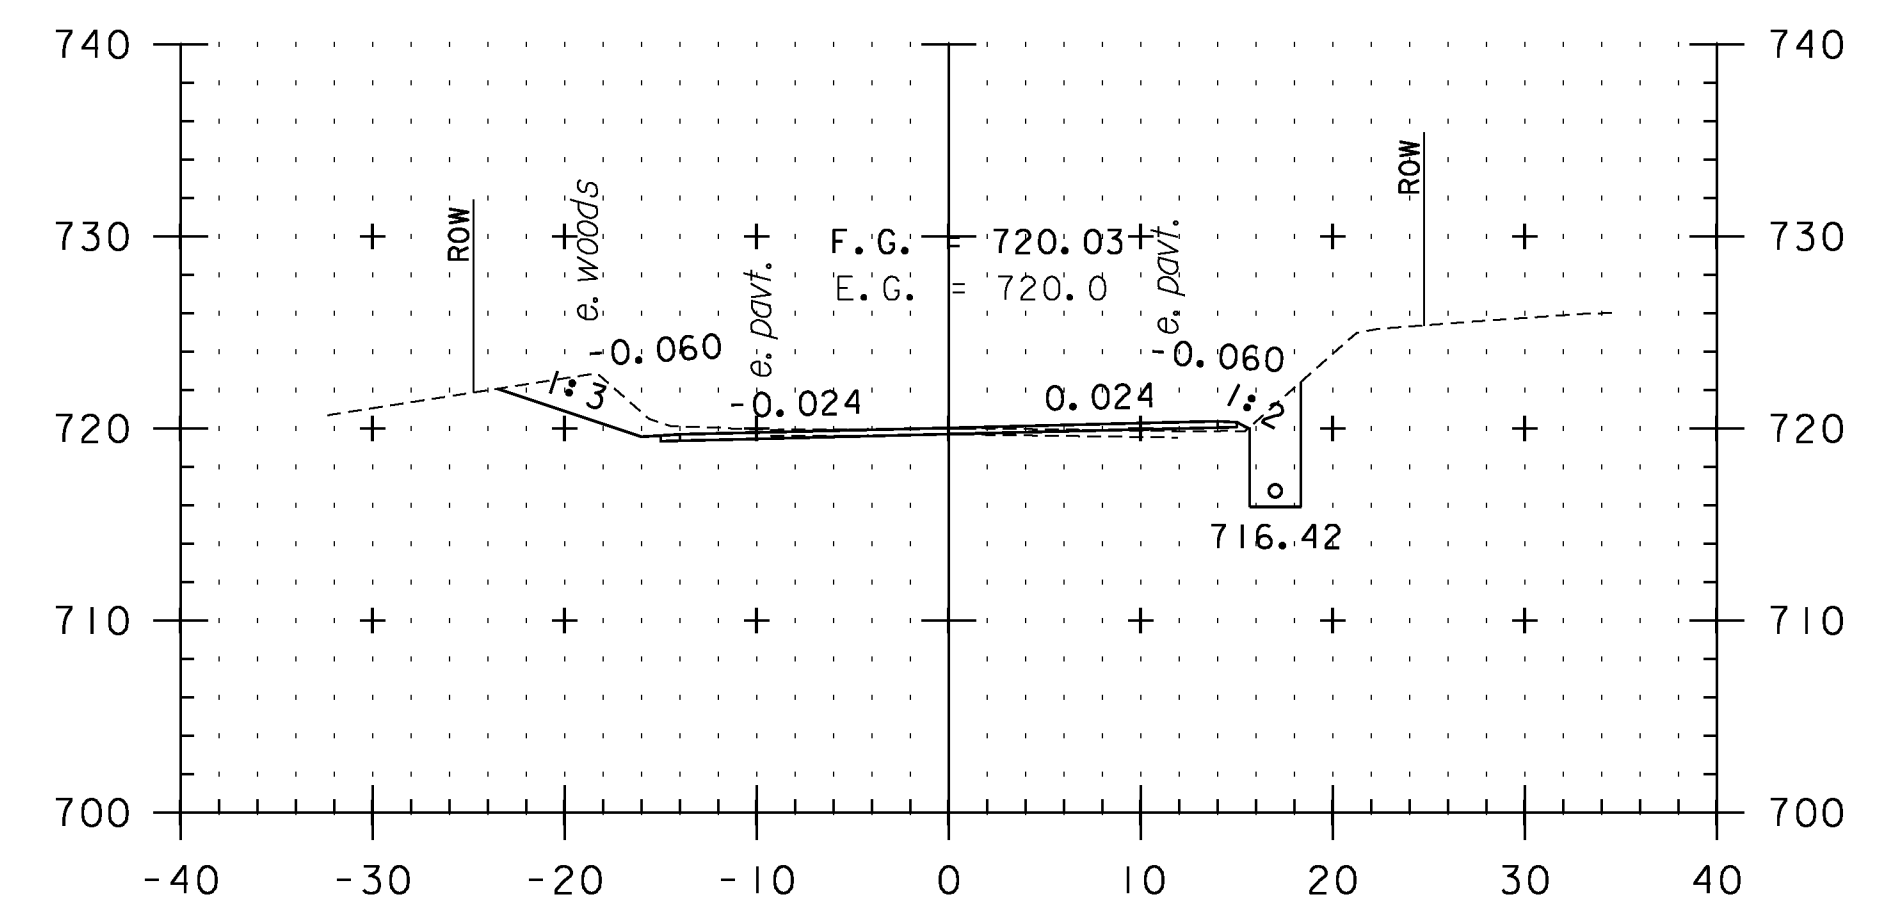


F 148+00

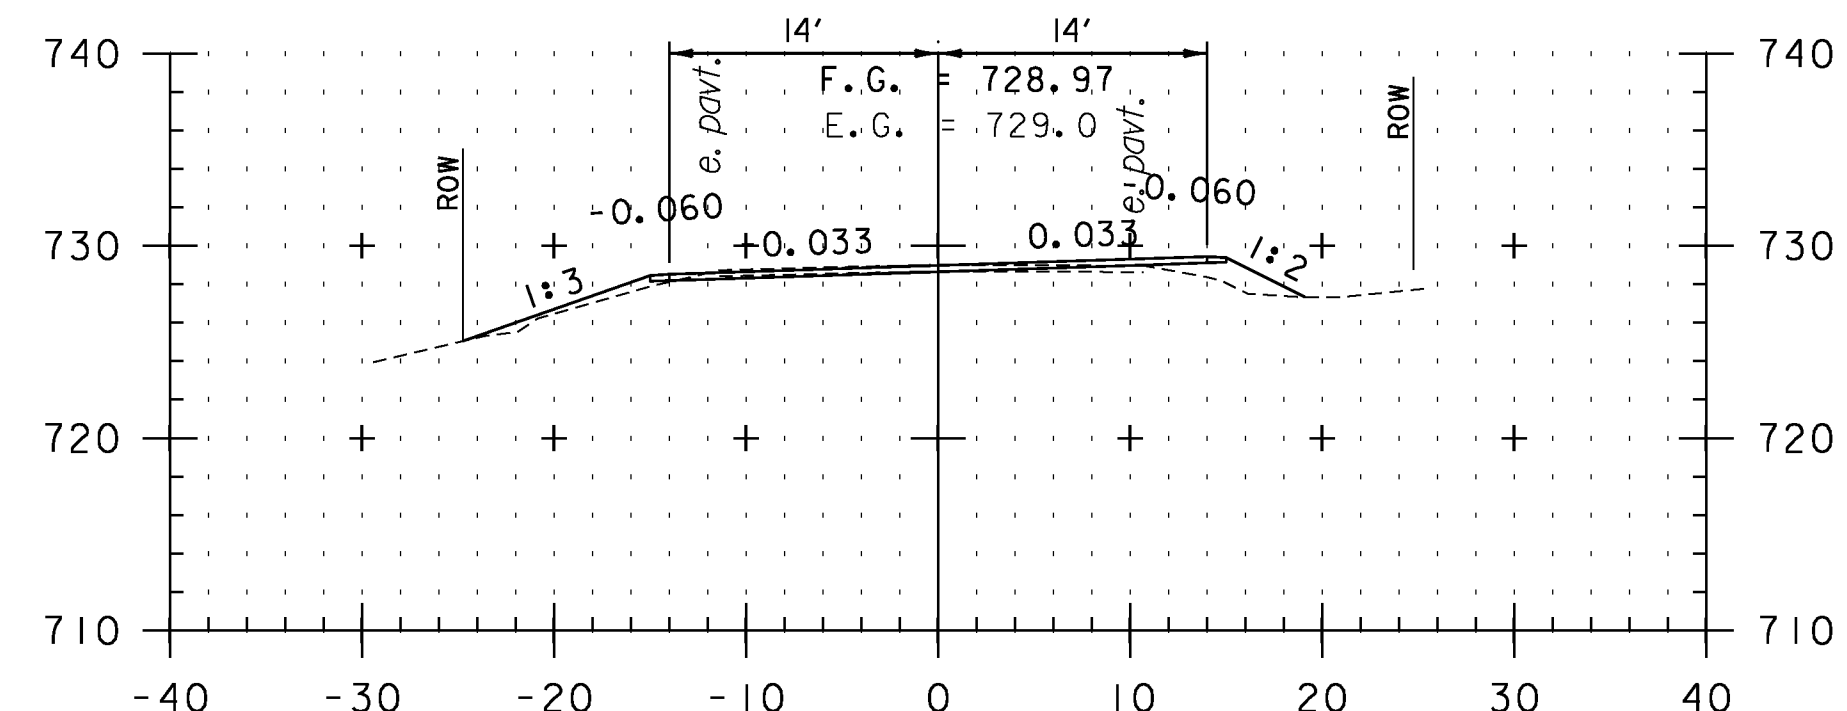

F 144+50

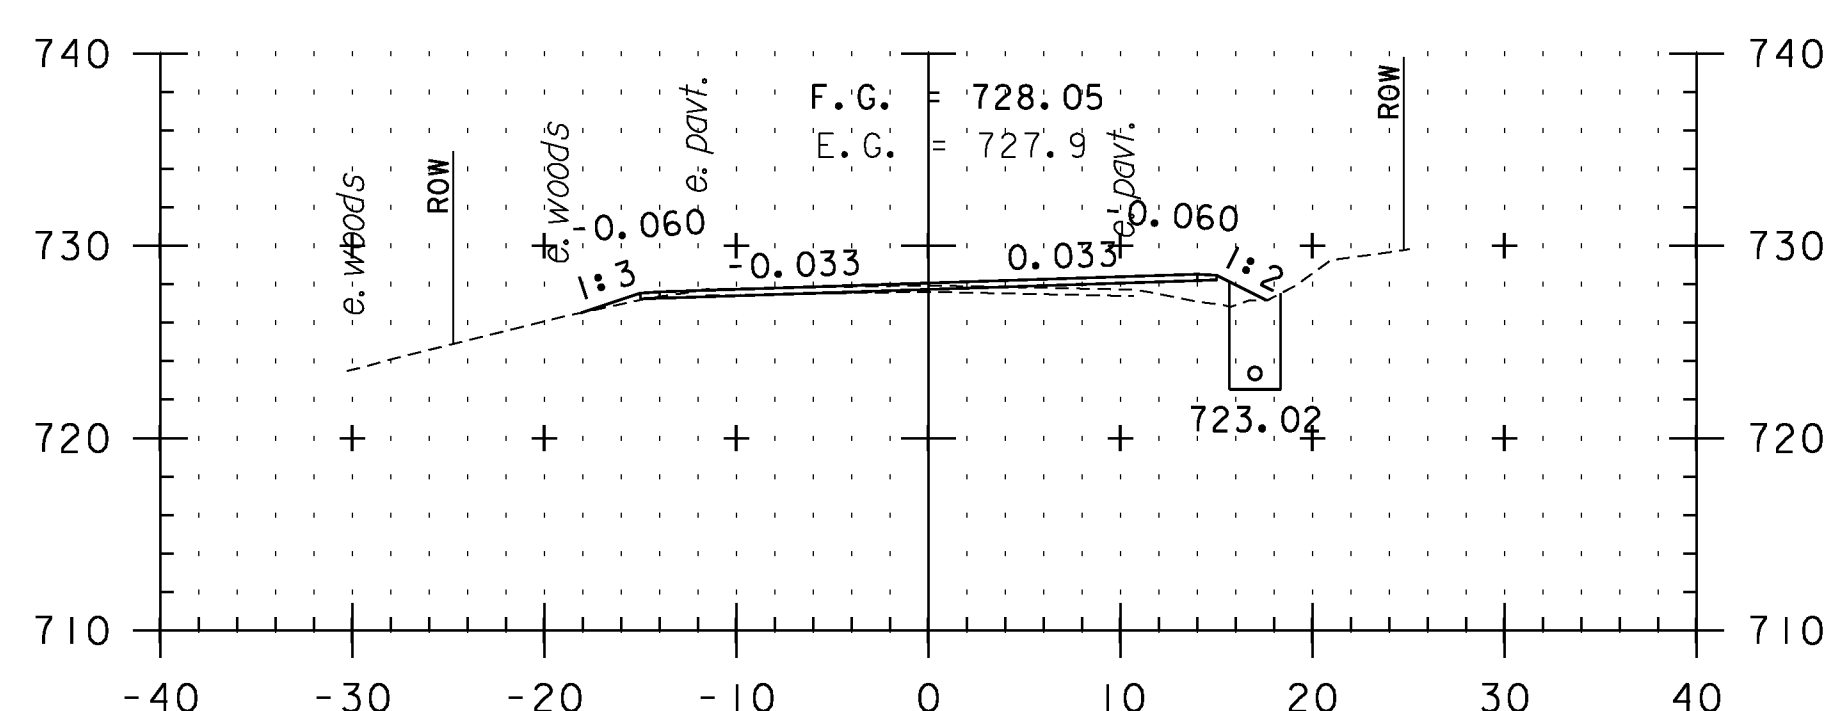


F 146+00

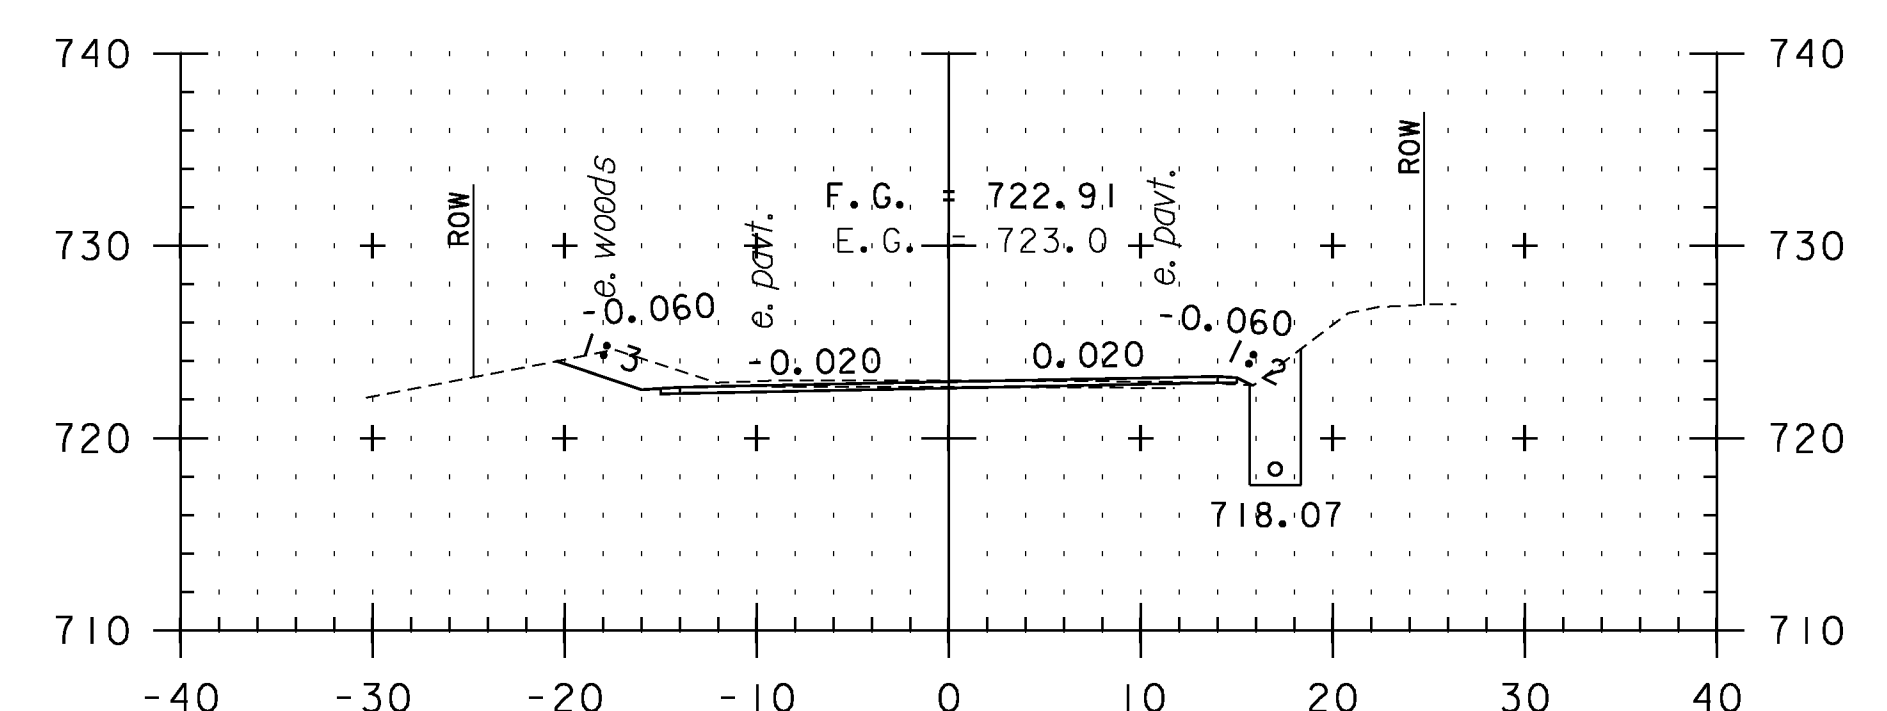

F 147+50

CROSS SECTION SHEET 86

STA. F144+50 TO STA. F148+50

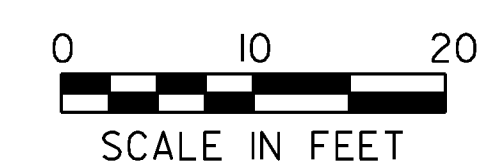

PROJECT NAME: VERSHIRE-THETFORD	PLOT DATE: 1/29/2013
PROJECT NUMBER: STP 2911(I)	DRAWN BY: SNG
FILE NAME: pl0c224.dgn	CHECKED BY: PTS
PROJECT LEADER: PTS	SHEET 194 OF 232
DESIGNED BY: NLL	
IPARM FILE NAME: IOC224_194	