




T0+50

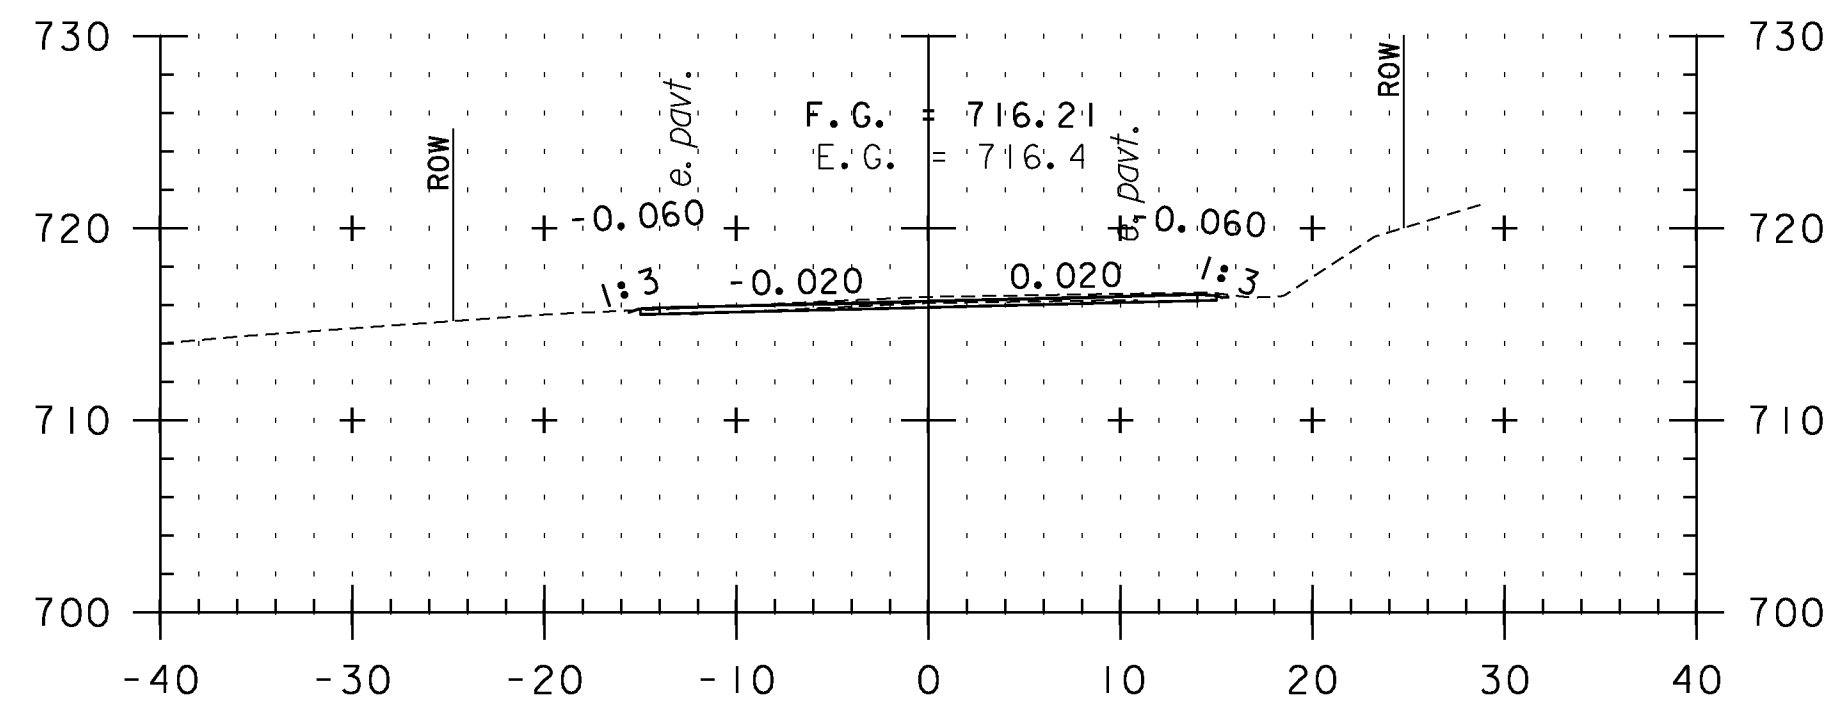


T1+83
TH I

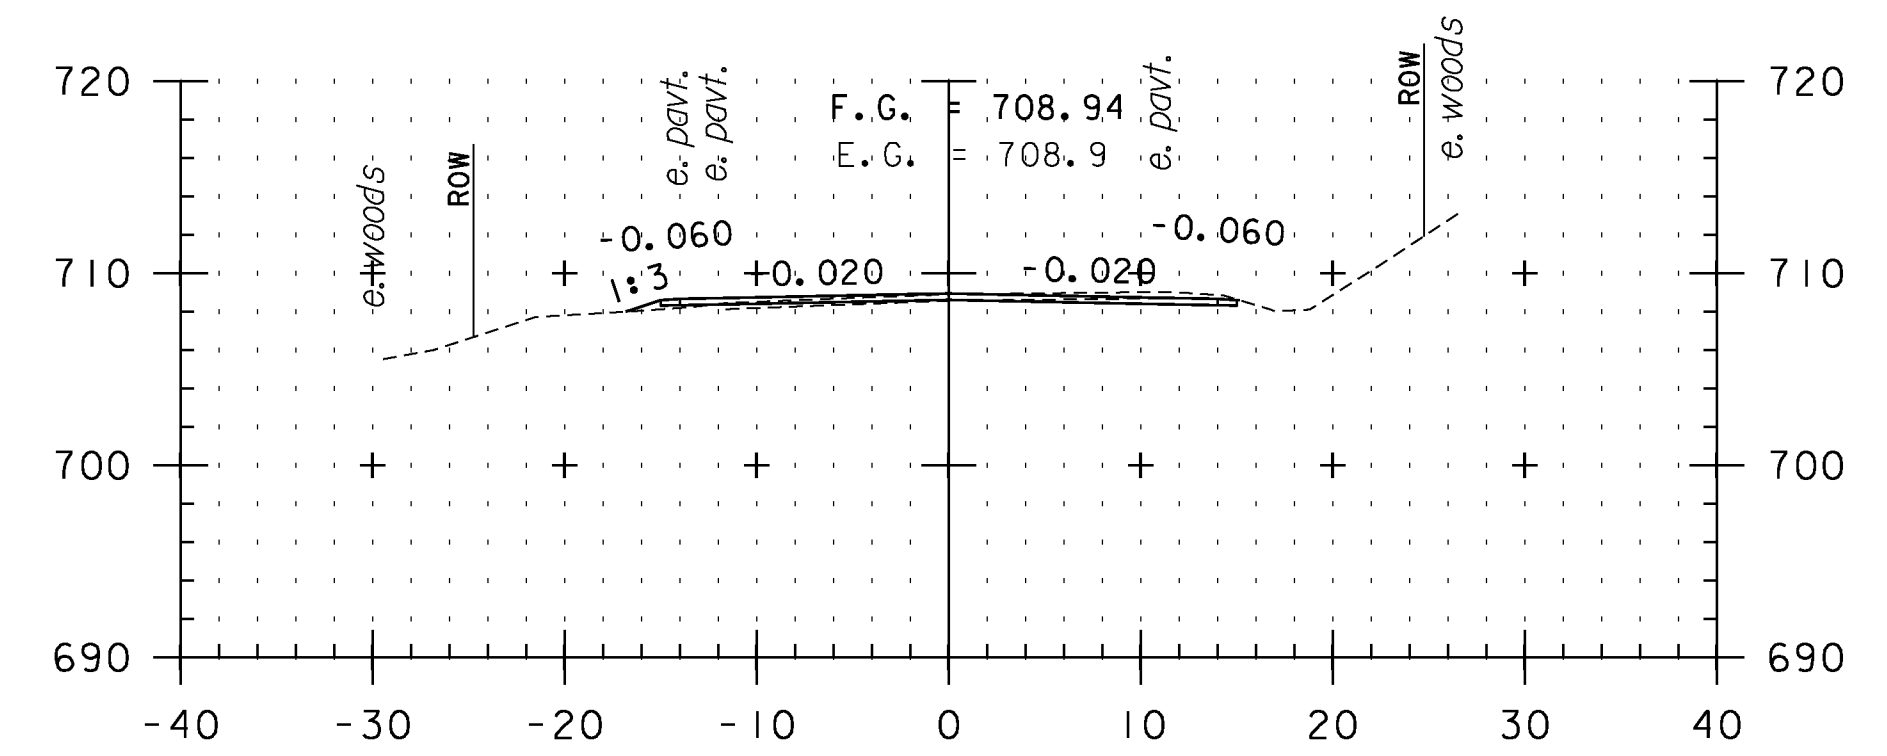


T3+00

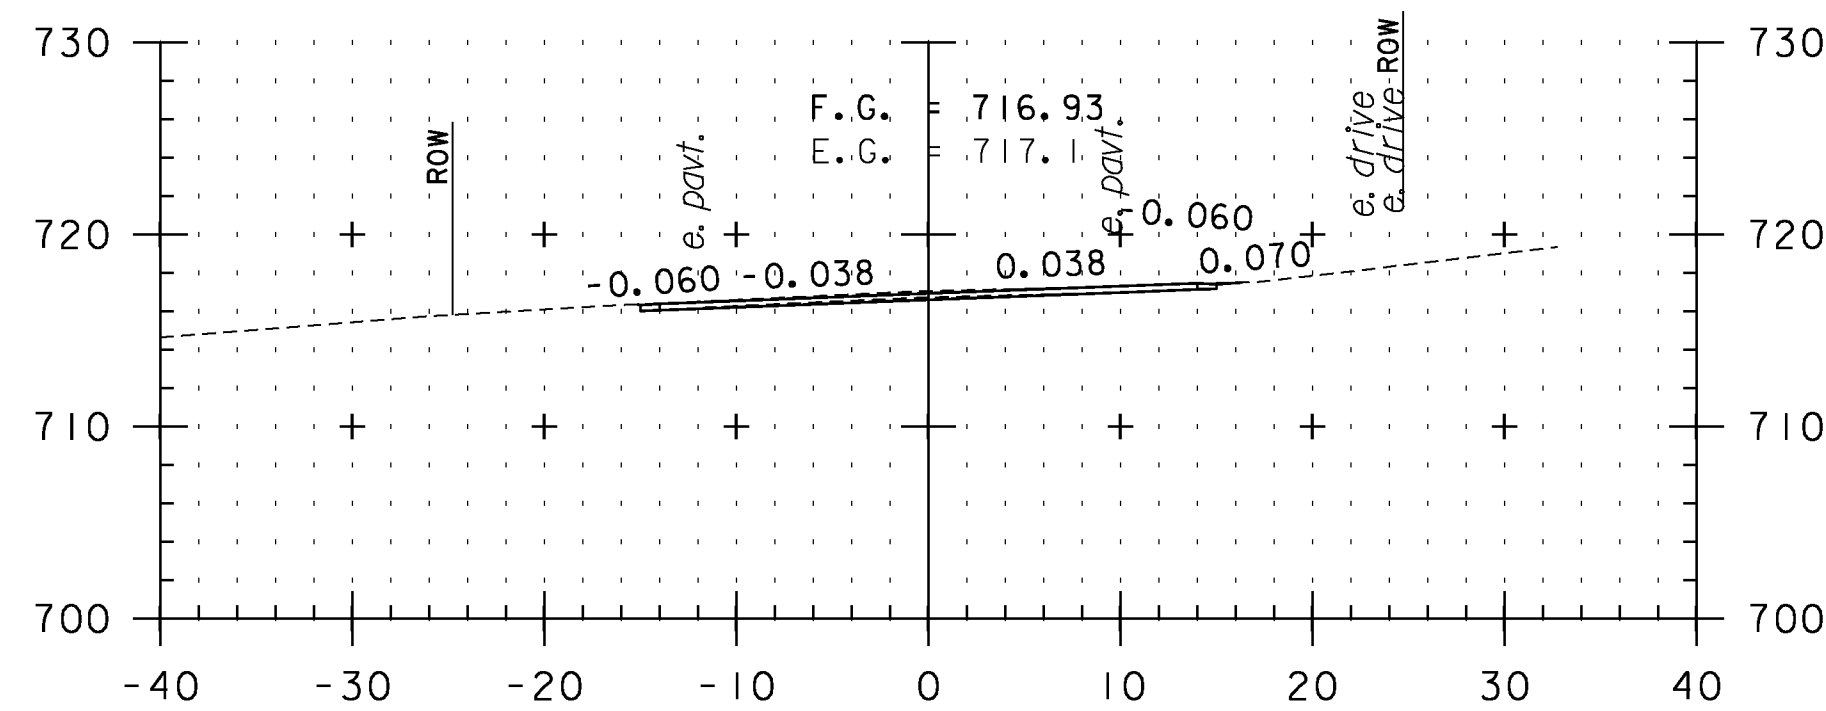


T1+50

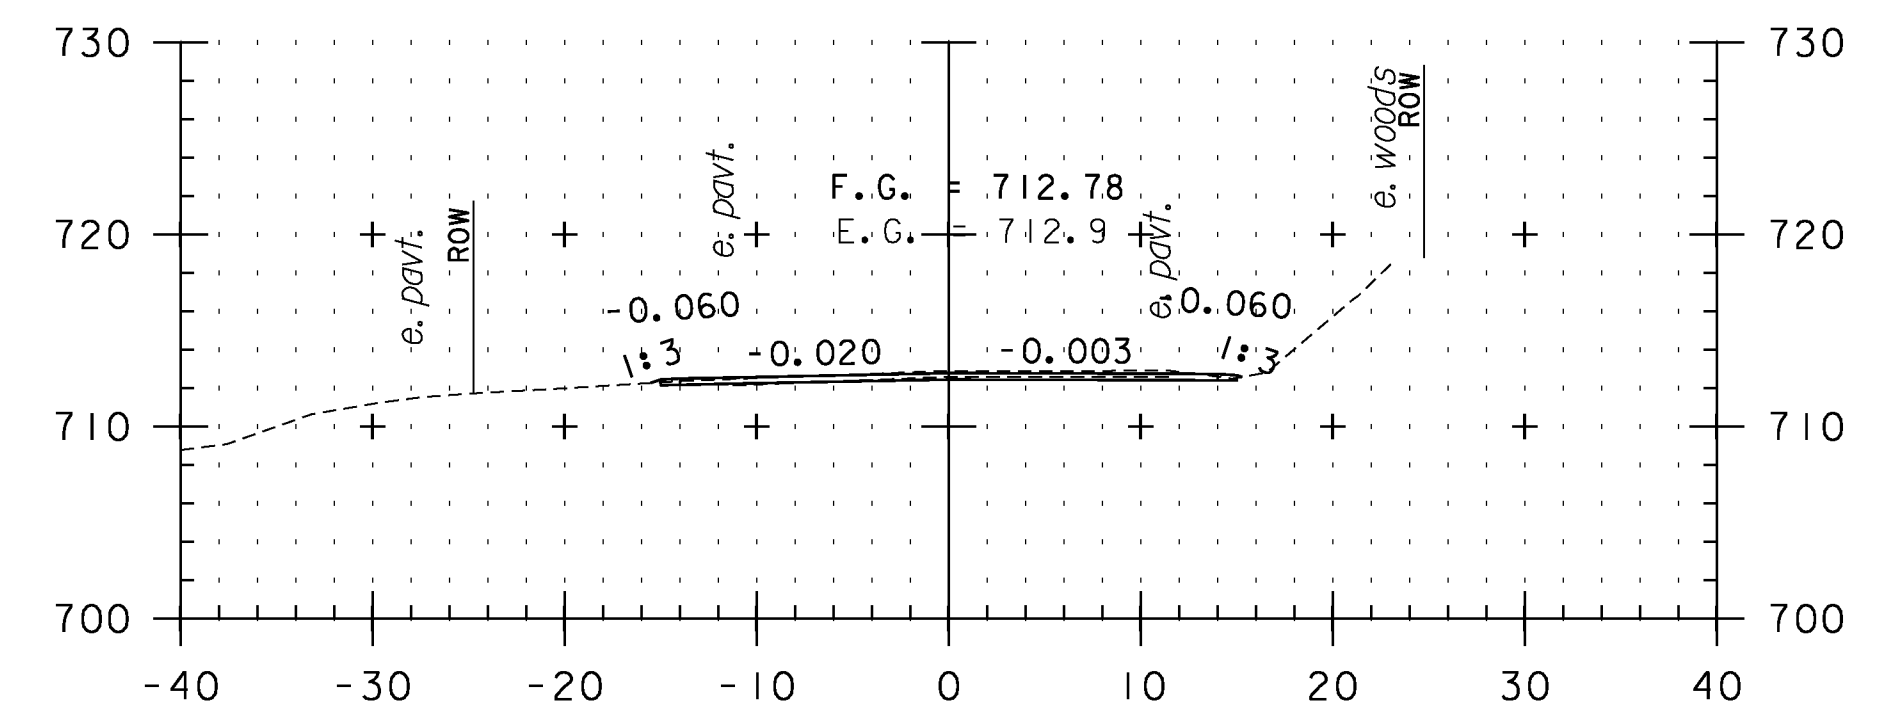


T2+50

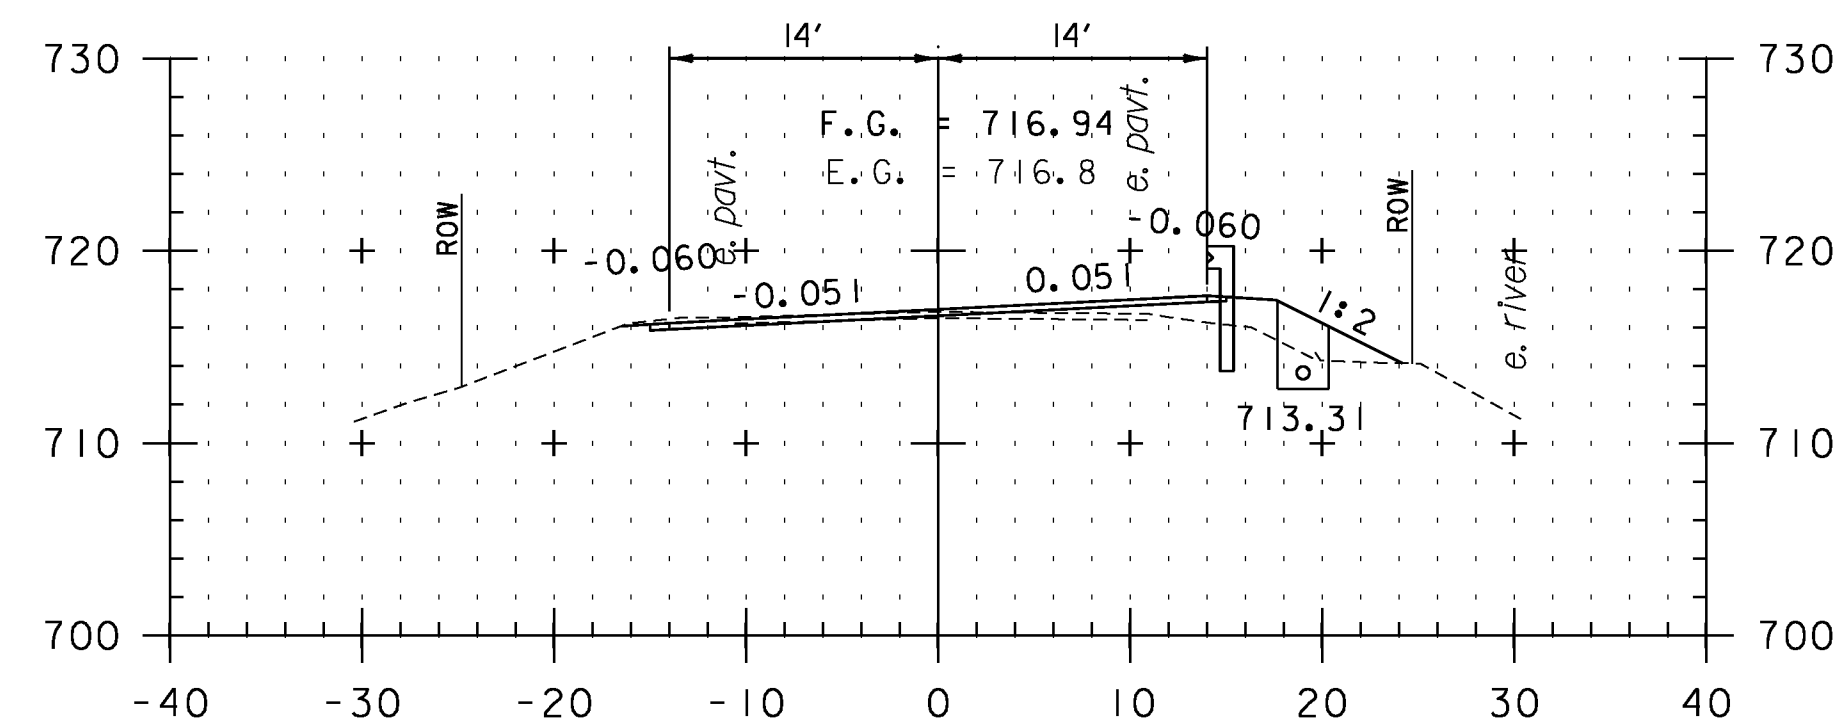

T0+00

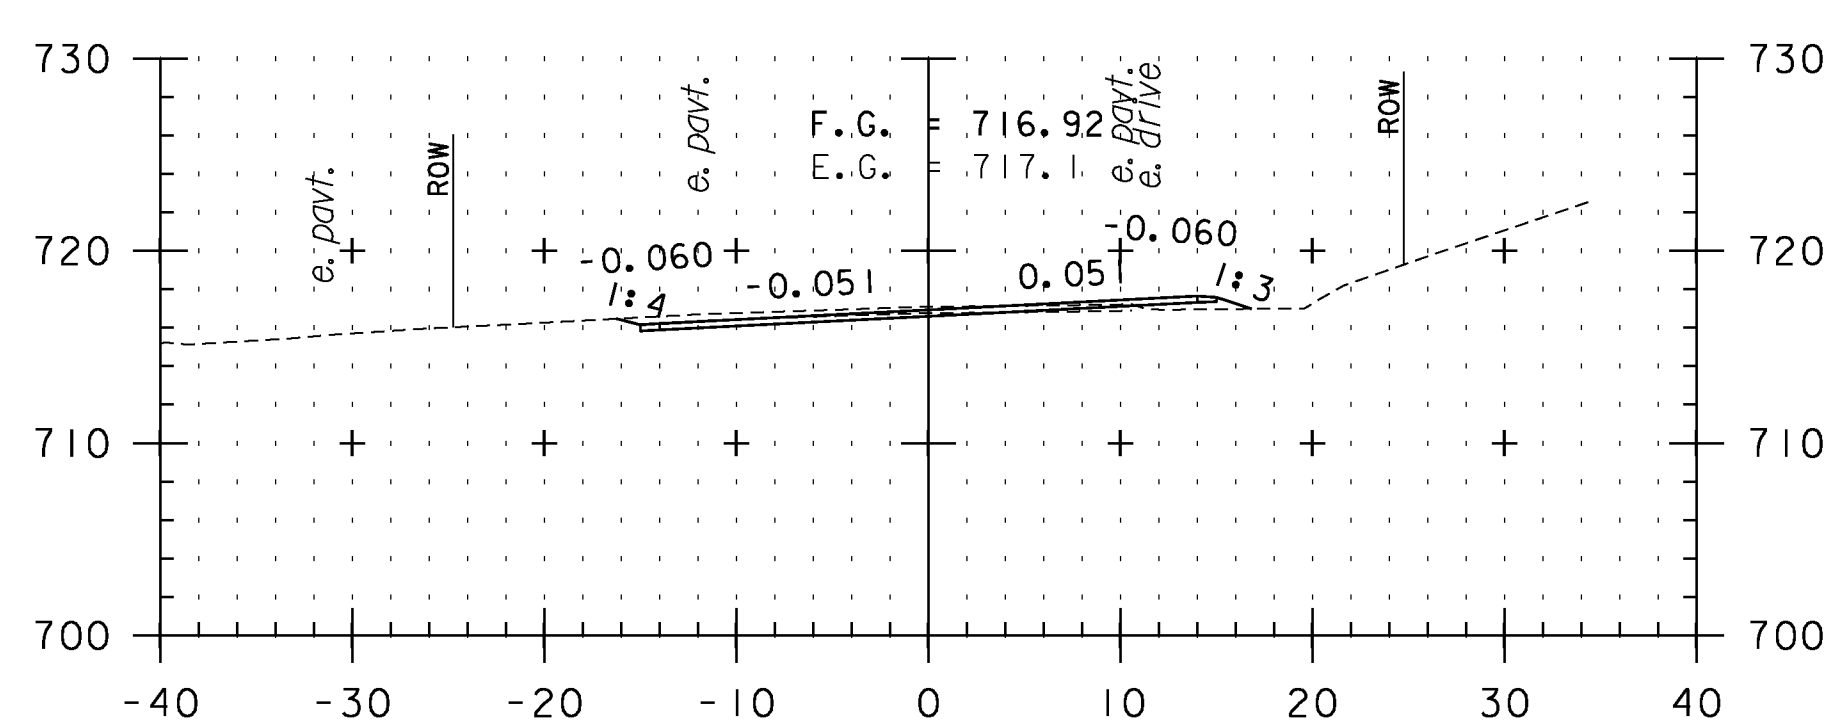


T1+00

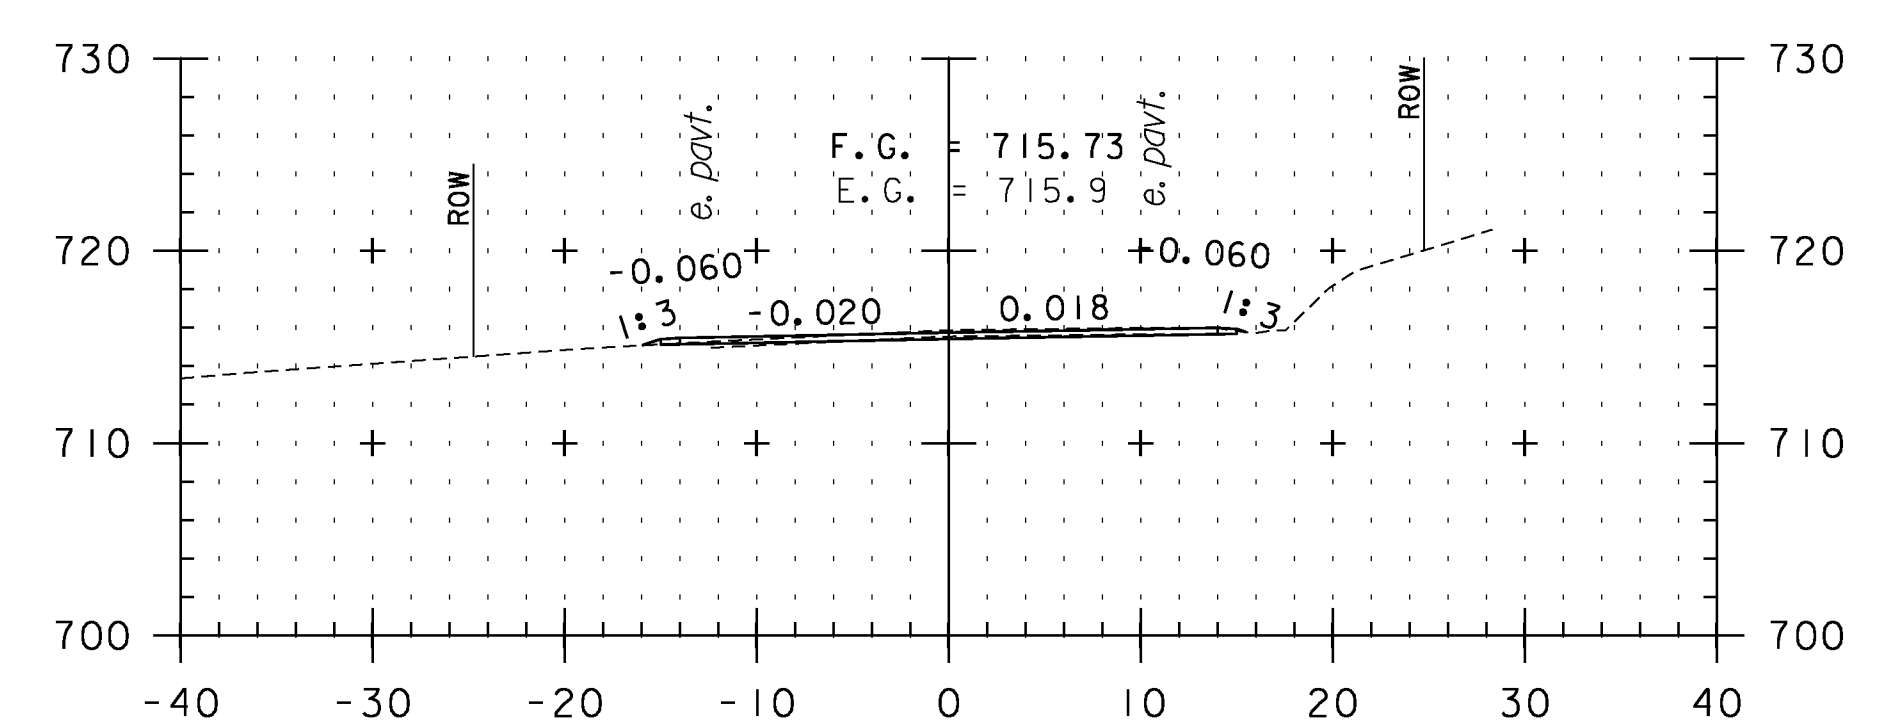

T2+00

CROSS SECTION SHEET 87

STA. T0+00 TO STA. T3+00

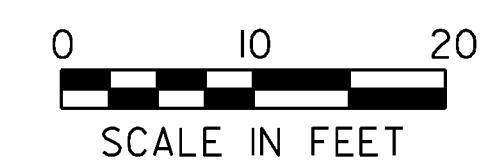

PROJECT NAME: VERSHIRE-THETFORD	PLOT DATE: 1/29/2013
PROJECT NUMBER: STP 2911(I)	DRAWN BY: SNG
FILE NAME: pl0c224.dgn	CHECKED BY: PTS
PROJECT LEADER: PTS	SHEET 195 OF 232
DESIGNED BY: NLL	
IPARM FILE NAME: IOC224_195	