




T9+00

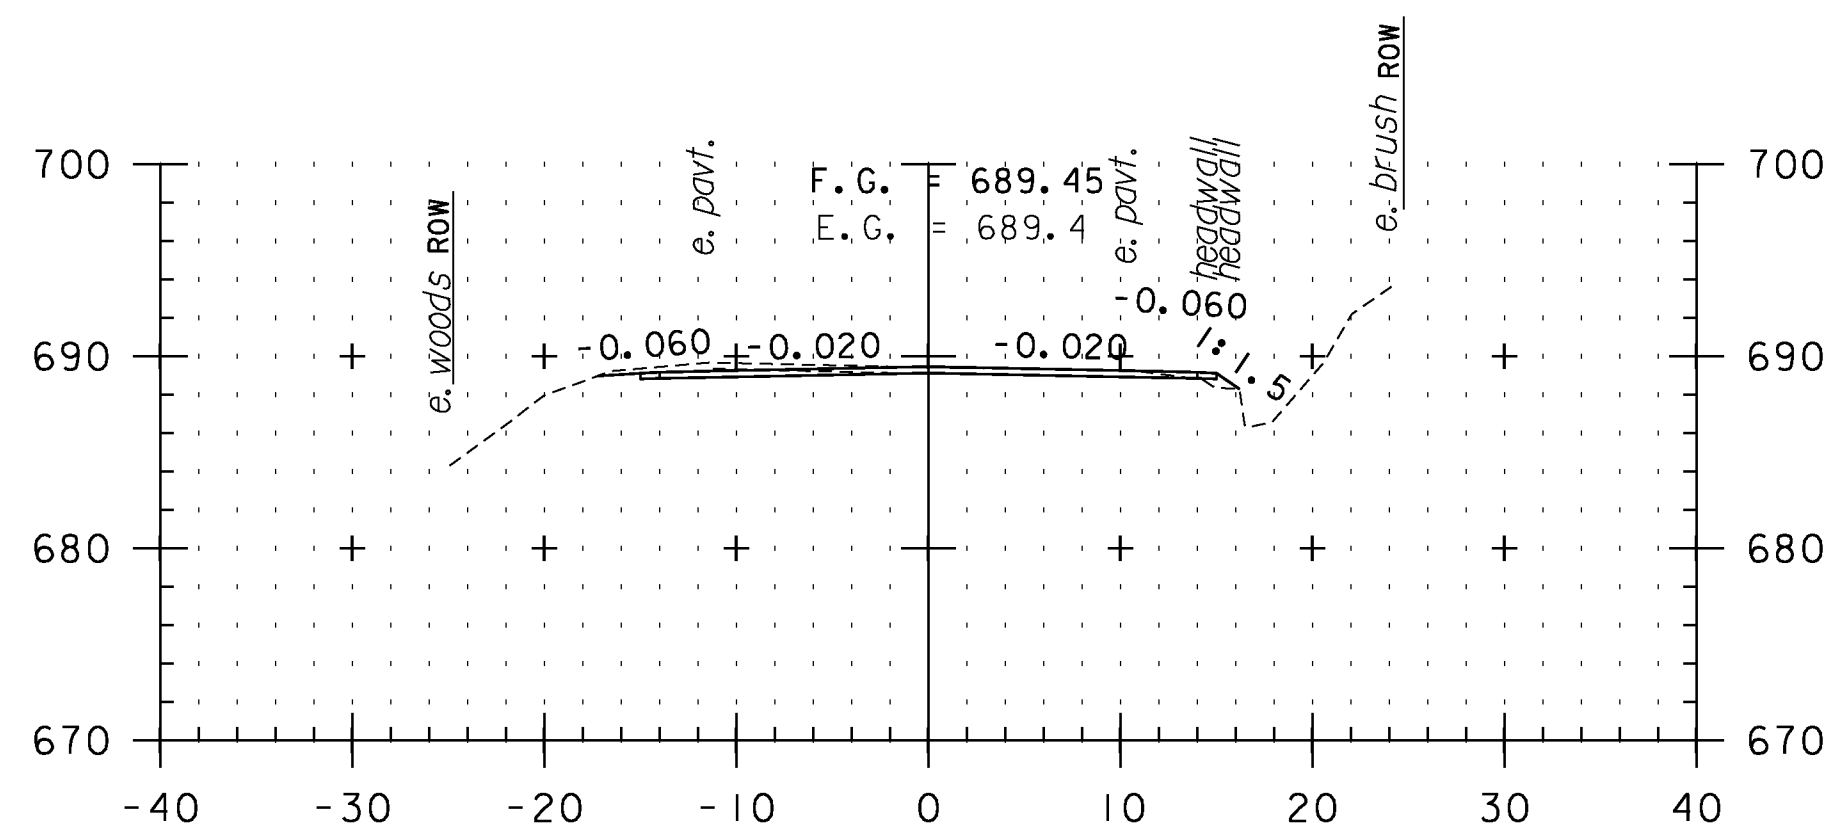


T10+50

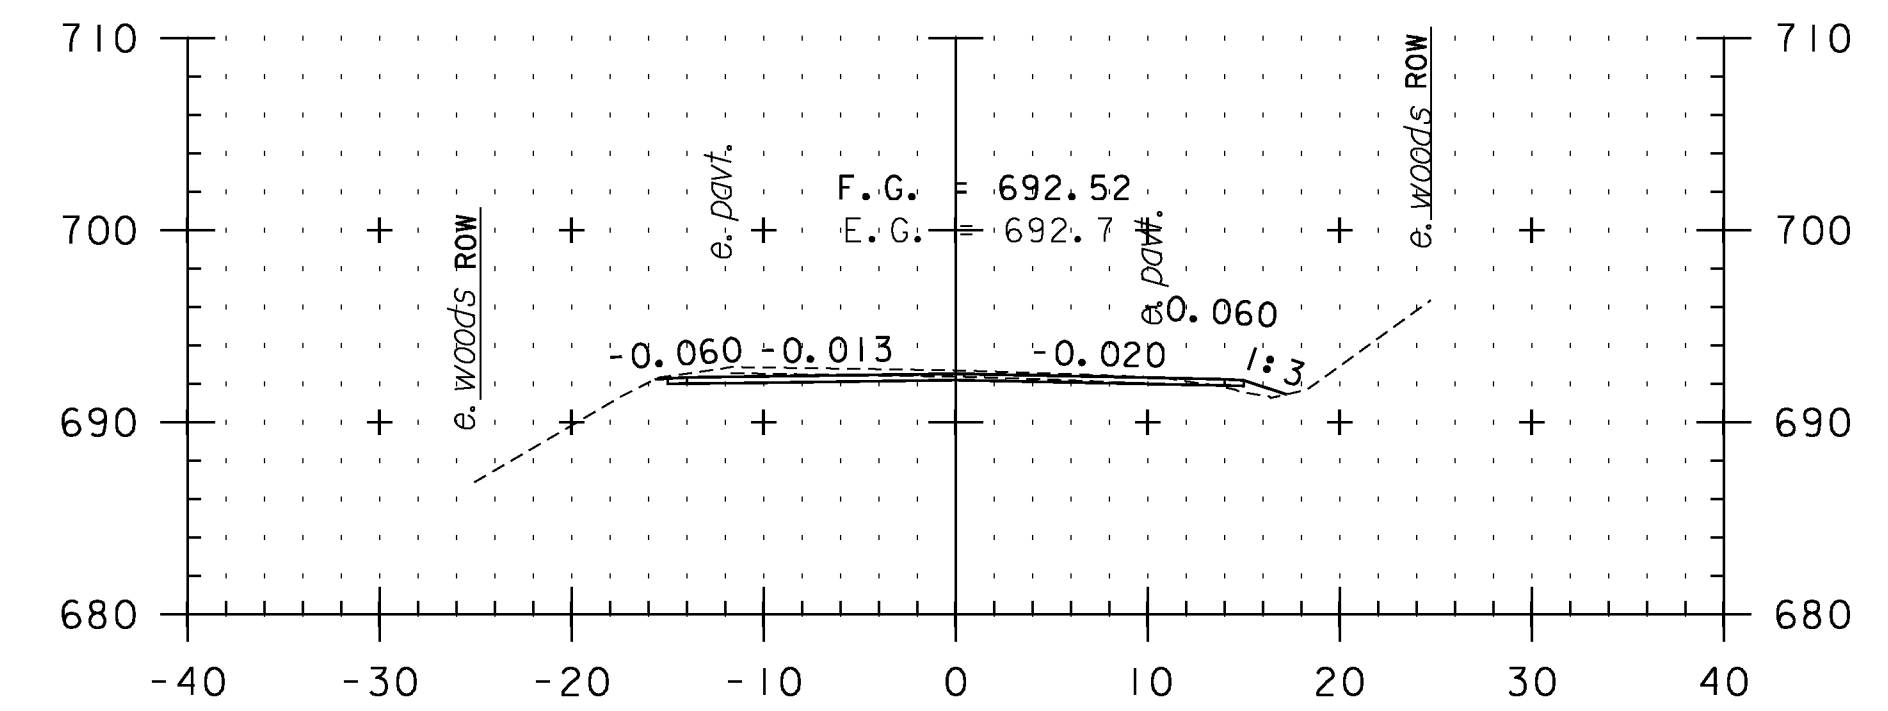


T12+00

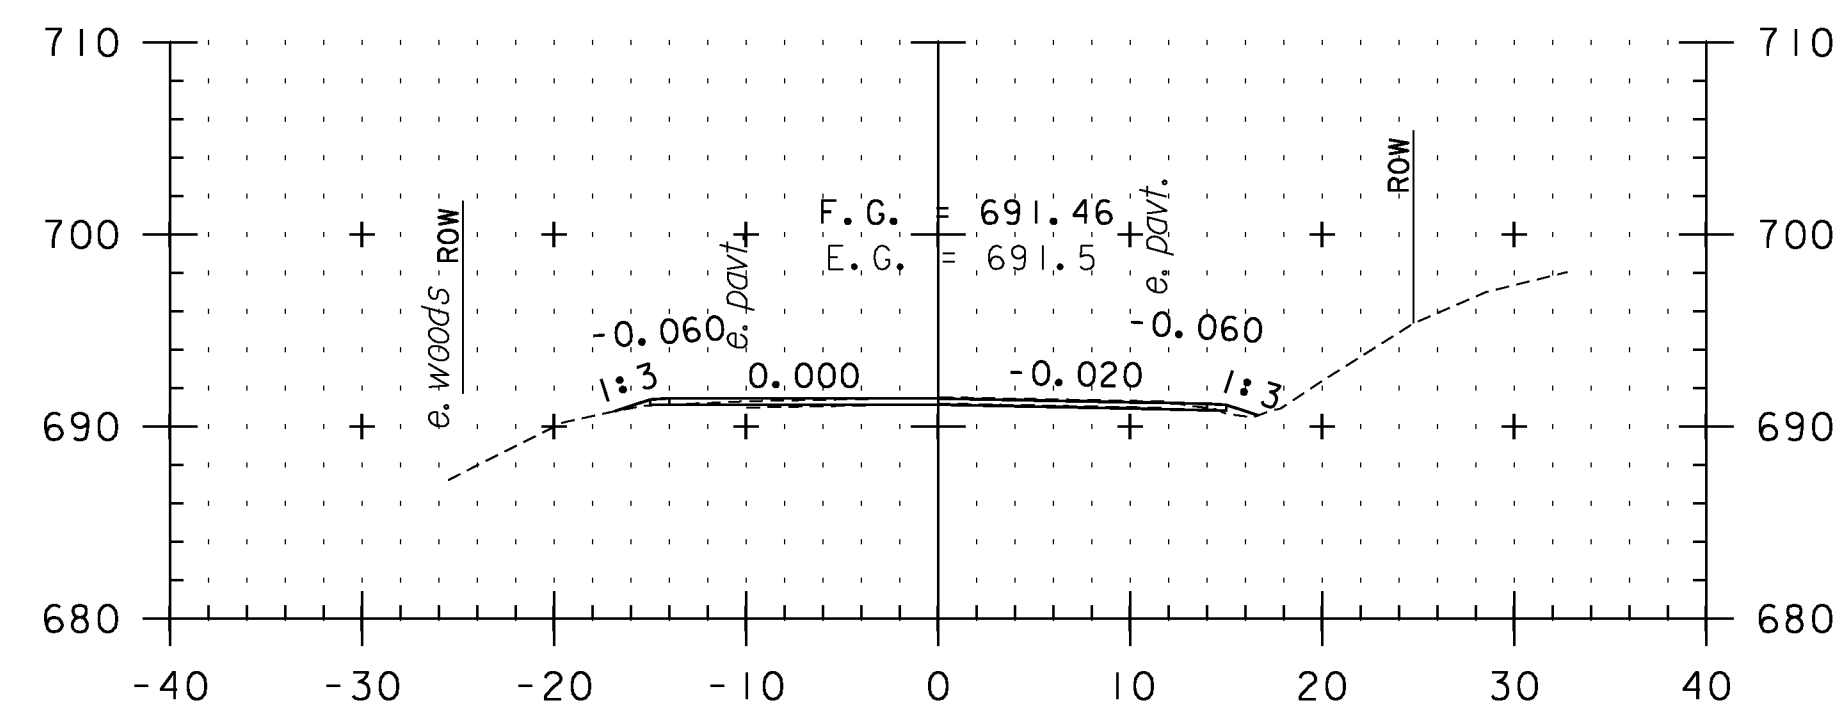


T8+50

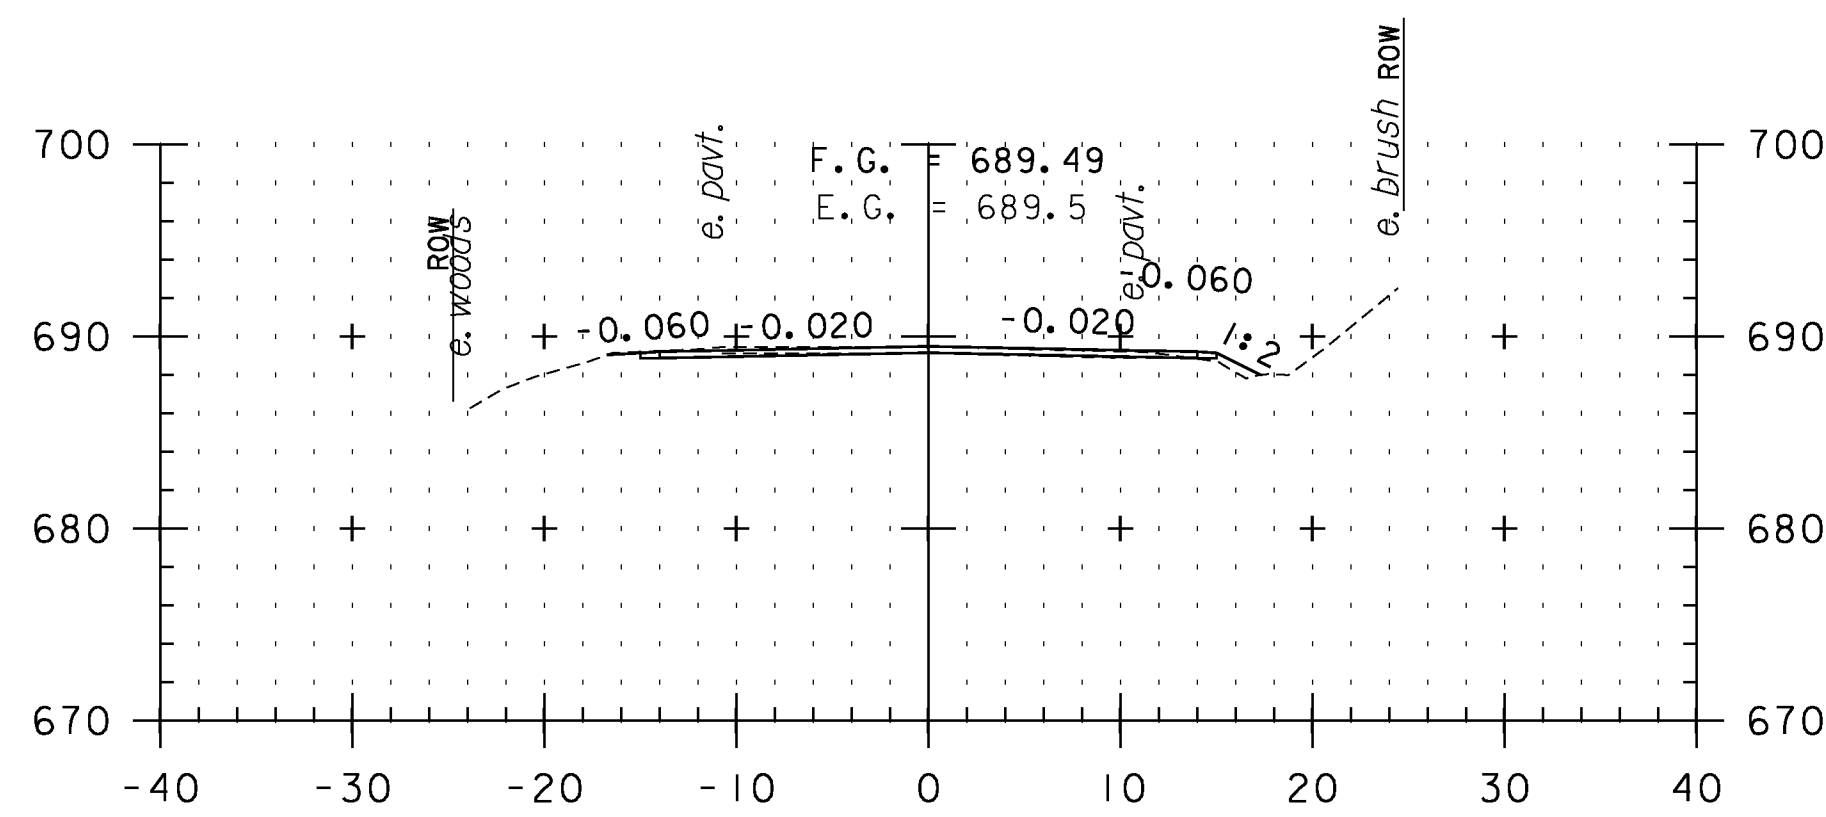


T10+00

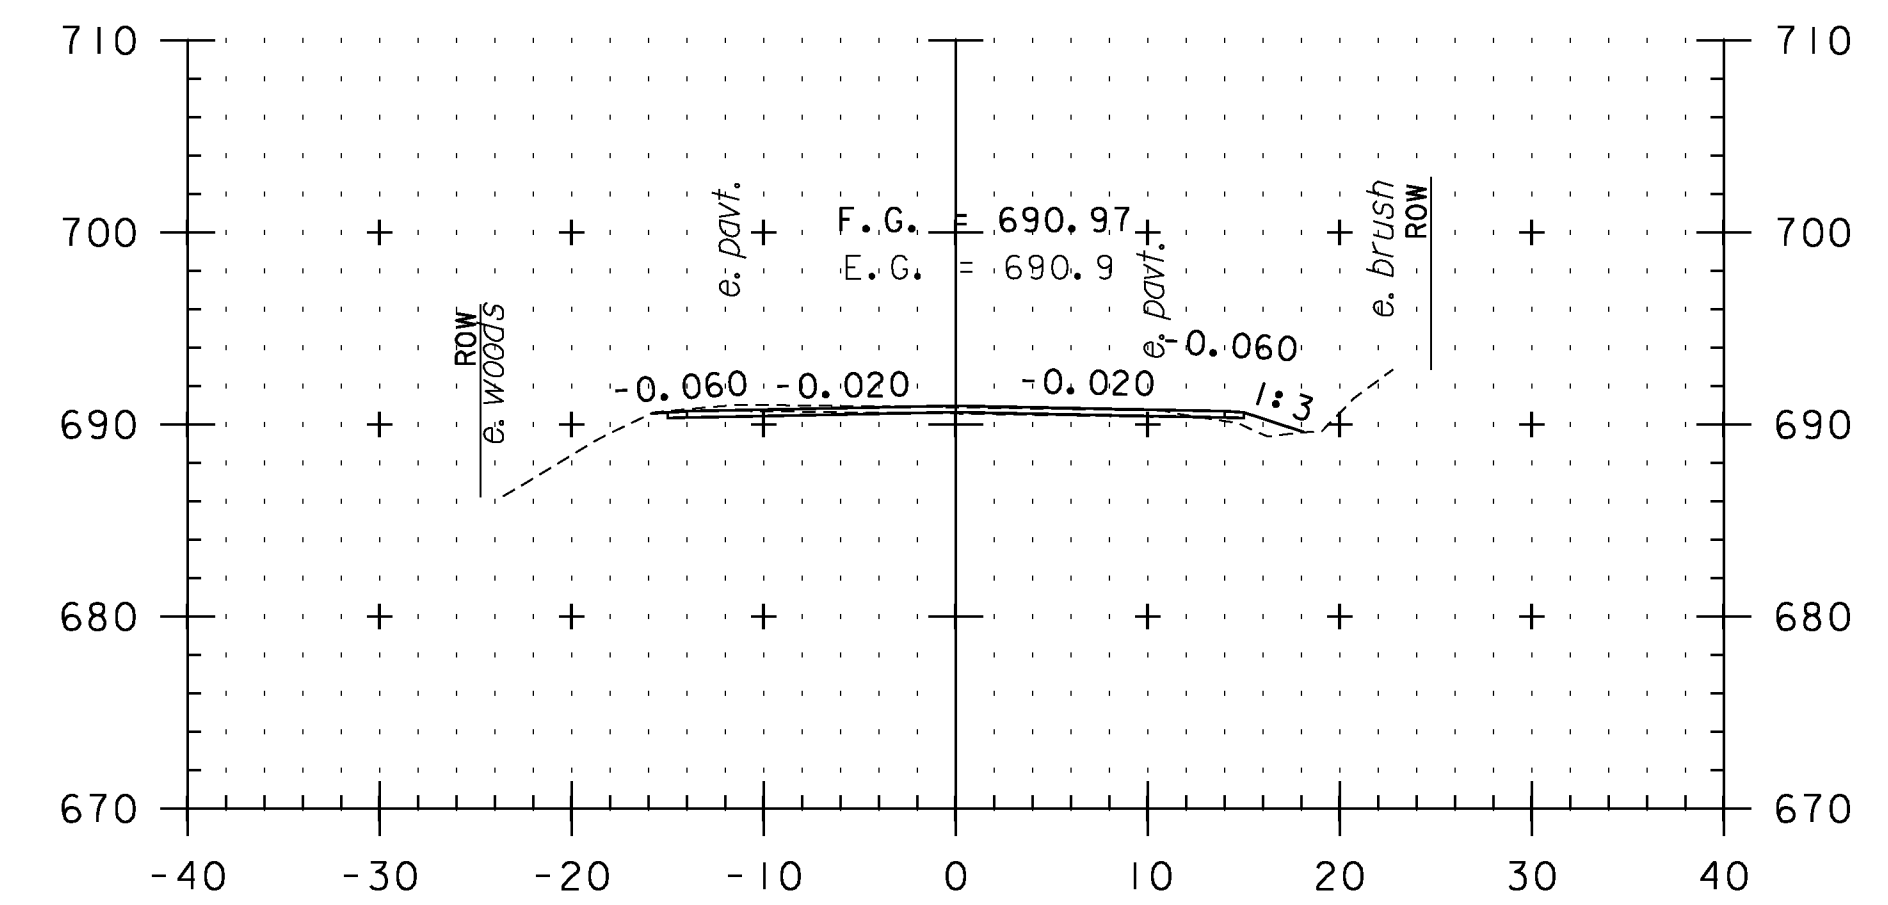


T11+50

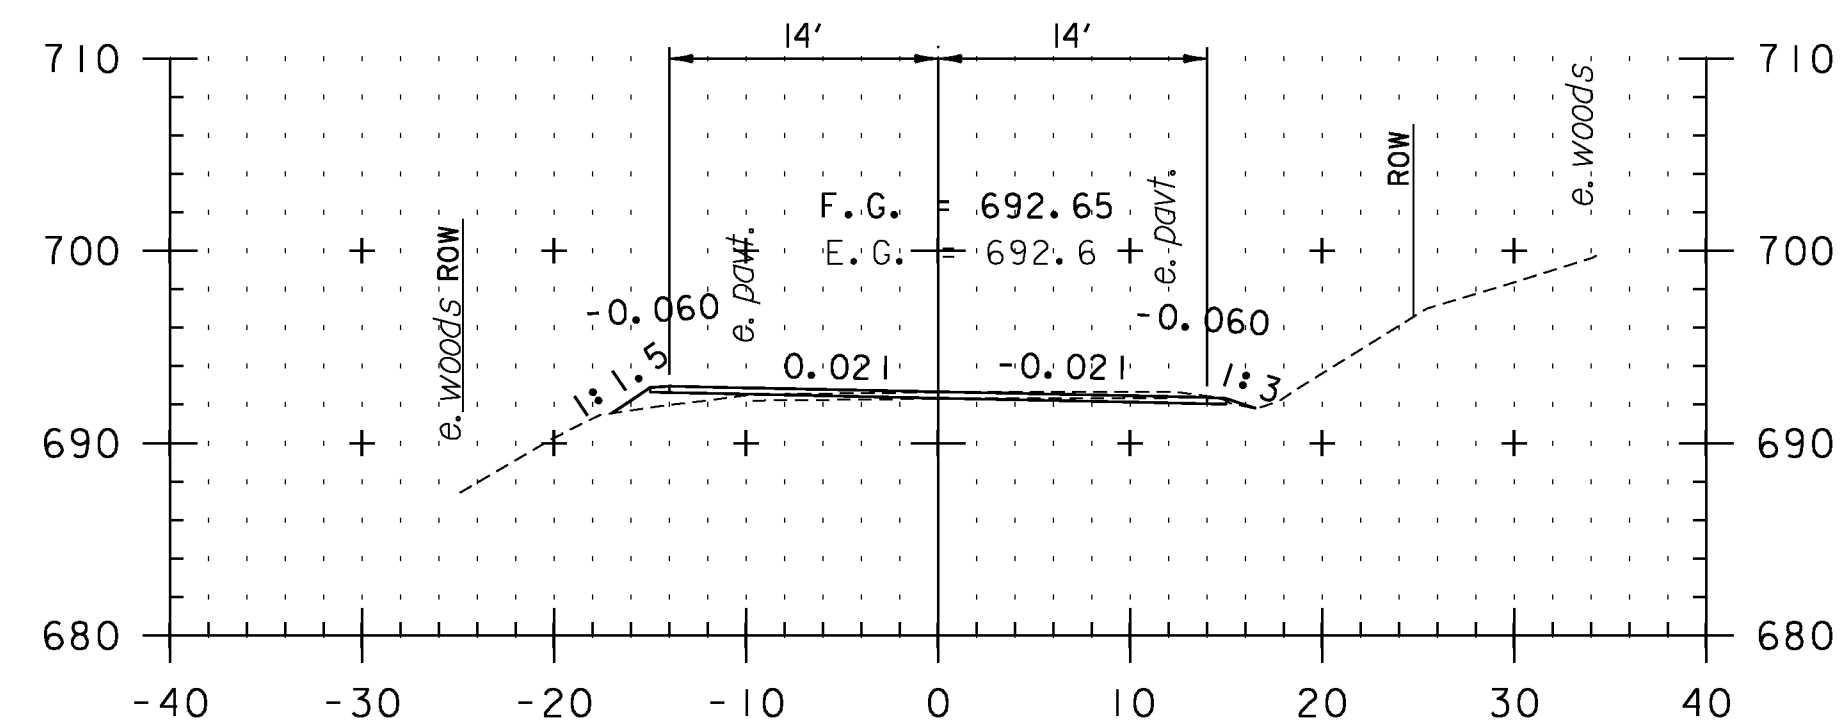

T8+00

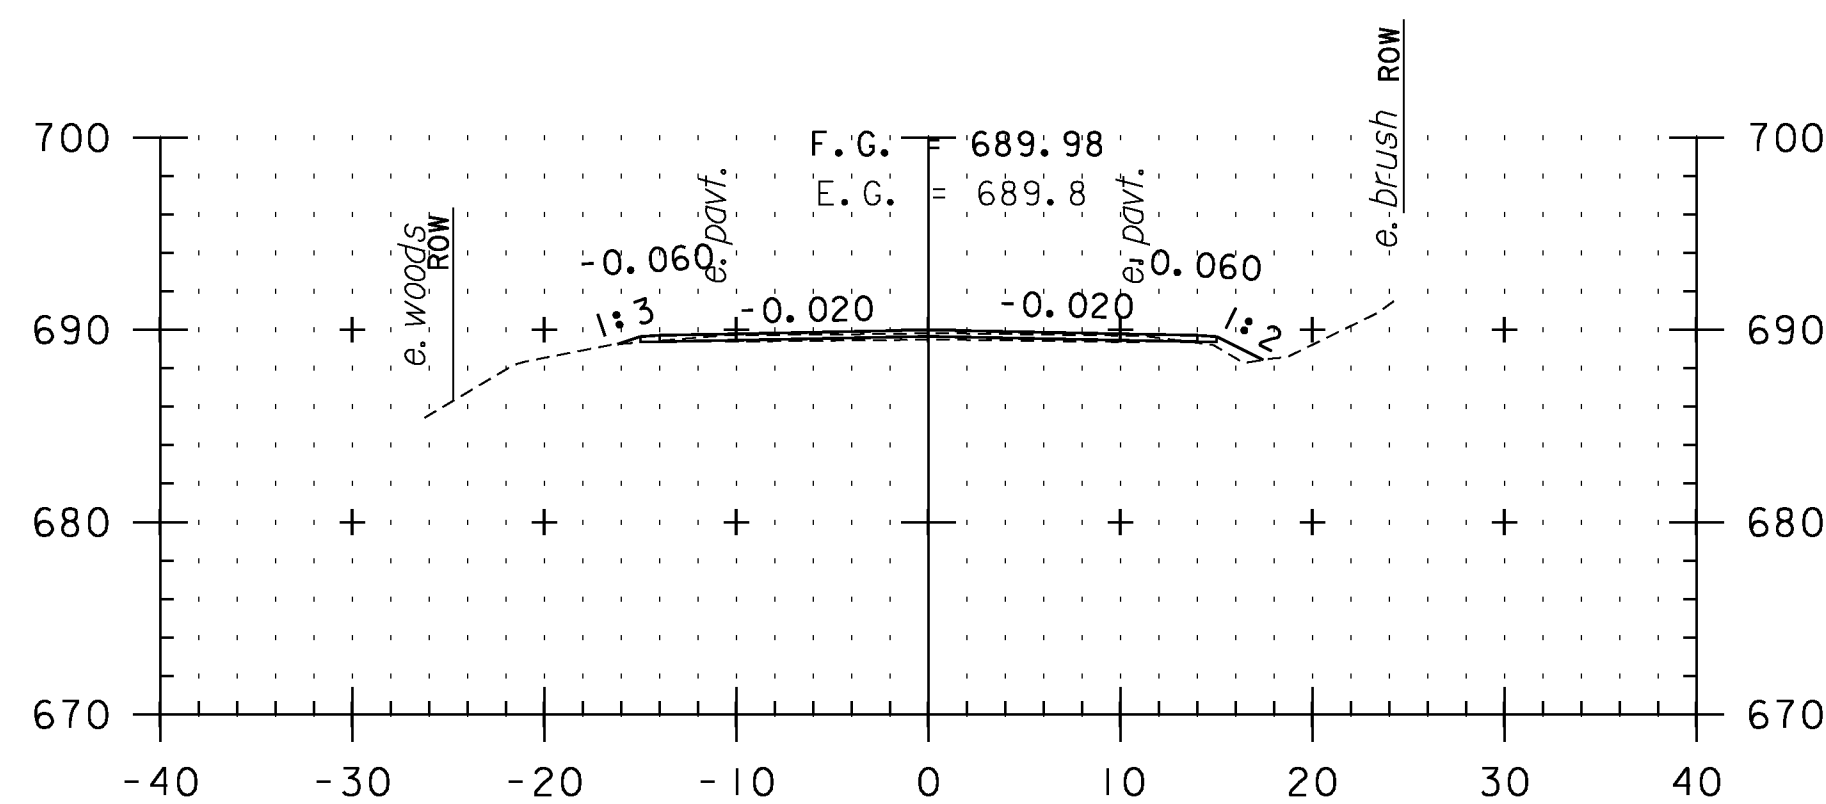


T9+50

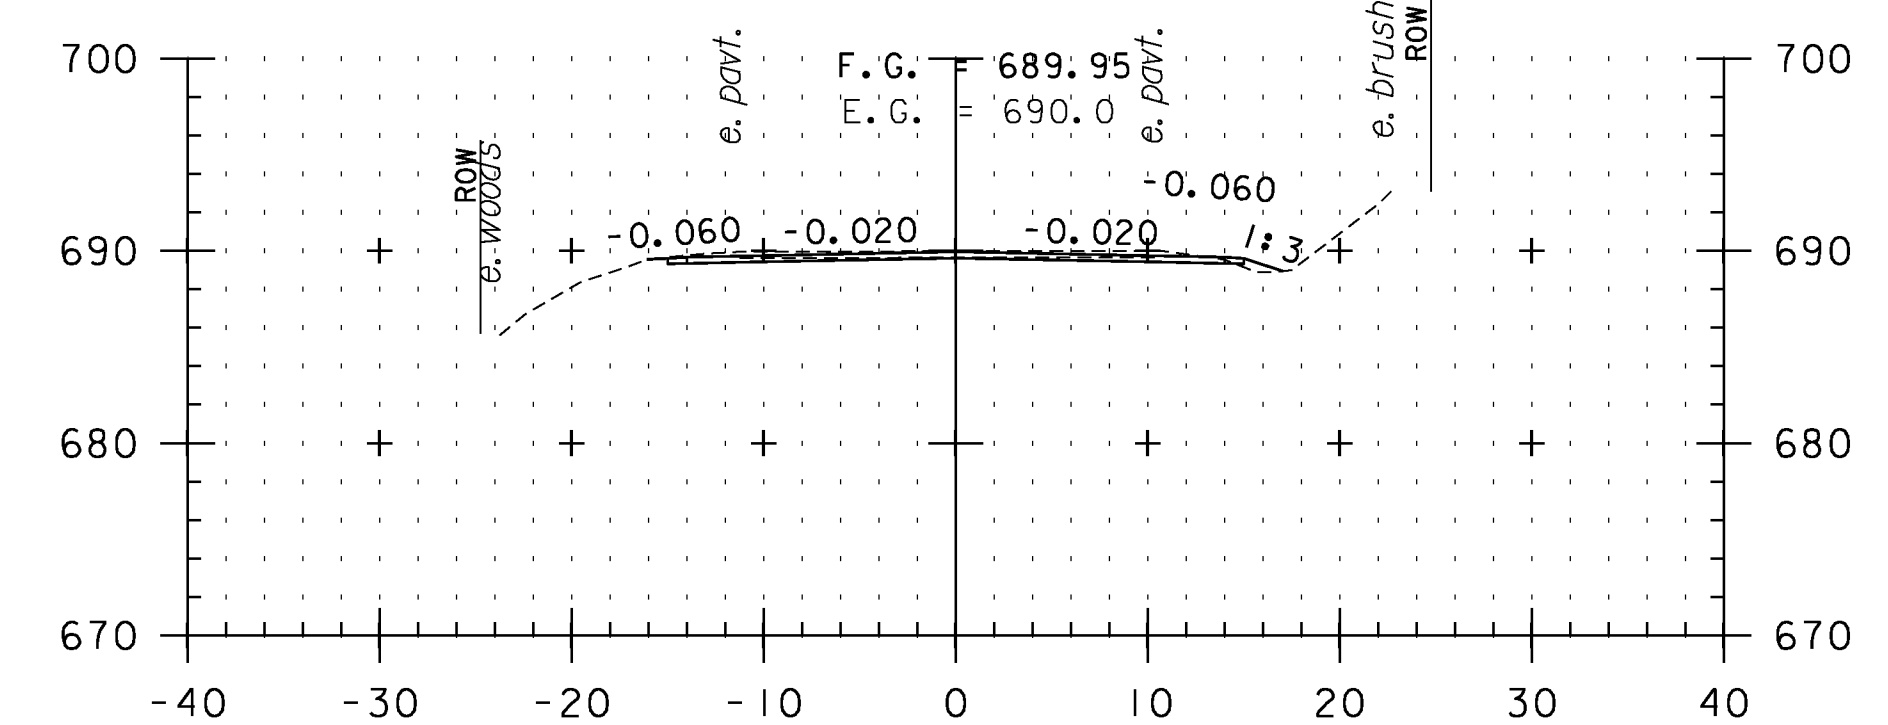

T11+00

**CROSS SECTION SHEET 89**

STA. T8+00 TO STA. T12+00

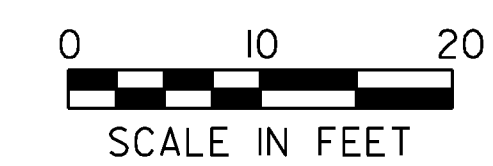

PROJECT NAME: VERSHIRE-THETFORD	PLOT DATE: 1/29/2013
PROJECT NUMBER: STP 2911(I)	DRAWN BY: SNG
FILE NAME: pl0c224.dgn	CHECKED BY: PTS
PROJECT LEADER: PTS	SHEET 197 OF 232
DESIGNED BY: NLL	
IPARM FILE NAME: IOC224_I97	