




T 13+50

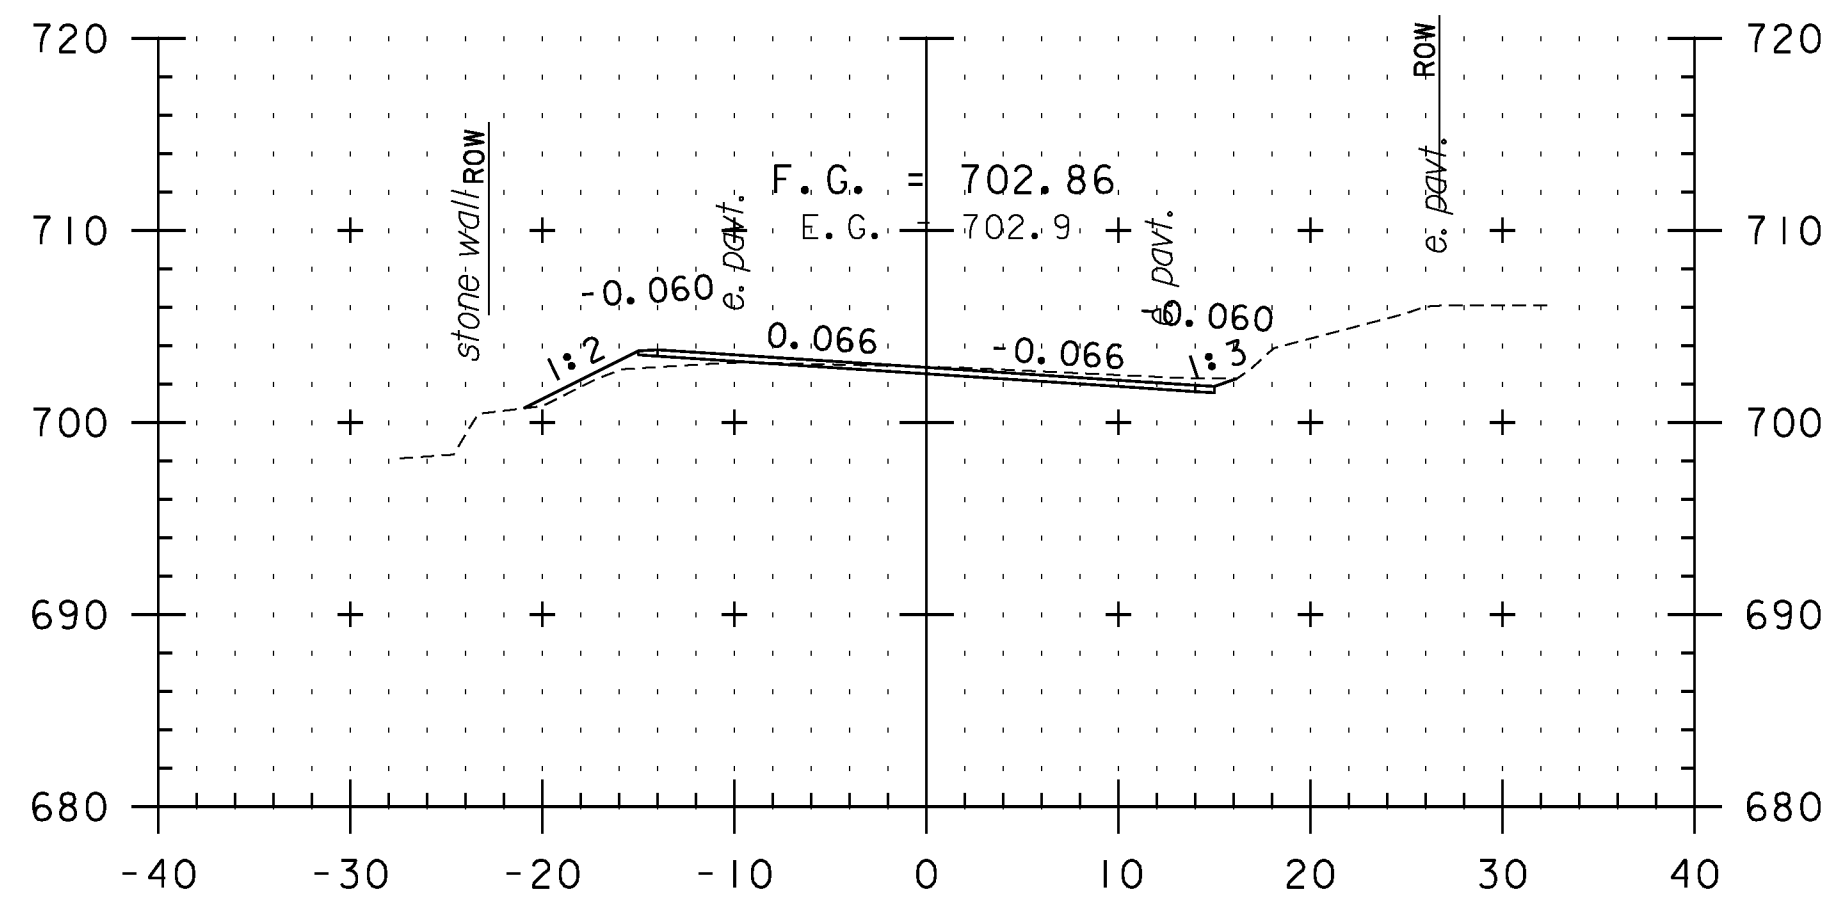


T 15+00

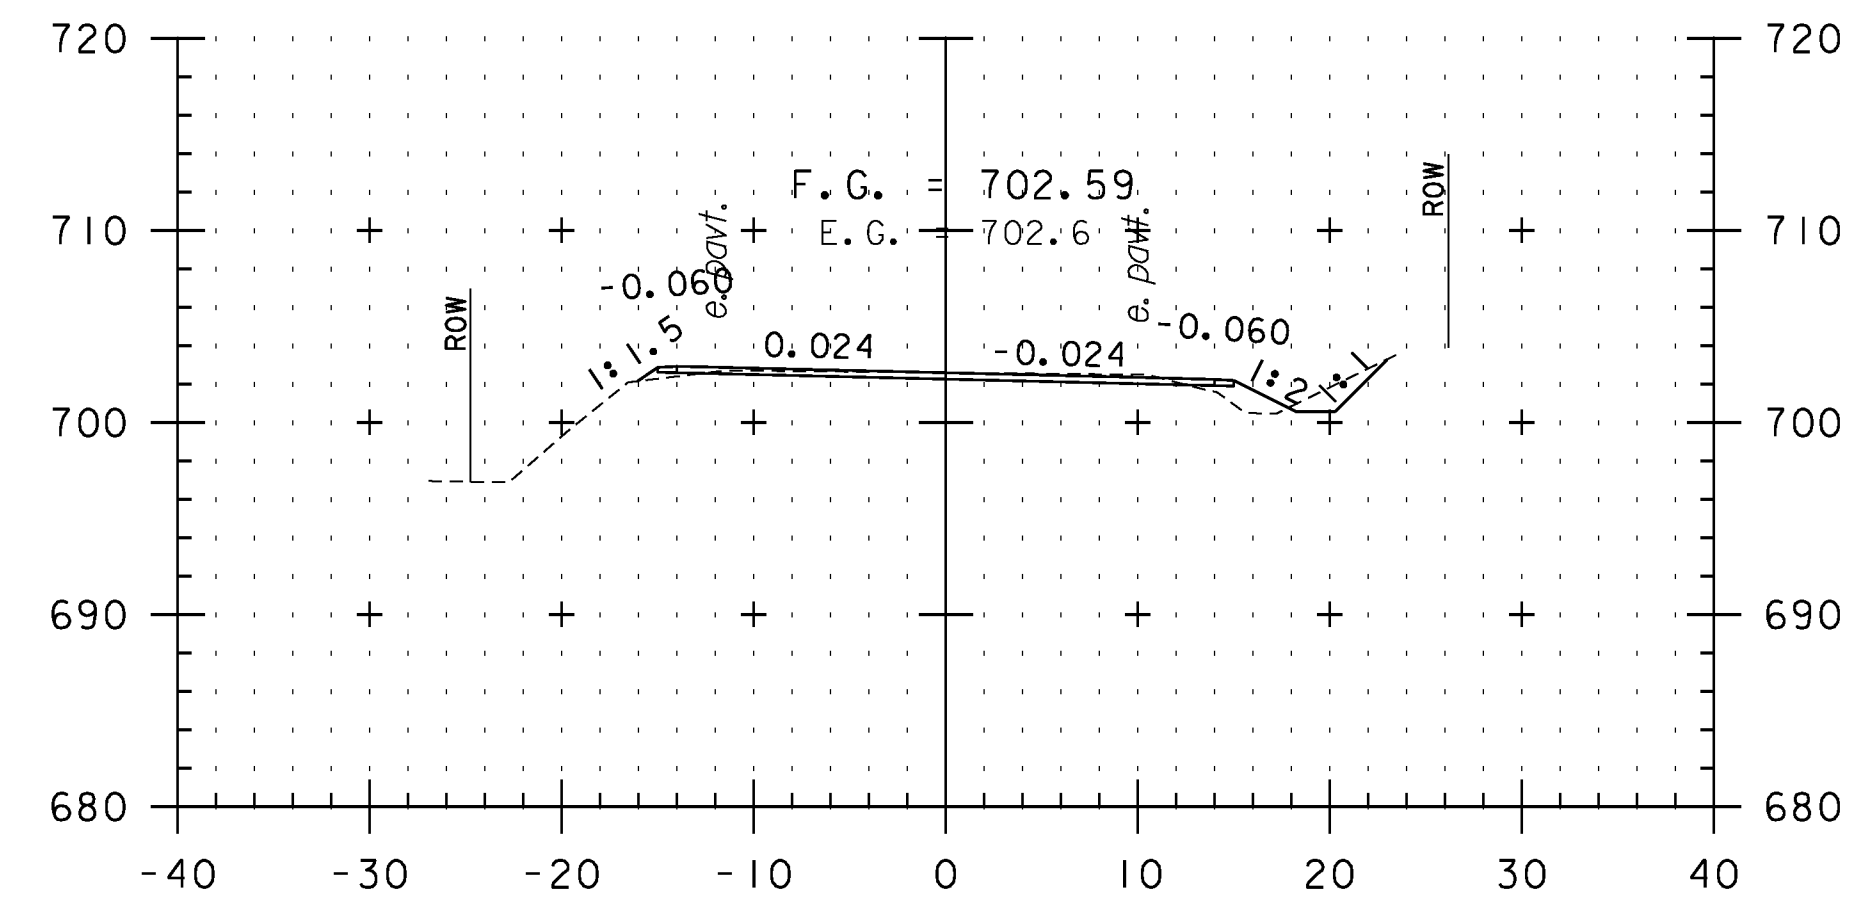


T 16+50

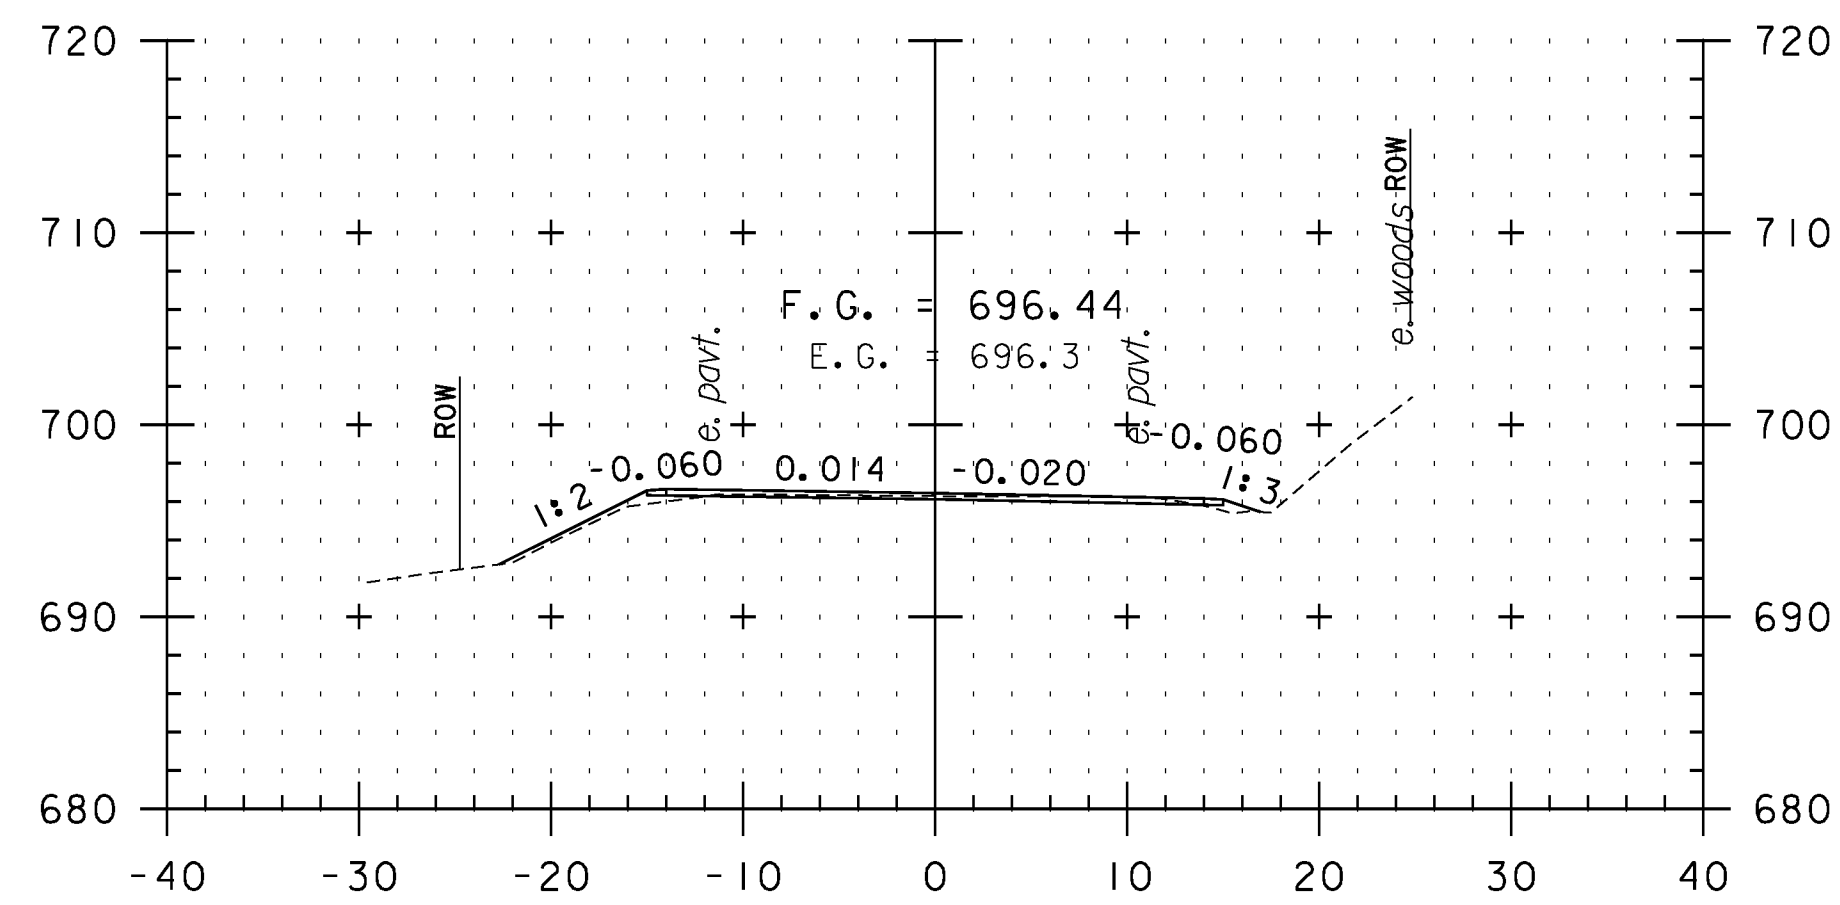


T 13+00

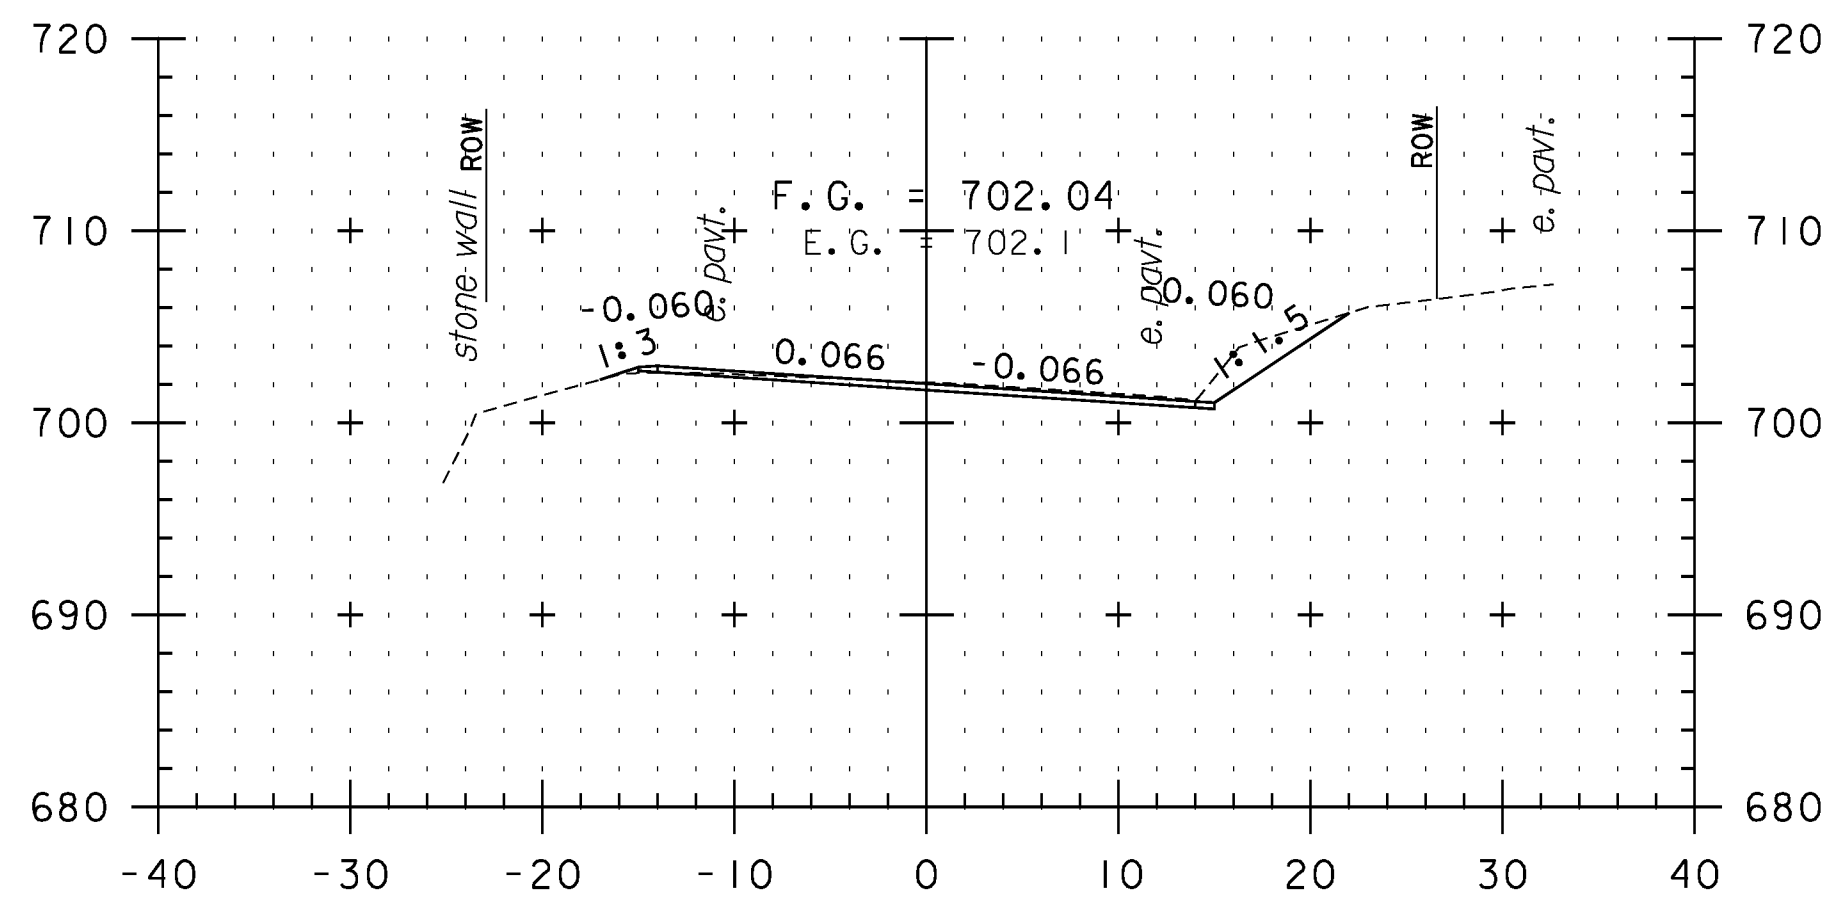


T 14+50

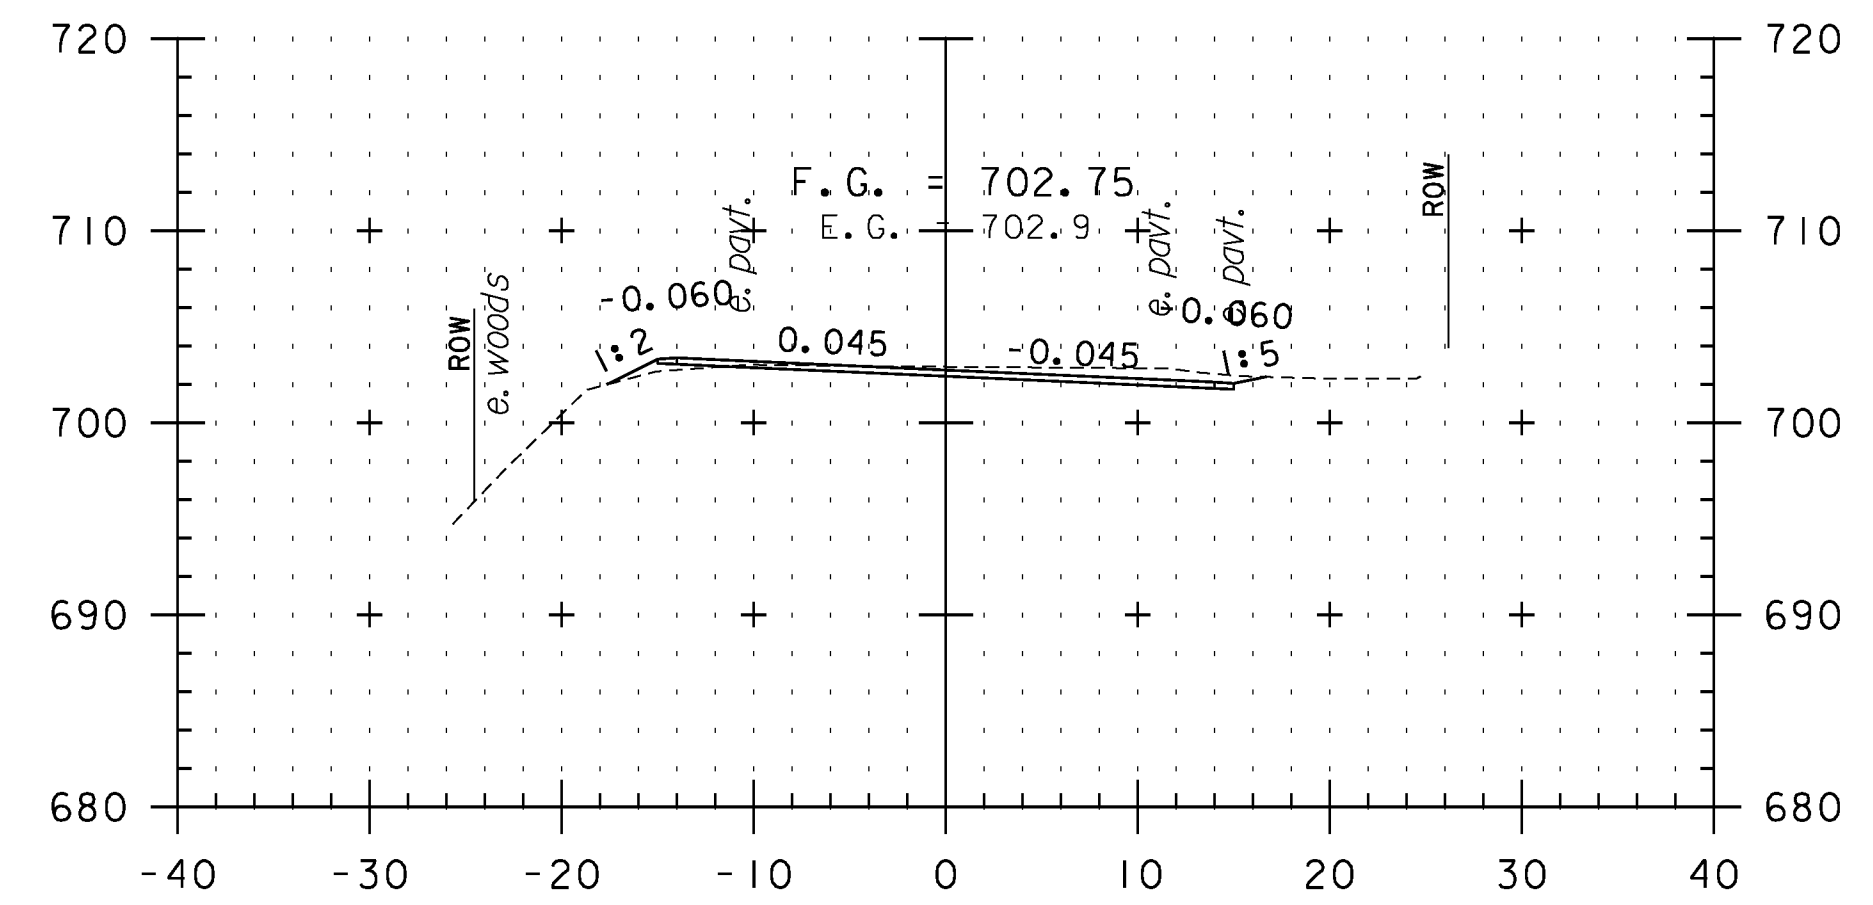


T 16+00

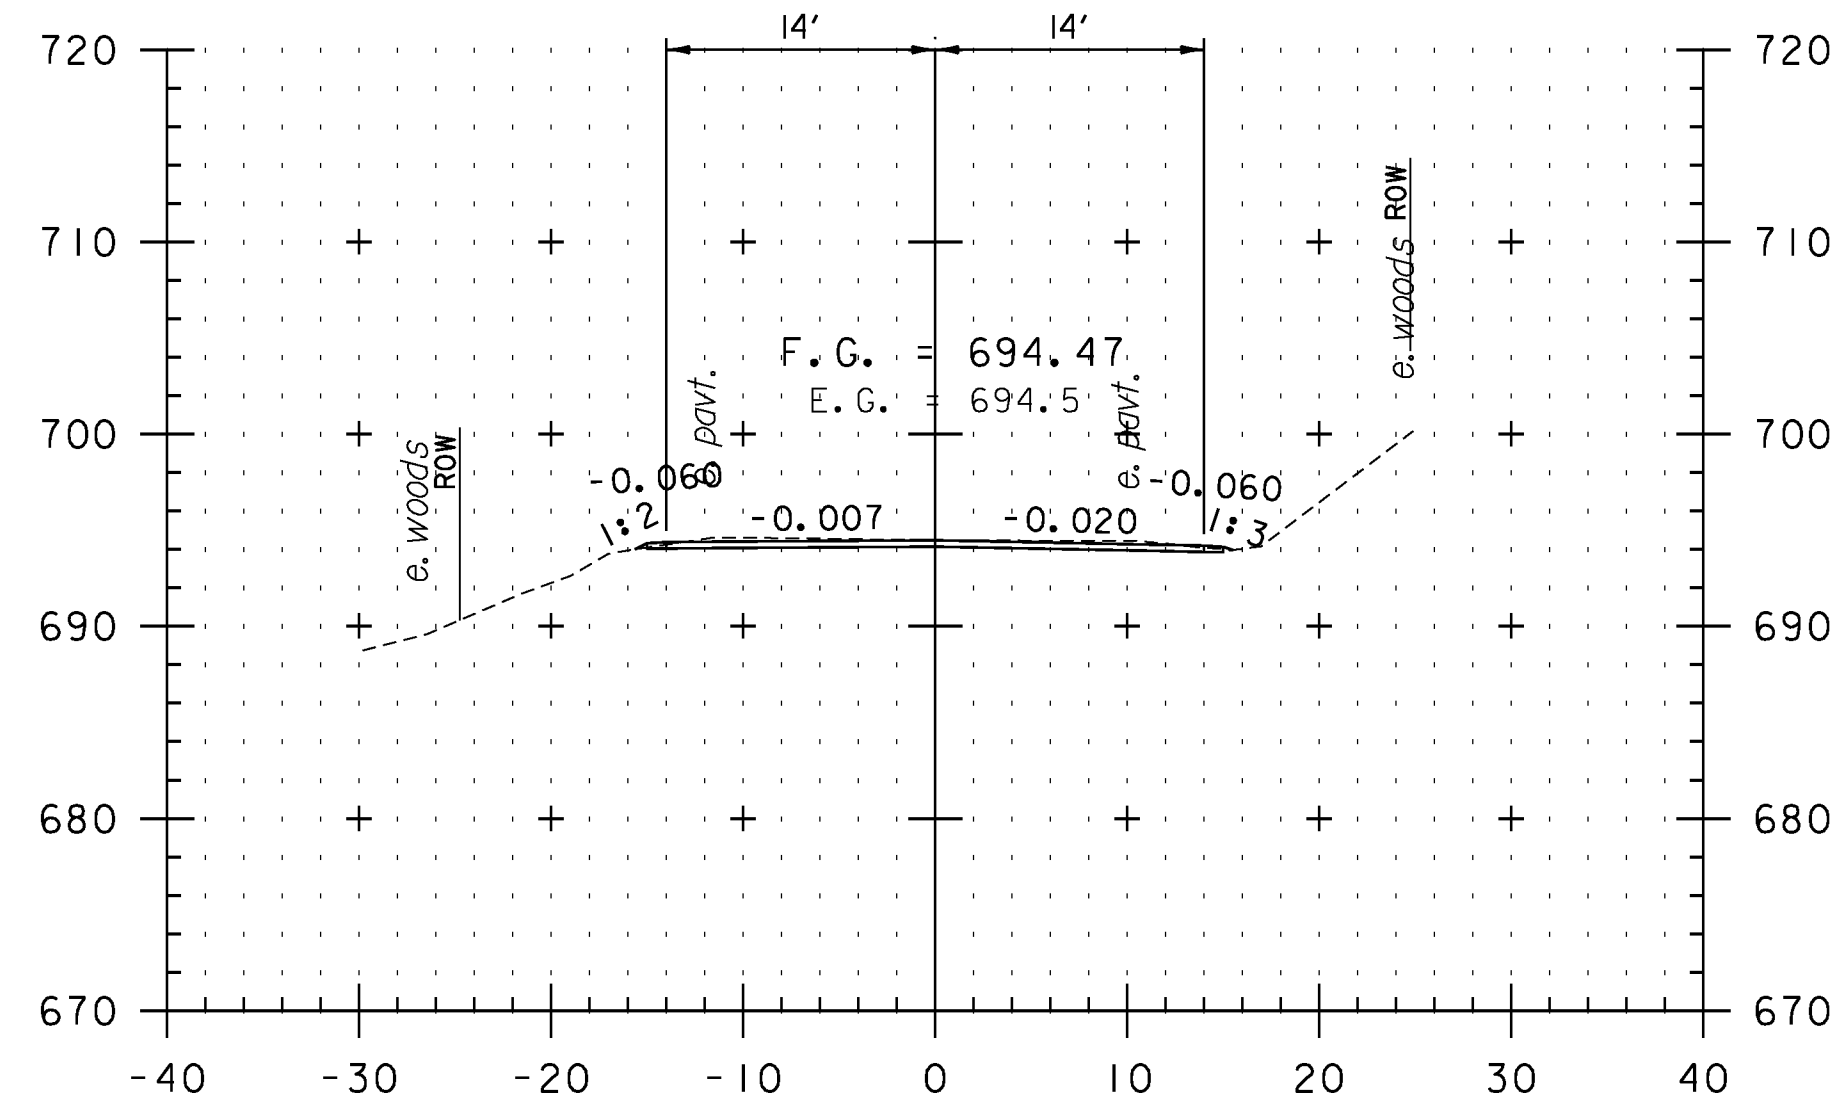

T 12+50

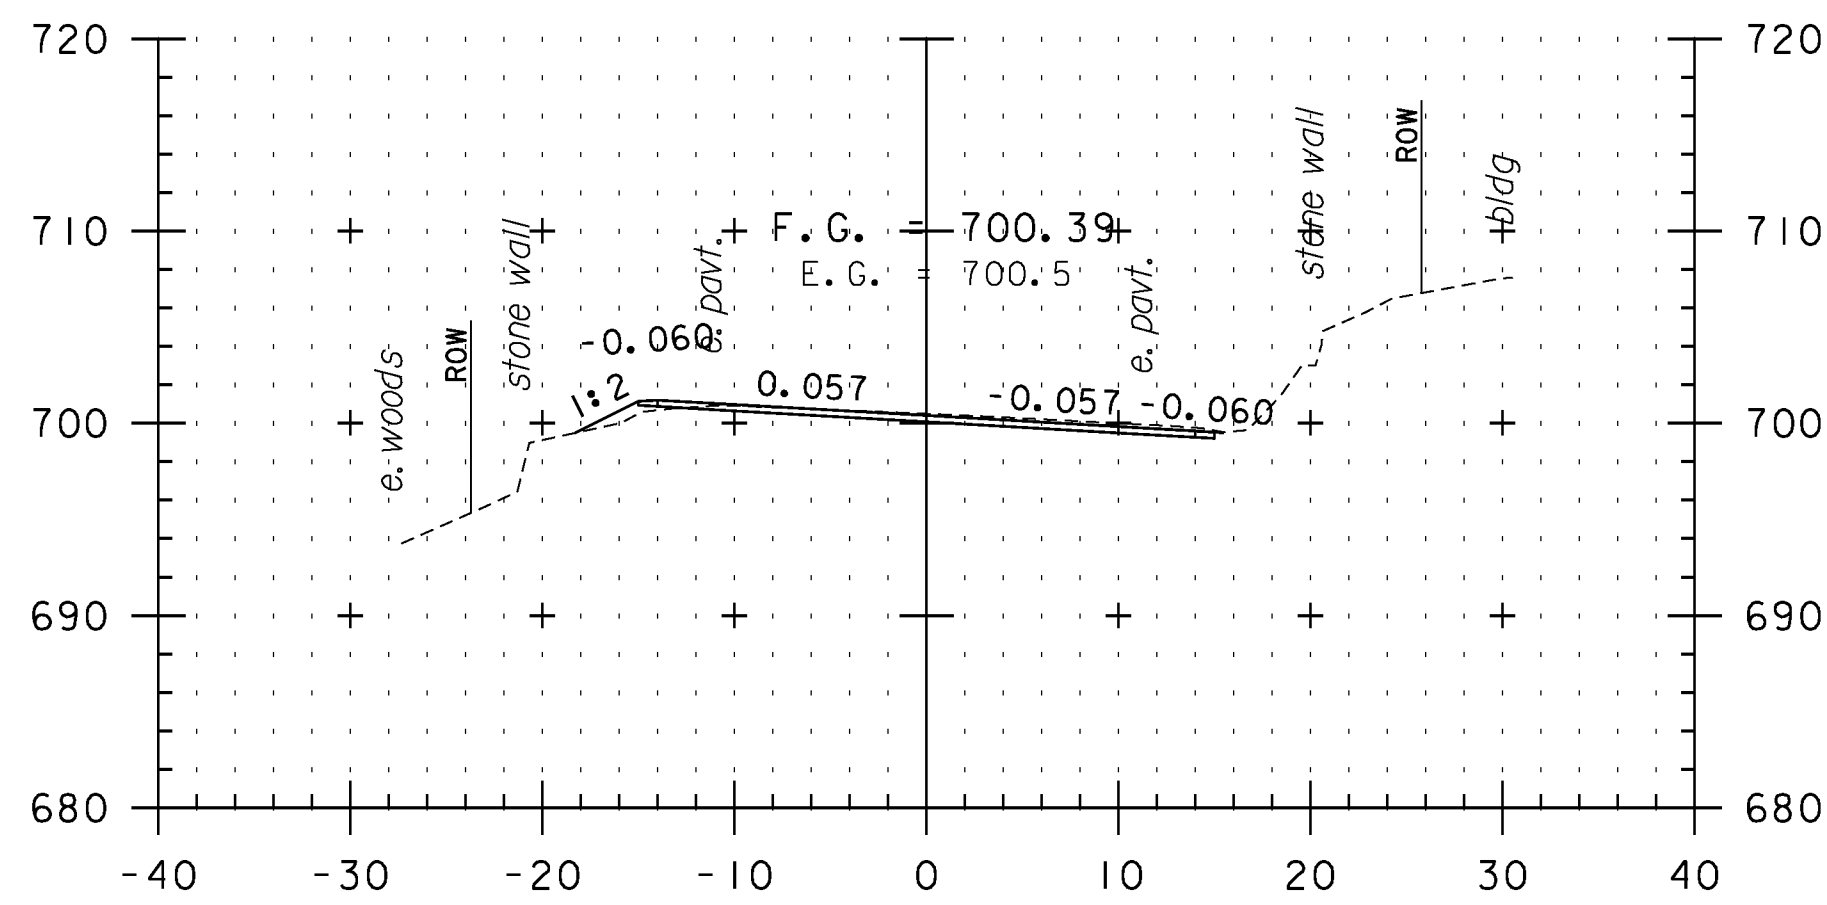

T 14+00

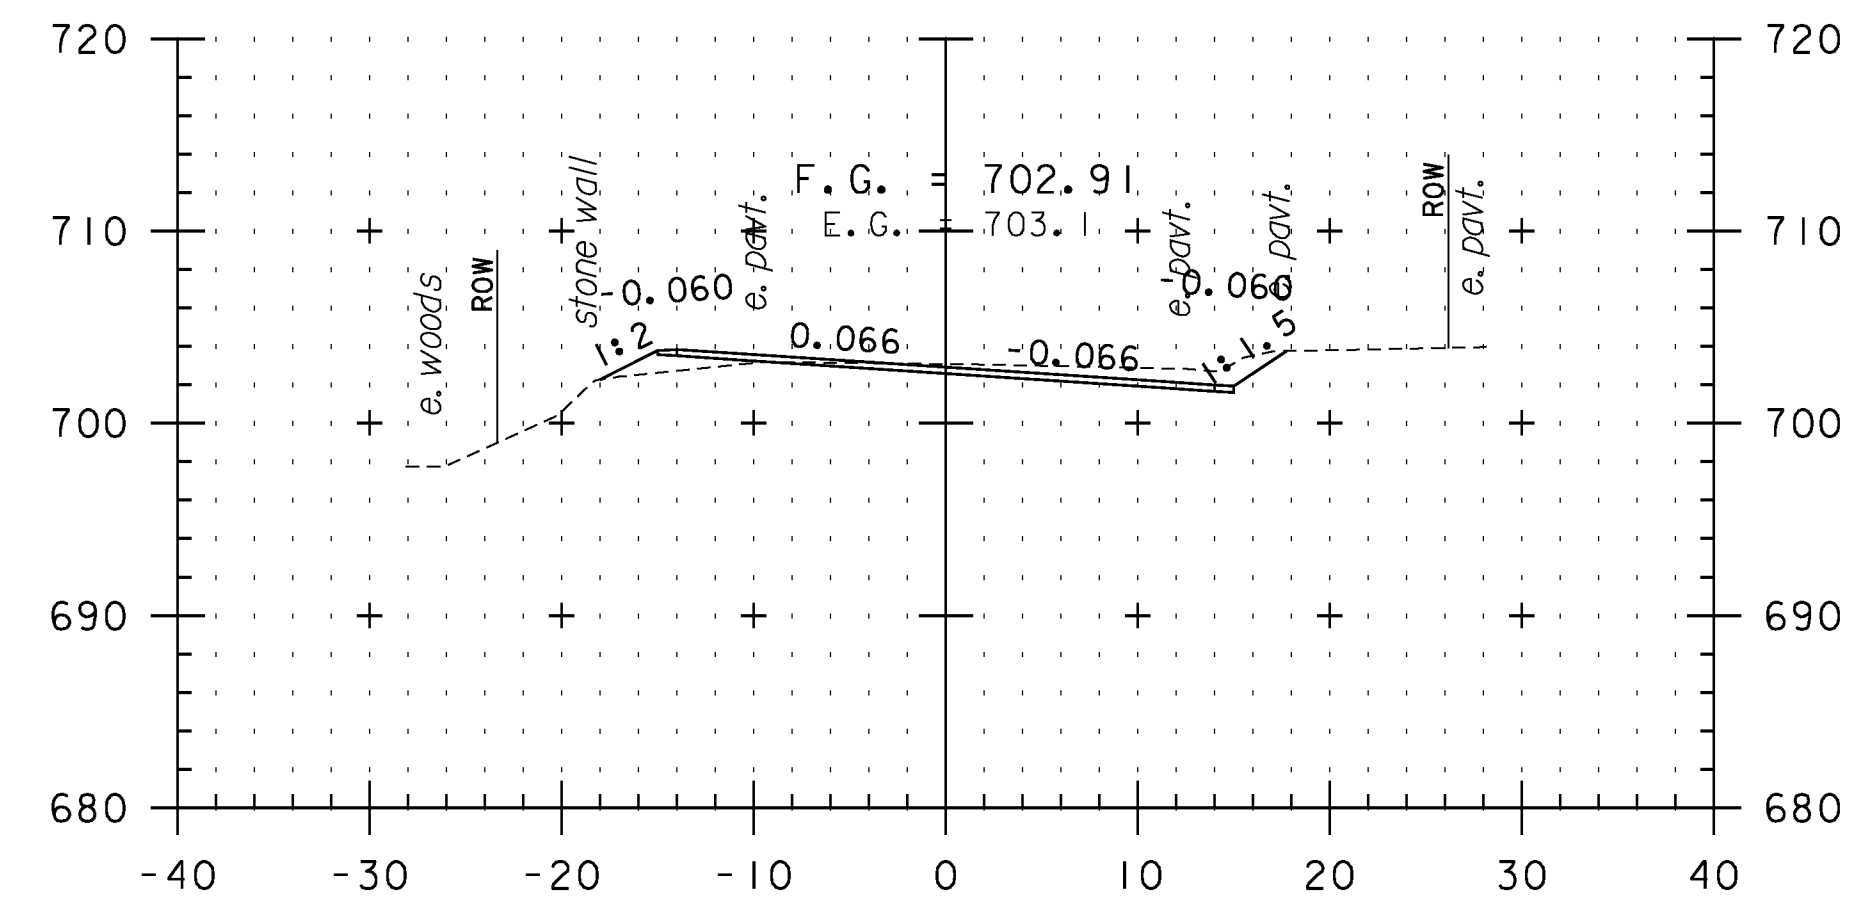


T 15+50

CROSS SECTION SHEET 90

PROJECT NAME: VERSHIRE-THETFORD	PLOT DATE: 1/29/2013
PROJECT NUMBER: STP 2911(I)	DRAWN BY: SNG
FILE NAME: pl0c224.dgn	CHECKED BY: PTS
PROJECT LEADER: PTS	SHEET 198 OF 232
DESIGNED BY: NLL	
IPARM FILE NAME: IOC224_198	

STA. T 12+50 TO STA. T 16+50

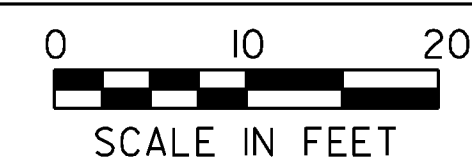

SCALE IN FEET