




T18+00

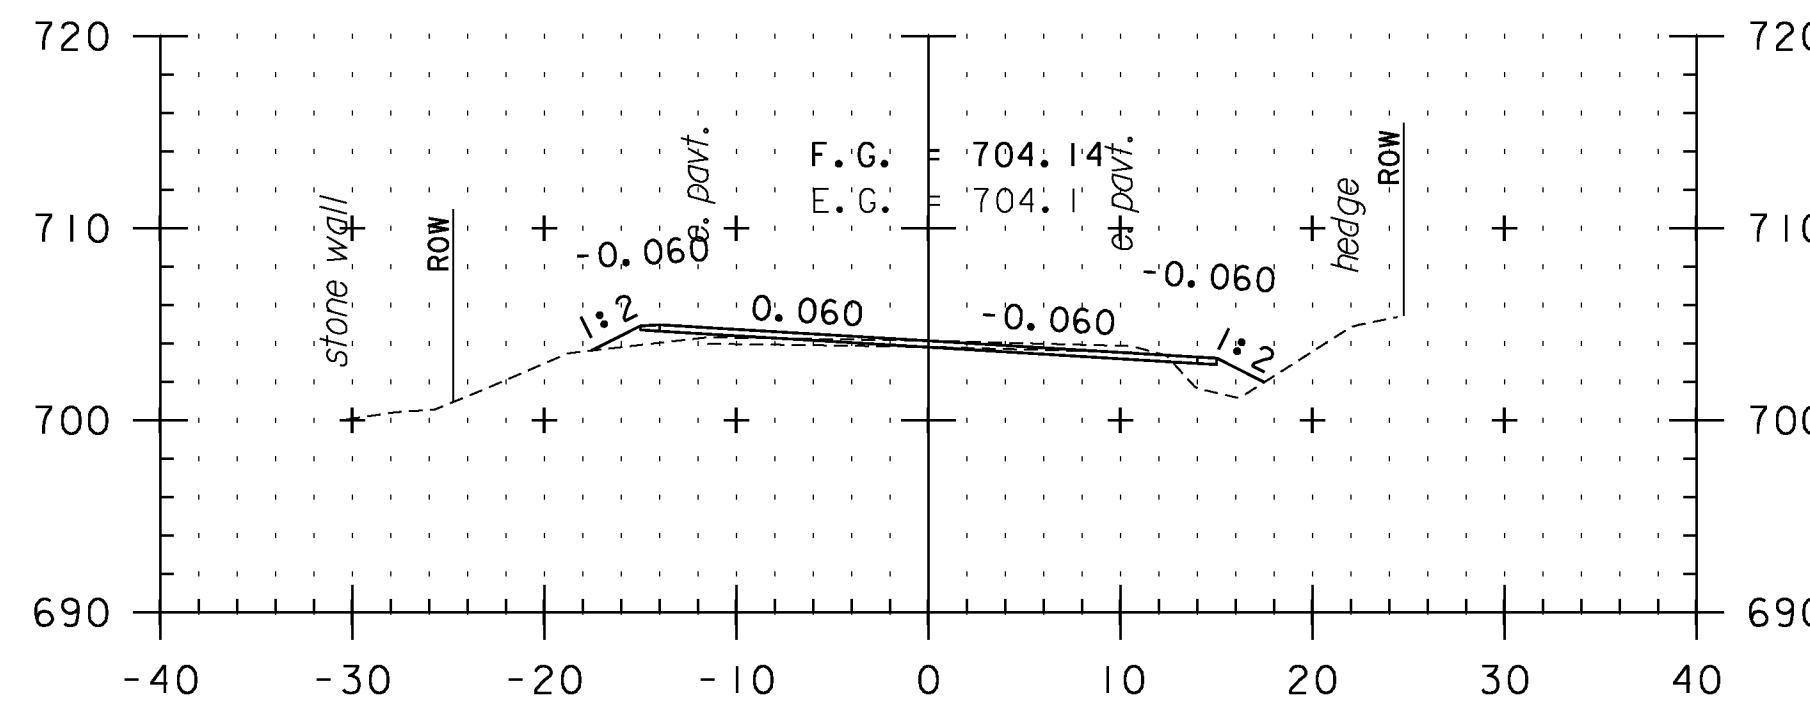


T19+50

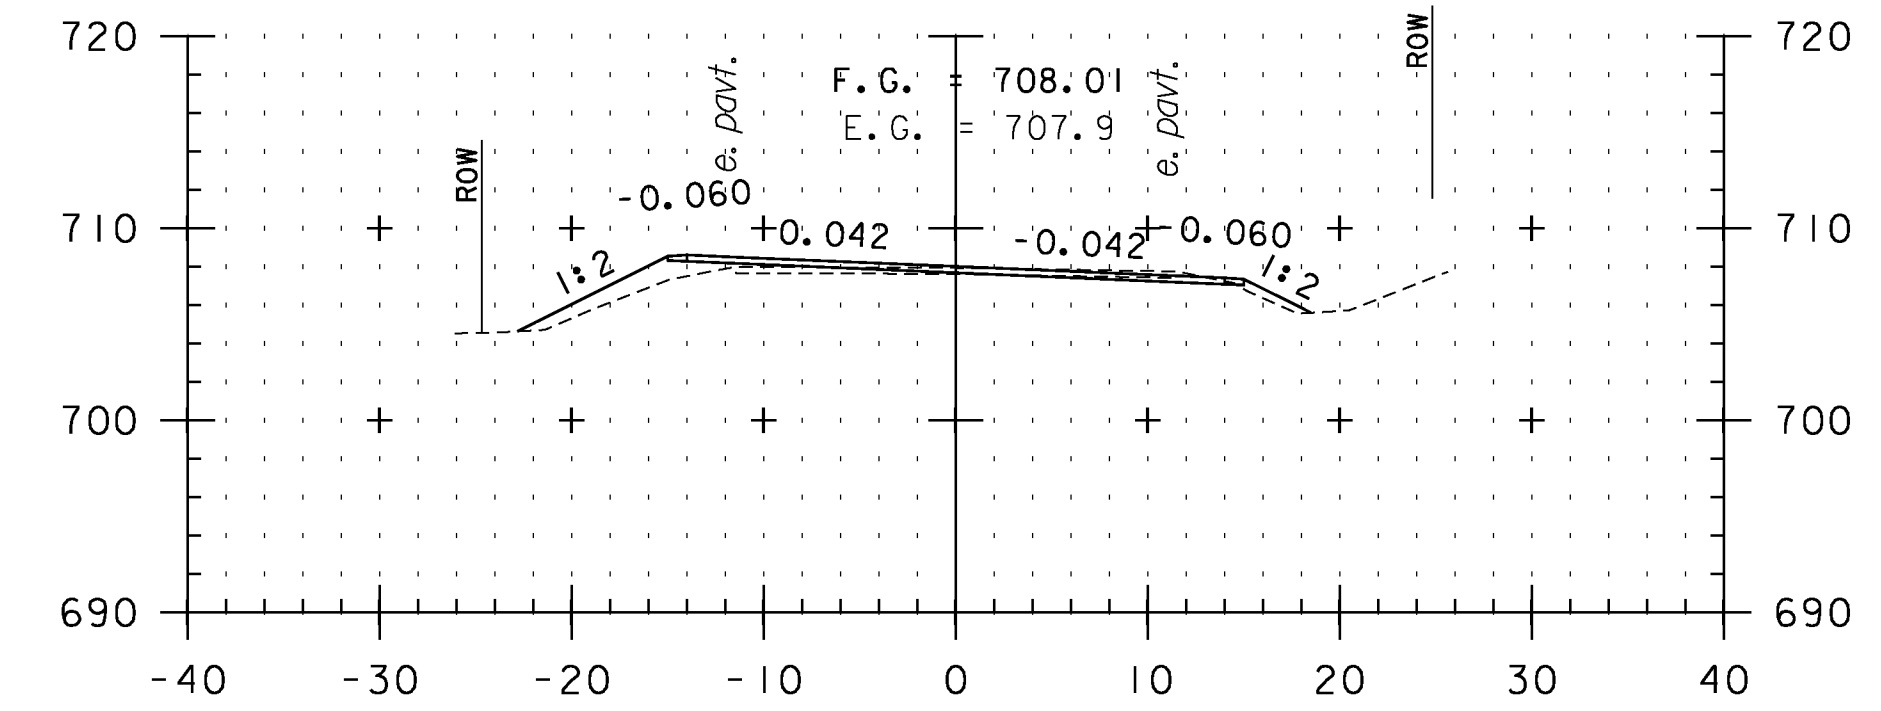


T21+00

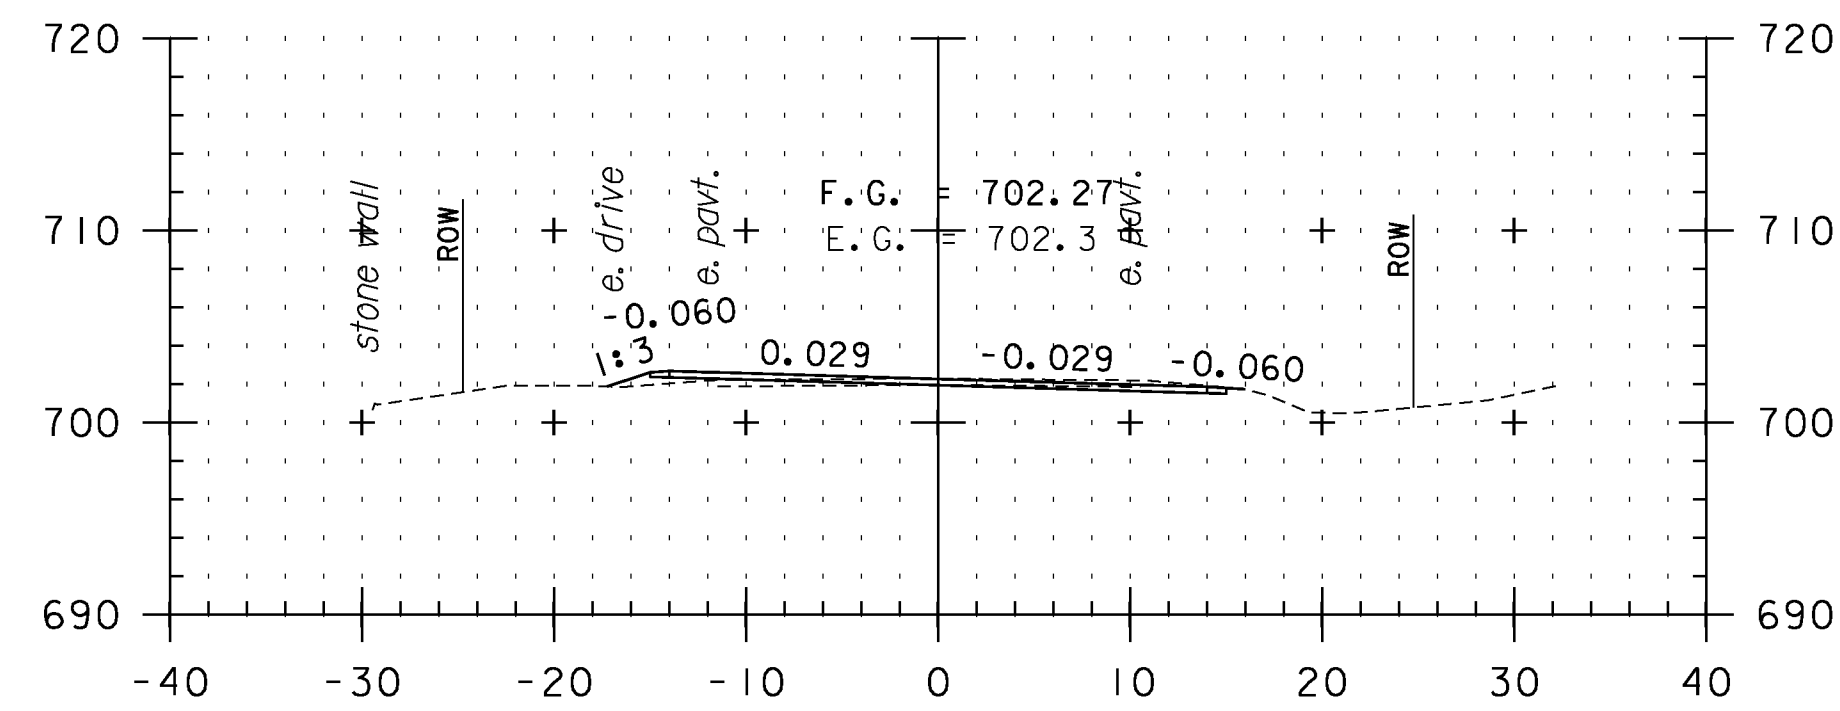


T17+50

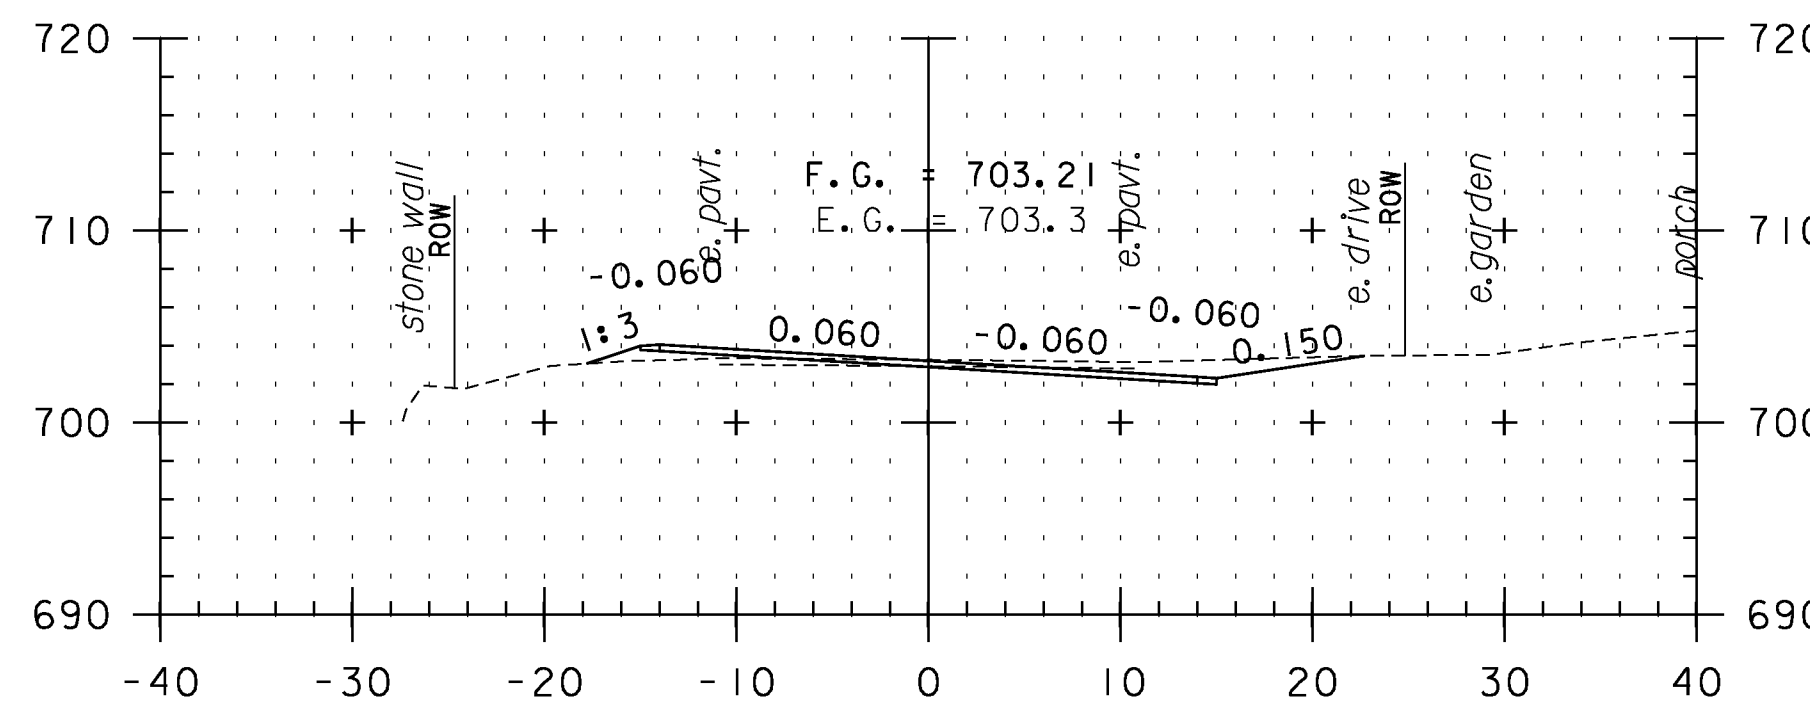


T19+00

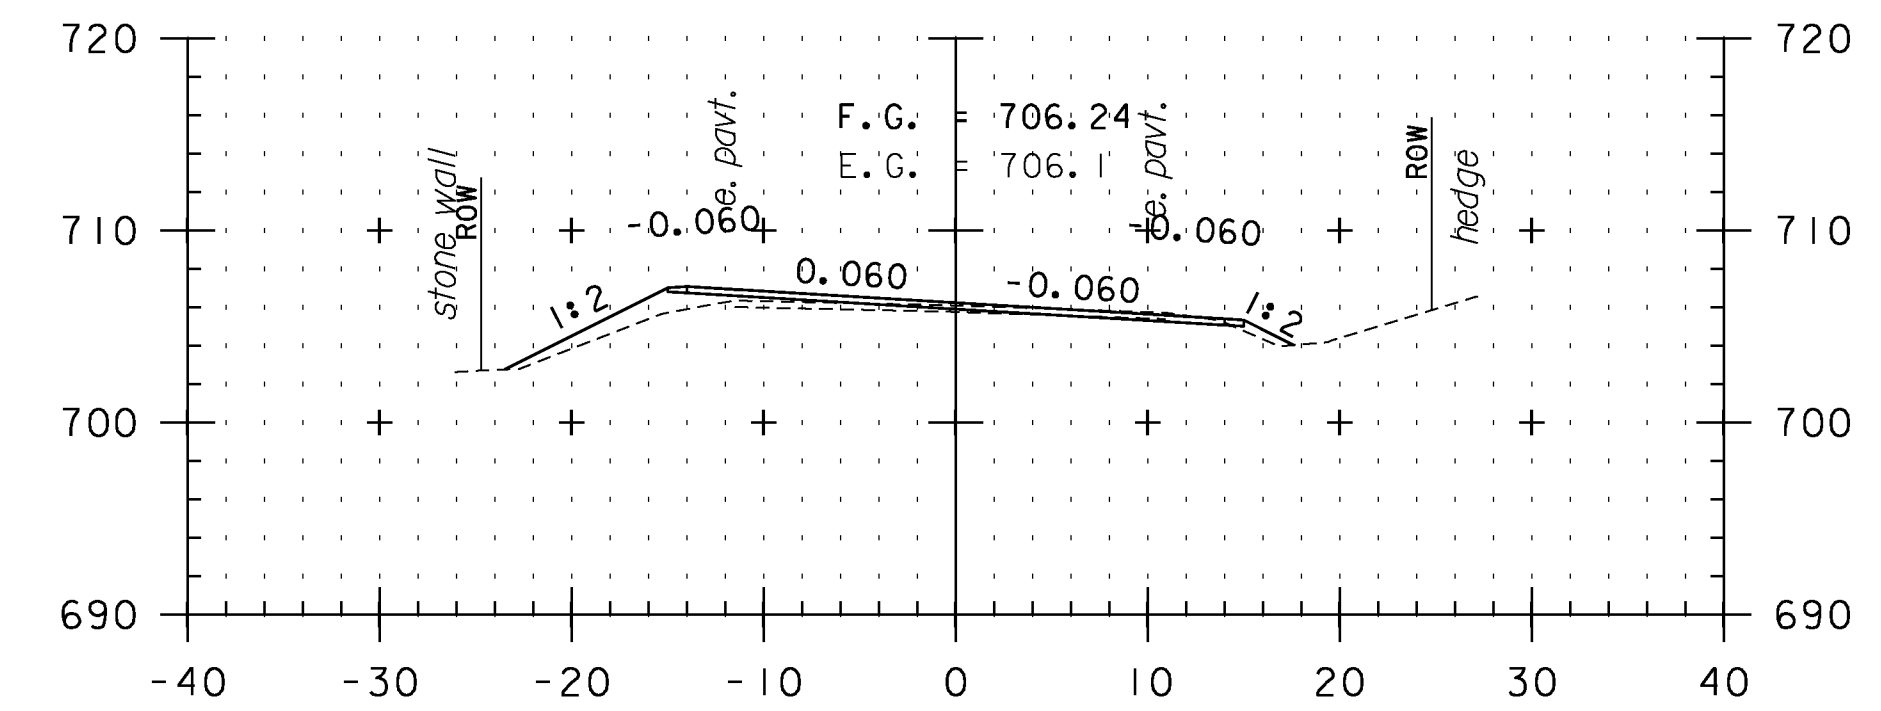


T20+50

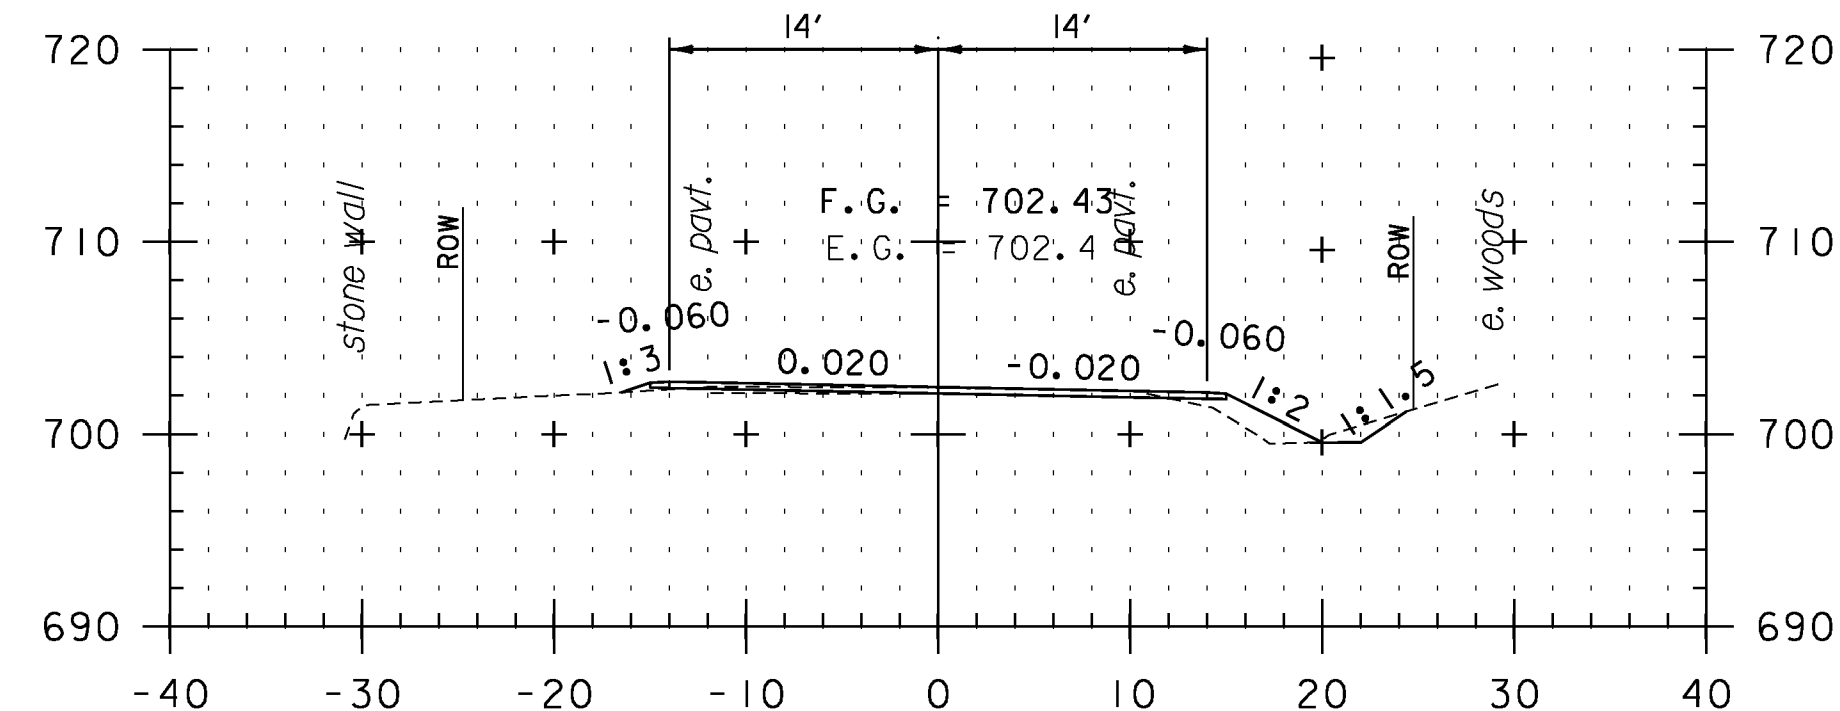

T17+00

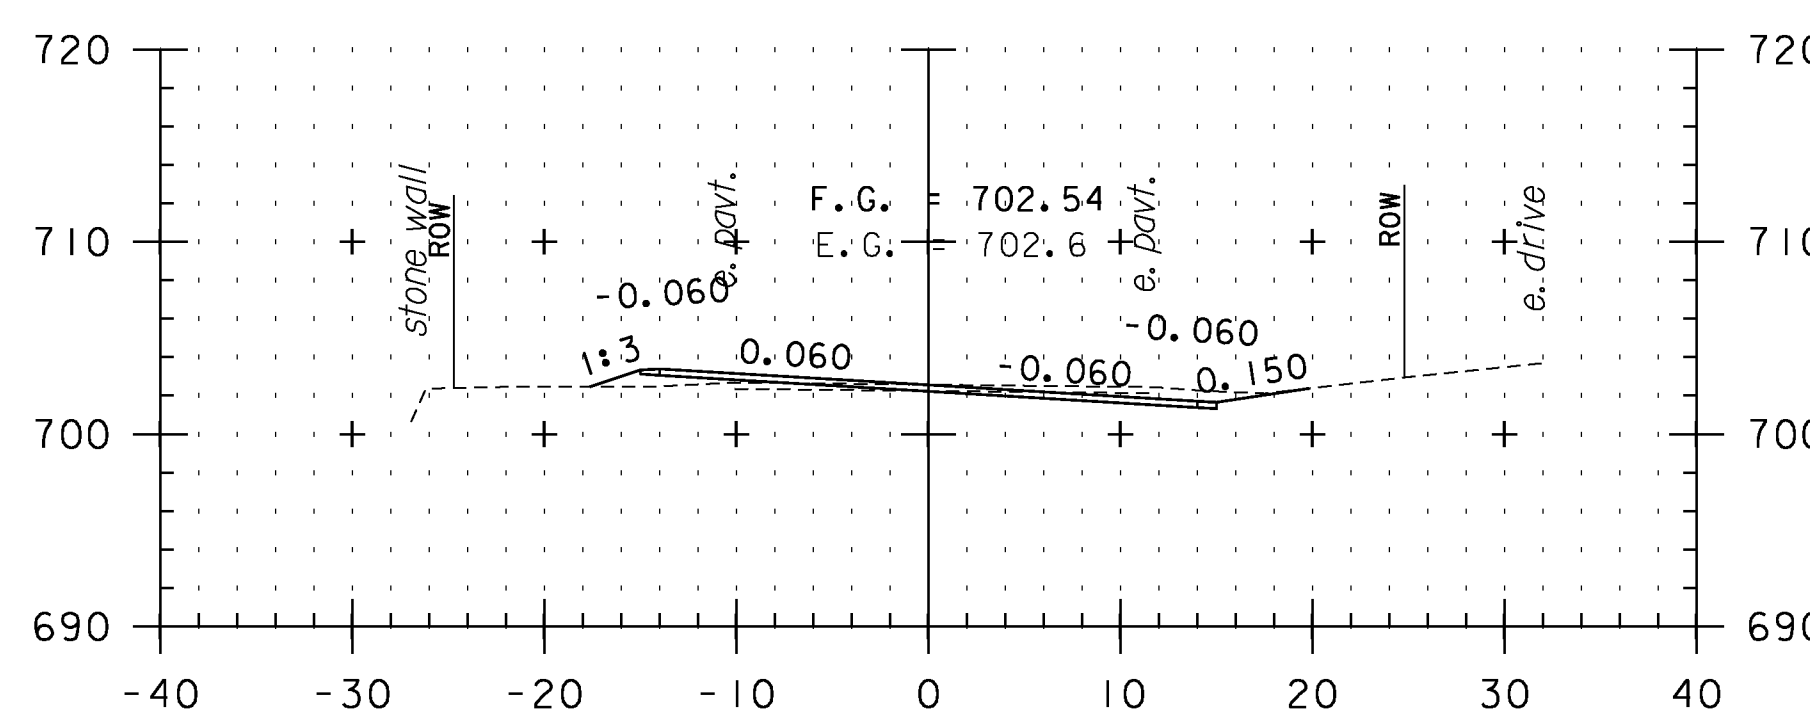


T18+50

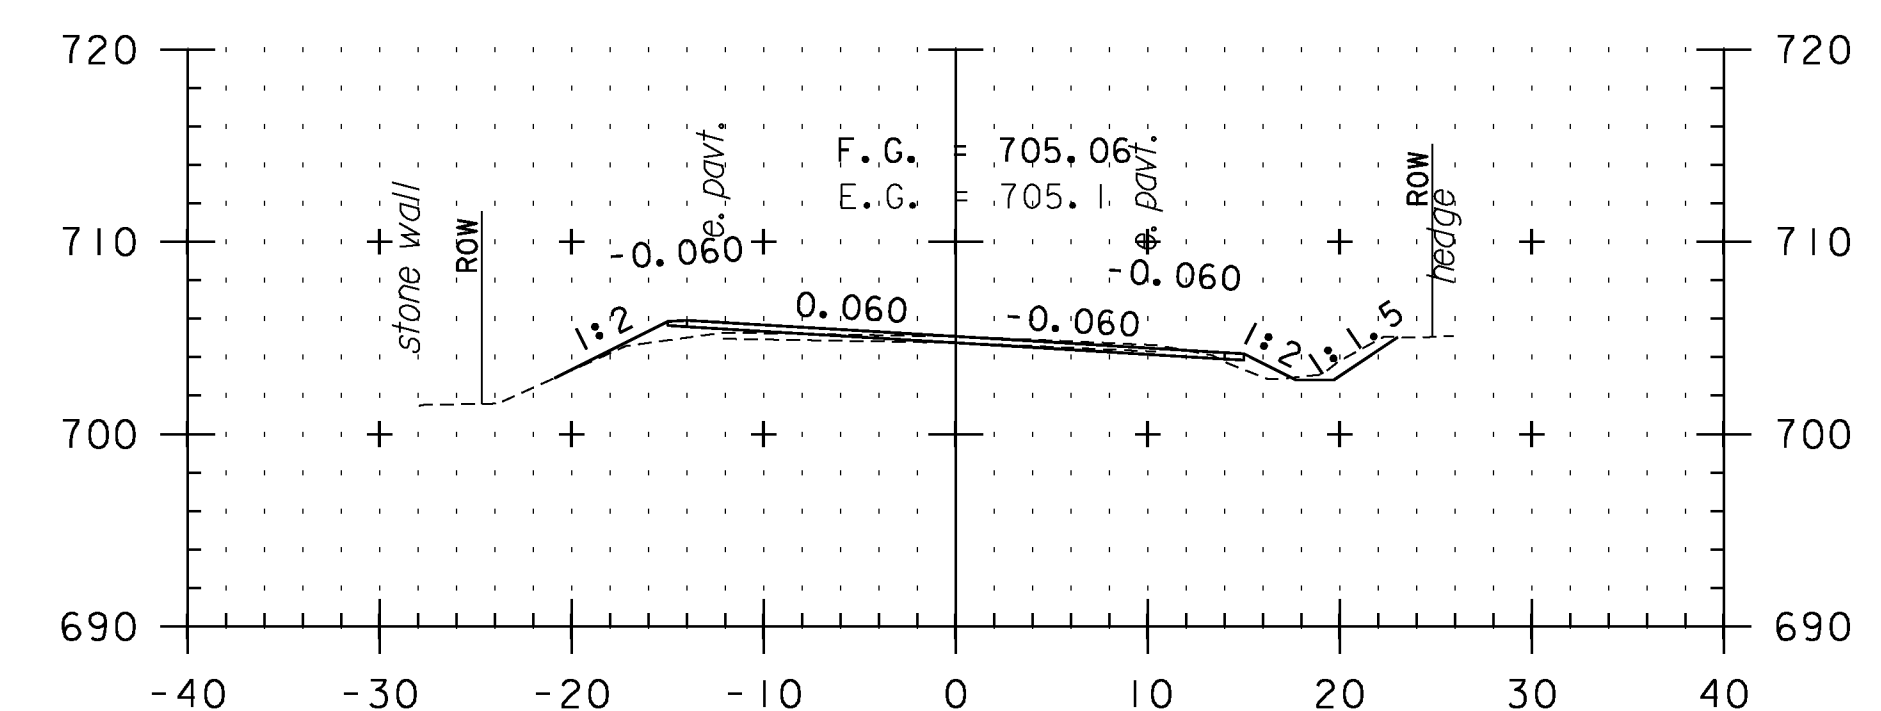

T20+00

**CROSS SECTION SHEET 91**

STA. T17+00 TO STA. T21+00

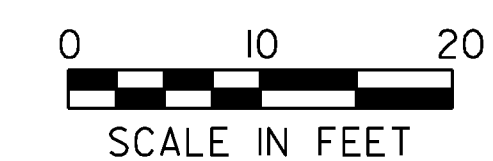

PROJECT NAME: VERSHIRE-THETFORD	PLOT DATE: 1/29/2013
PROJECT NUMBER: STP 2911(I)	DRAWN BY: SNG
FILE NAME: pl0c224.dgn	CHECKED BY: PTS
PROJECT LEADER: PTS	SHEET 199 OF 232
DESIGNED BY: NLL	
IPARM FILE NAME: IOC224_199	