




T22+50

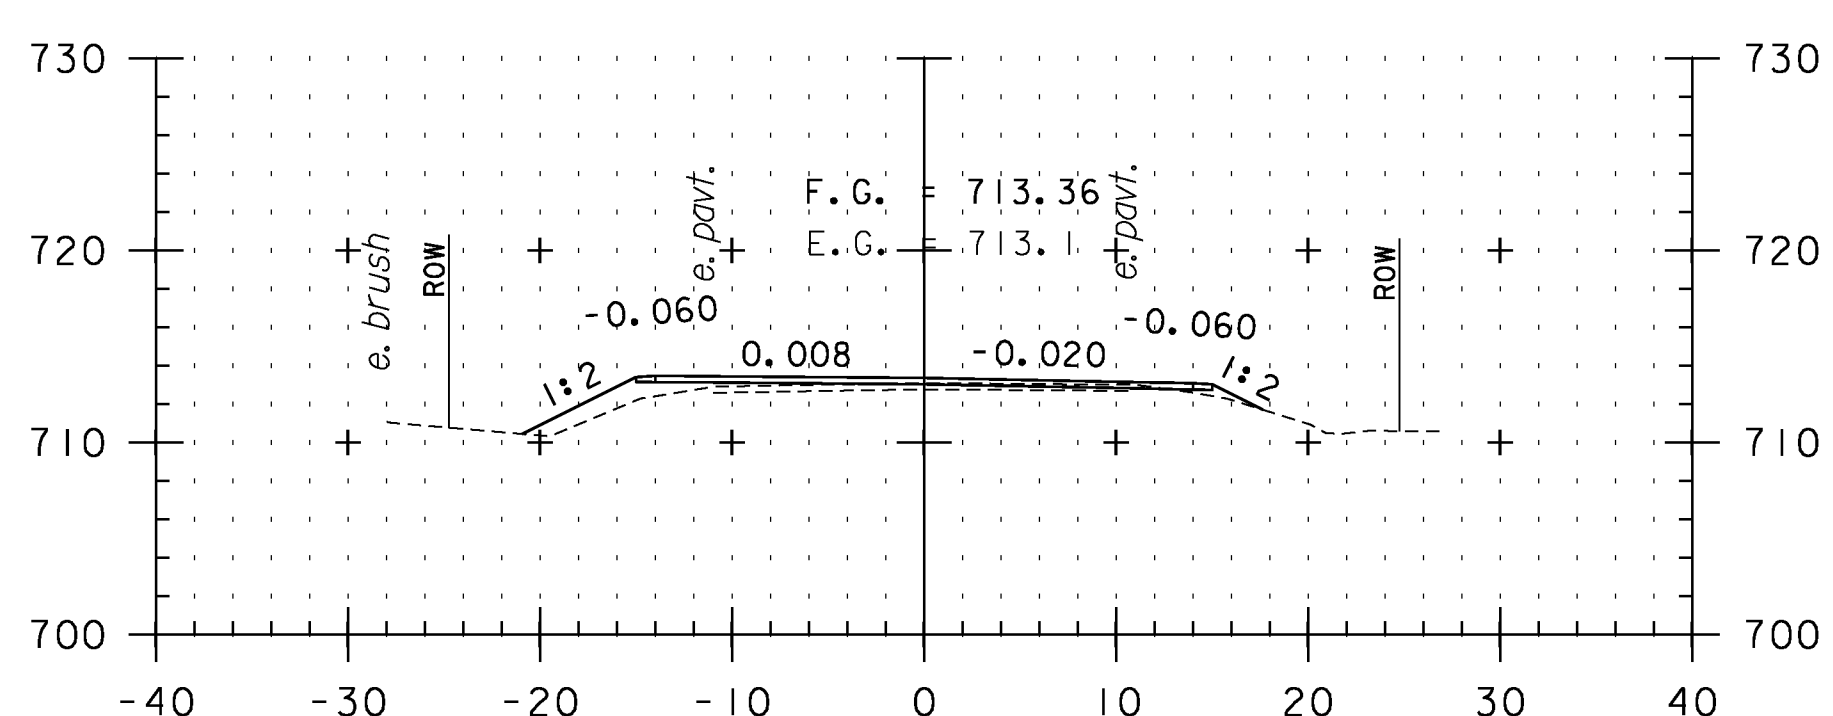


T22+00

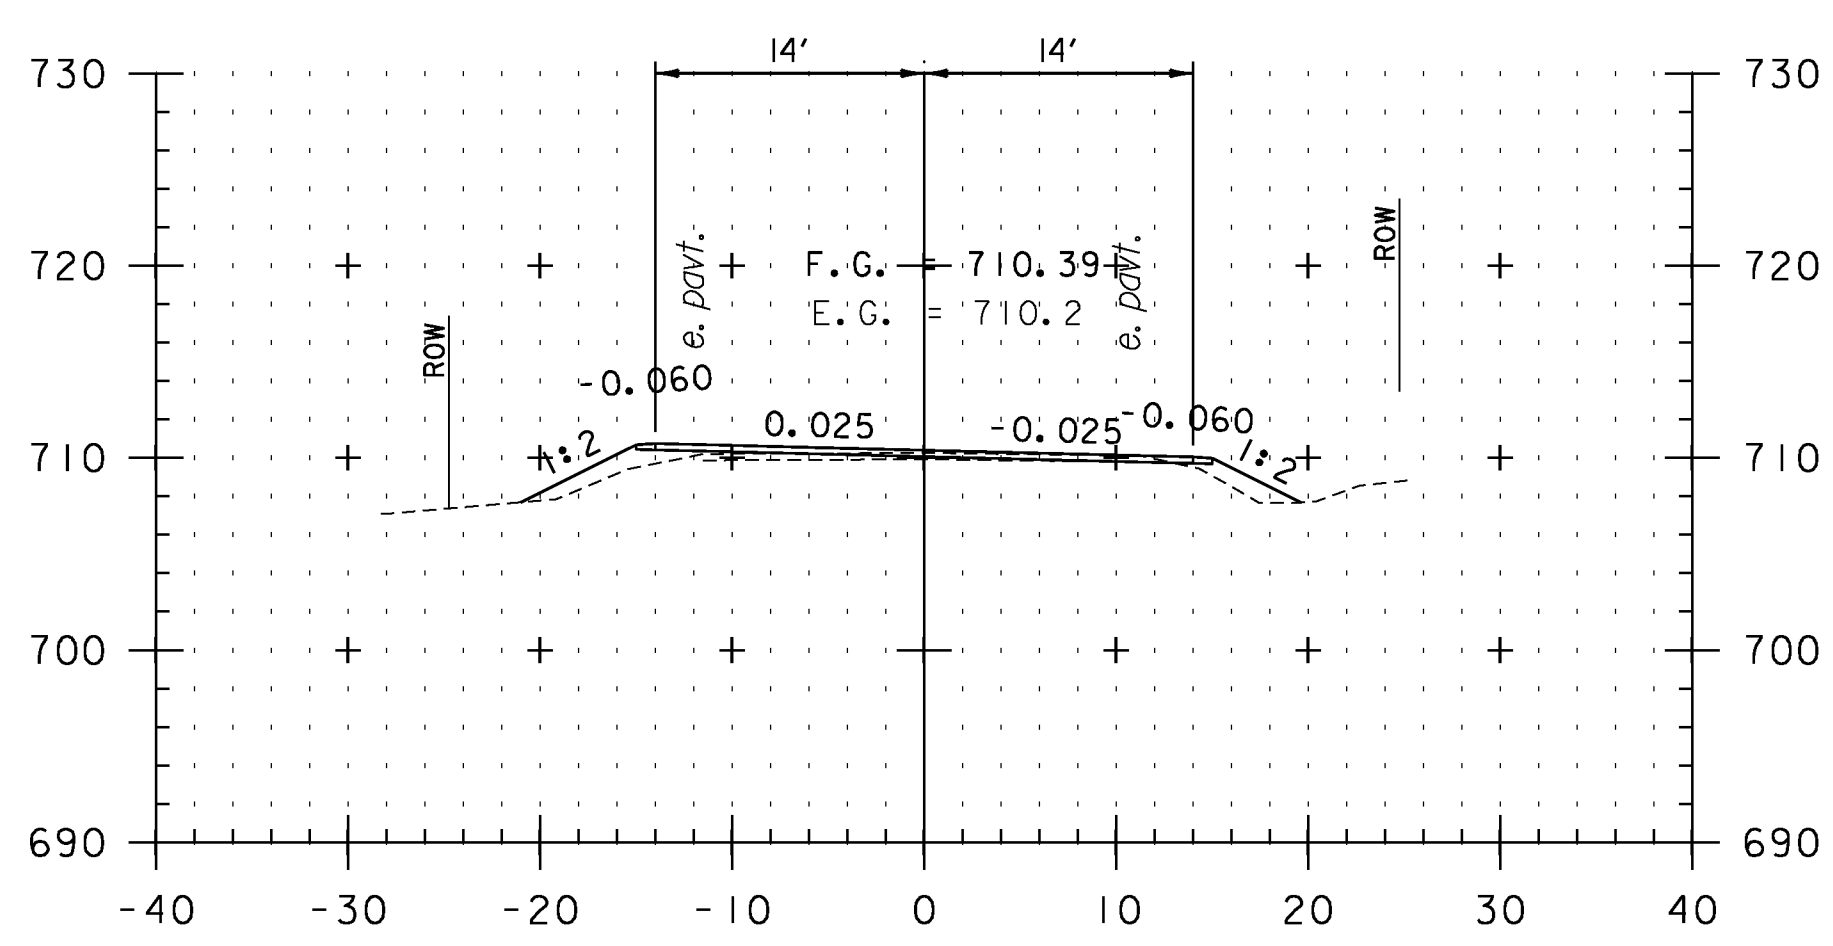


T21+50

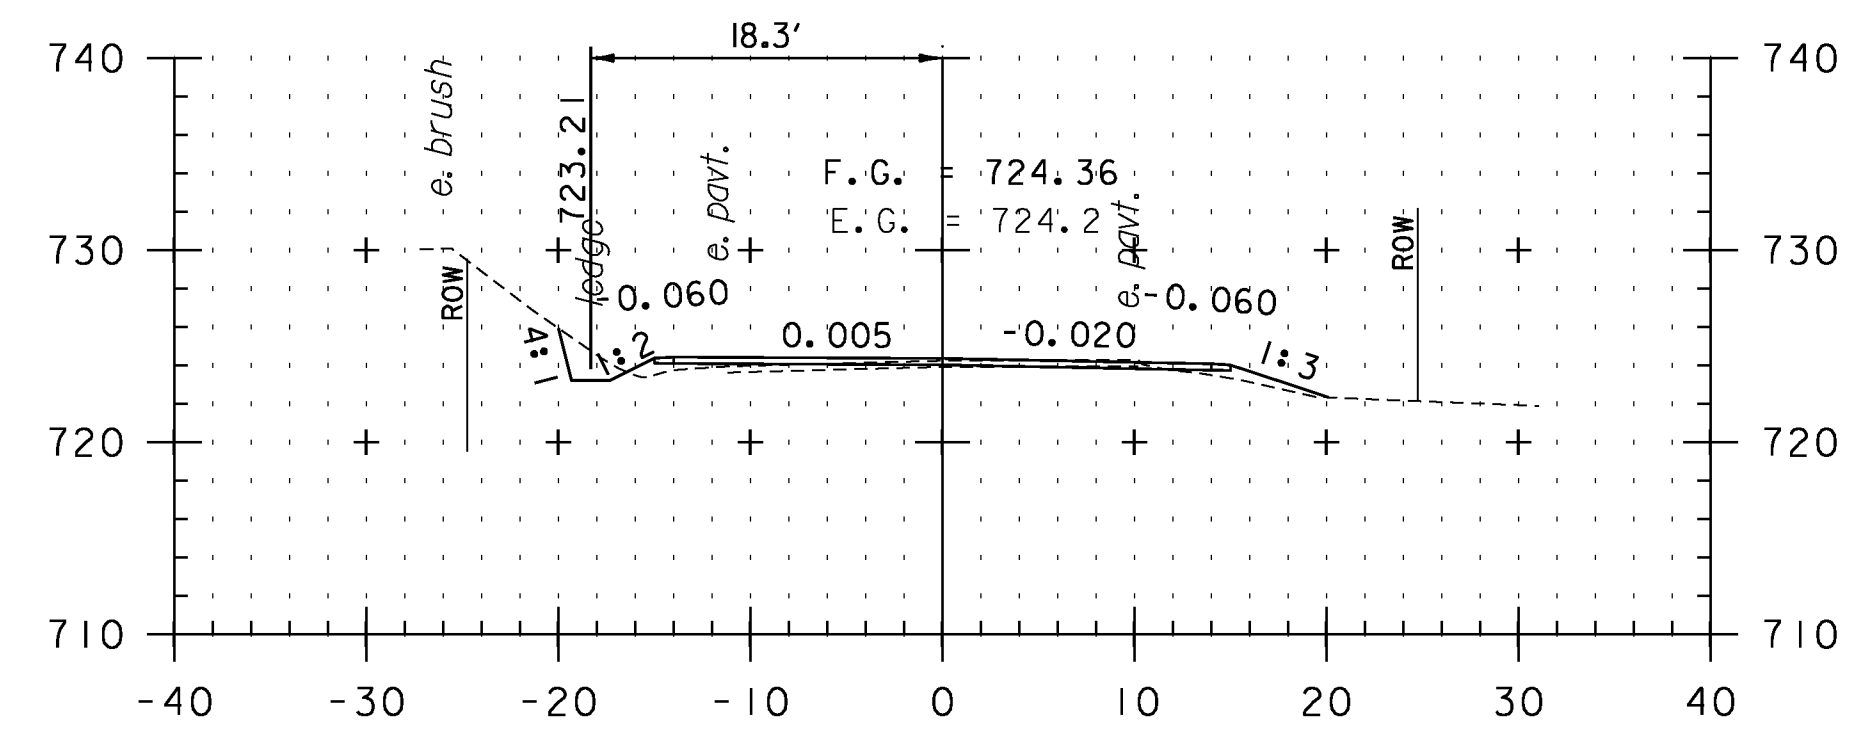


T24+00

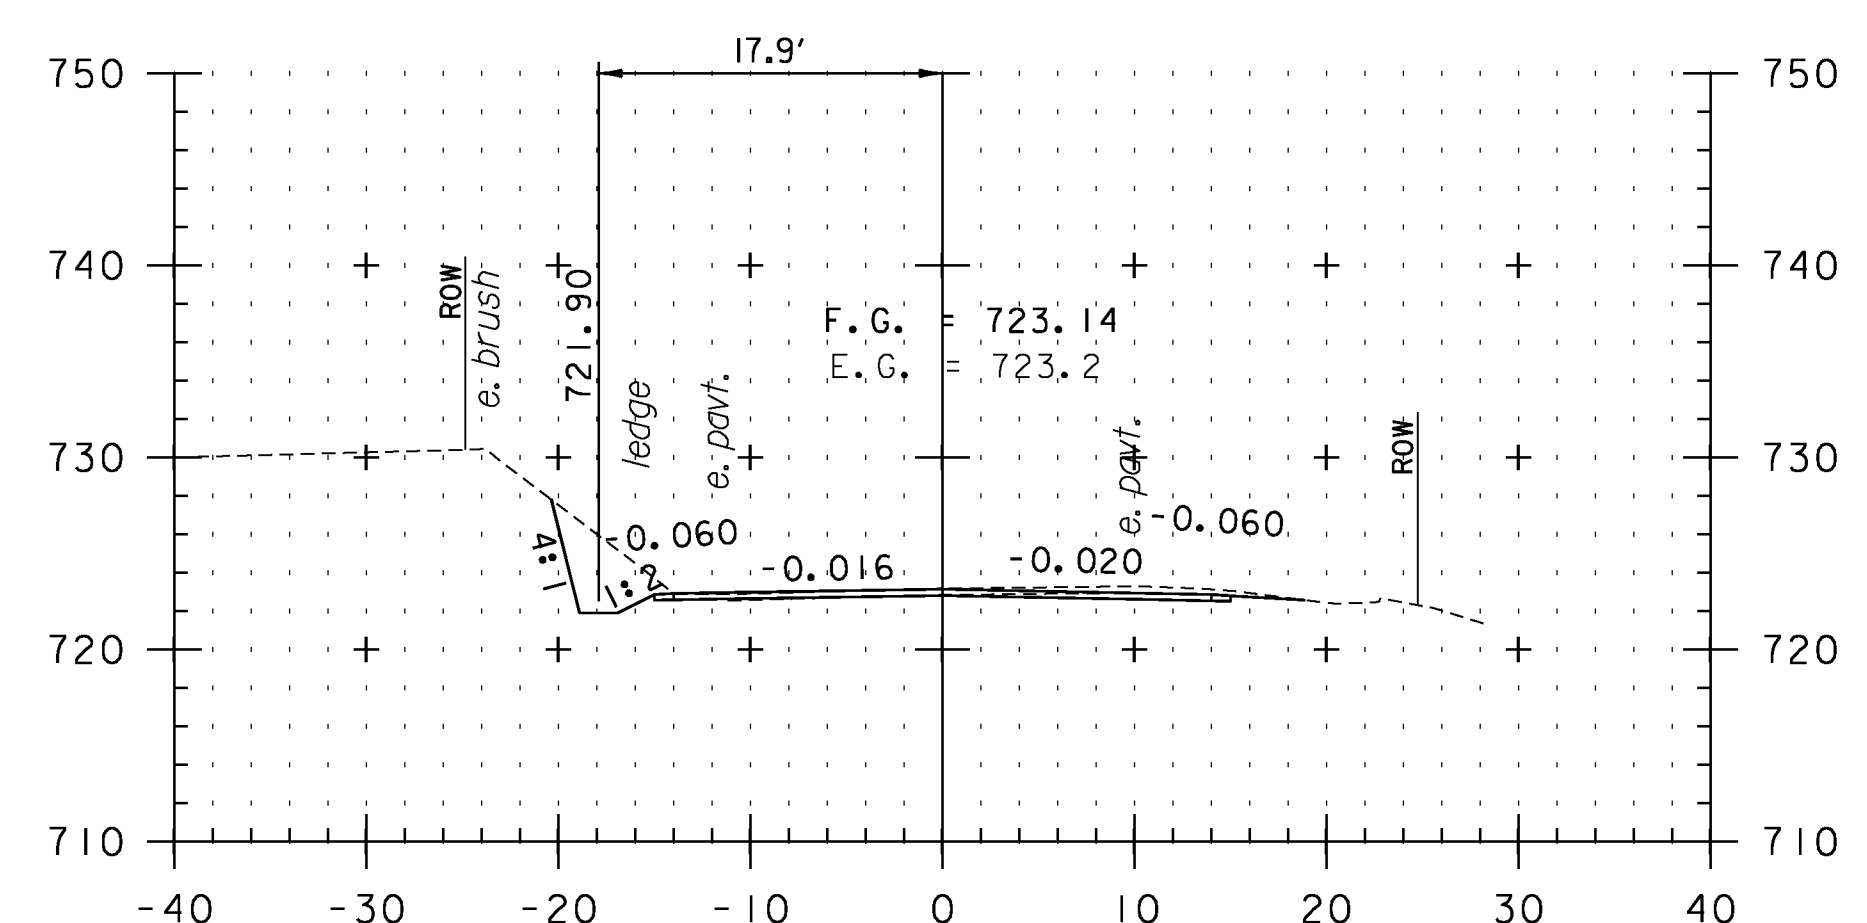


T23+50

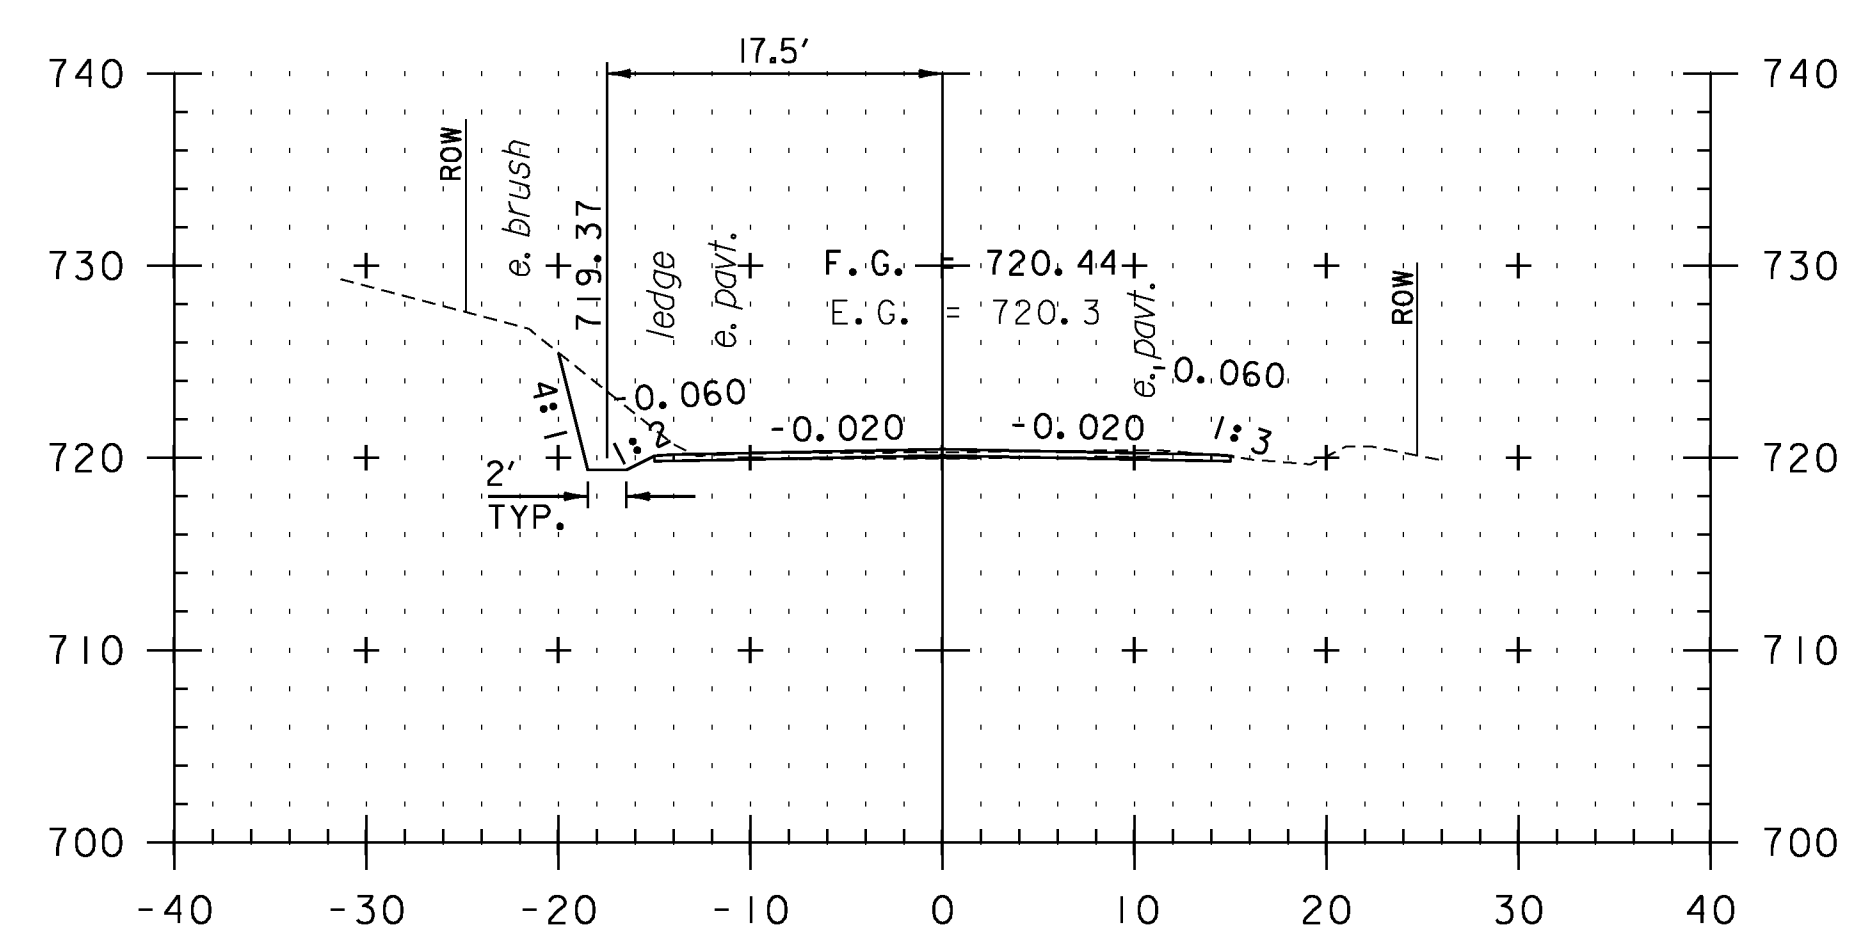


T23+00

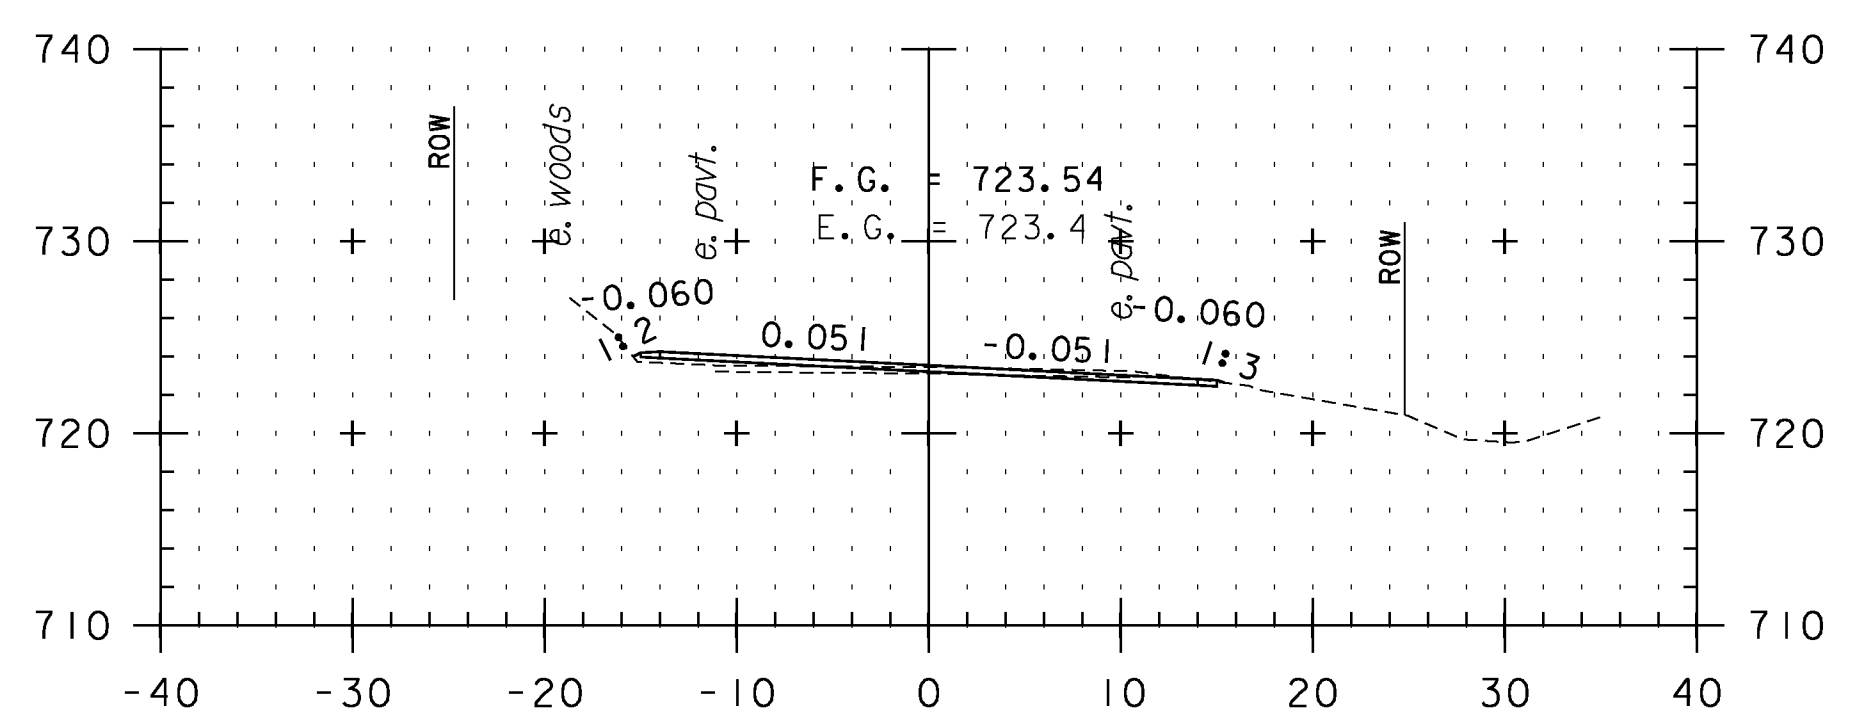

T25+50

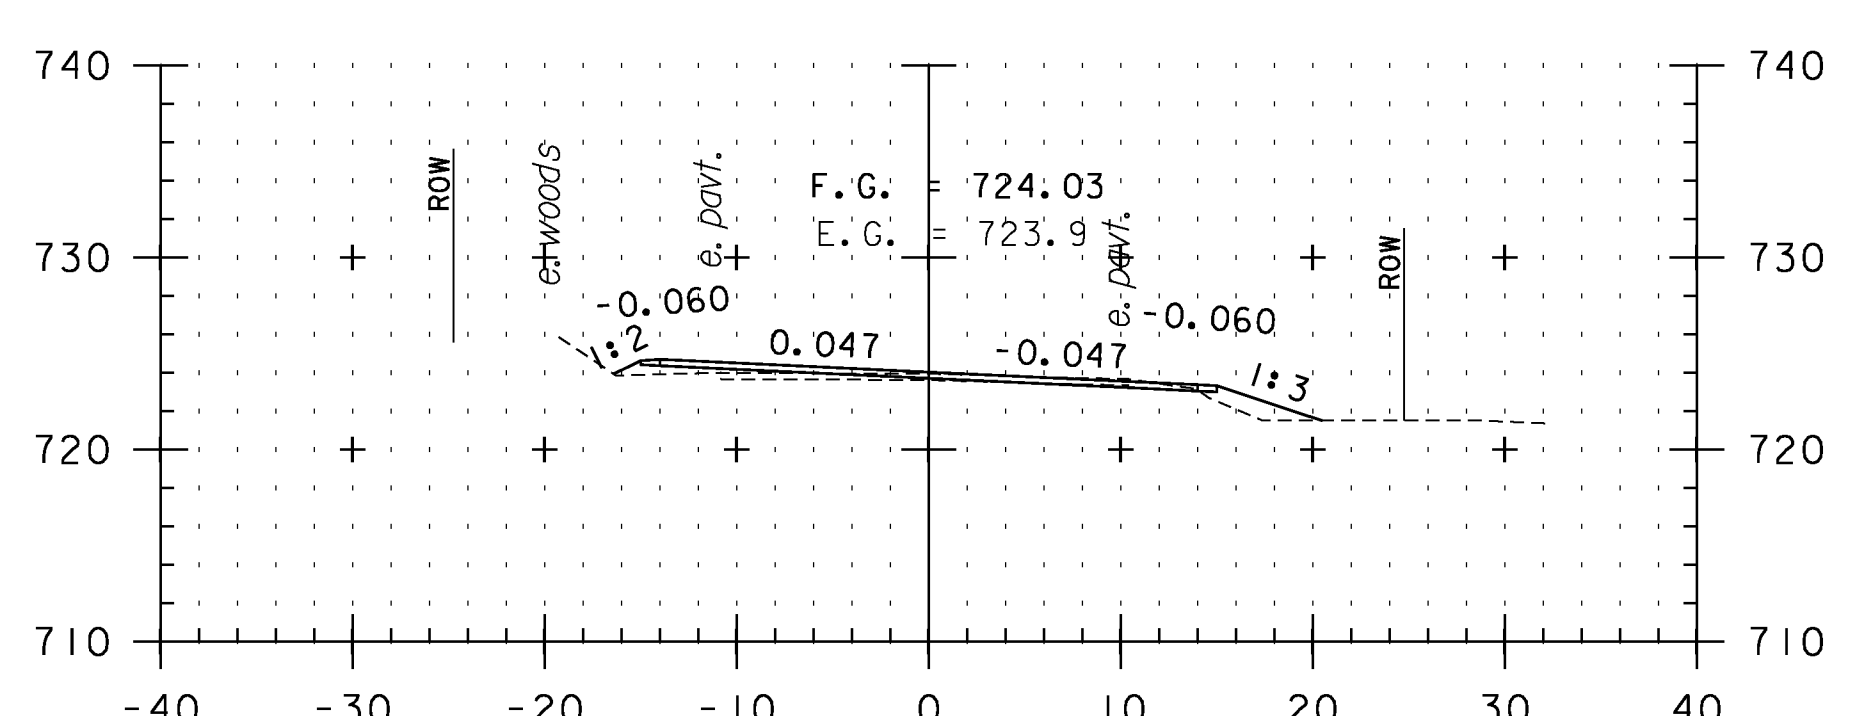

T25+00

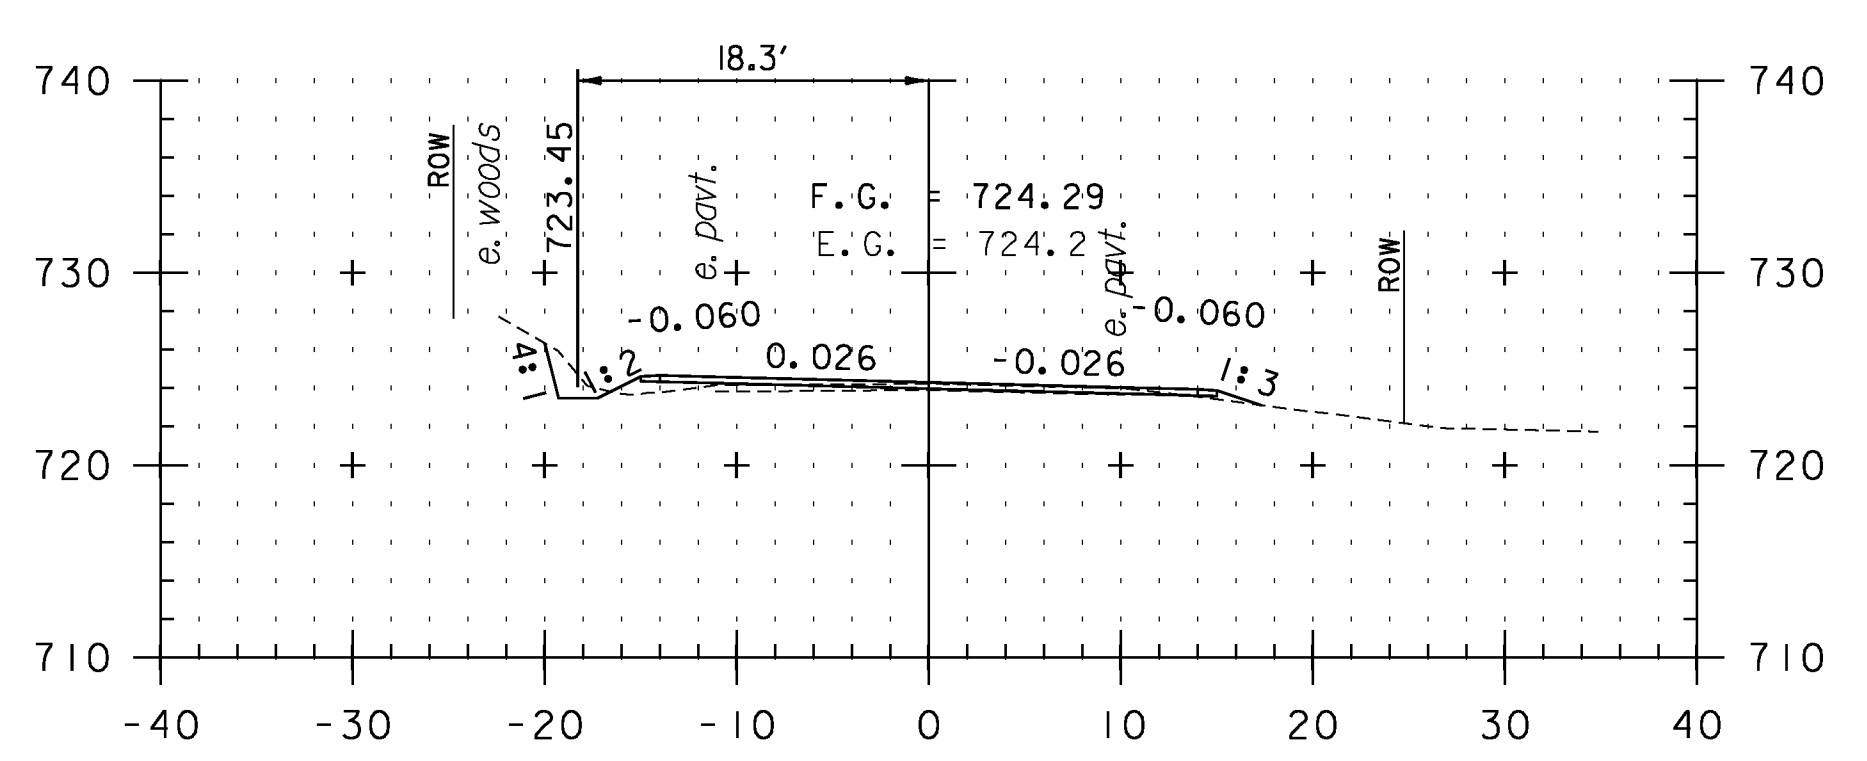

T24+50

CROSS SECTION SHEET 92

PROJECT NAME: VERSHIRE-THETFORD	
PROJECT NUMBER: STP 291(K)	
FILE NAME: pl0c224.dgn	PLOT DATE: 1/29/2013
PROJECT LEADER: PTS	DRAWN BY: SNG
DESIGNED BY: NLL	CHECKED BY: PTS
IPARM FILE NAME: IOC224_200	SHEET 200 OF 232

STA. T21+50 TO STA. T25+50

