




T27+00

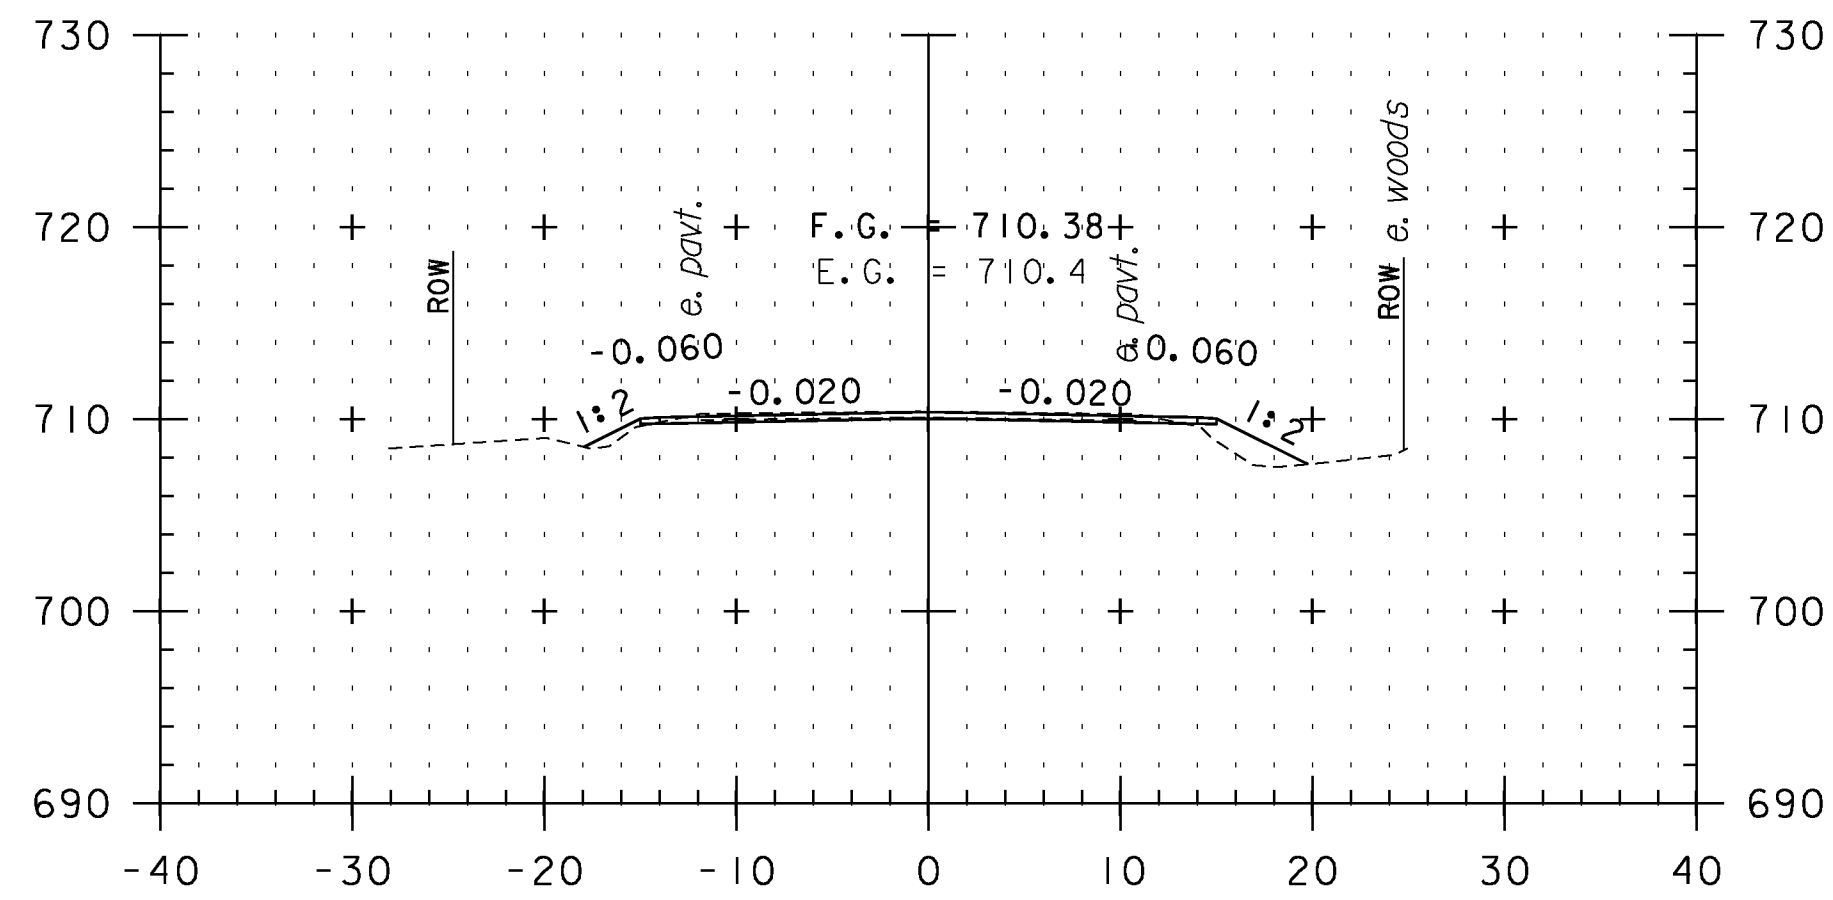


T28+50

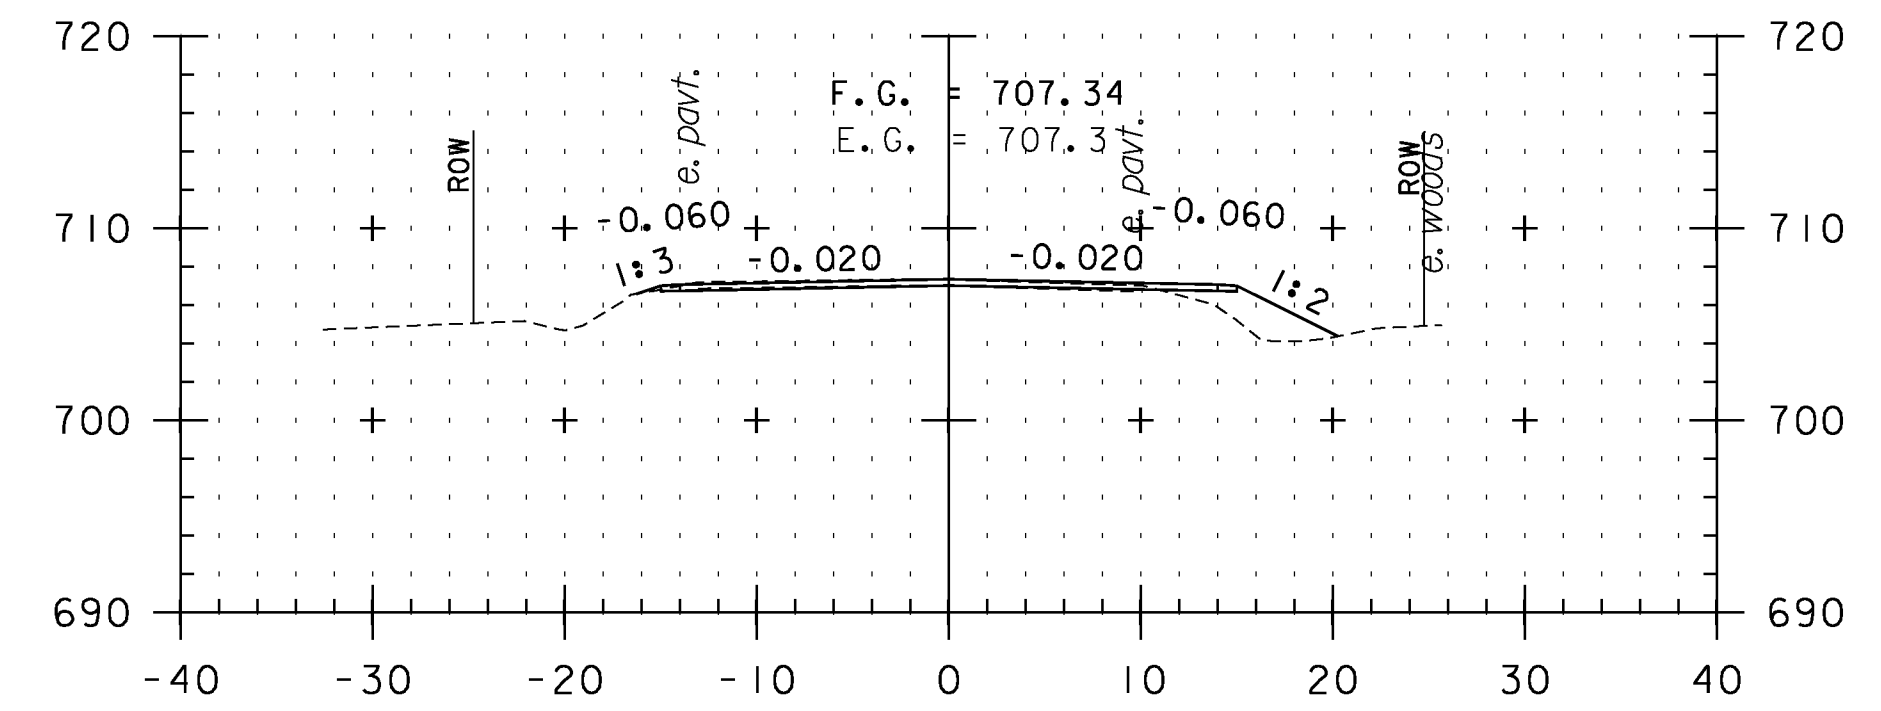


T30+00

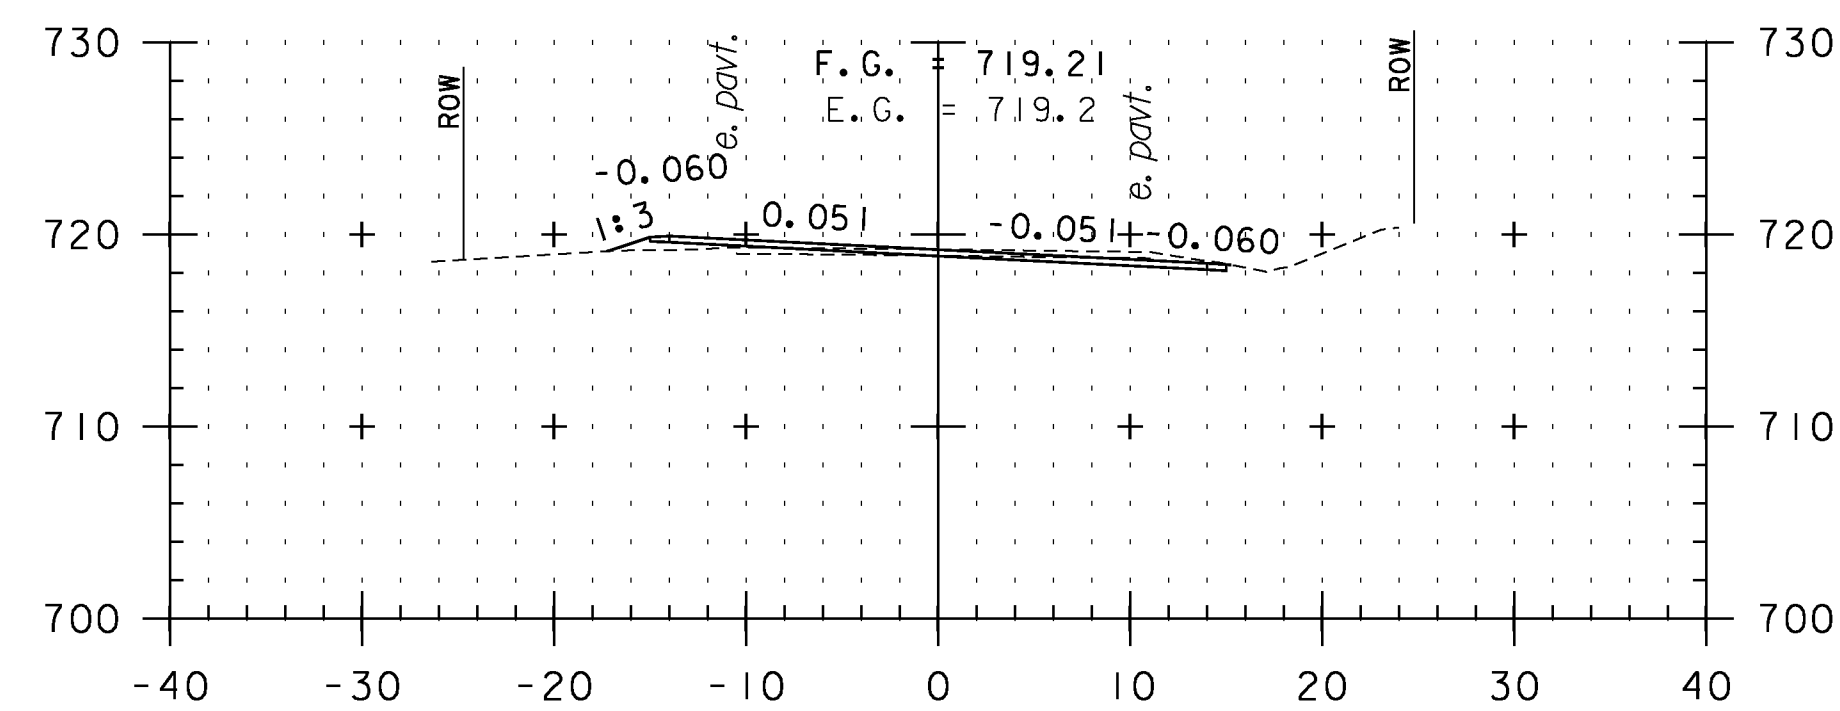


T26+50

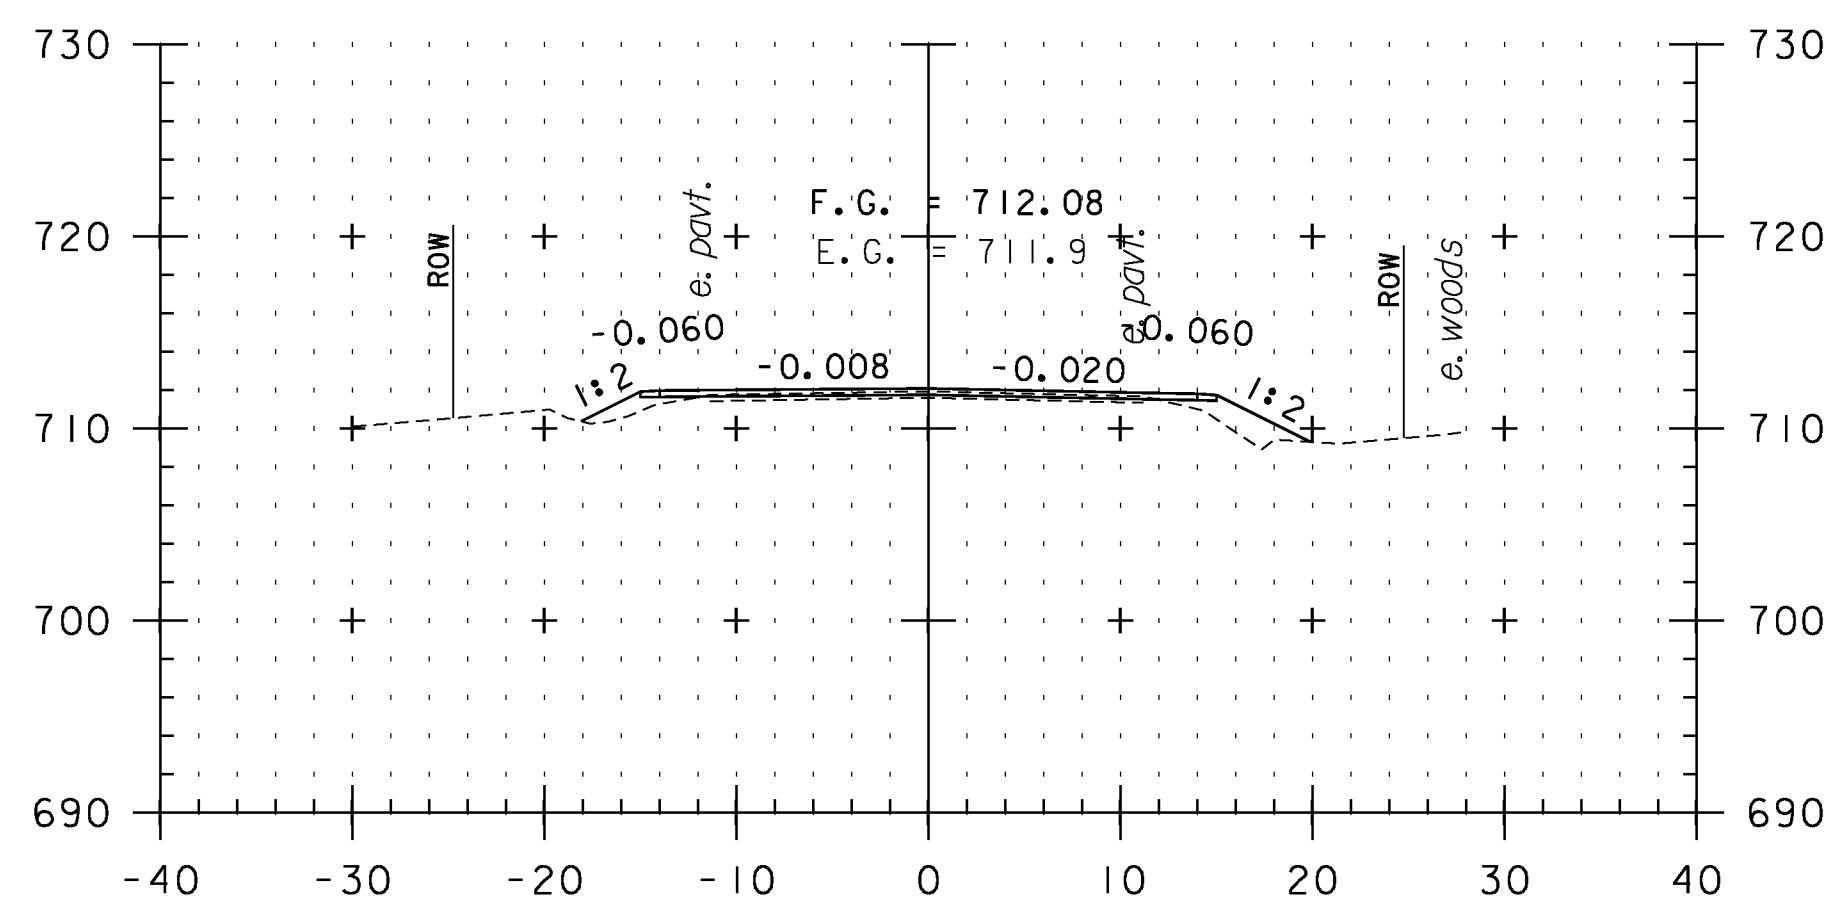


T28+00

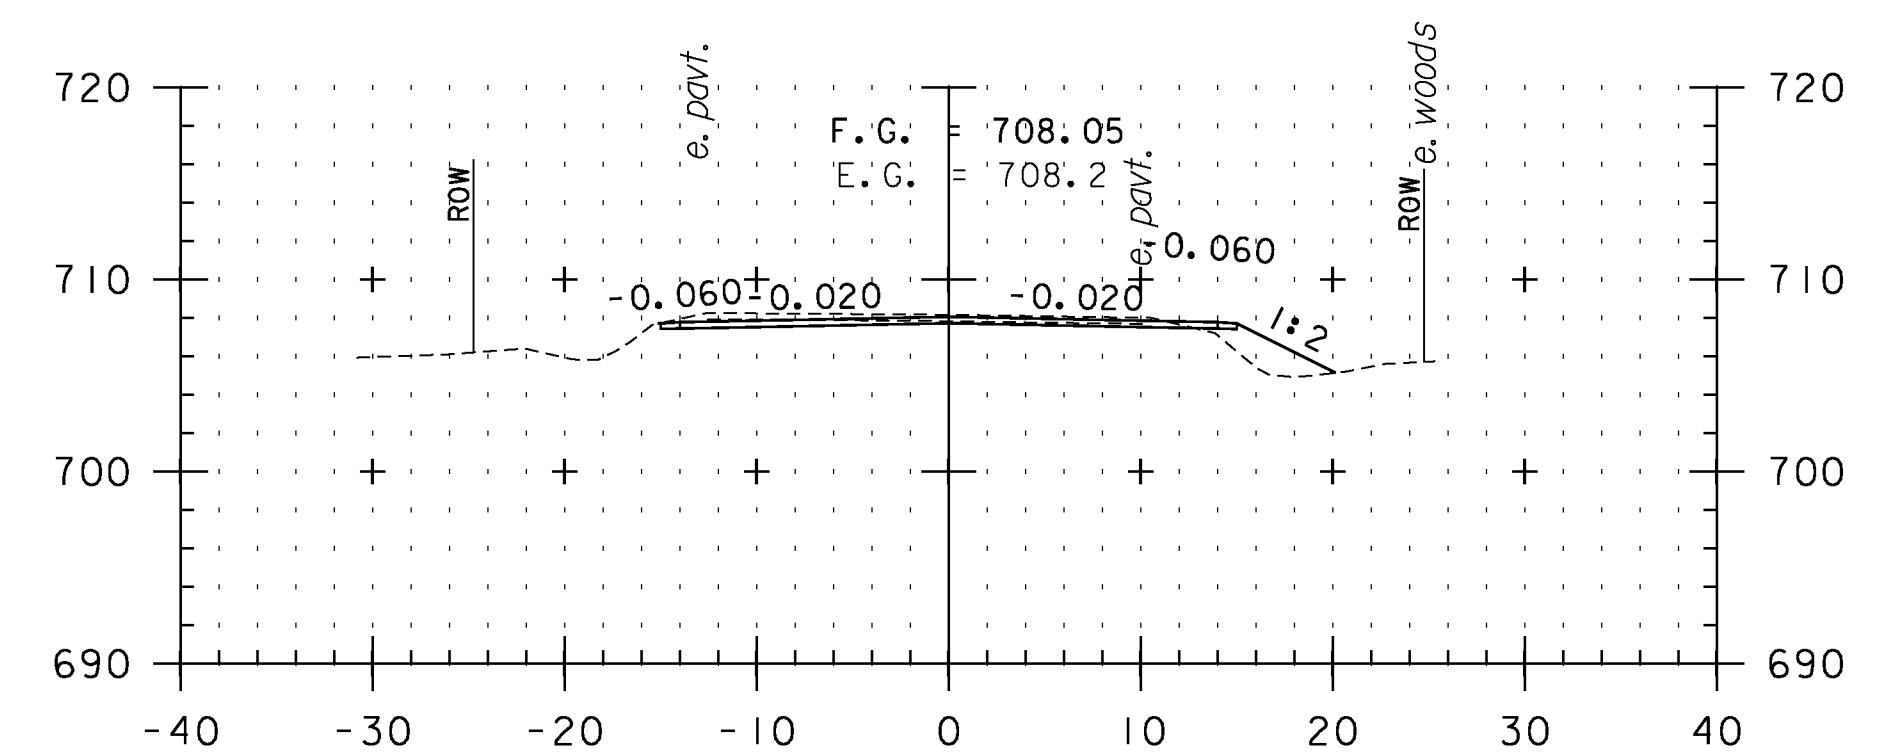


T29+50

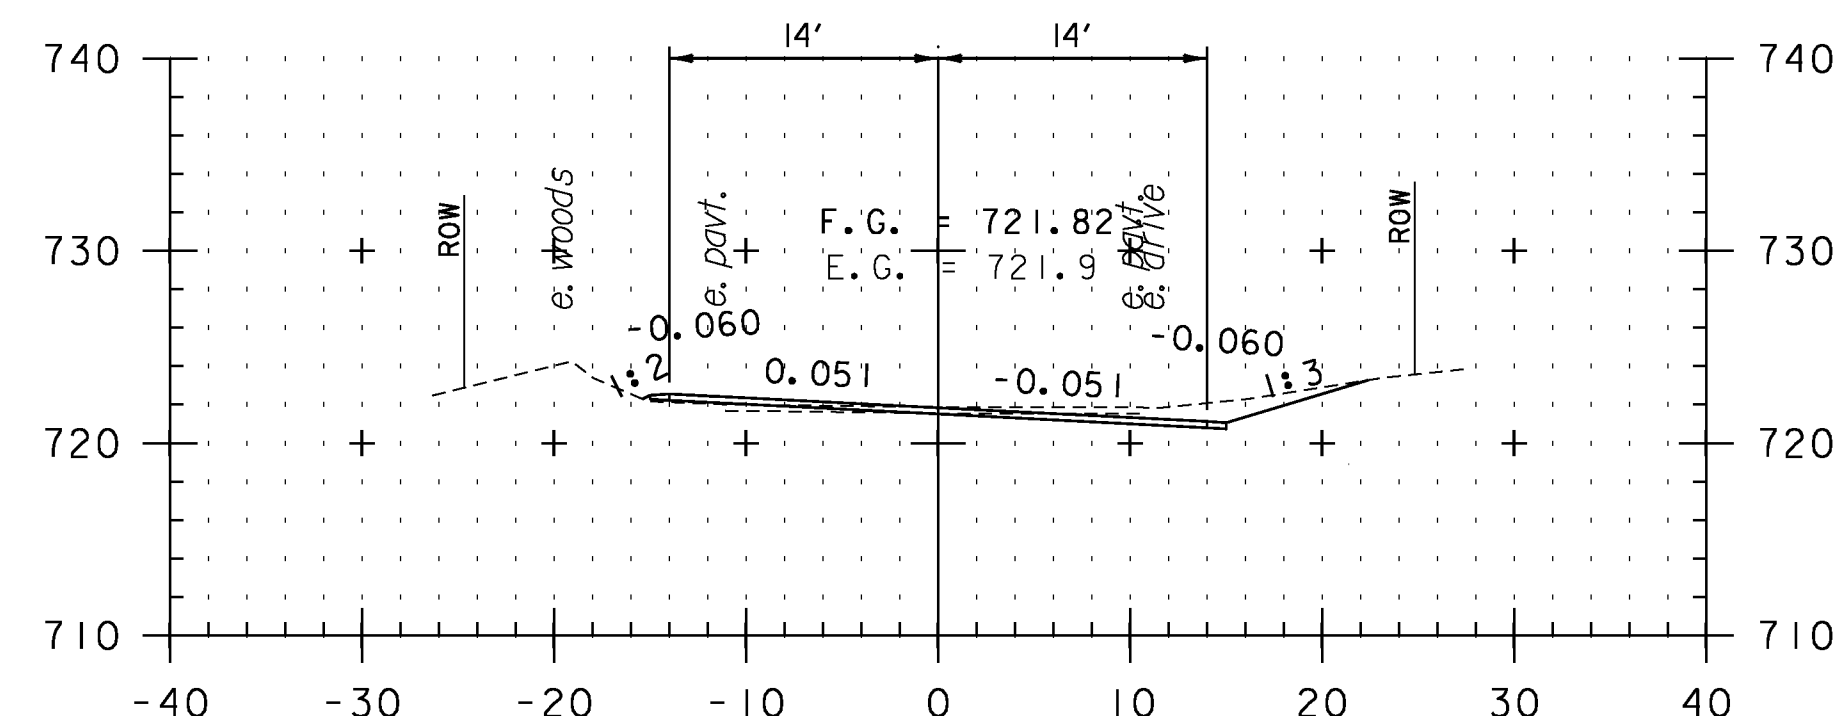

T26+00

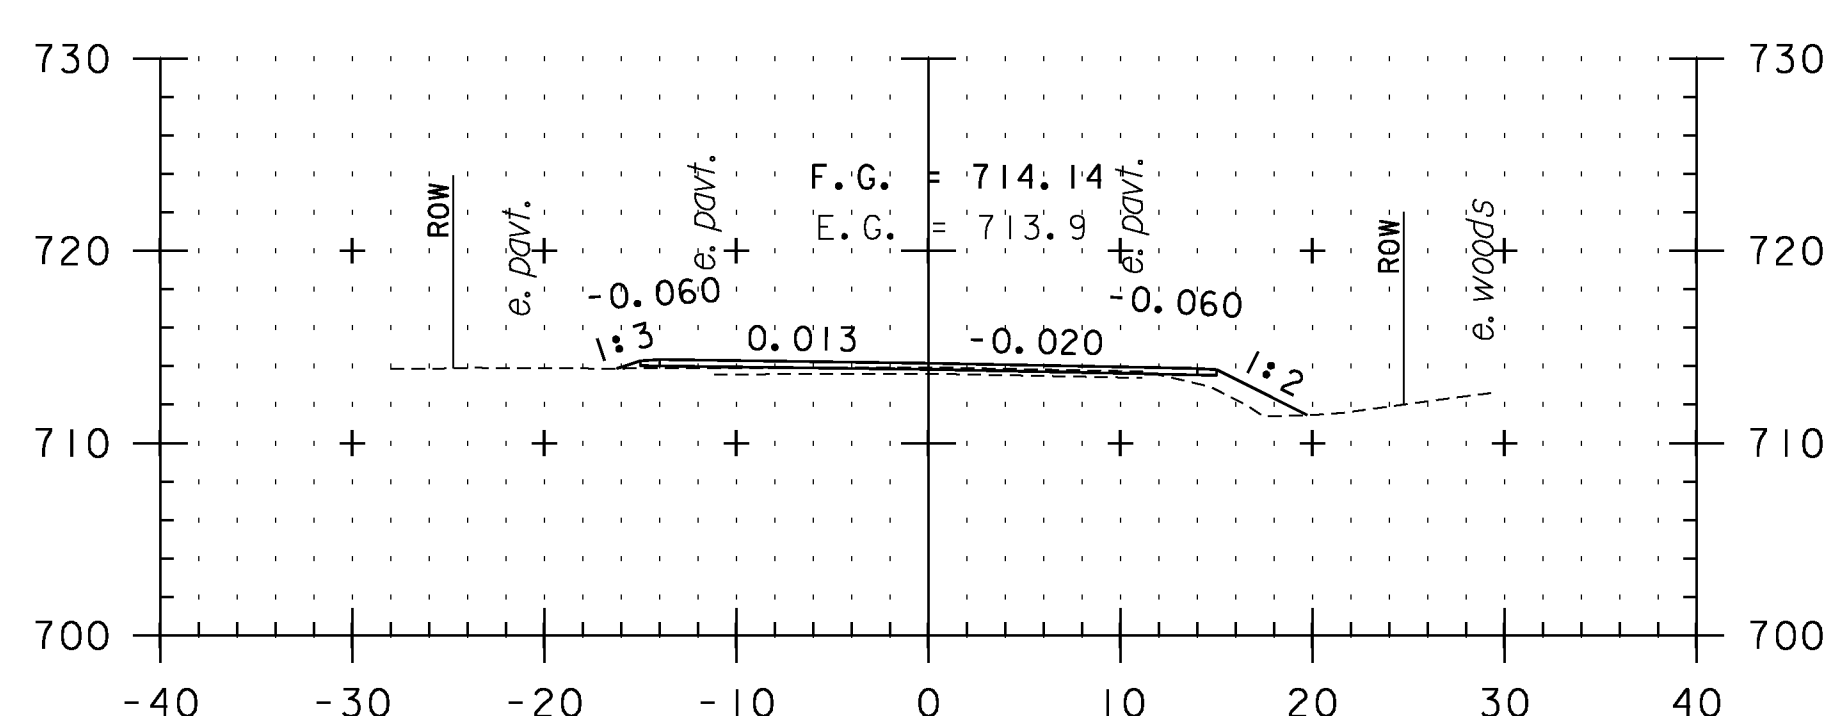


T27+50

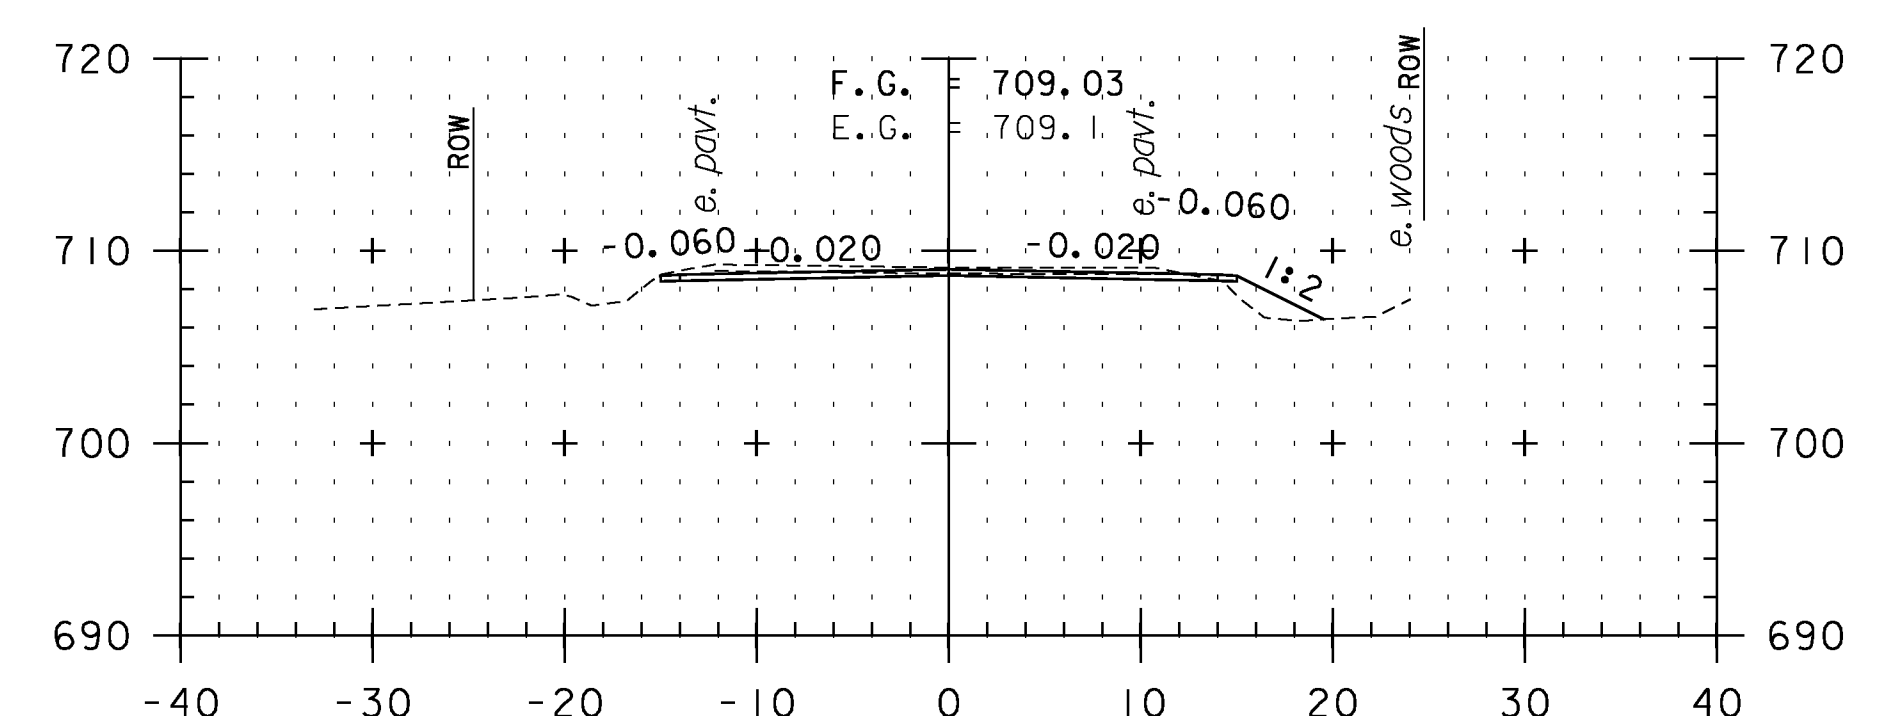

T29+00

CROSS SECTION SHEET 93

STA. T26+00 TO STA. T30+00

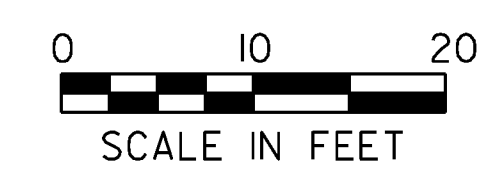

PROJECT NAME: VERSHIRE-THETFORD	PLOT DATE: 1/29/2013
PROJECT NUMBER: STP 2911(I)	DRAWN BY: SNG
FILE NAME: pl0c224.dgn	CHECKED BY: PTS
PROJECT LEADER: PTS	SHEET 201 OF 232
DESIGNED BY: NLL	
IPARM FILE NAME: IOC224_201	