




T31+50

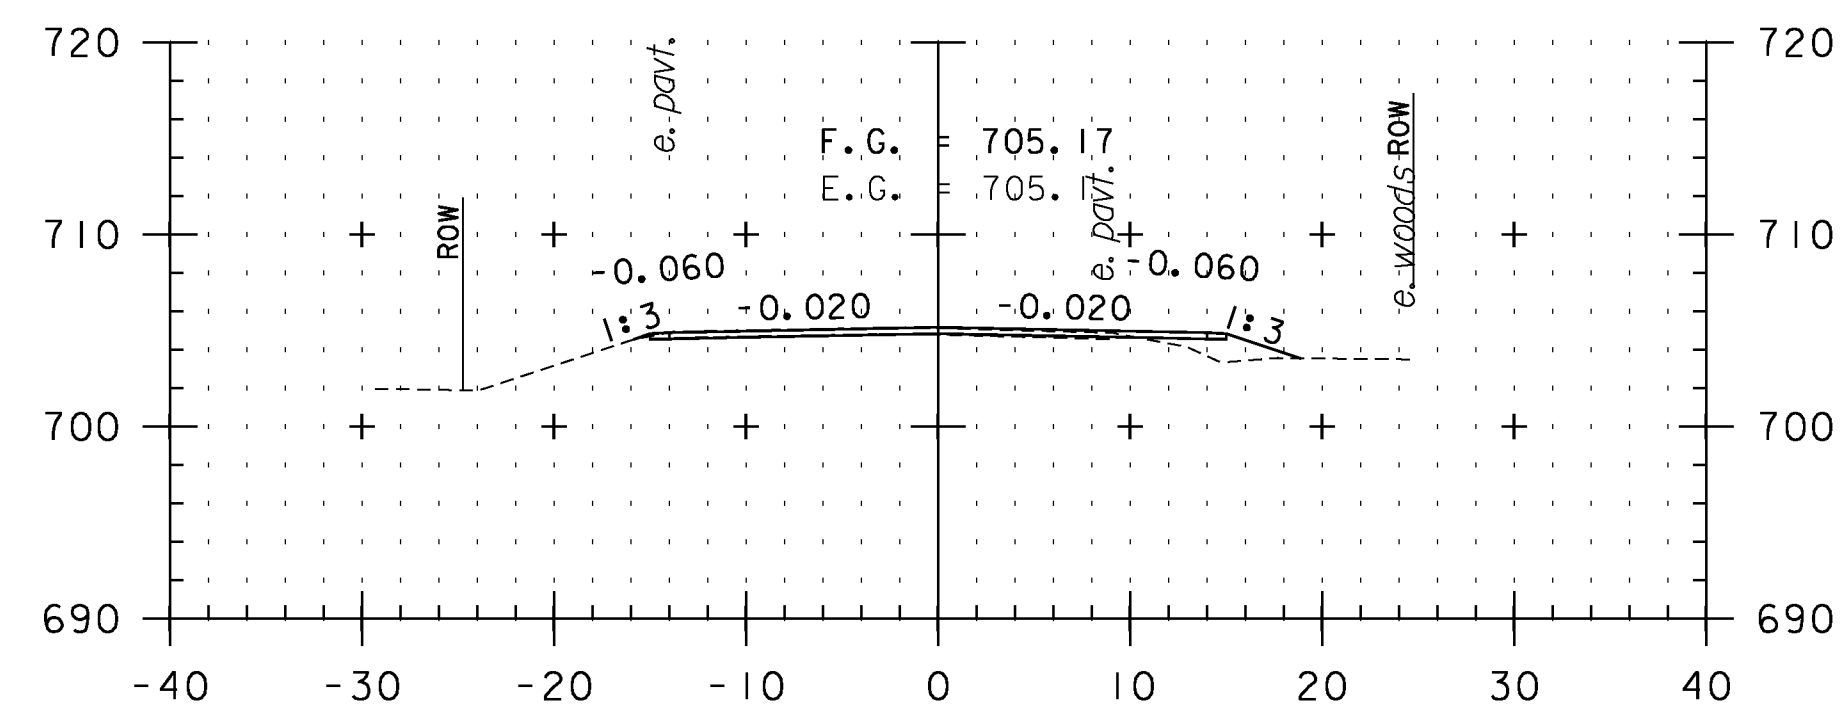


T31+00

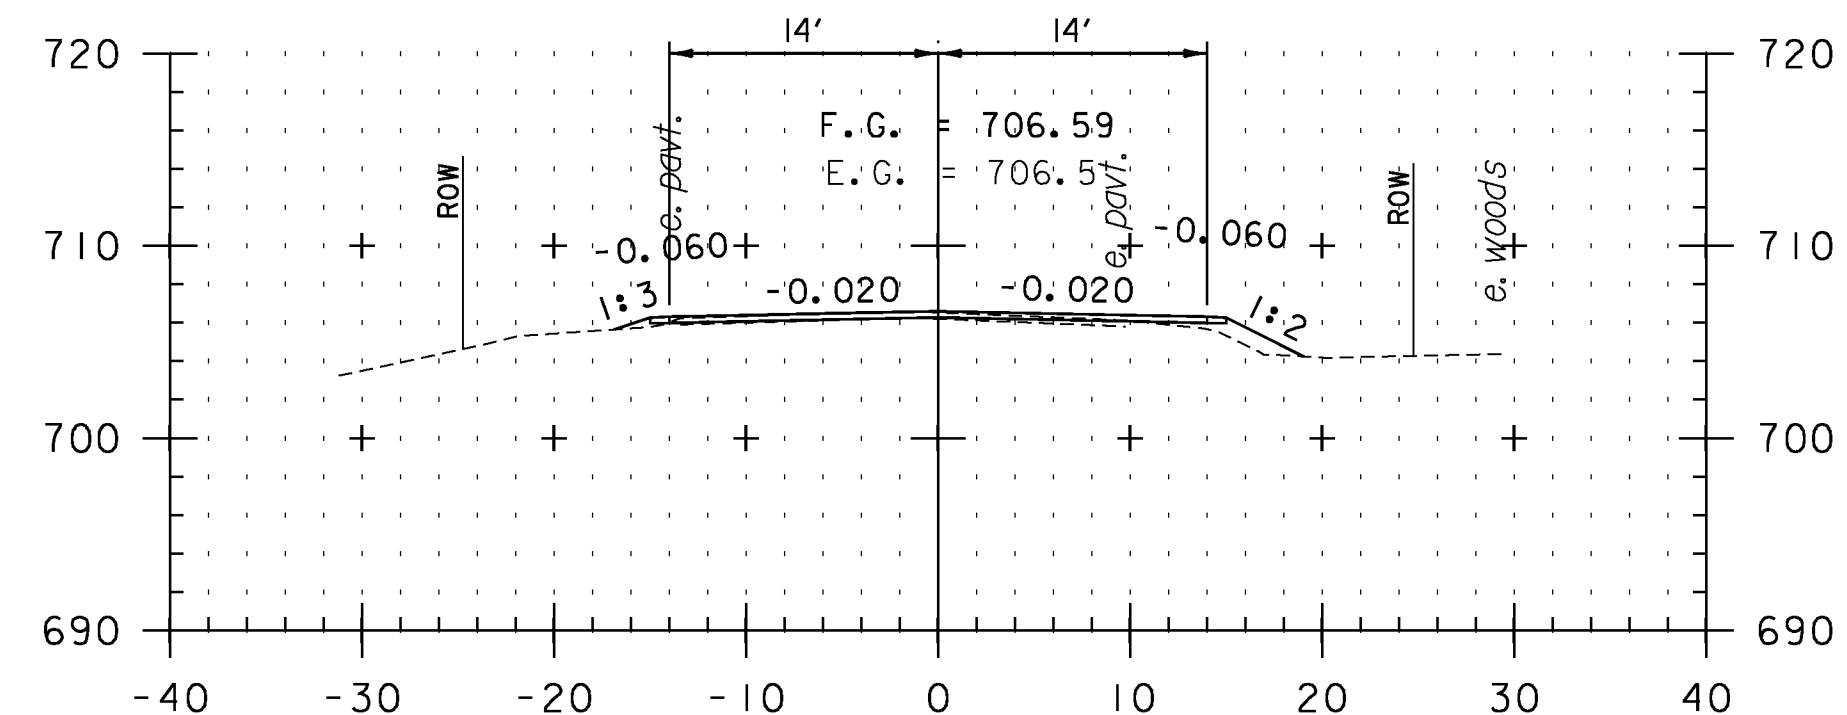


T30+50

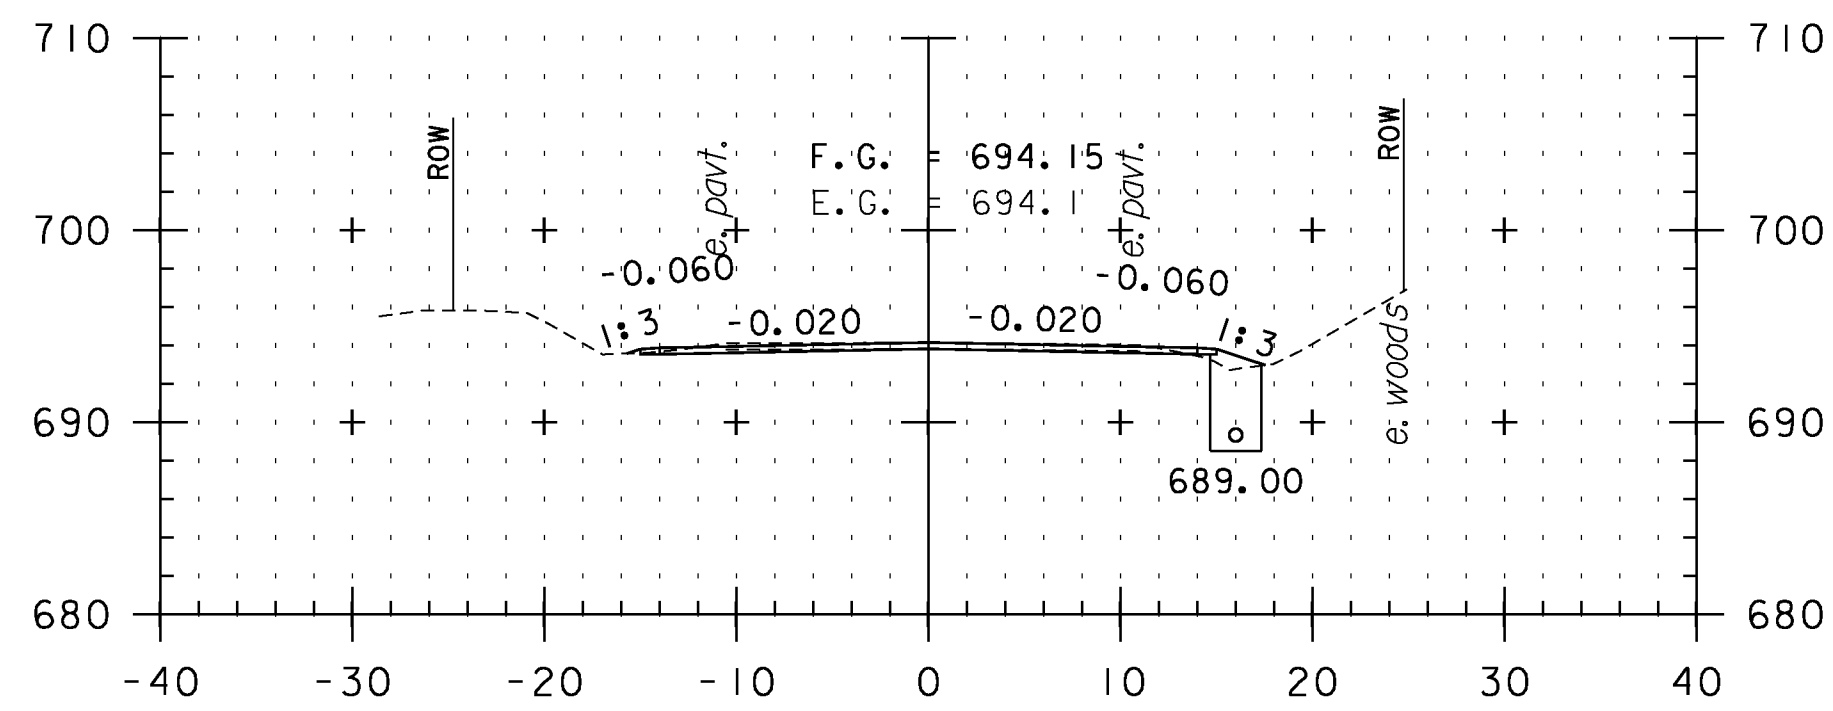


T33+00

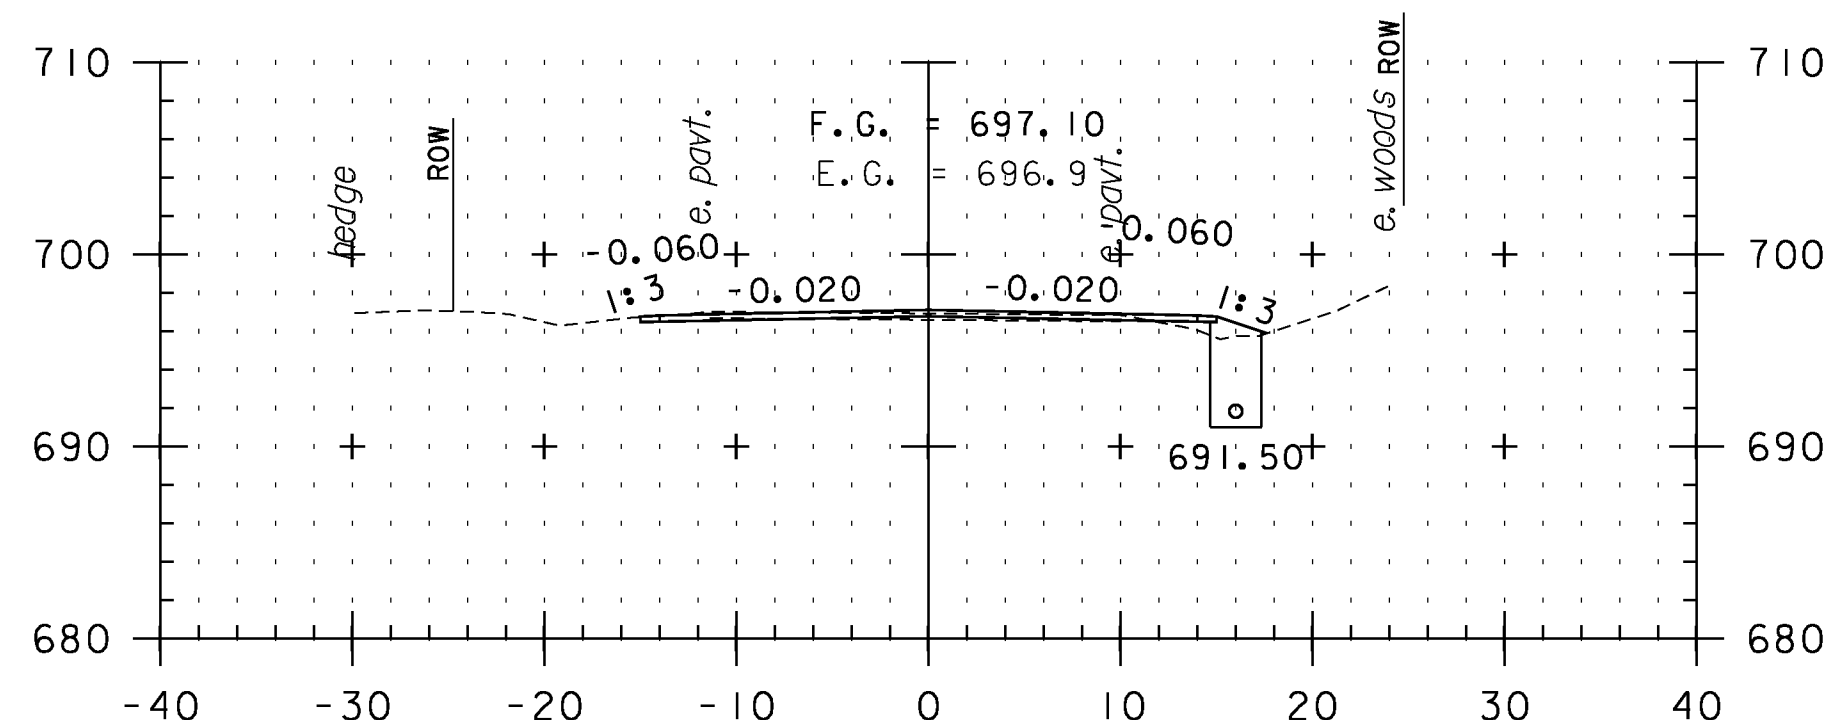


T32+50

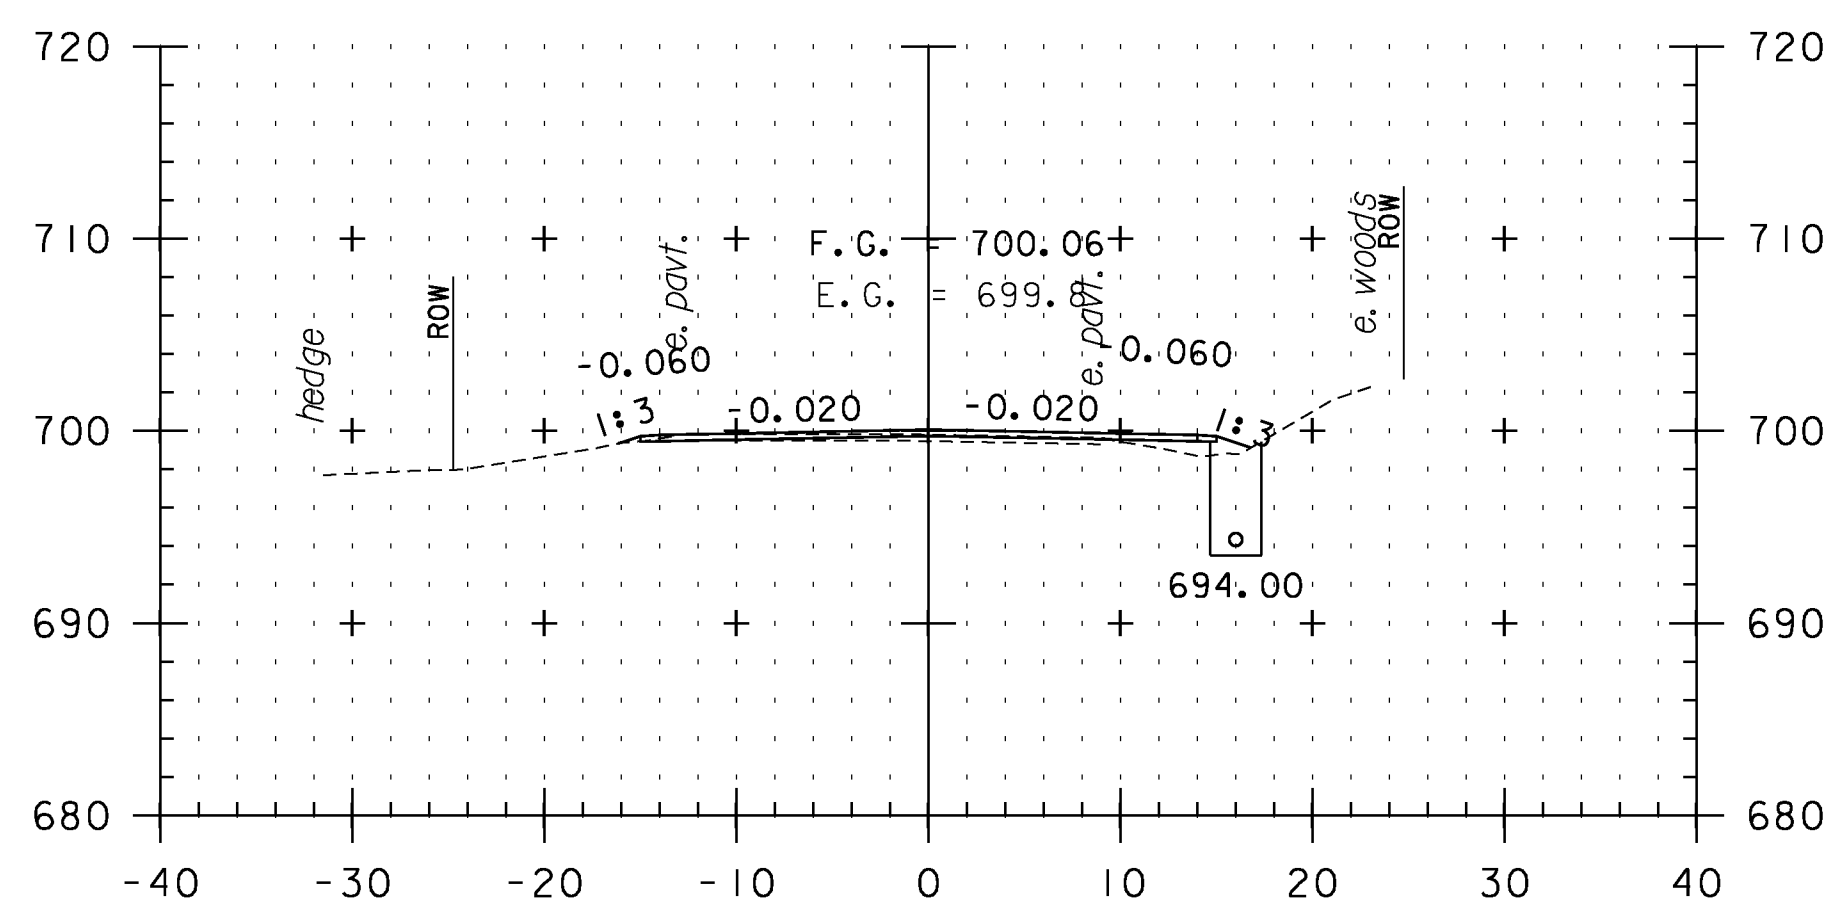


T32+00

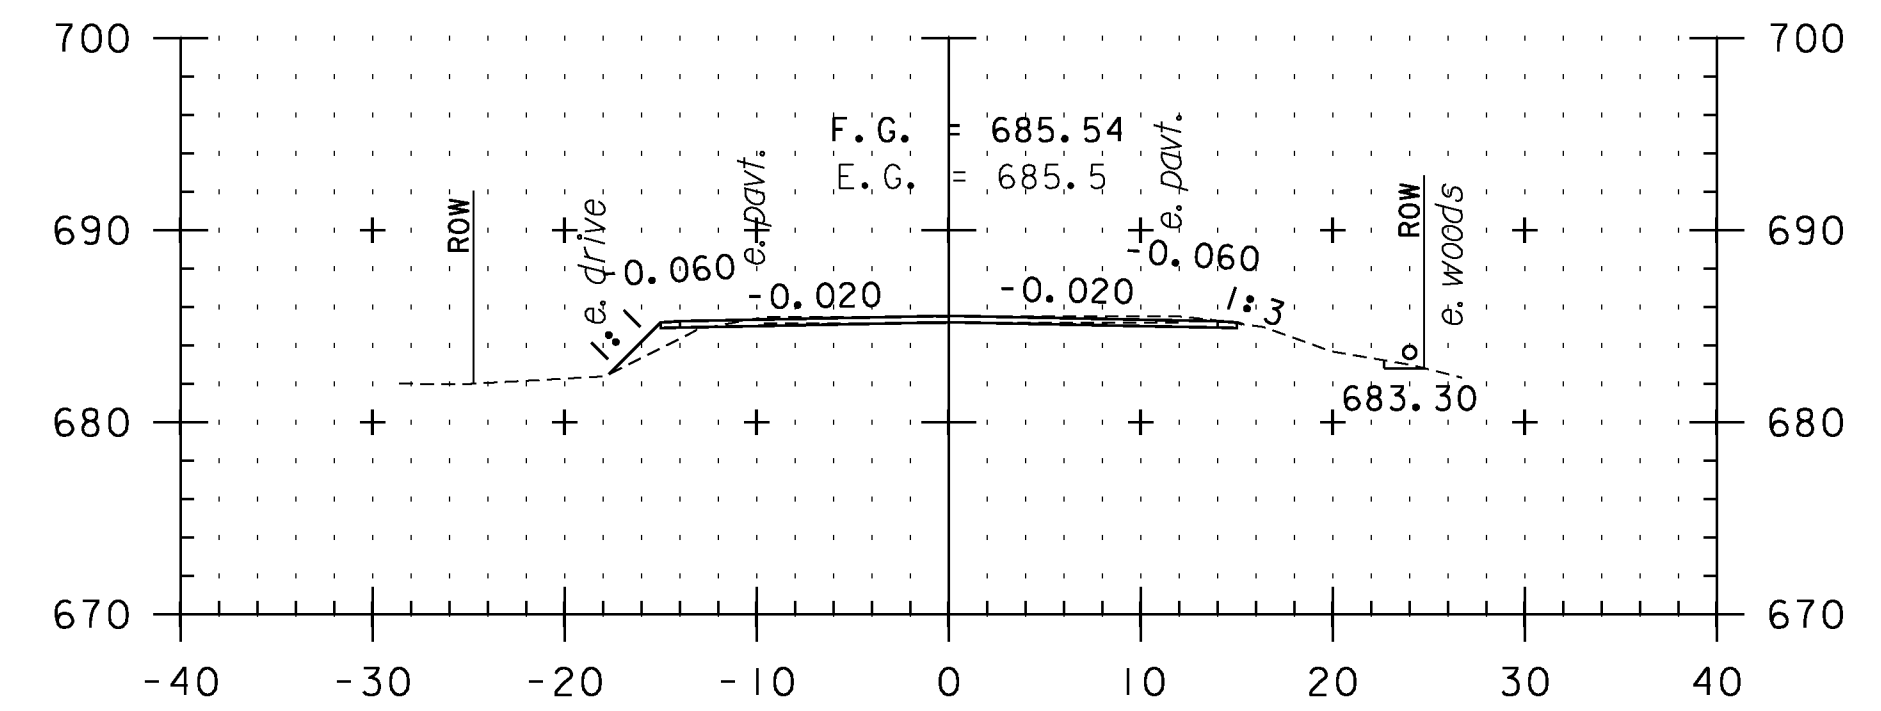

T34+50

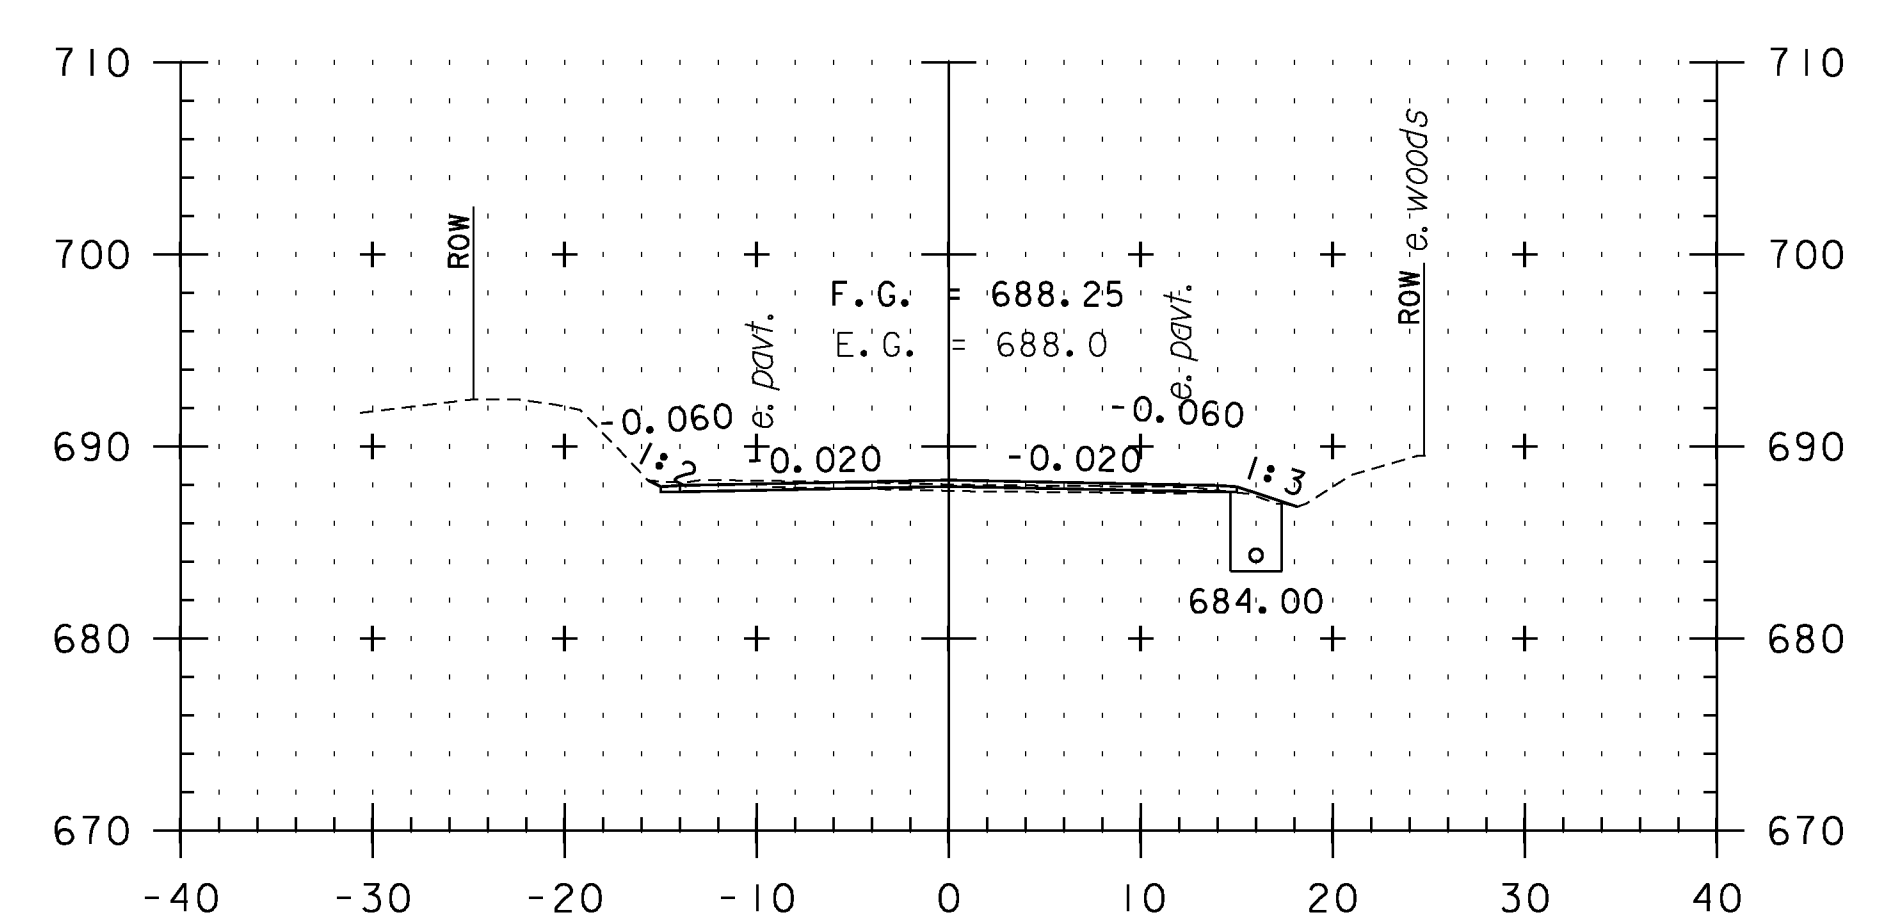

T34+00

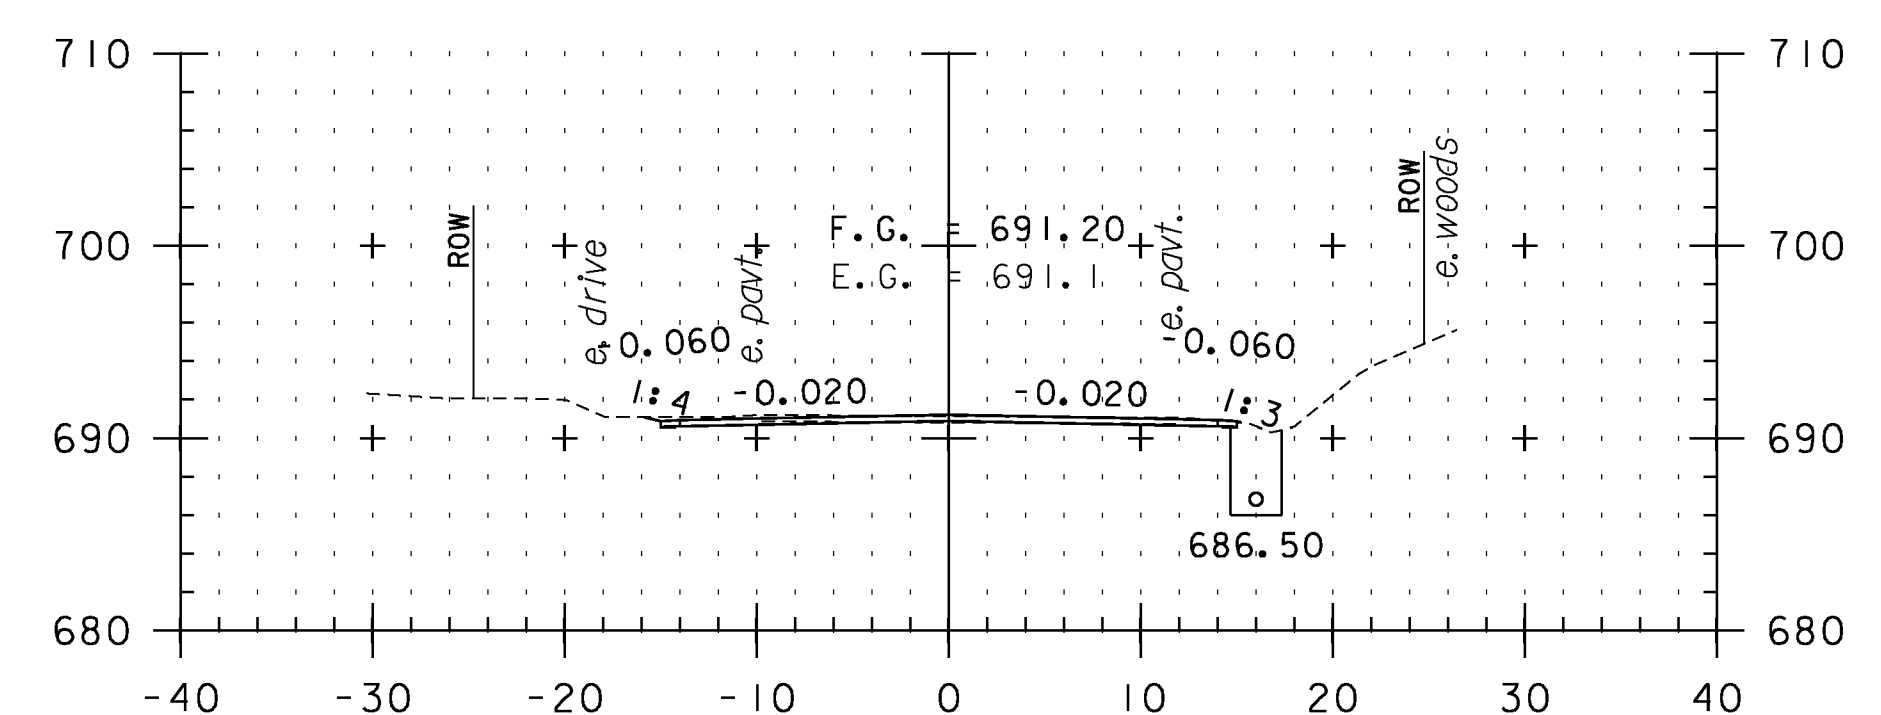

T33+50

**CROSS SECTION SHEET 94**

PROJECT NAME: VERSHIRE-THETFORD

PROJECT NUMBER: STP 2911(I)

FILE NAME: pl0c224.dgn

PLOT DATE: 1/29/2013

PROJECT LEADER: PTS

DRAWN BY: SNG

DESIGNED BY: NLL

CHECKED BY: PTS

IPARM FILE NAME: IOC224\_202

SHEET 202 OF 232

STA. T30+50 TO STA. T34+50

