




T40+50

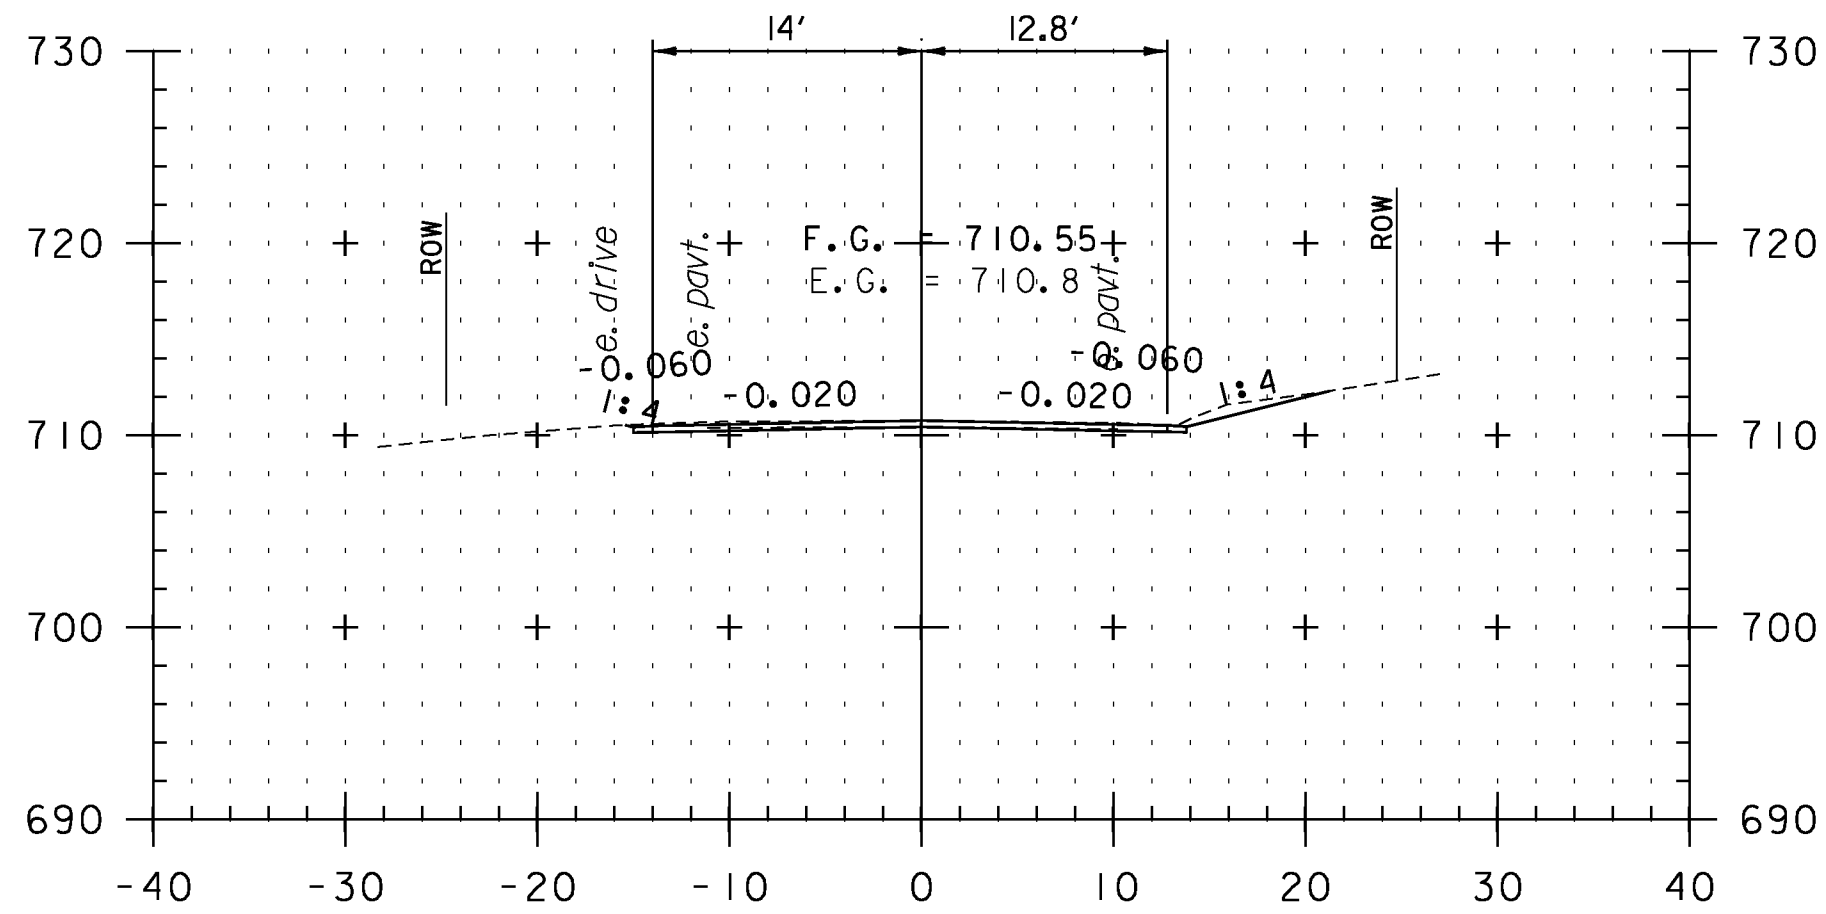


T42+00

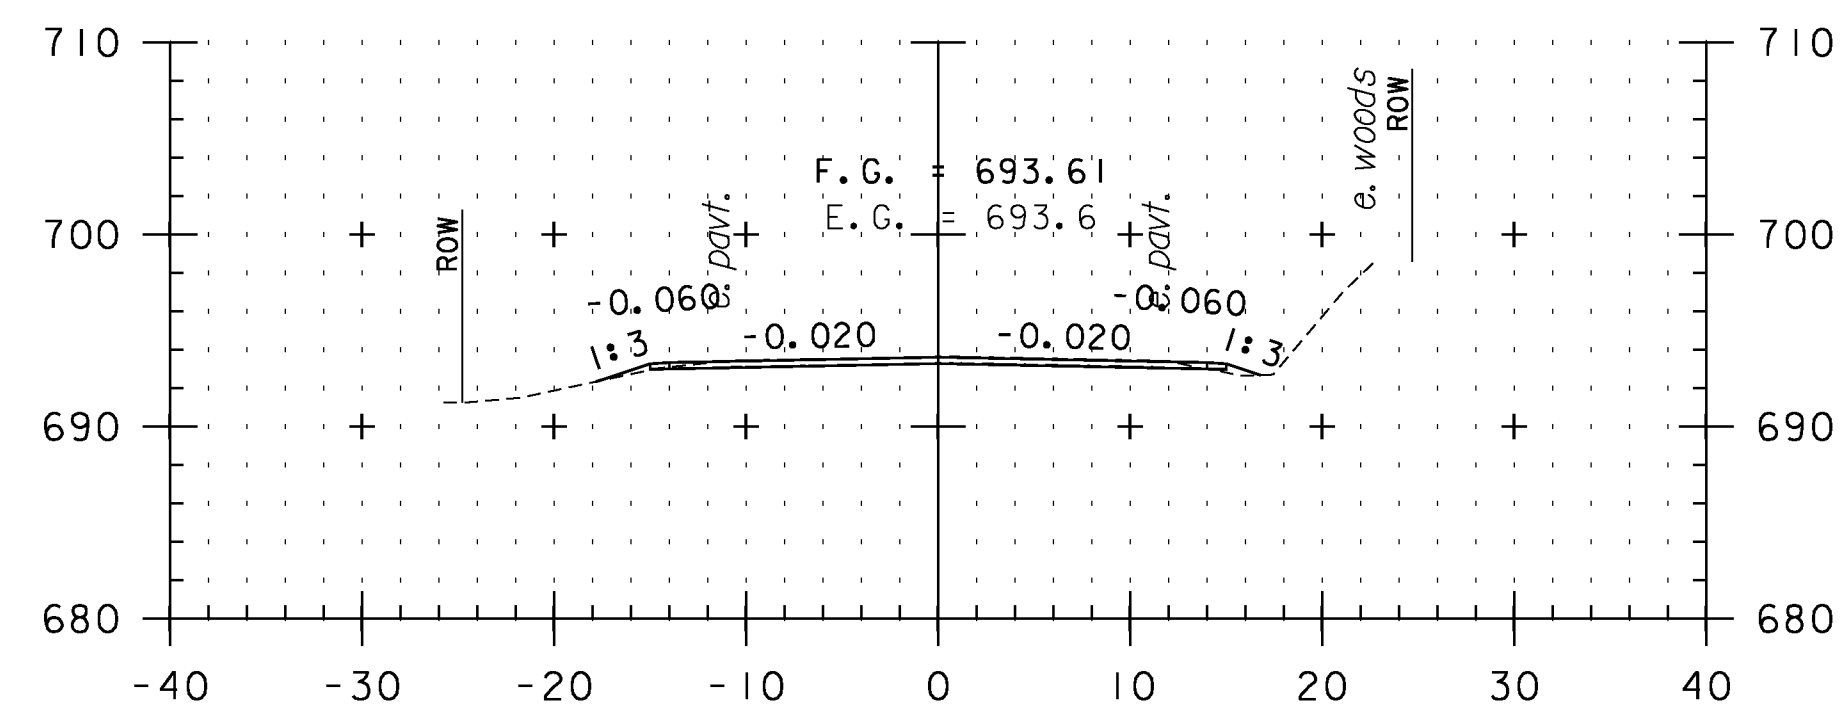


T40+00

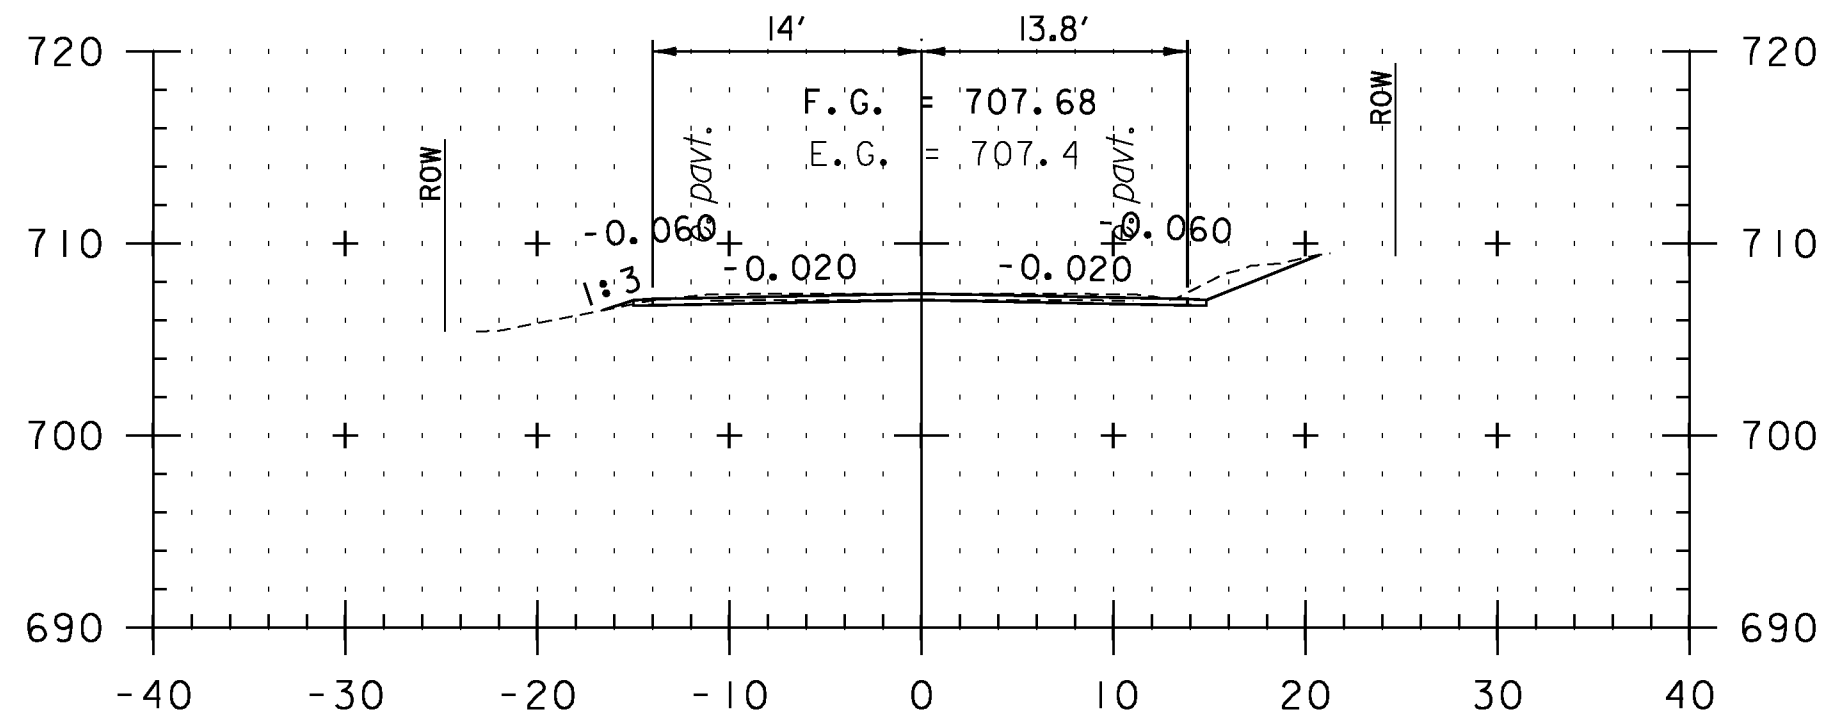


T41+50

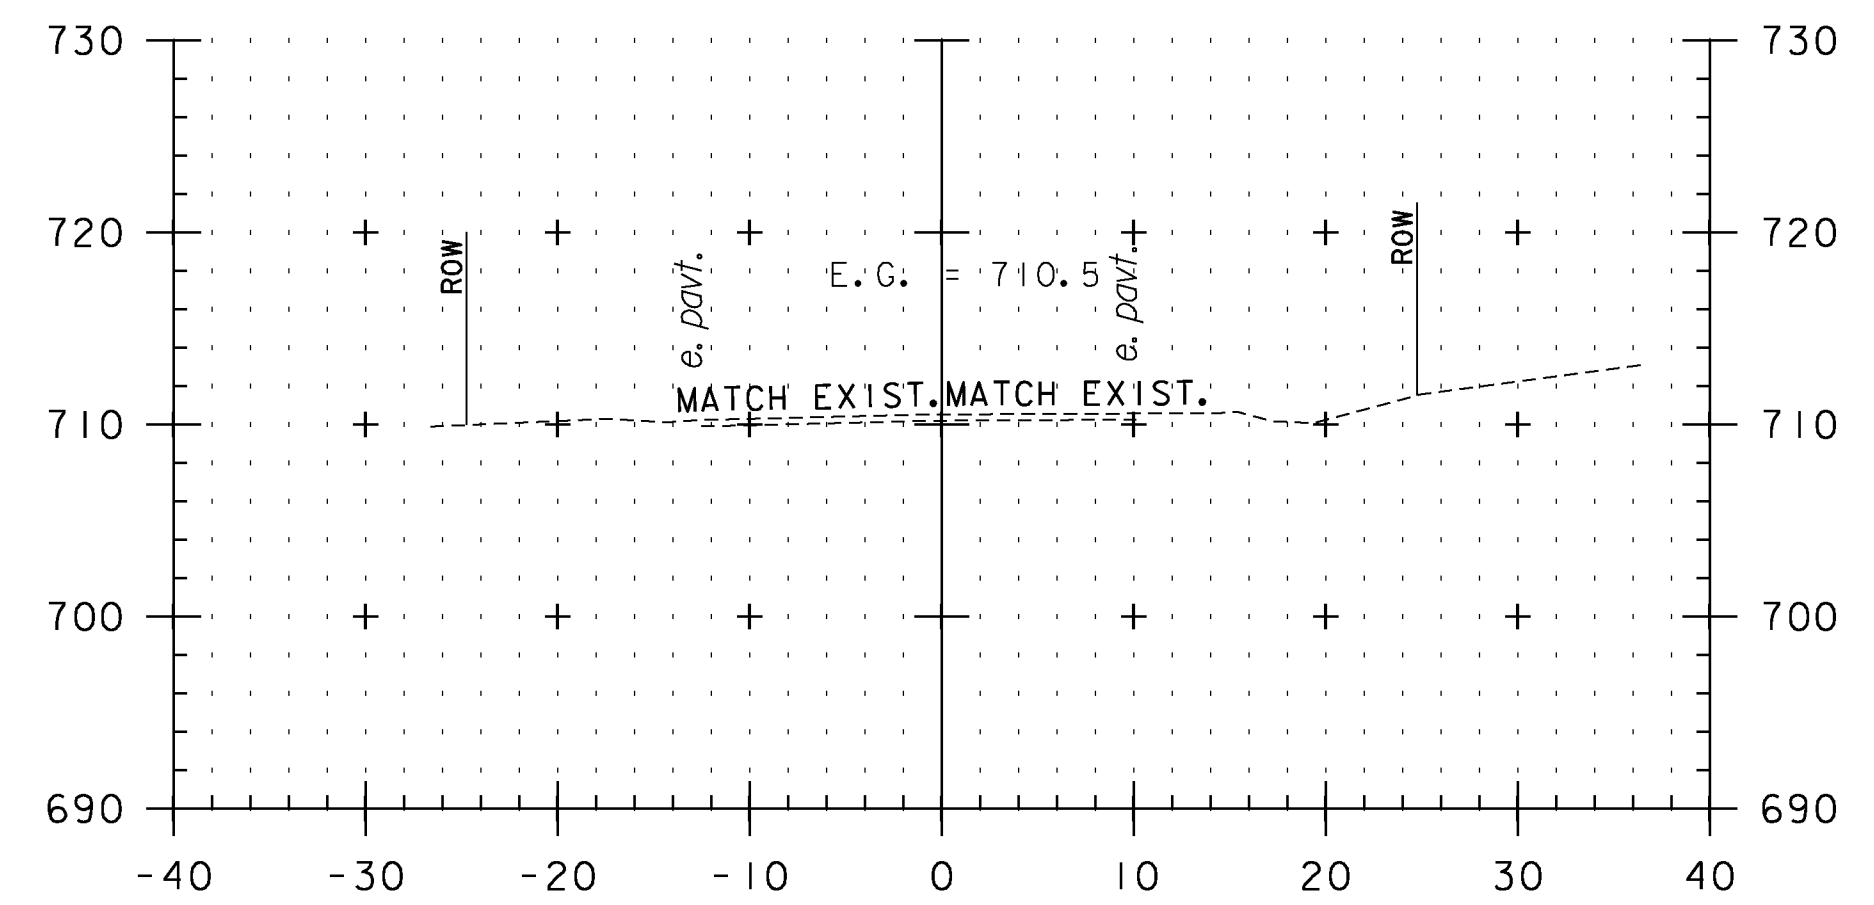


T42+93  
END PROJECT

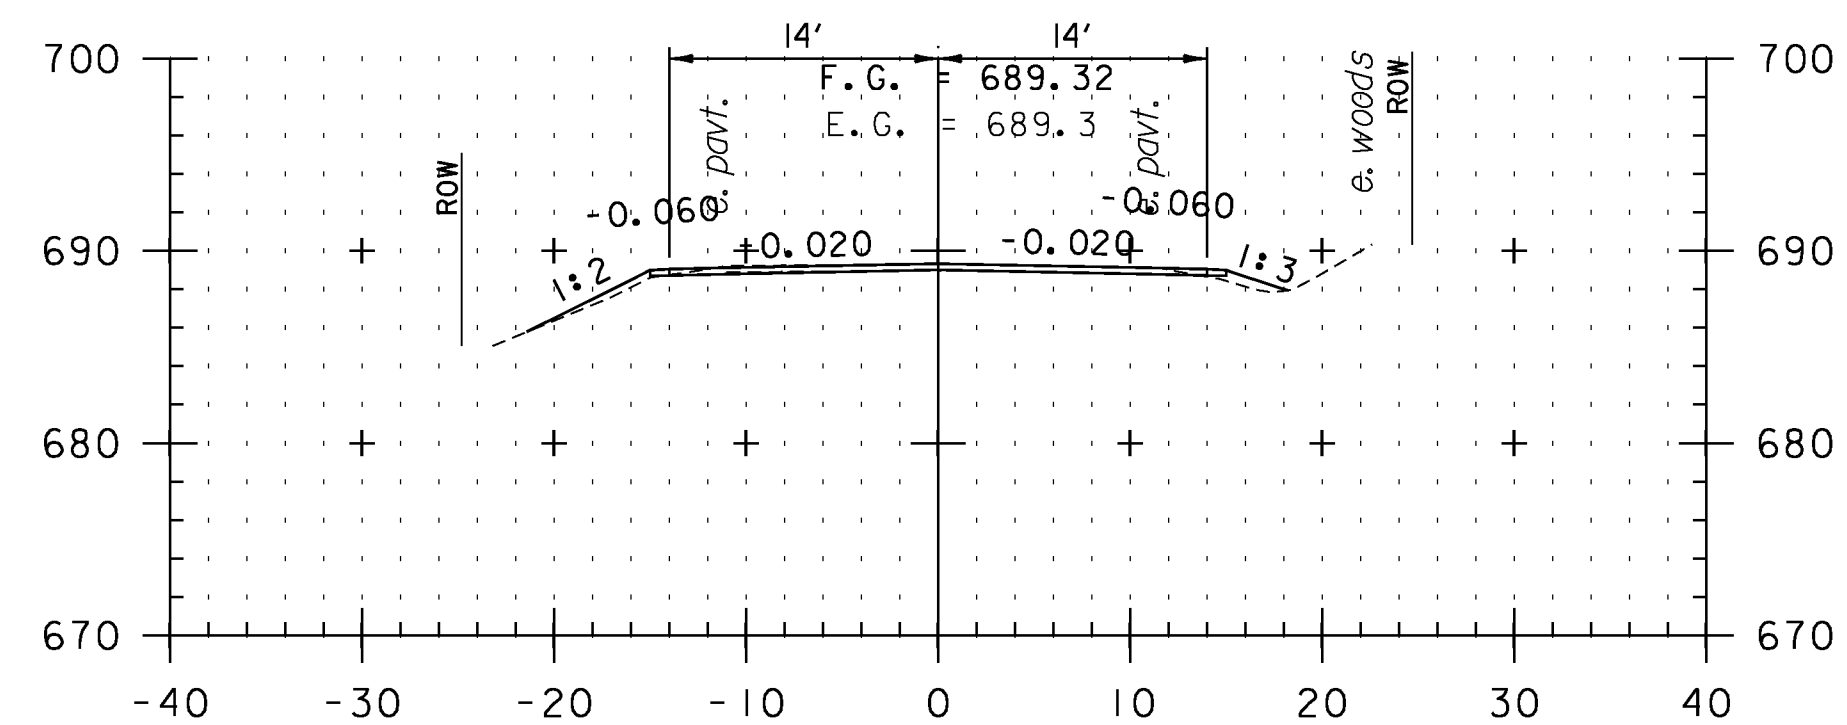

T39+50

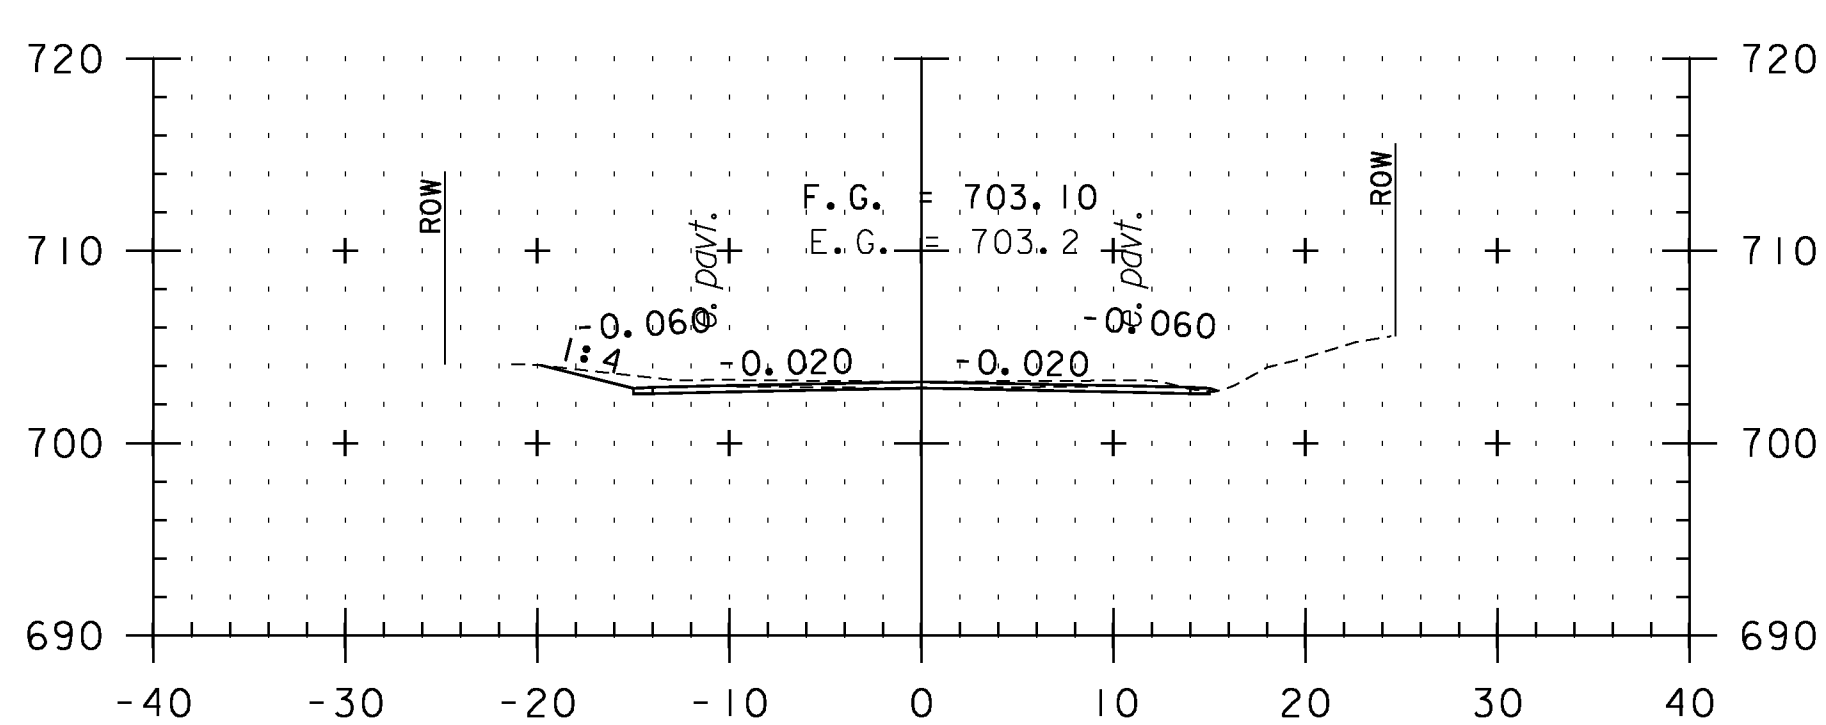

T41+00

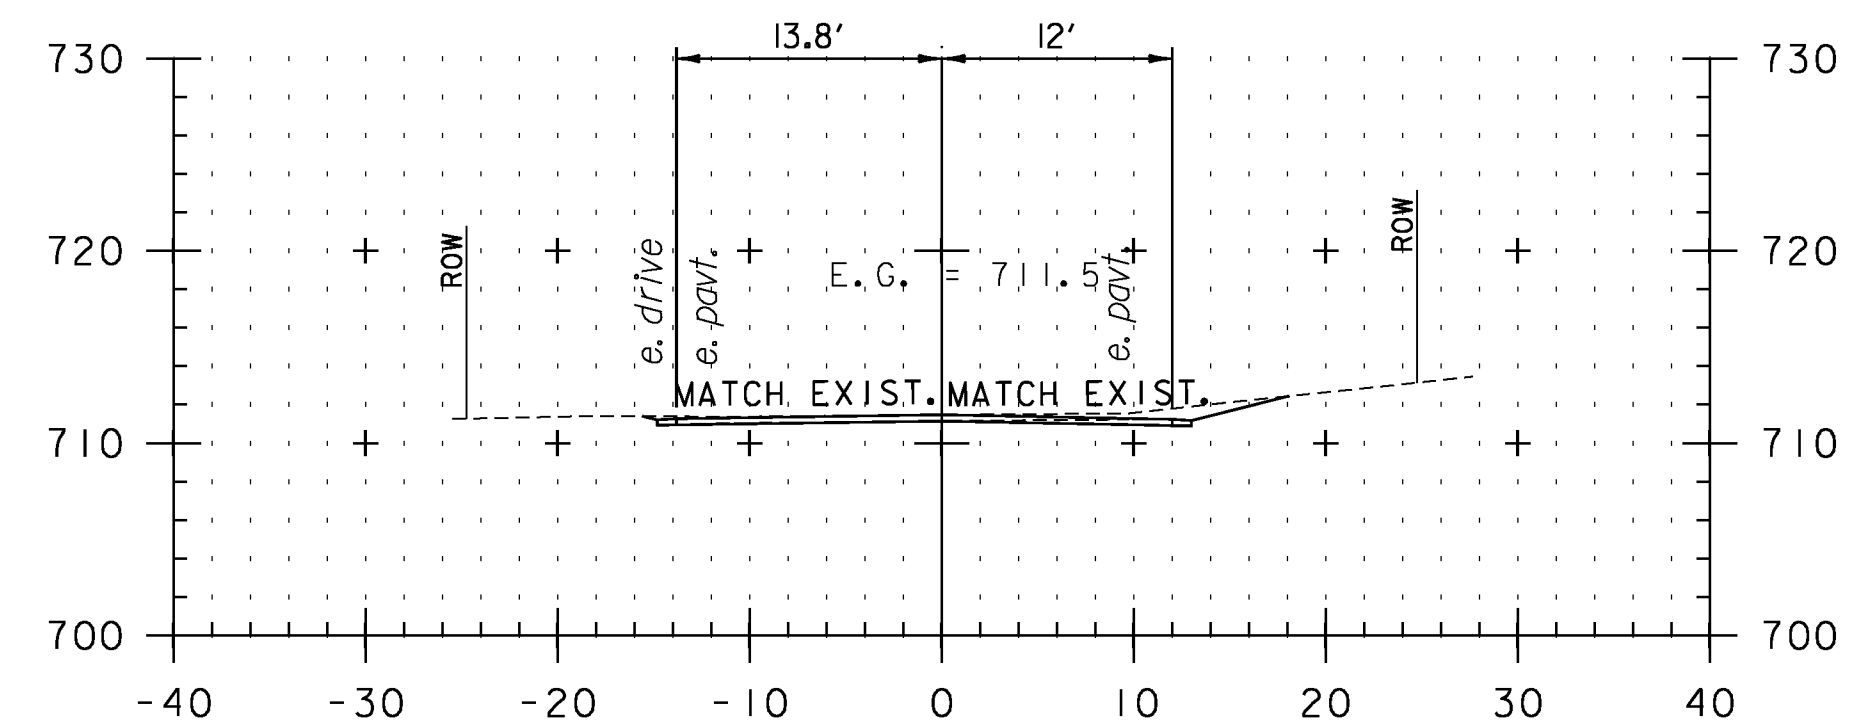

T42+50

**CROSS SECTION SHEET 96**

STA. T39+50 TO STA. T42+93



PROJECT NAME: VERSHIRE-THETFORD	PLOT DATE: 1/29/2013
PROJECT NUMBER: STP 2911(I)	DRAWN BY: SNG
FILE NAME: pl0c224.dgn	CHECKED BY: PTS
PROJECT LEADER: PTS	SHEET 204 OF 232
DESIGNED BY: NULL	
IPARM FILE NAME: IOC224_204	