


STA. 194+71 TO STA. 210+02

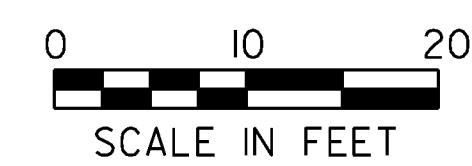

UTILITY CROSS SECTION SHEET 2

PROJECT NAME: VERSHIRE-THETFORD

PROJECT NUMBER: STP 2911(I)

FILE NAME: pl0c224.dgn

PROJECT LEADER: PTS

DESIGNED BY: NLL

IPARM FILE NAME: IOC224_206

PLOT DATE: 1/29/2013

DRAWN BY: JLS

CHECKED BY: PTS

SHEET 206 OF 232