


STA. 210+72 TO STA. 218+79

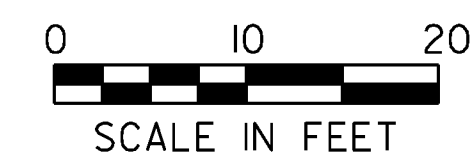

UTILITY CROSS SECTION SHEET 3

PROJECT NAME: VERSHIRE-THETFORD

PROJECT NUMBER: STP 2911(I)

FILE NAME: pl0c224.dgn

PLOT DATE: 1/29/2013

PROJECT LEADER: PTS

DRAWN BY: JLS

DESIGNED BY: NLL

CHECKED BY: PTS

IPARM FILE NAME: IOC224_207

SHEET 207 OF 232