




223+47

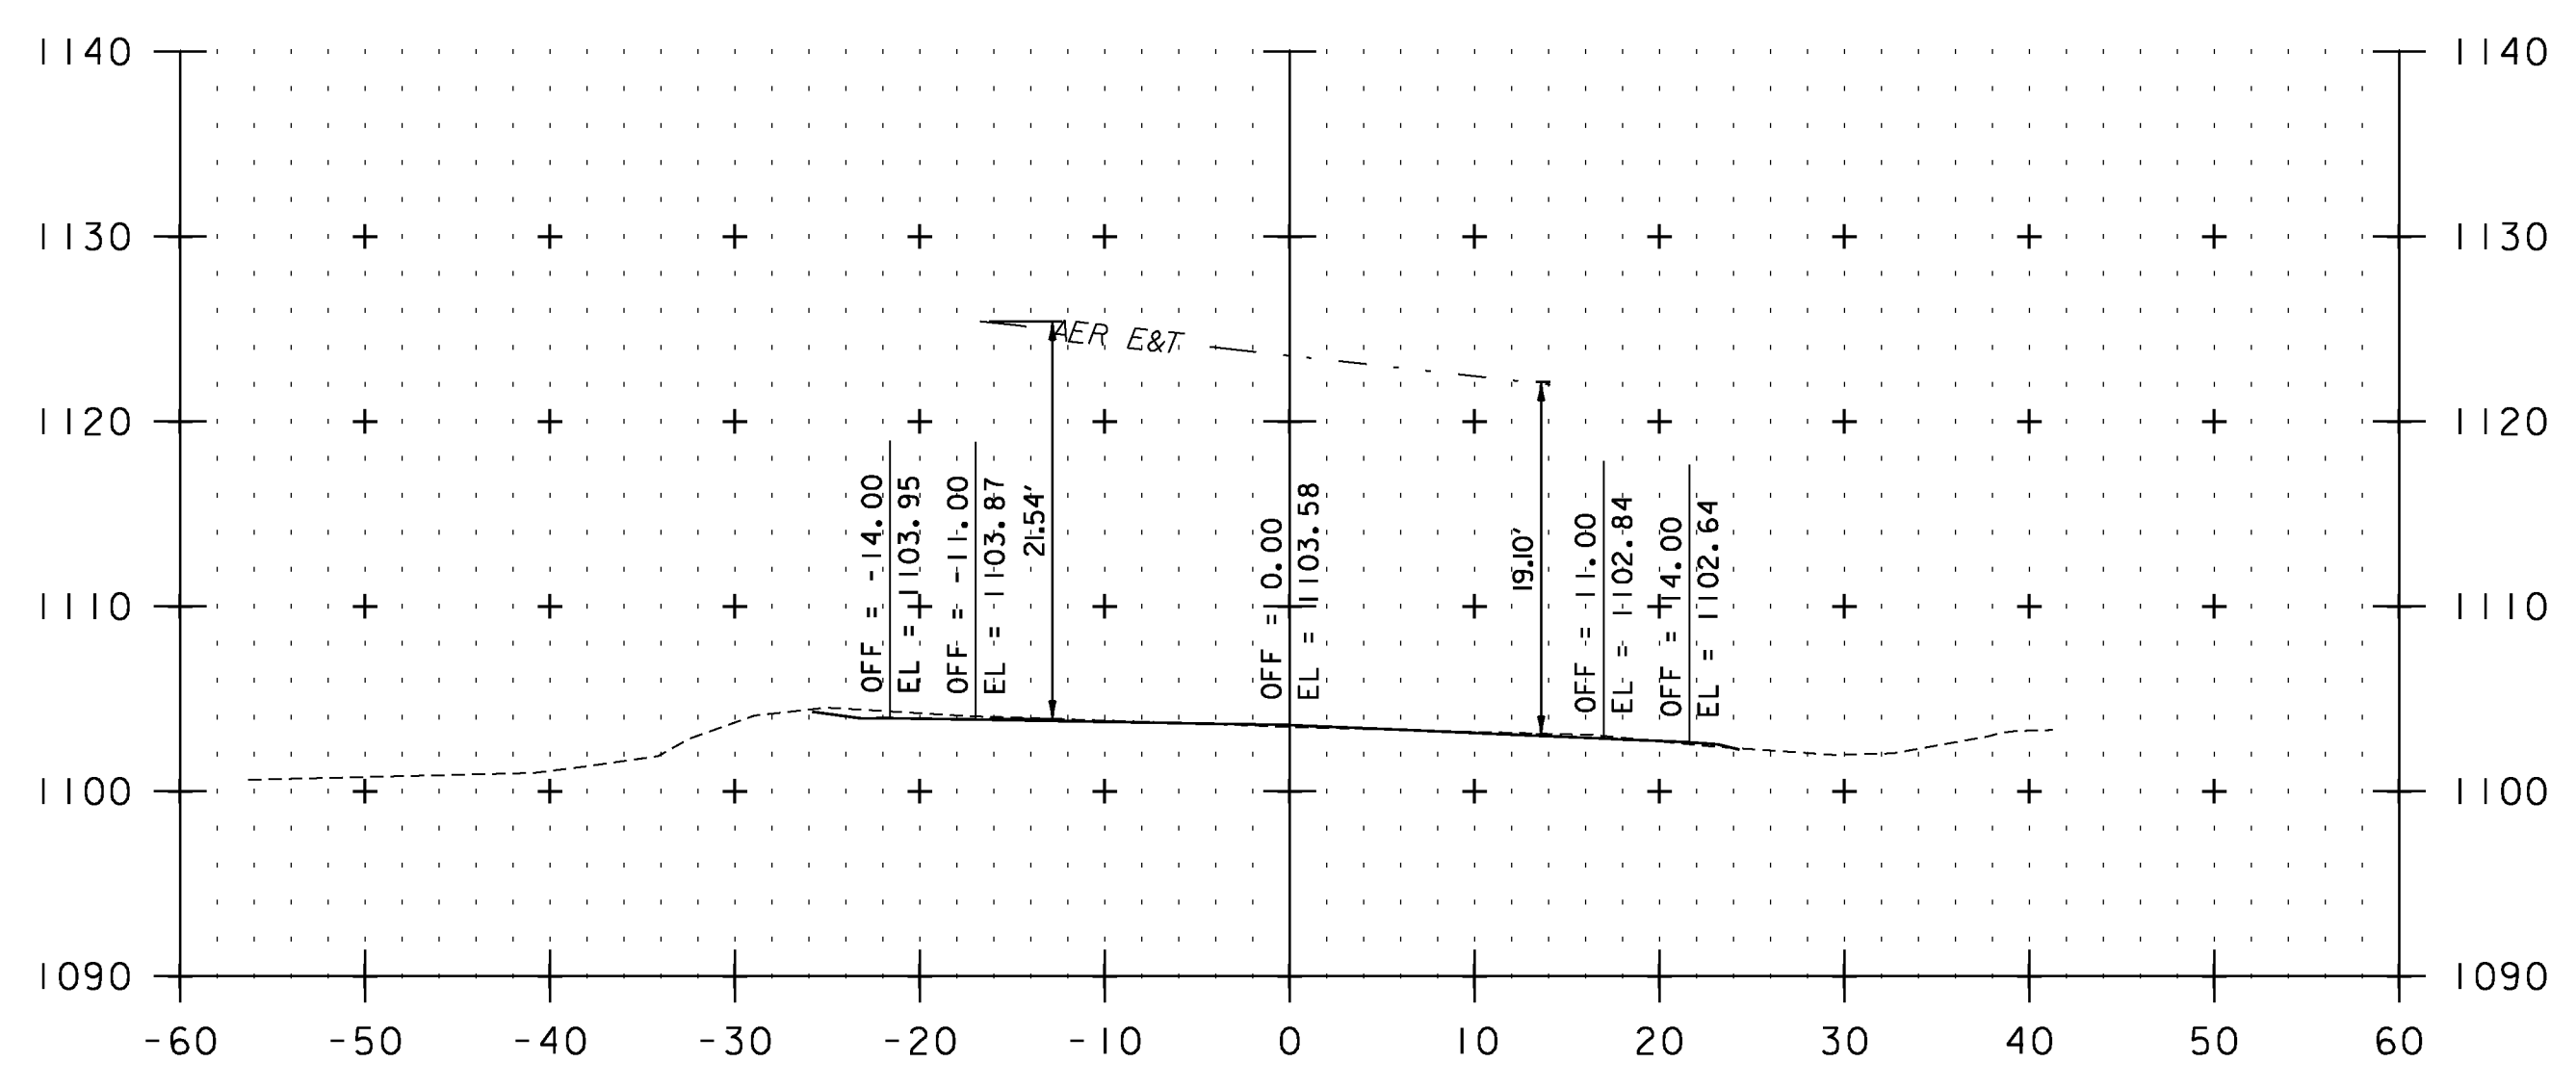

222+70

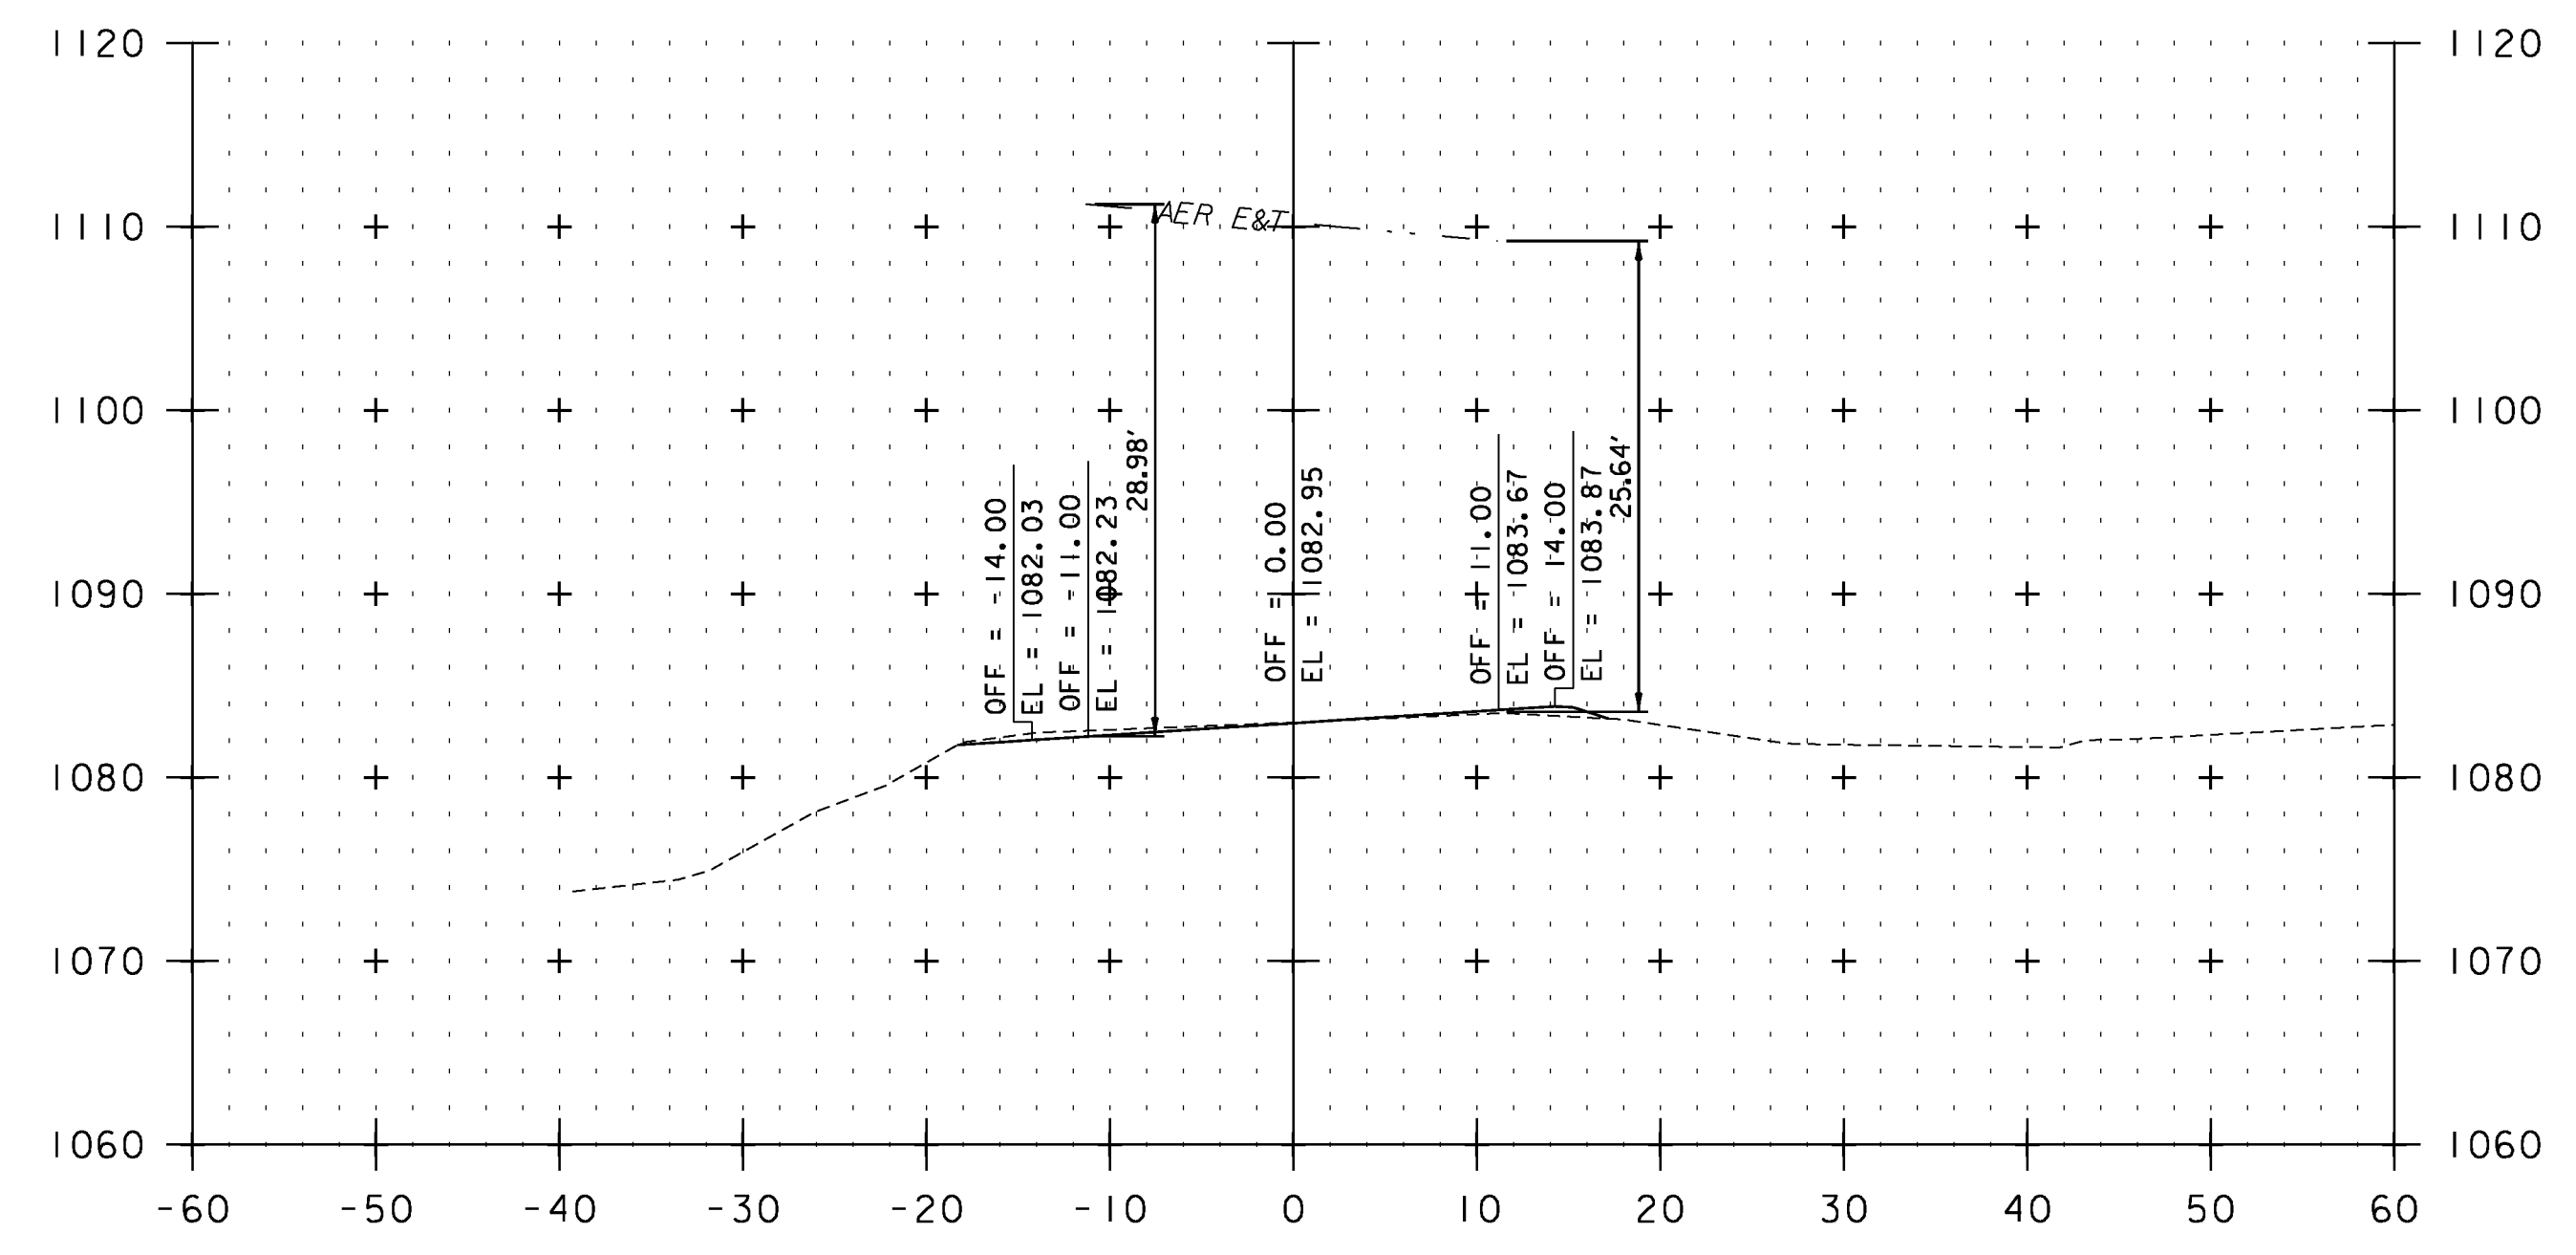

231+87

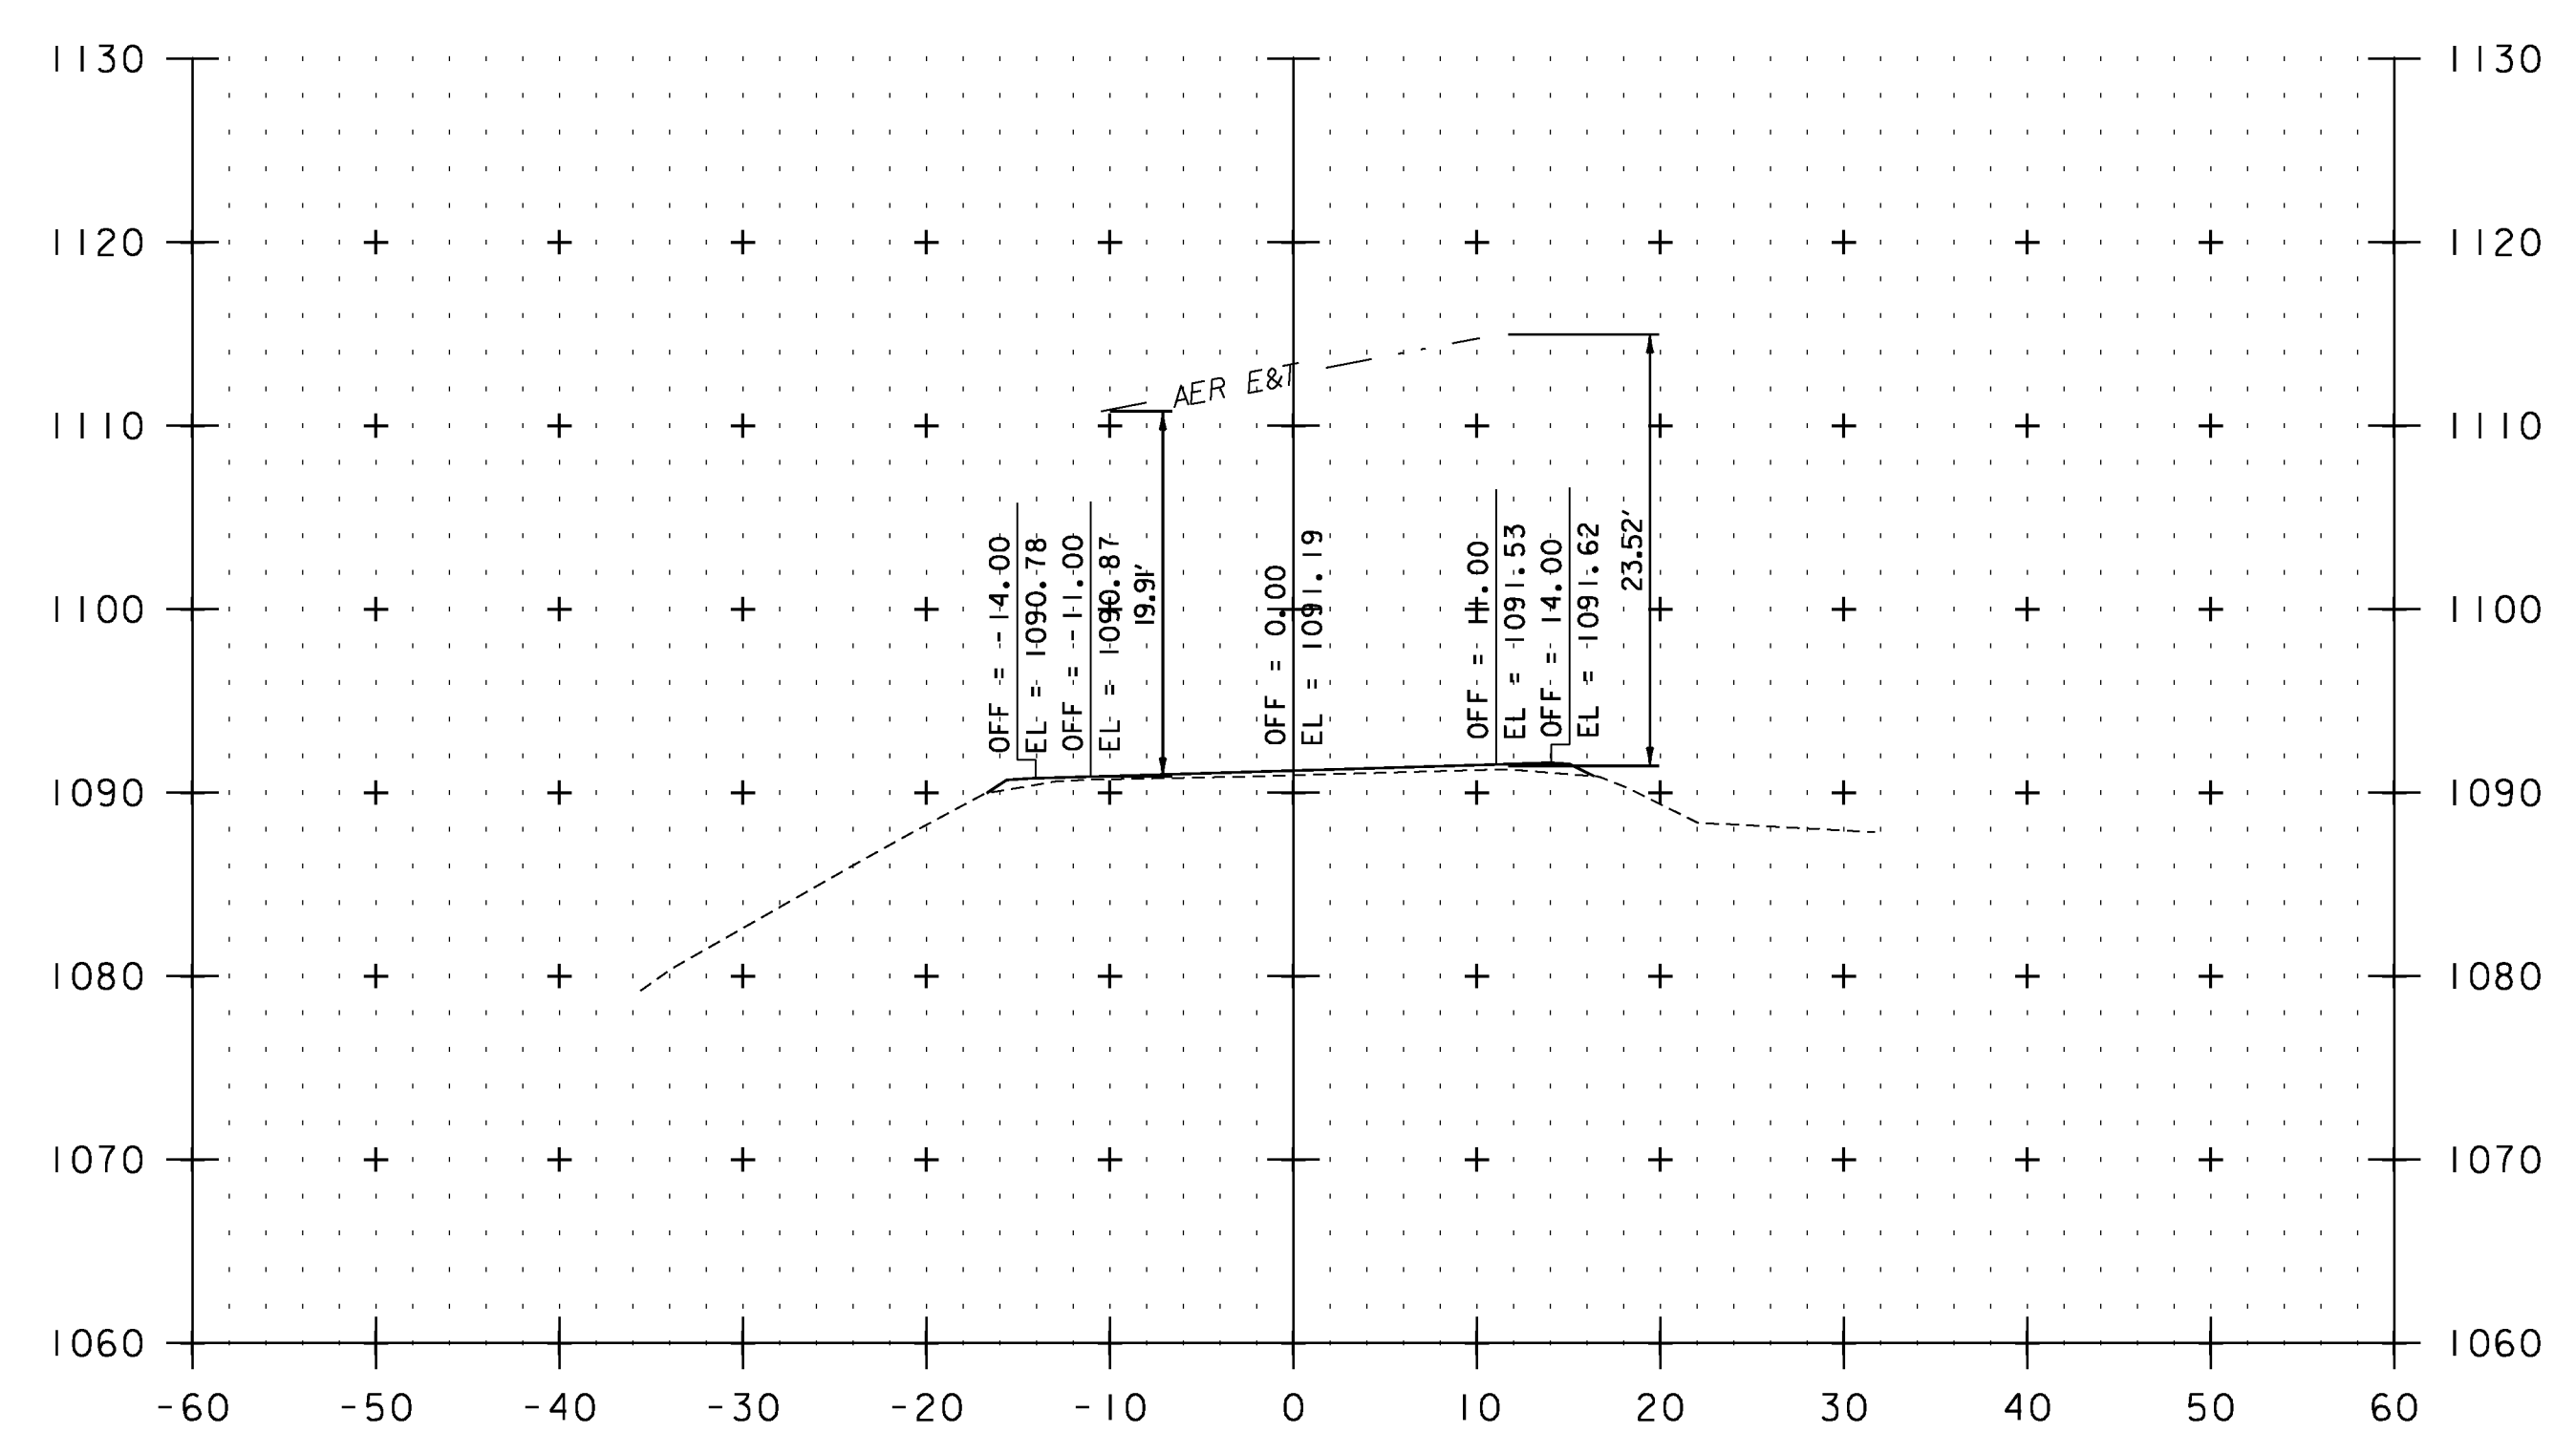

229+07

STA. 222+70 TO STA. 231+87



UTILITY CROSS SECTION SHEET 4

PROJECT NAME: VERSHIRE-THETFORD
 PROJECT NUMBER: STP 291(I)

FILE NAME: pl0c224.dgn
 PROJECT LEADER: PTS
 DESIGNED BY: NLL
 IPARM FILE NAME: IOC224_208

PLOT DATE: 1/29/2013
 DRAWN BY: JLS
 CHECKED BY: PTS
 SHEET 208 OF 232