




254+47

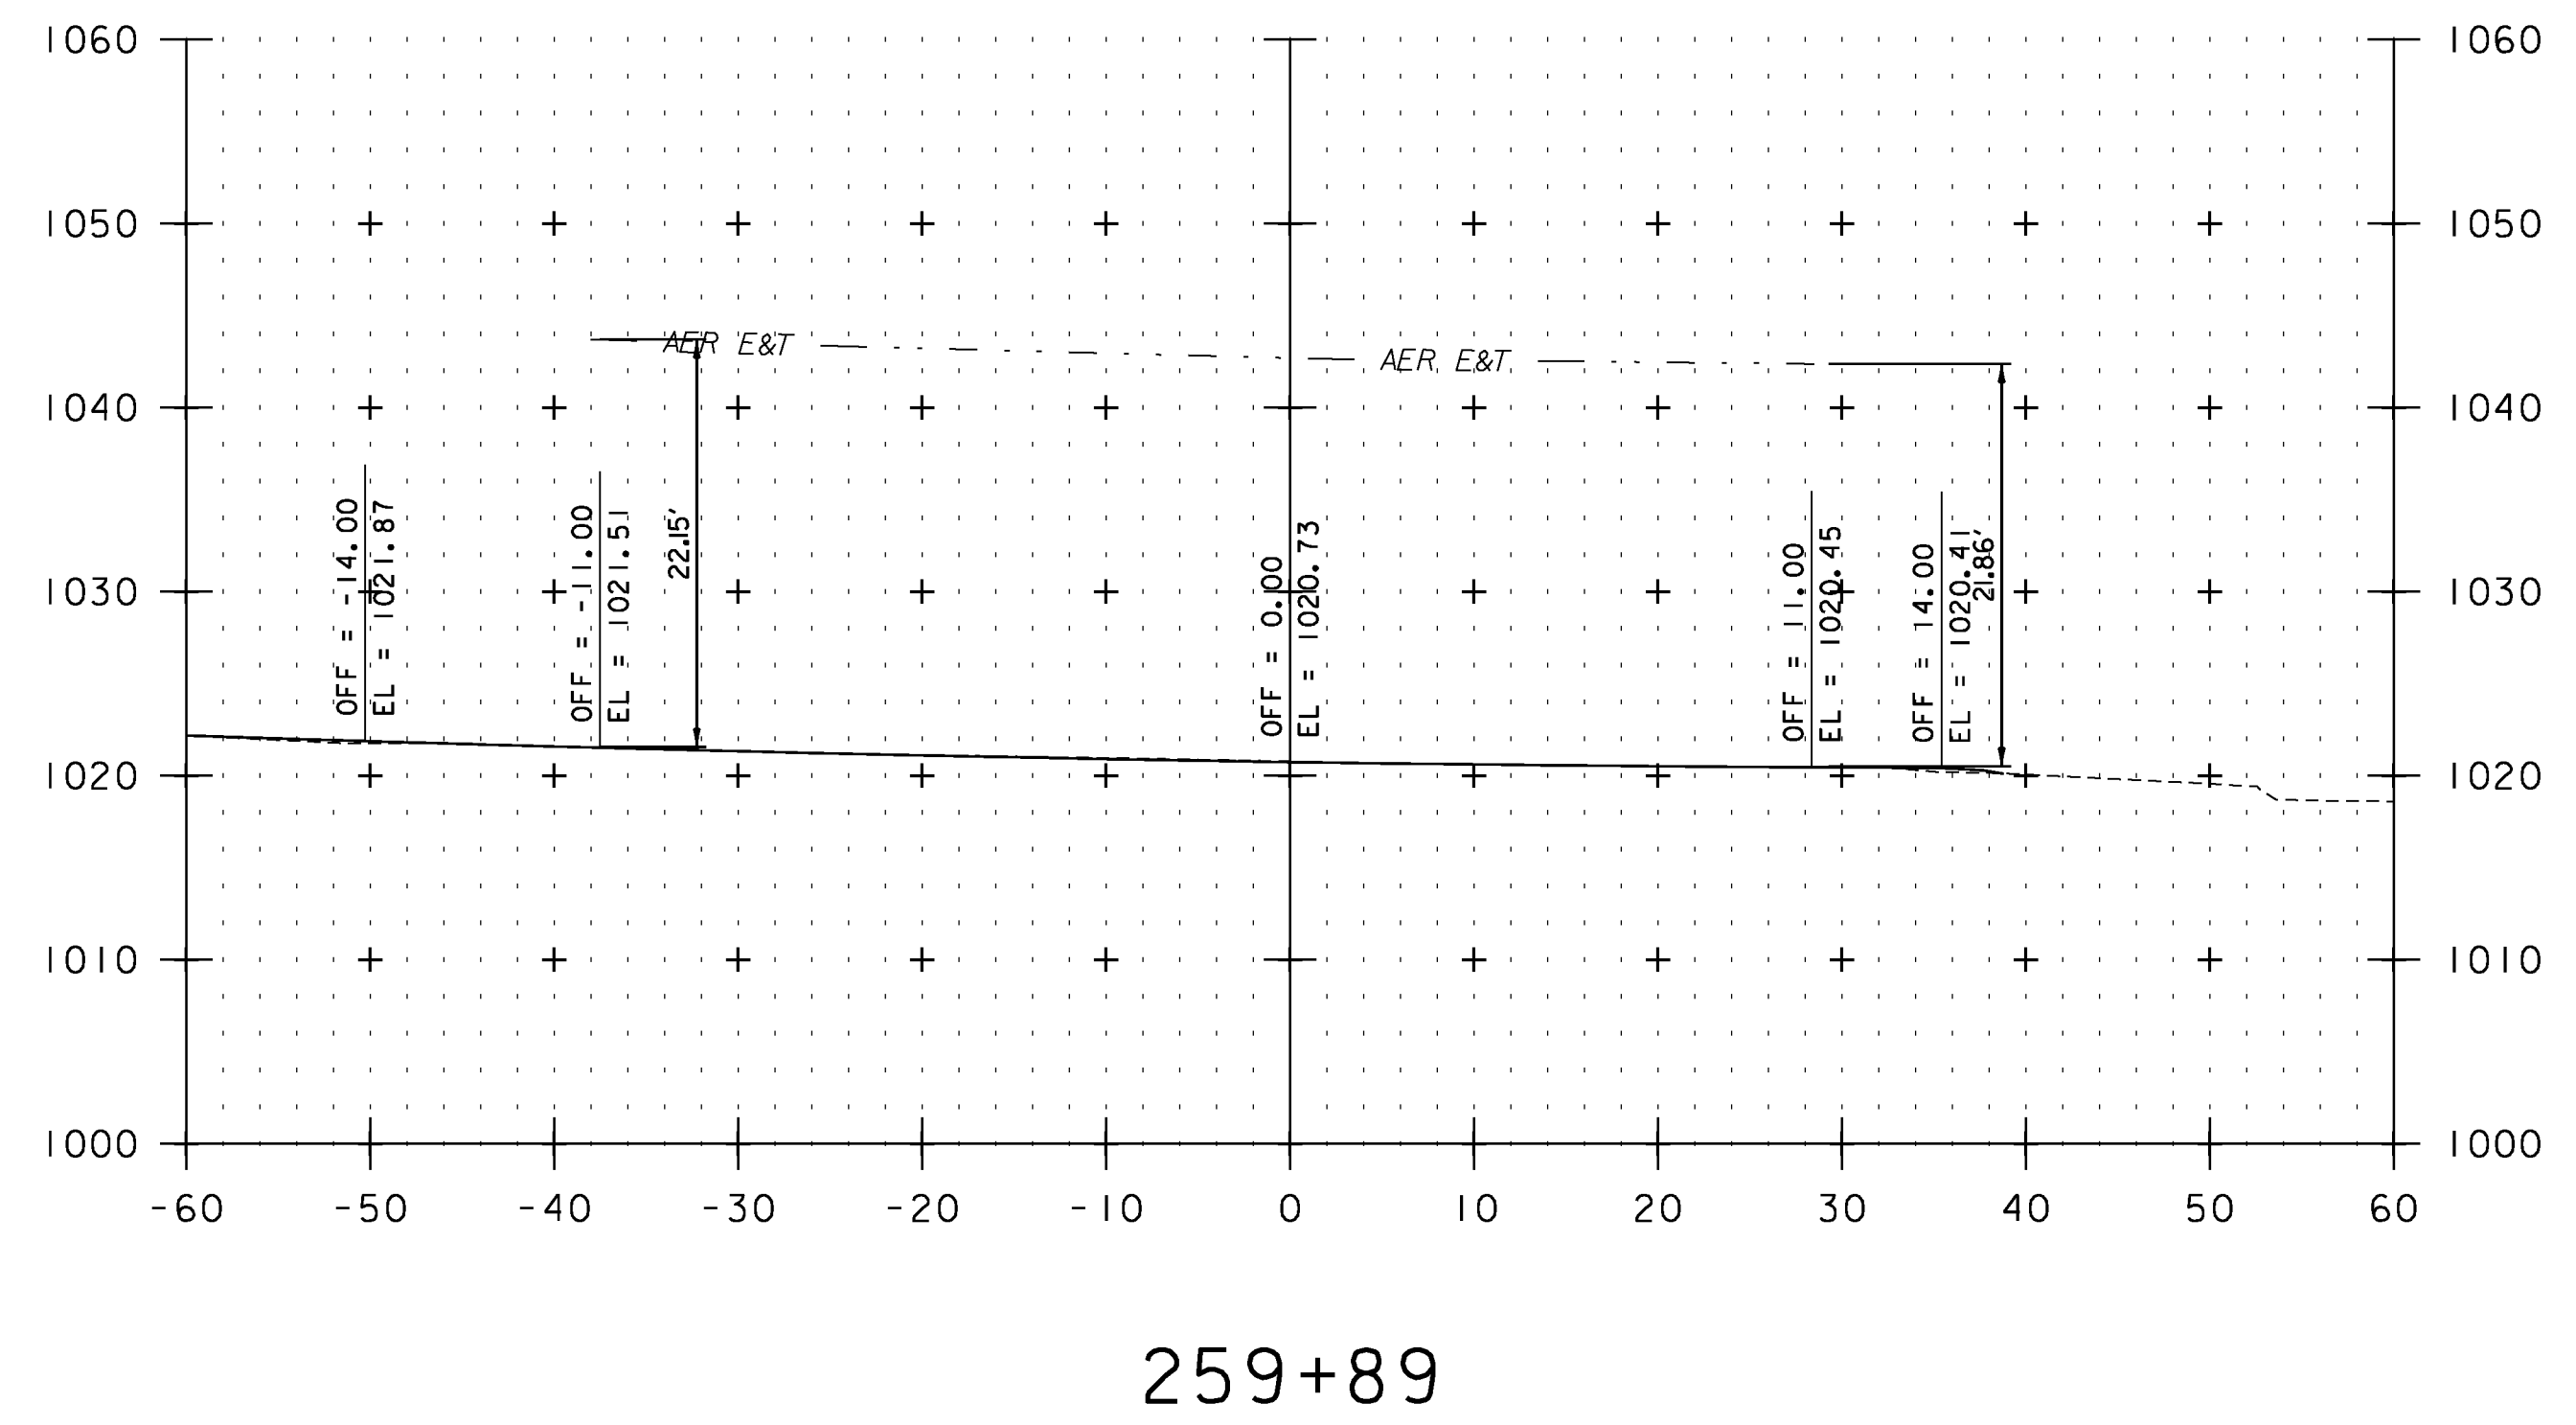

259+89

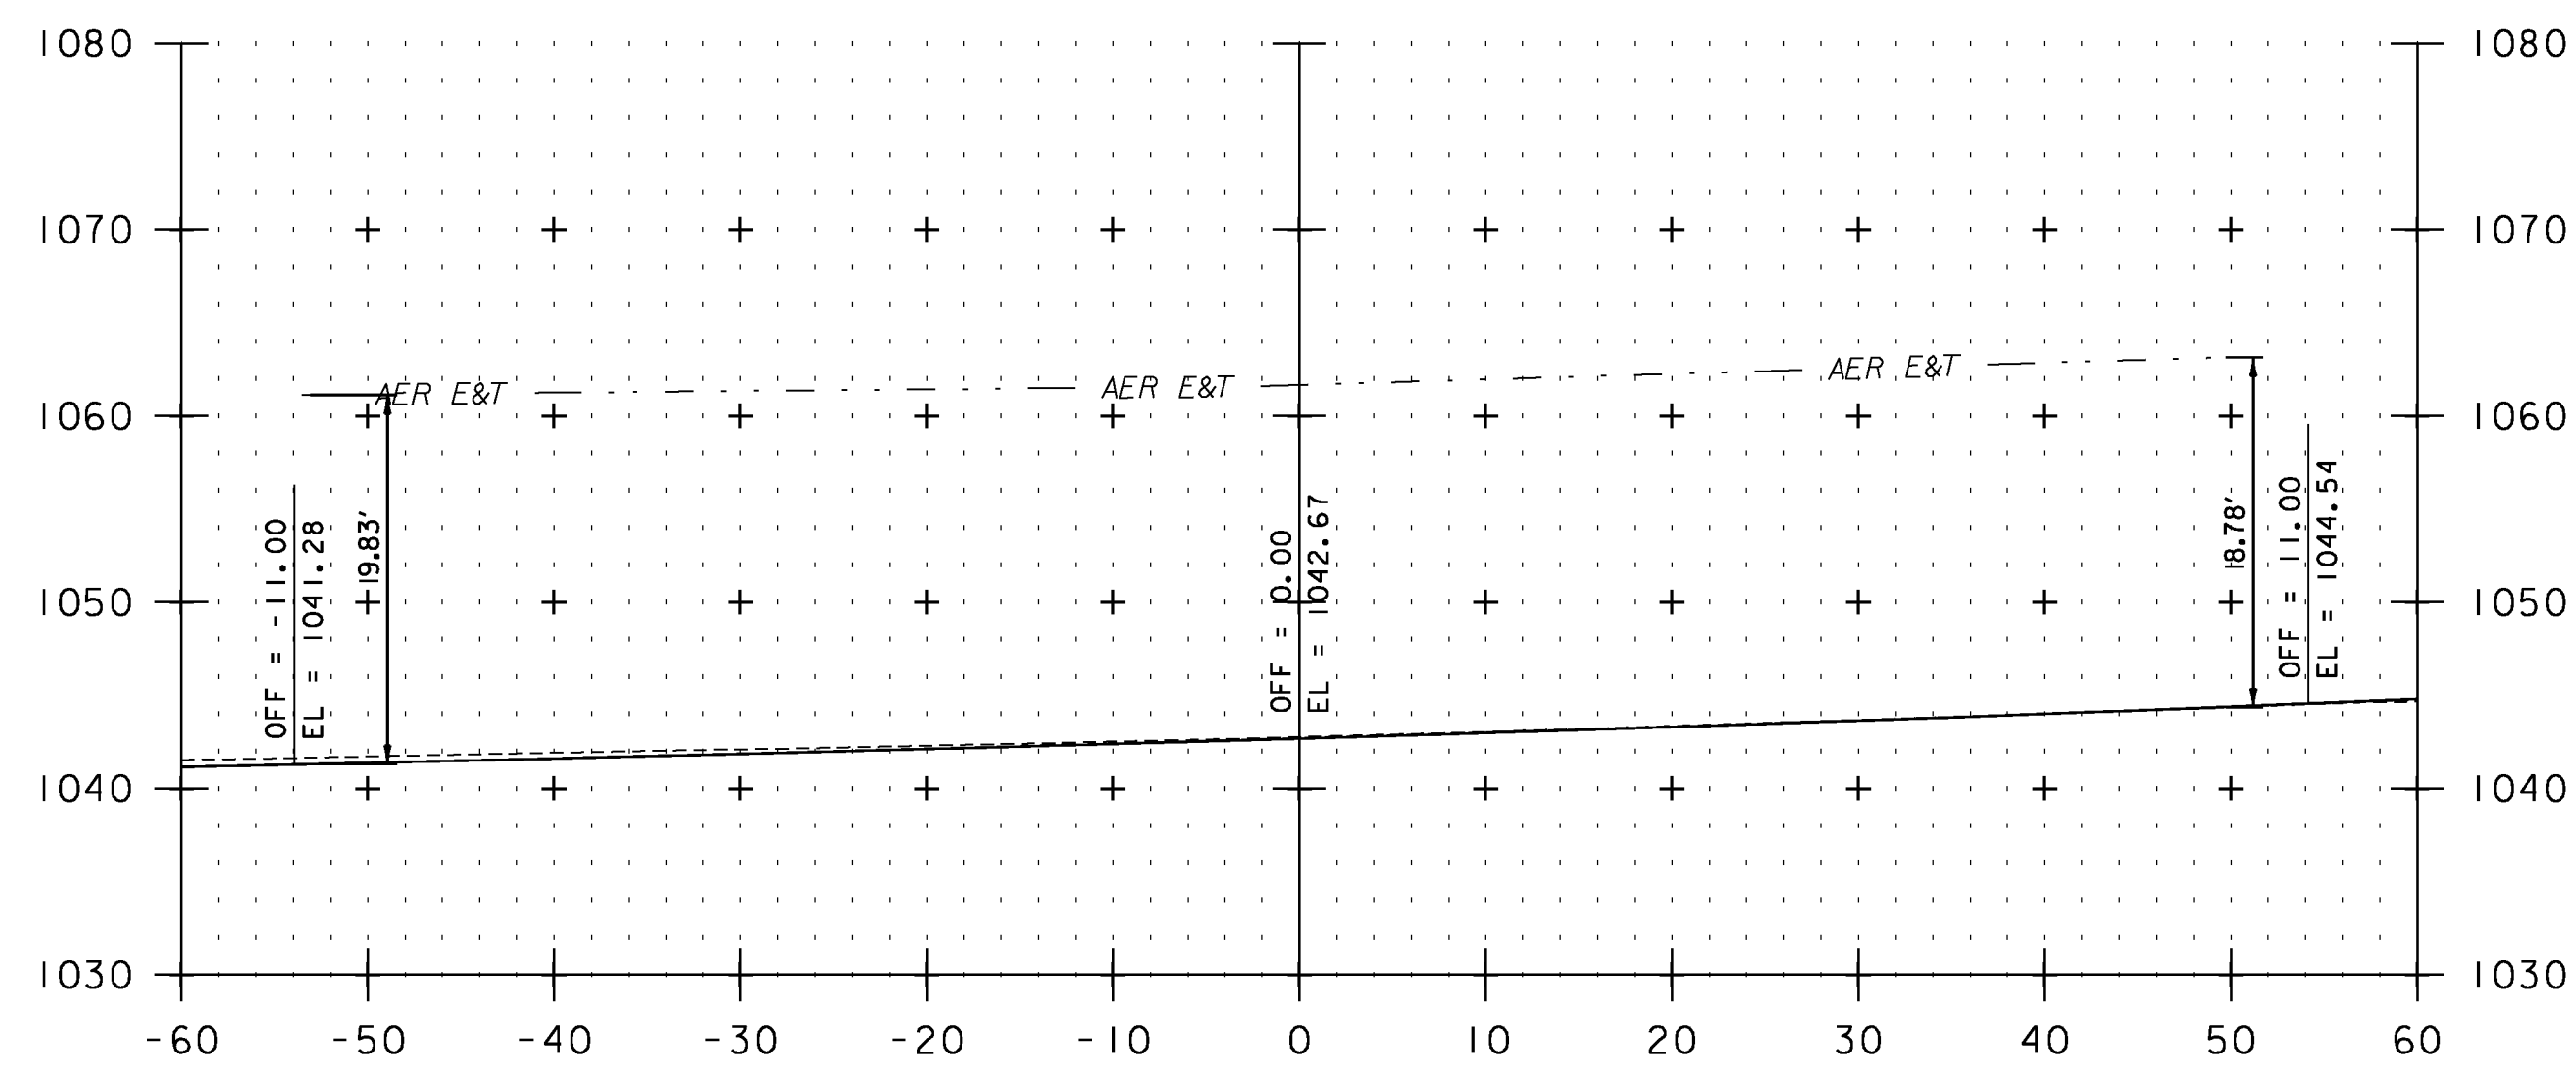


249+97

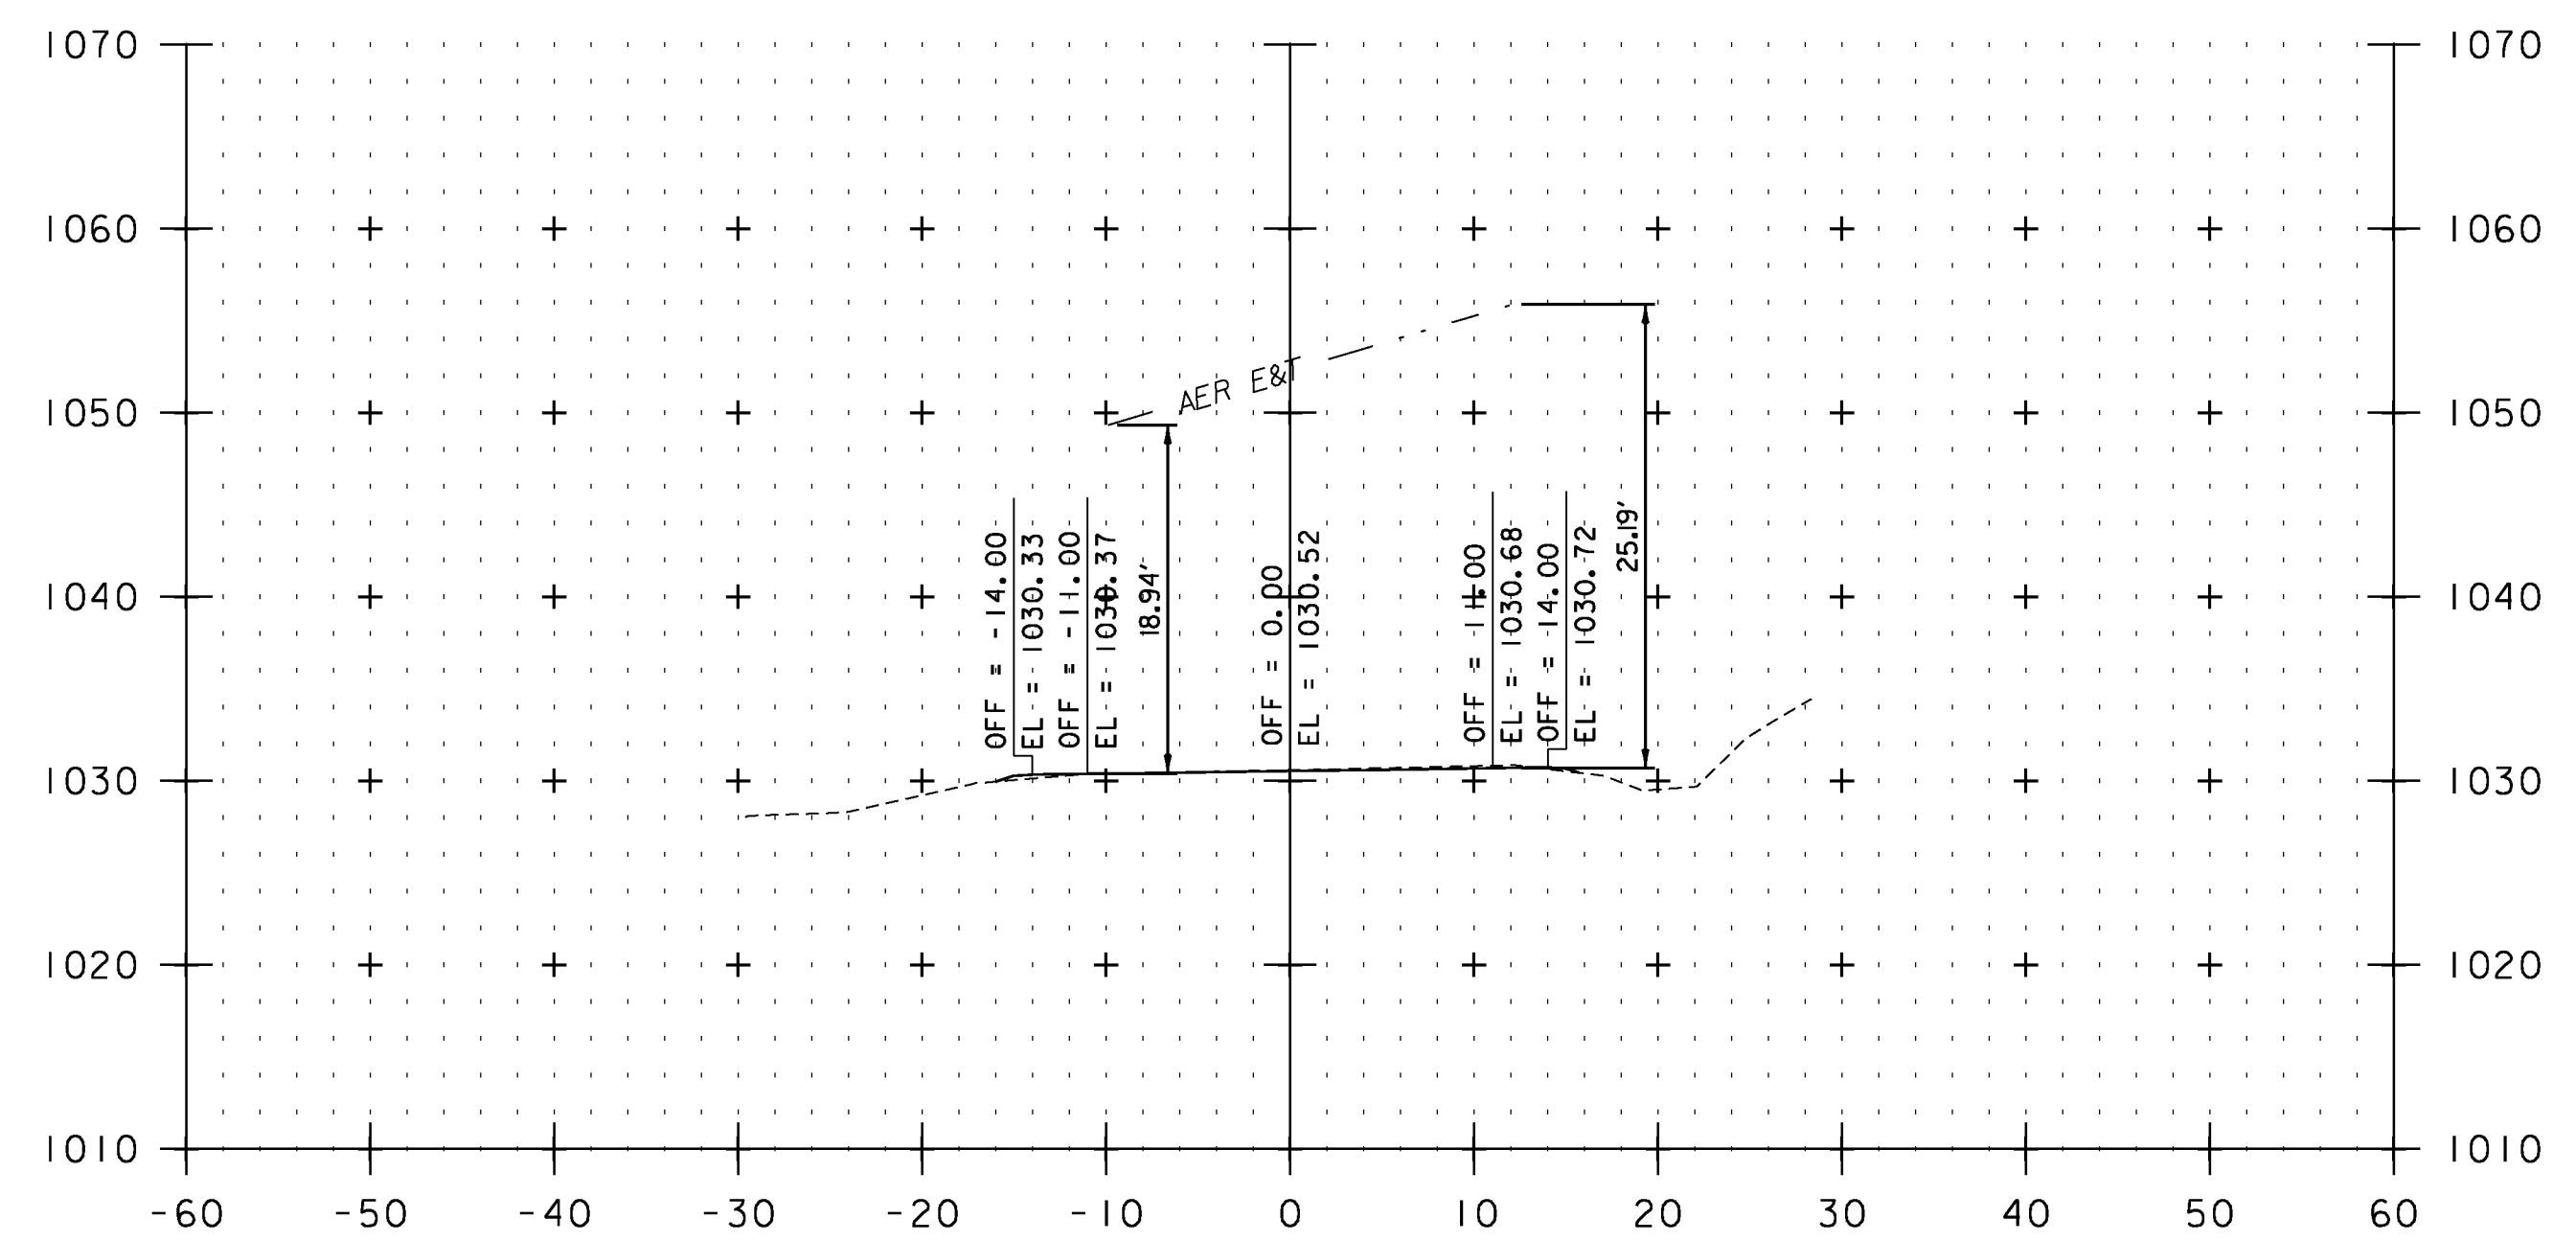

257+71

STA. 249+97 TO STA. 259+89

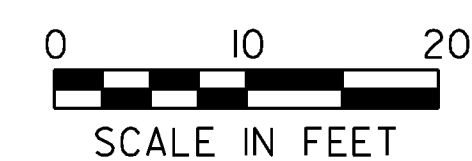

UTILITY CROSS SECTION SHEET 5

PROJECT NAME: VERSHIRE-THETFORD	PLOT DATE: 1/29/2013
PROJECT NUMBER: STP 291(I)	DRAWN BY: JLS
FILE NAME: pl0c224.dgn	CHECKED BY: PTS
PROJECT LEADER: PTS	SHEET 209 OF 232
DESIGNED BY: NLL	
IPARM FILE NAME: IOC224_209	