




262+36

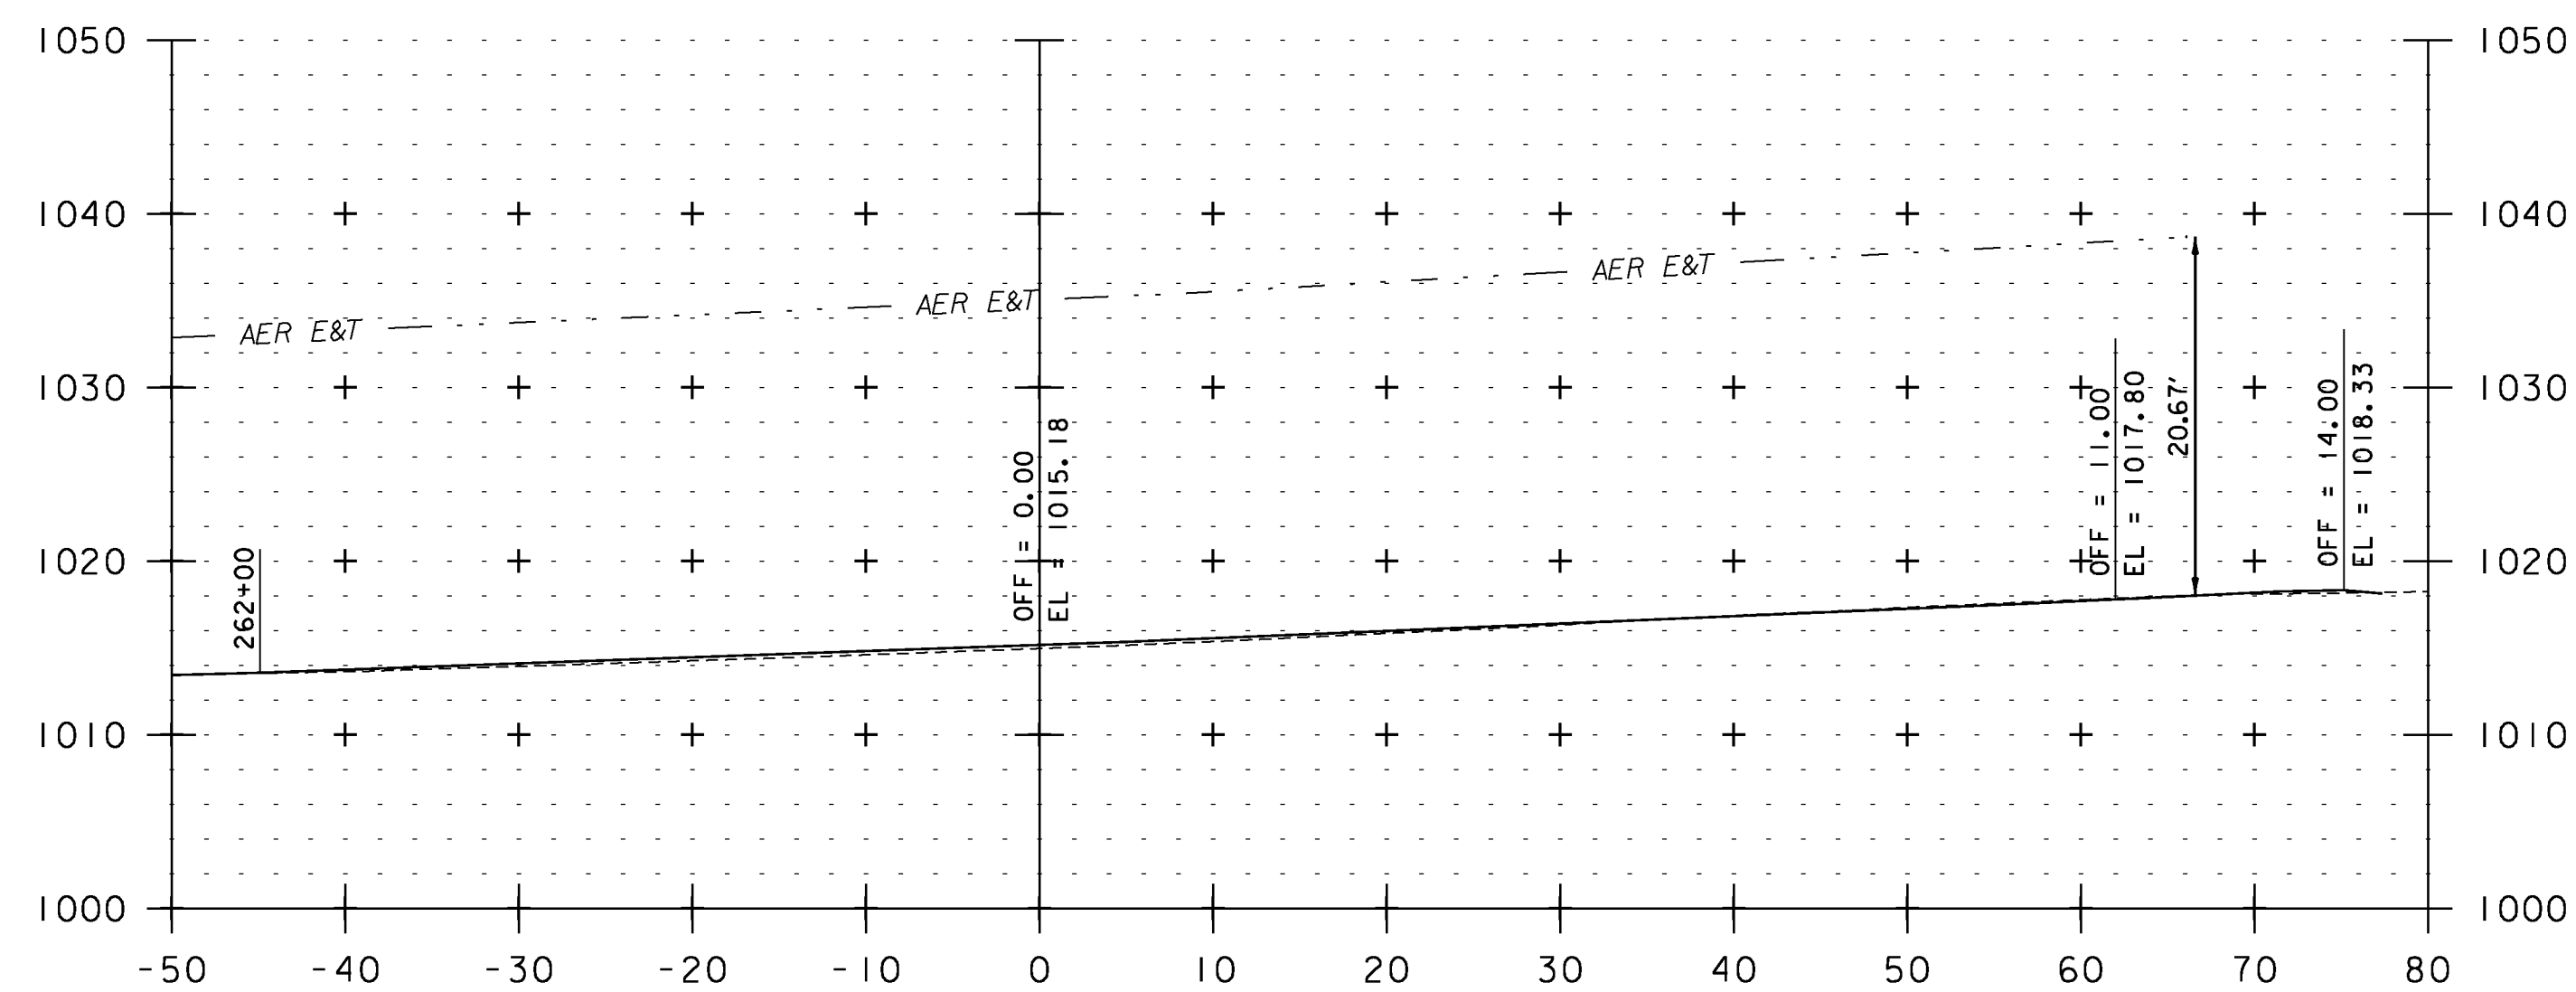

261+55

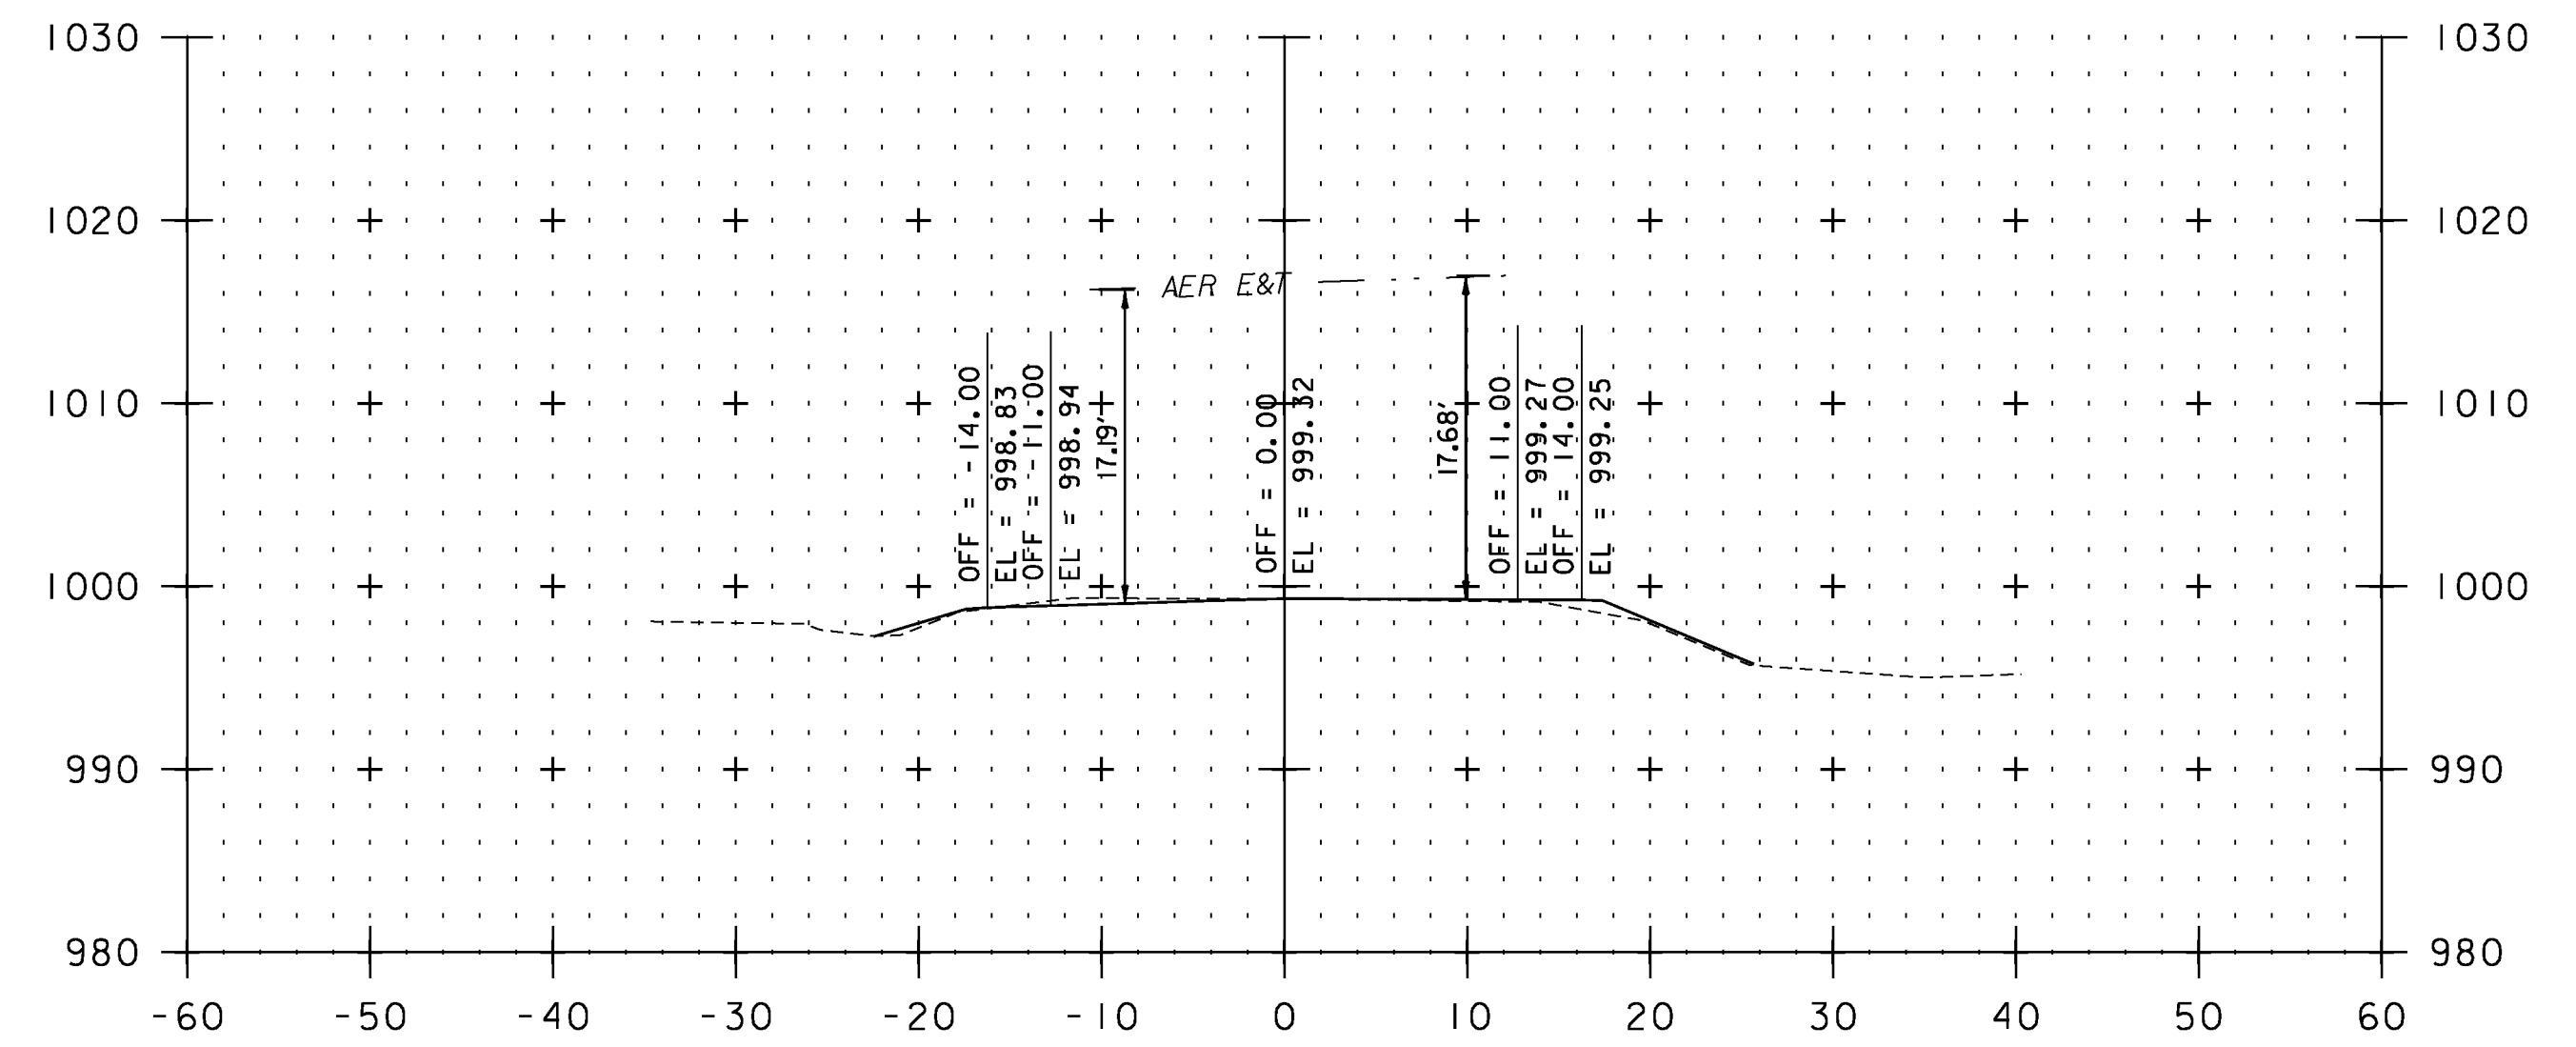


267+13

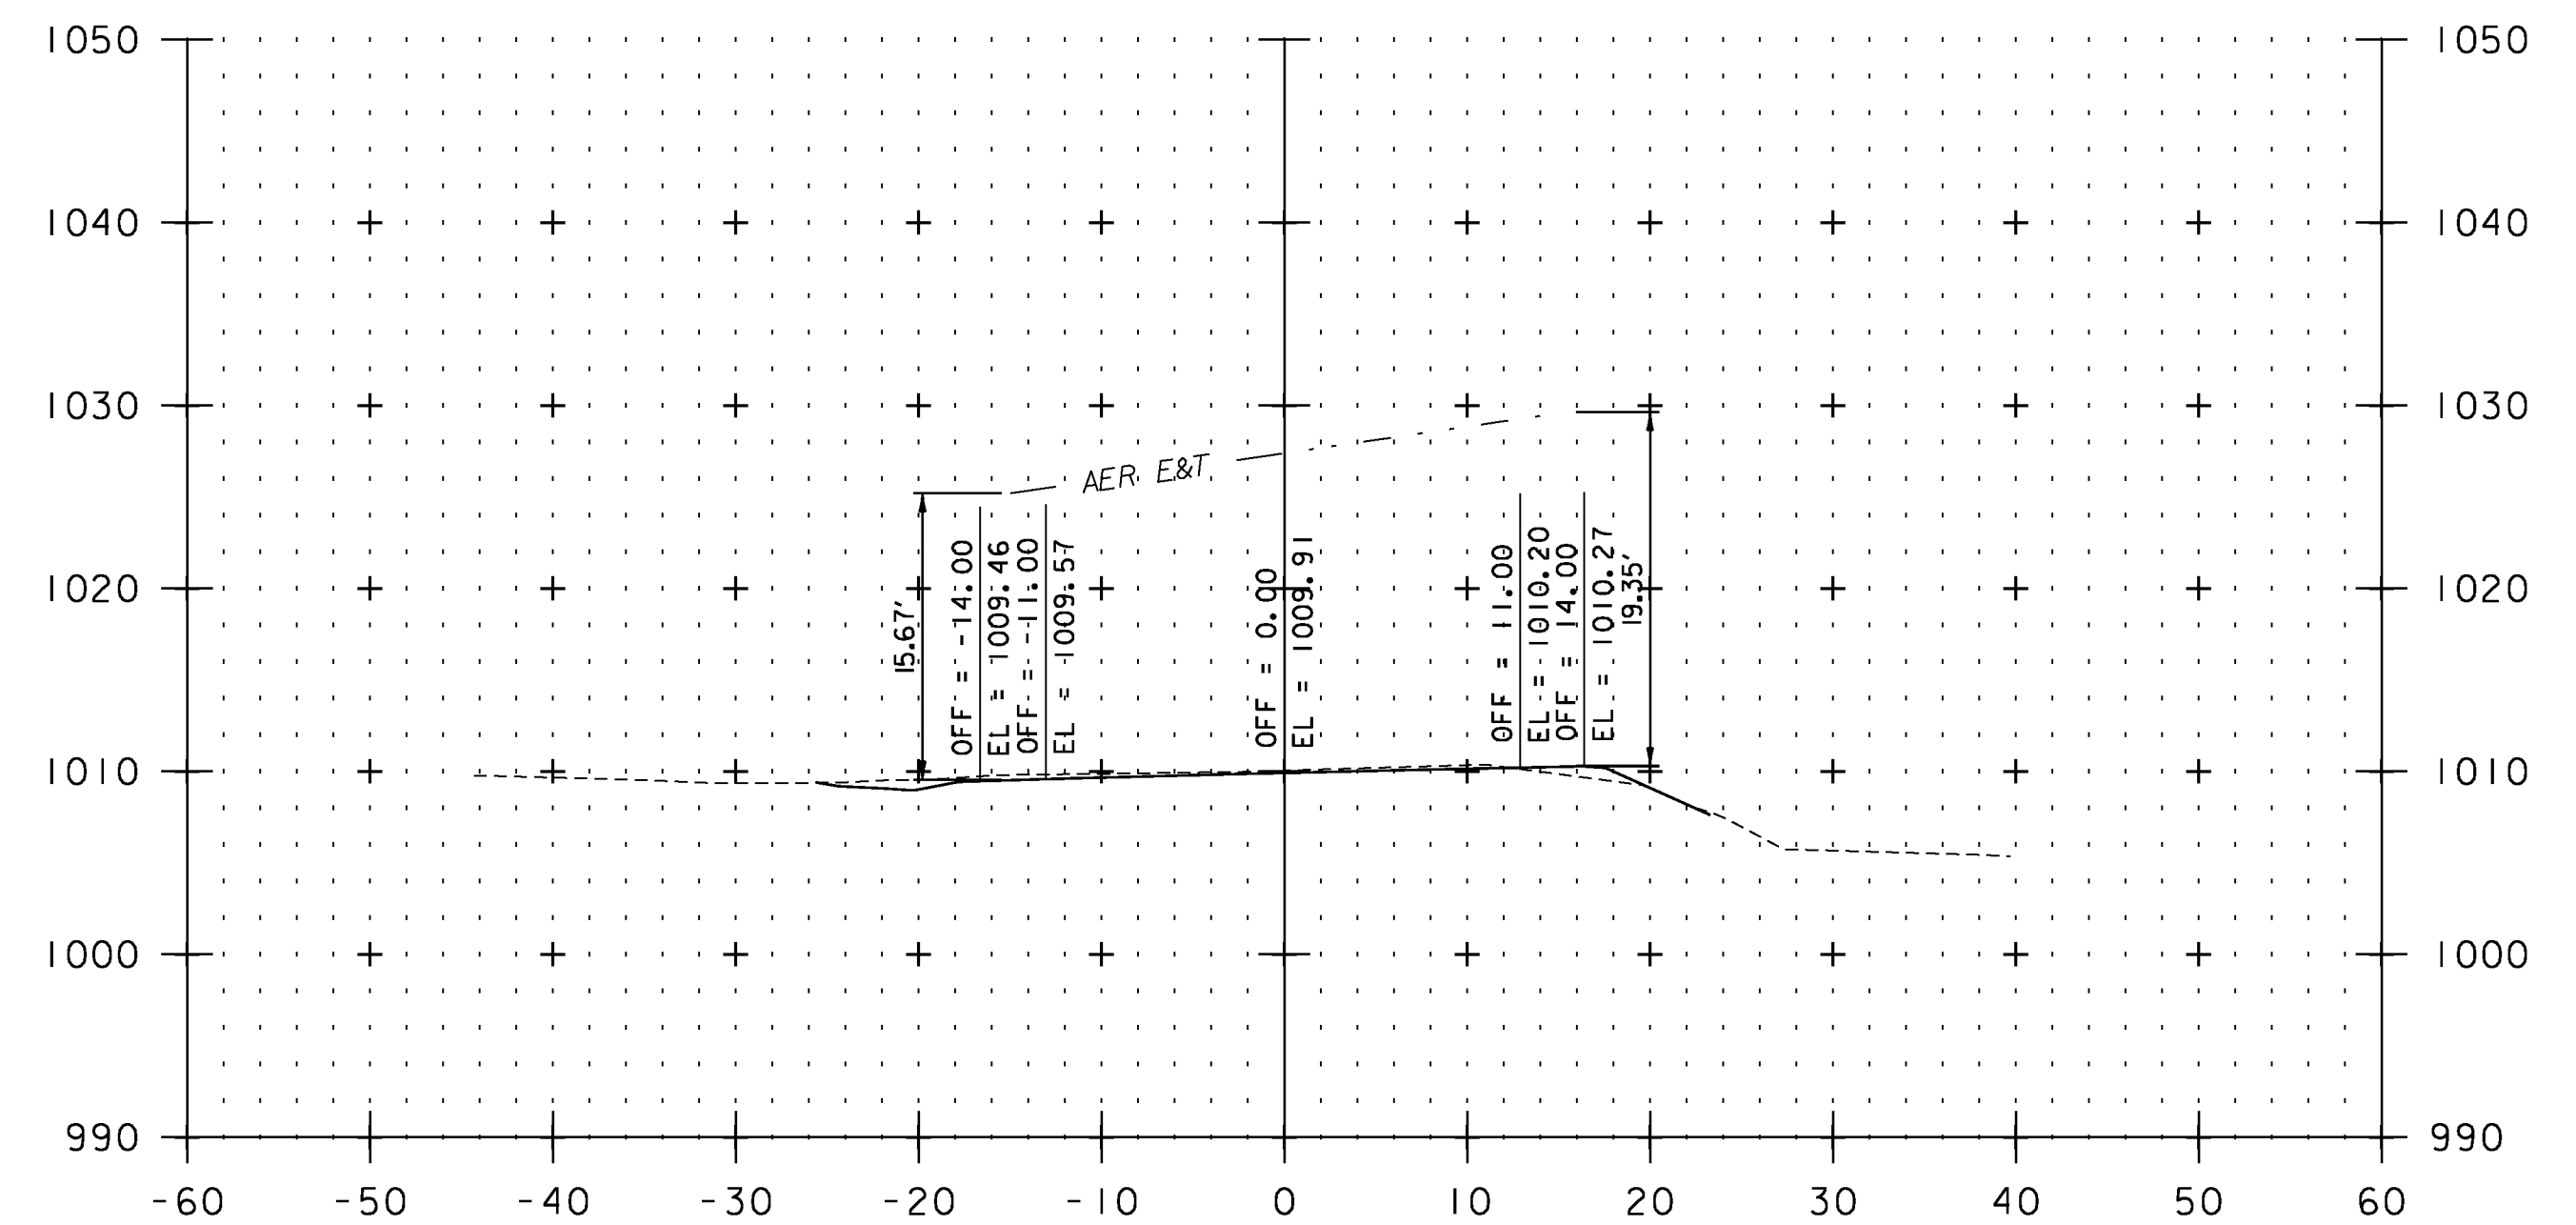

263+16

STA. 261+55 TO STA. 267+13

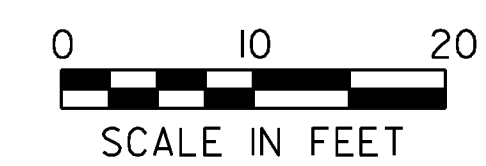

UTILITY CROSS SECTION SHEET 6

PROJECT NAME: VERSHIRE-THETFORD

PROJECT NUMBER: STP 2911(I)

FILE NAME: pl0c224.dgn

PLOT DATE: 1/29/2013

PROJECT LEADER: PTS

DRAWN BY: JLS

DESIGNED BY: NLL

CHECKED BY: PTS

IPARM FILE NAME: IOC224_210

SHEET 210 OF 232