




280+50

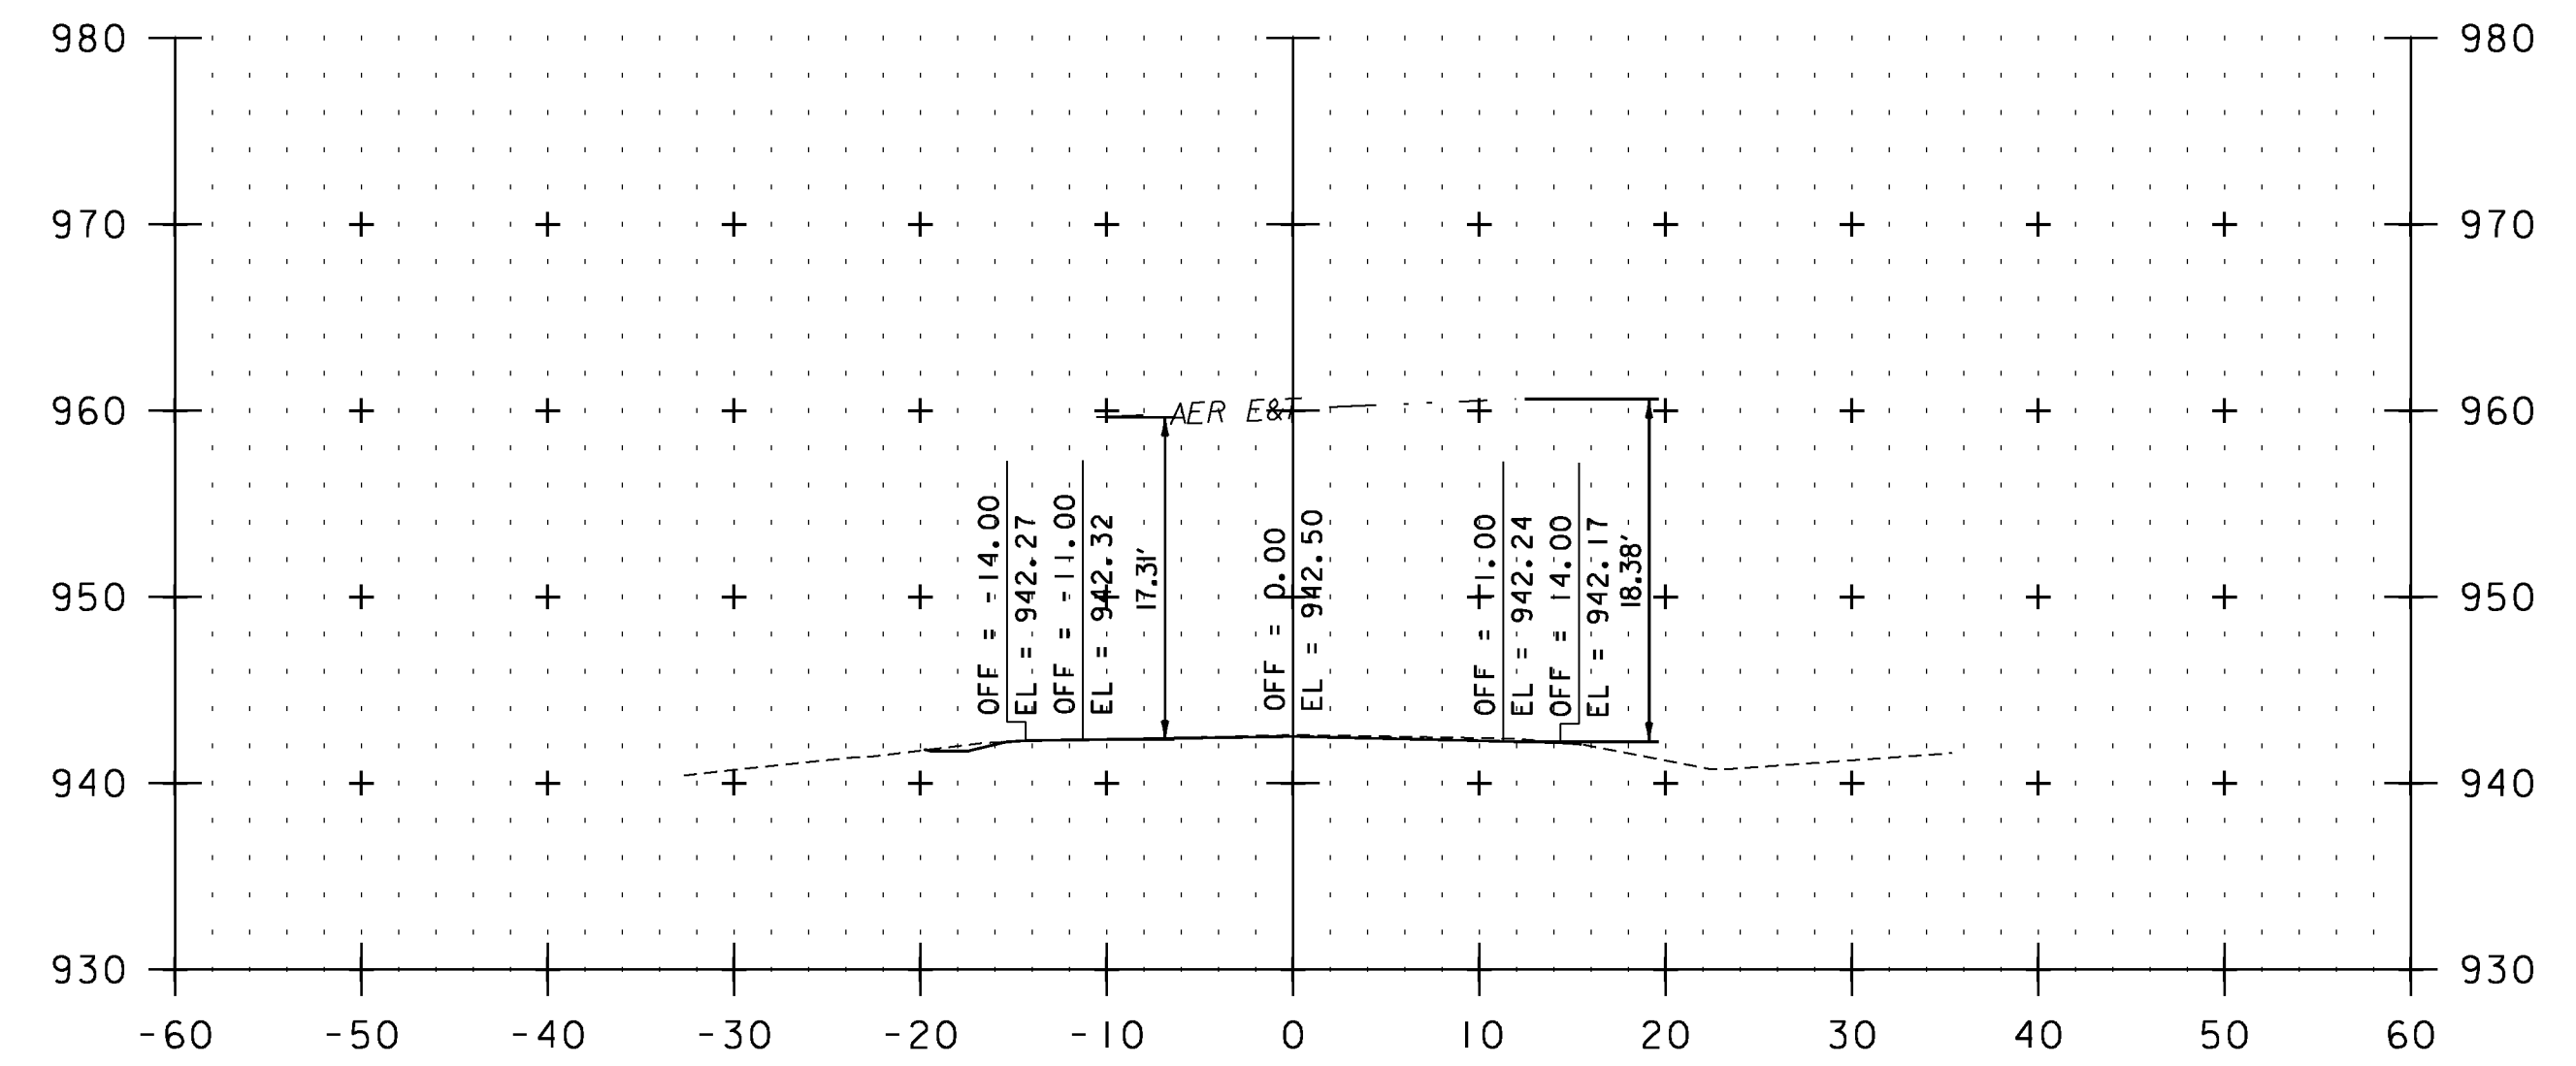

291+88

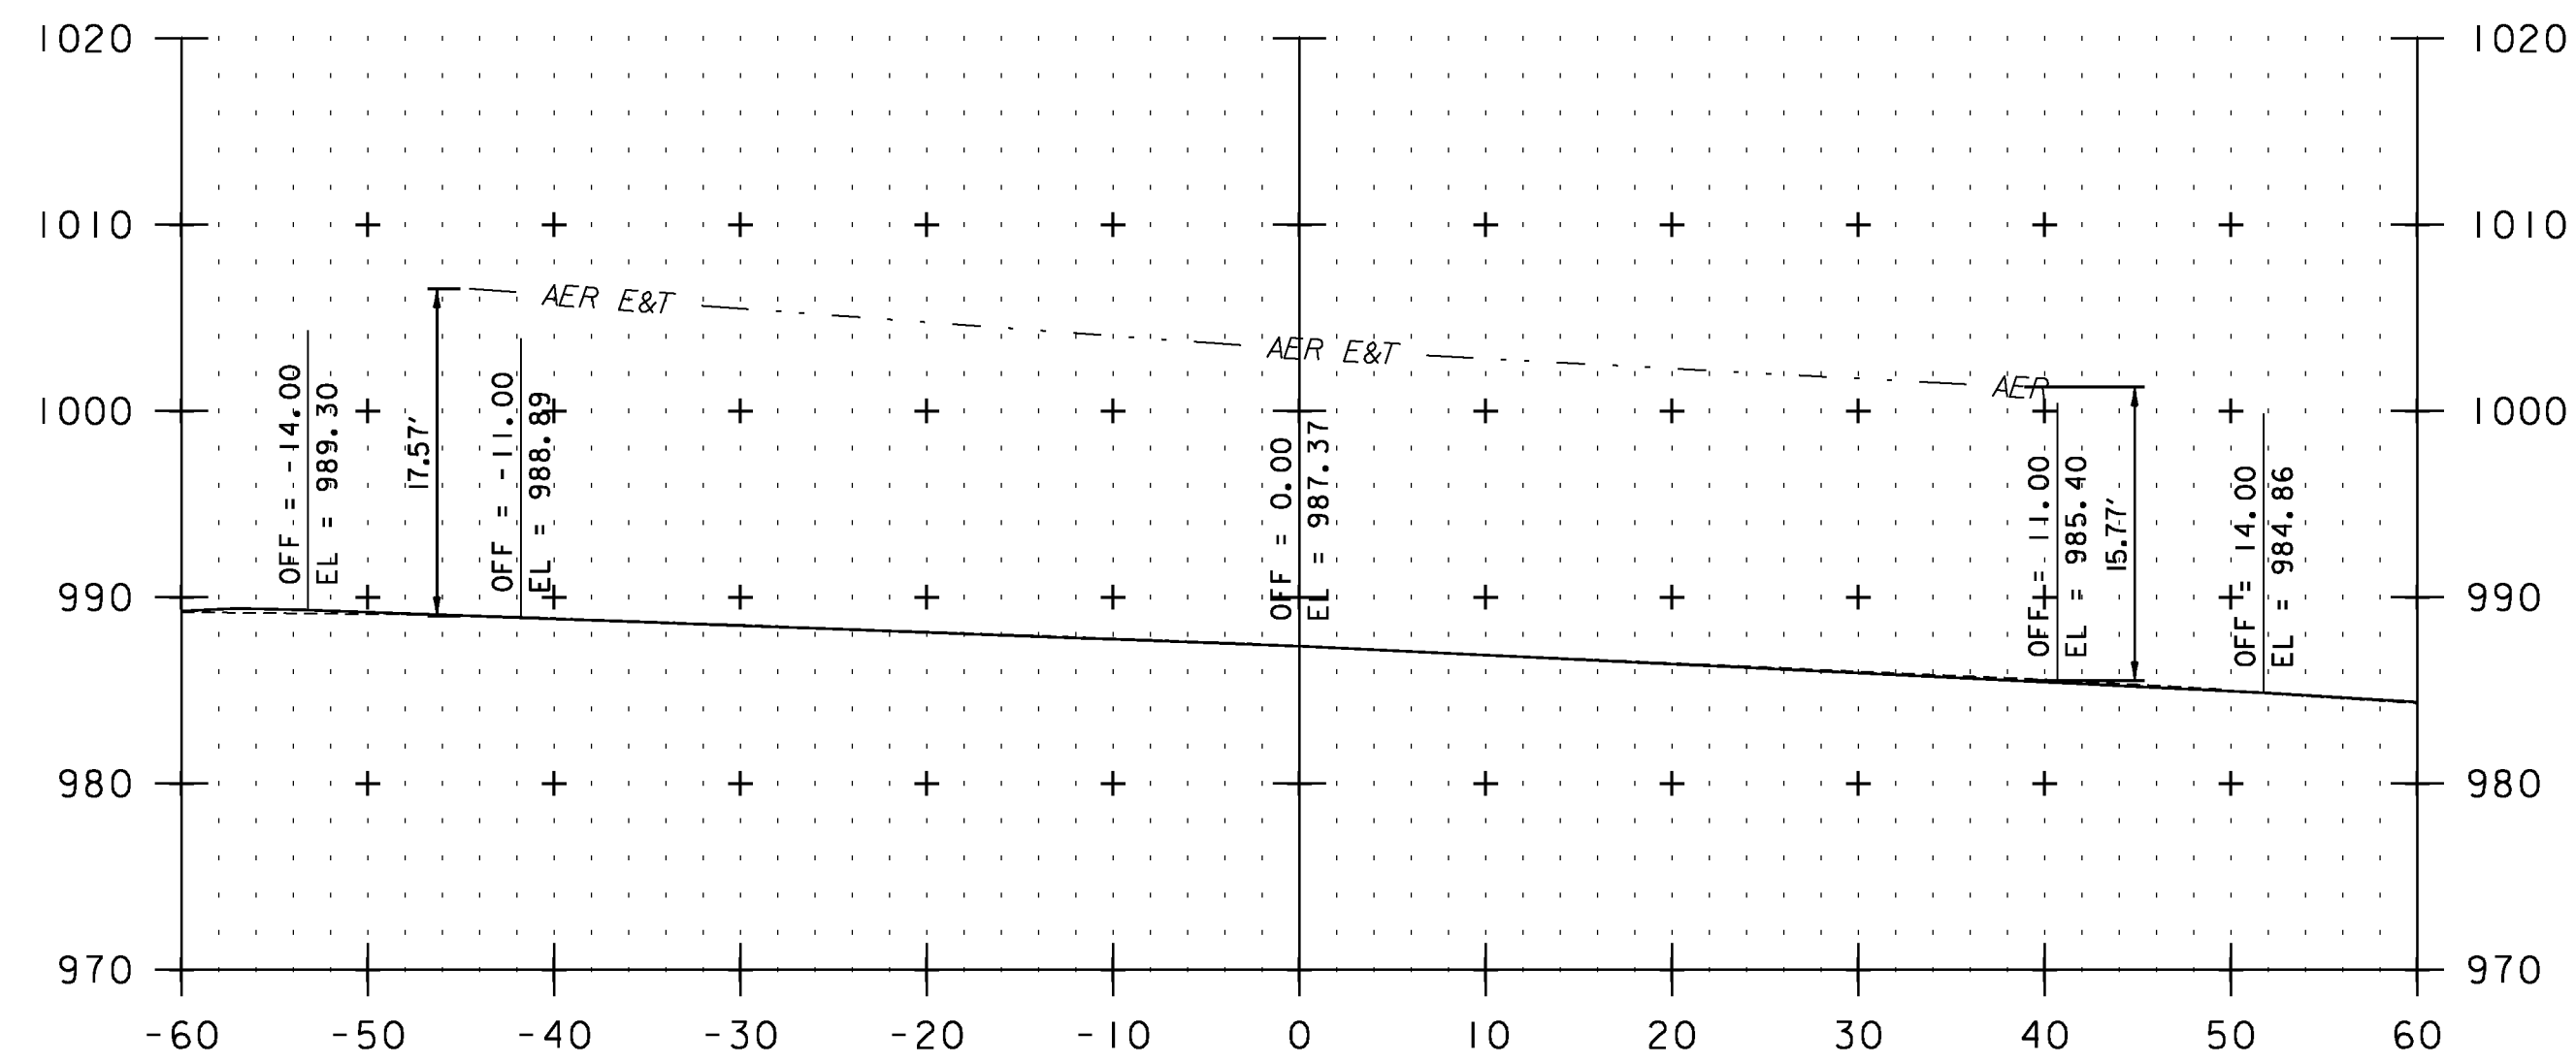


279+10

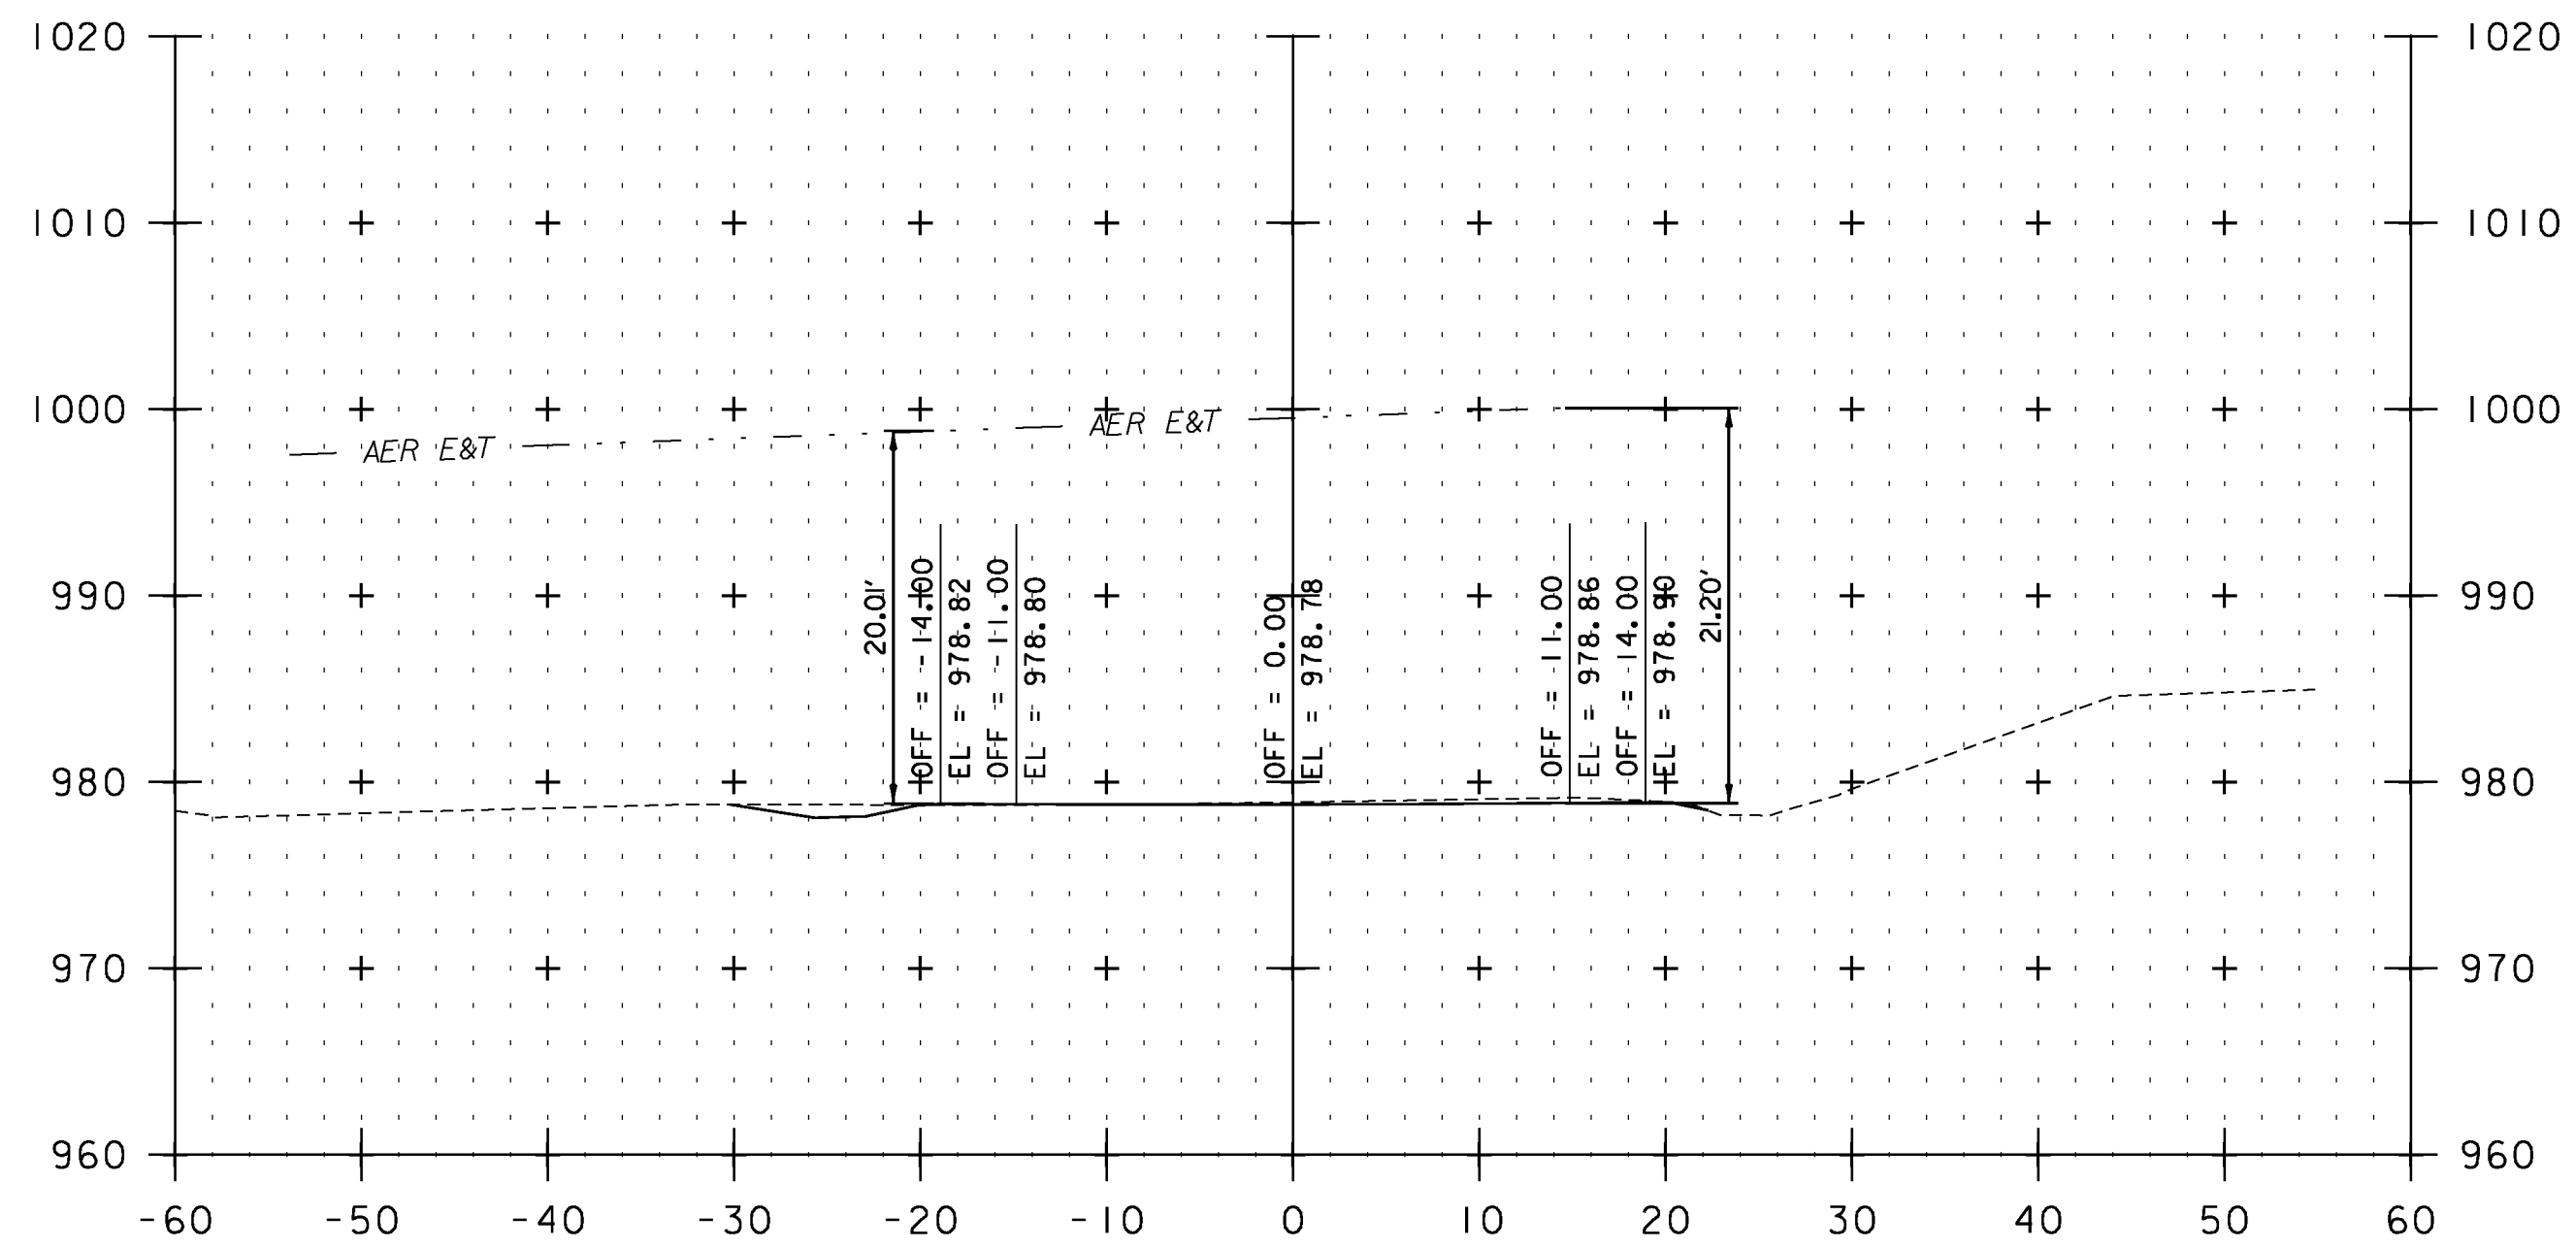

280+94

STA. 279+10 TO STA. 291+88

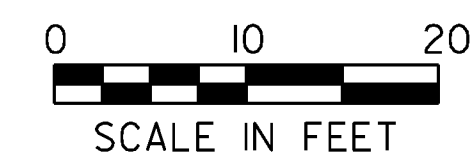

UTILITY CROSS SECTION SHEET 7

PROJECT NAME: VERSHIRE-THETFORD	PLOT DATE: 1/29/2013
PROJECT NUMBER: STP 291(I)	DRAWN BY: JLS
FILE NAME: pl0c224.dgn	CHECKED BY: PTS
PROJECT LEADER: PTS	SHEET 211 OF 232
DESIGNED BY: NLL	
IPARM FILE NAME: IOC224_211	