




339+99

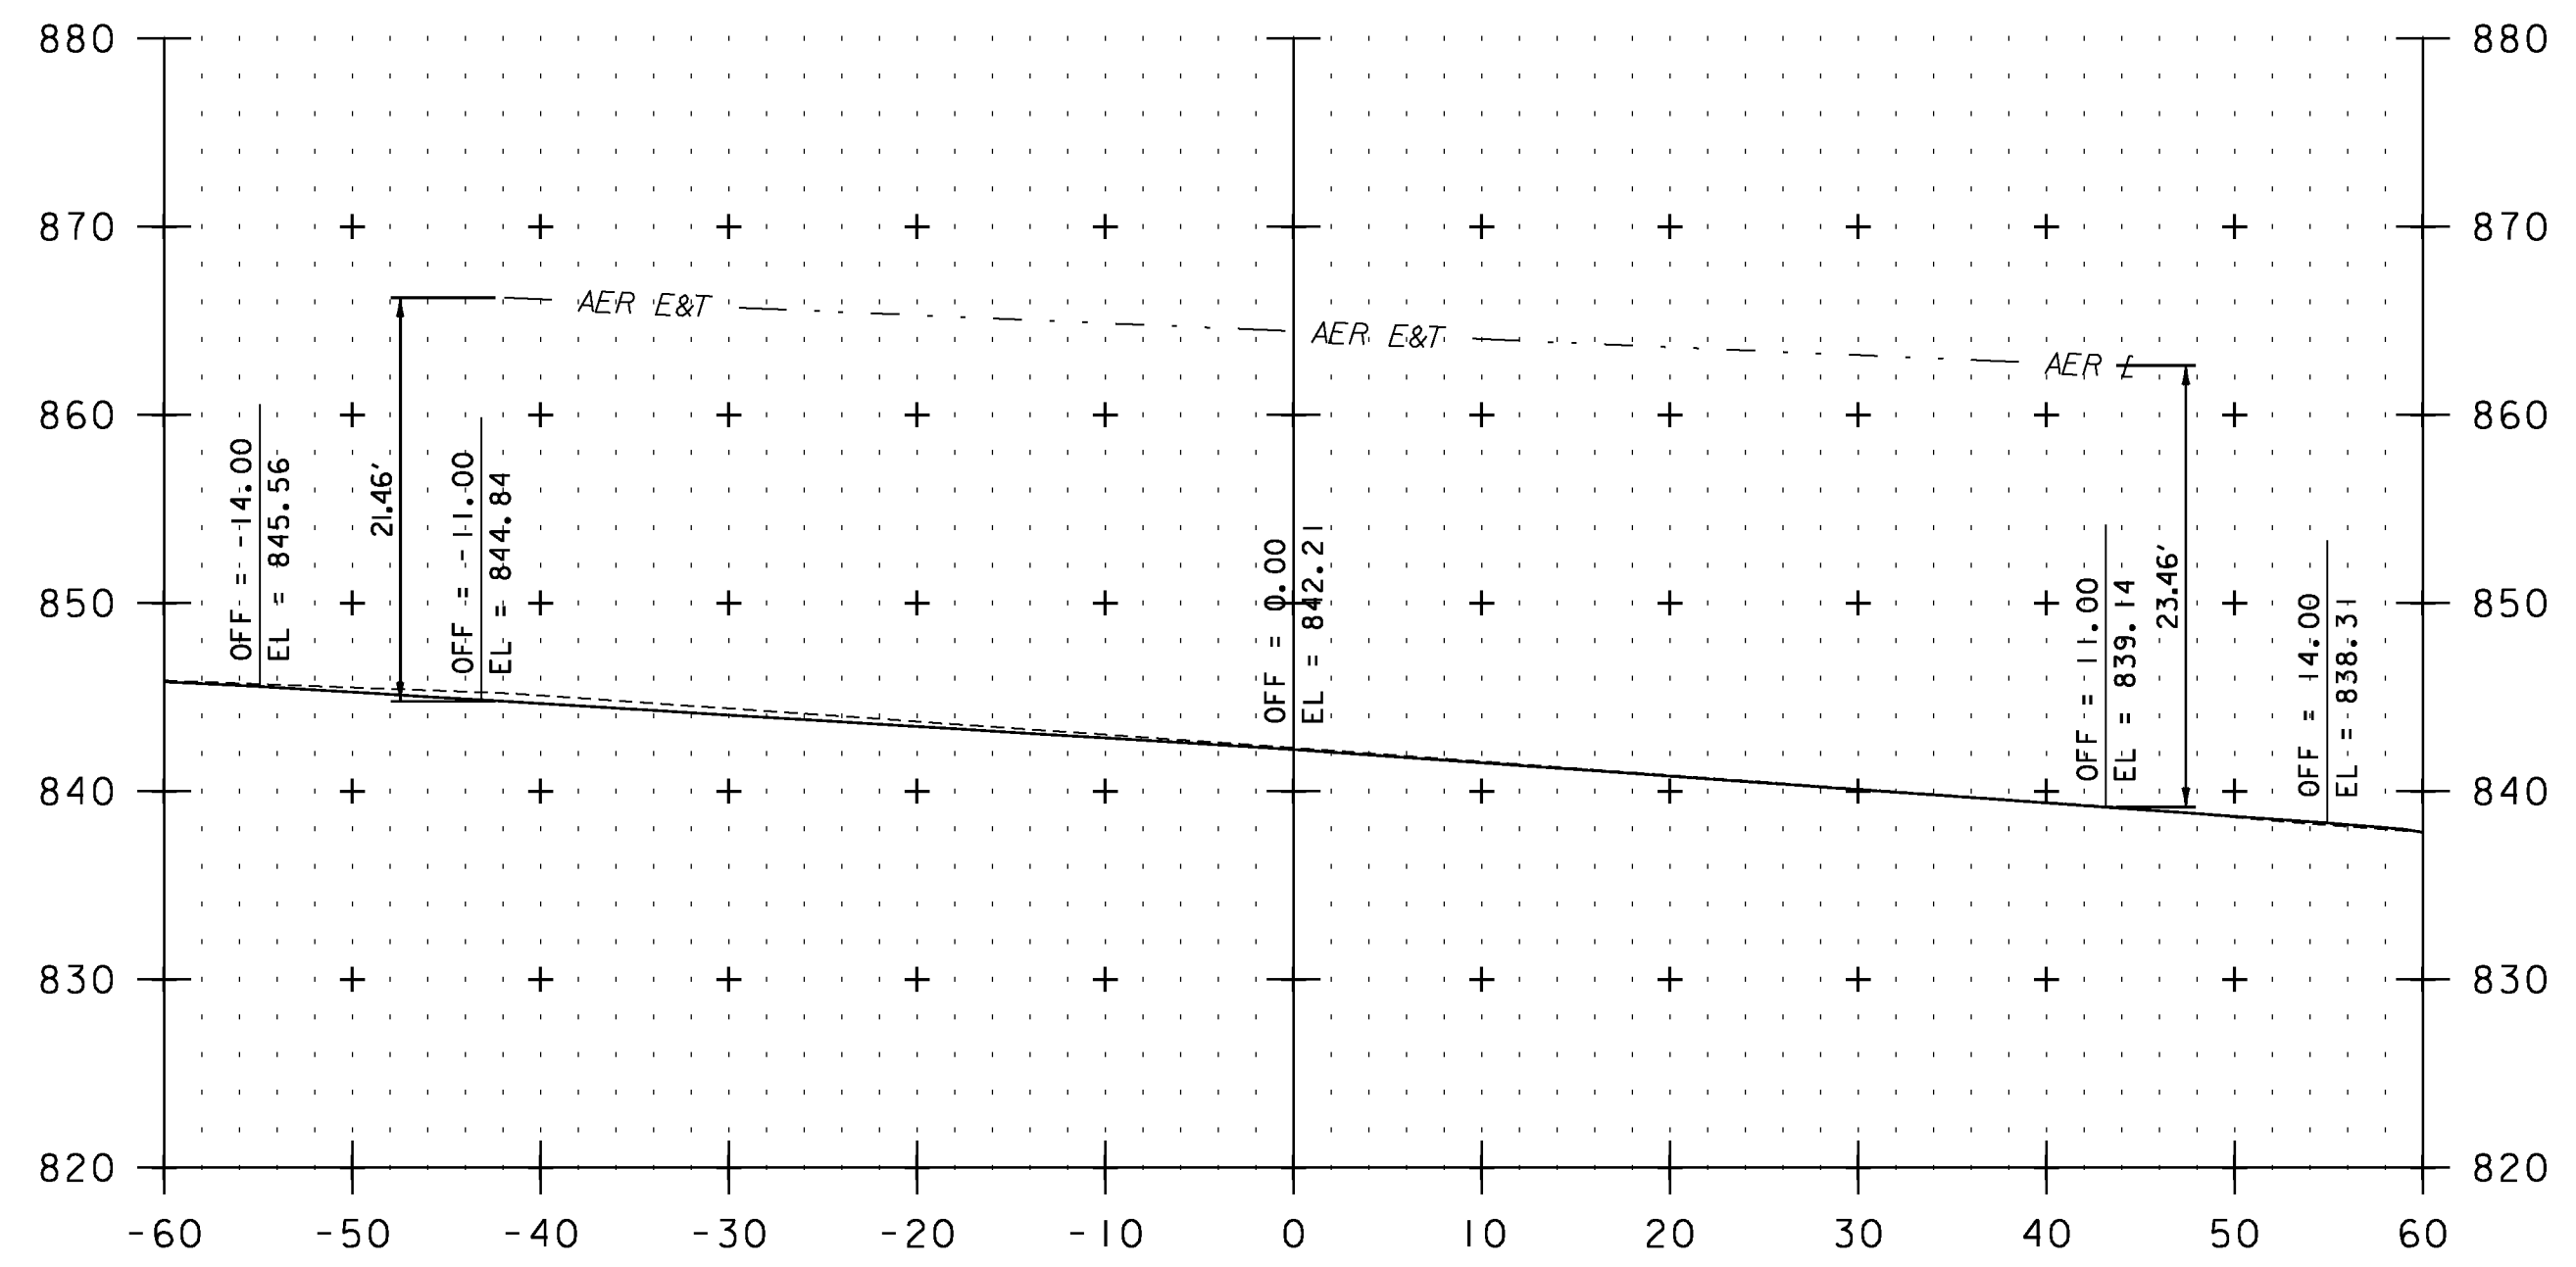

350+14

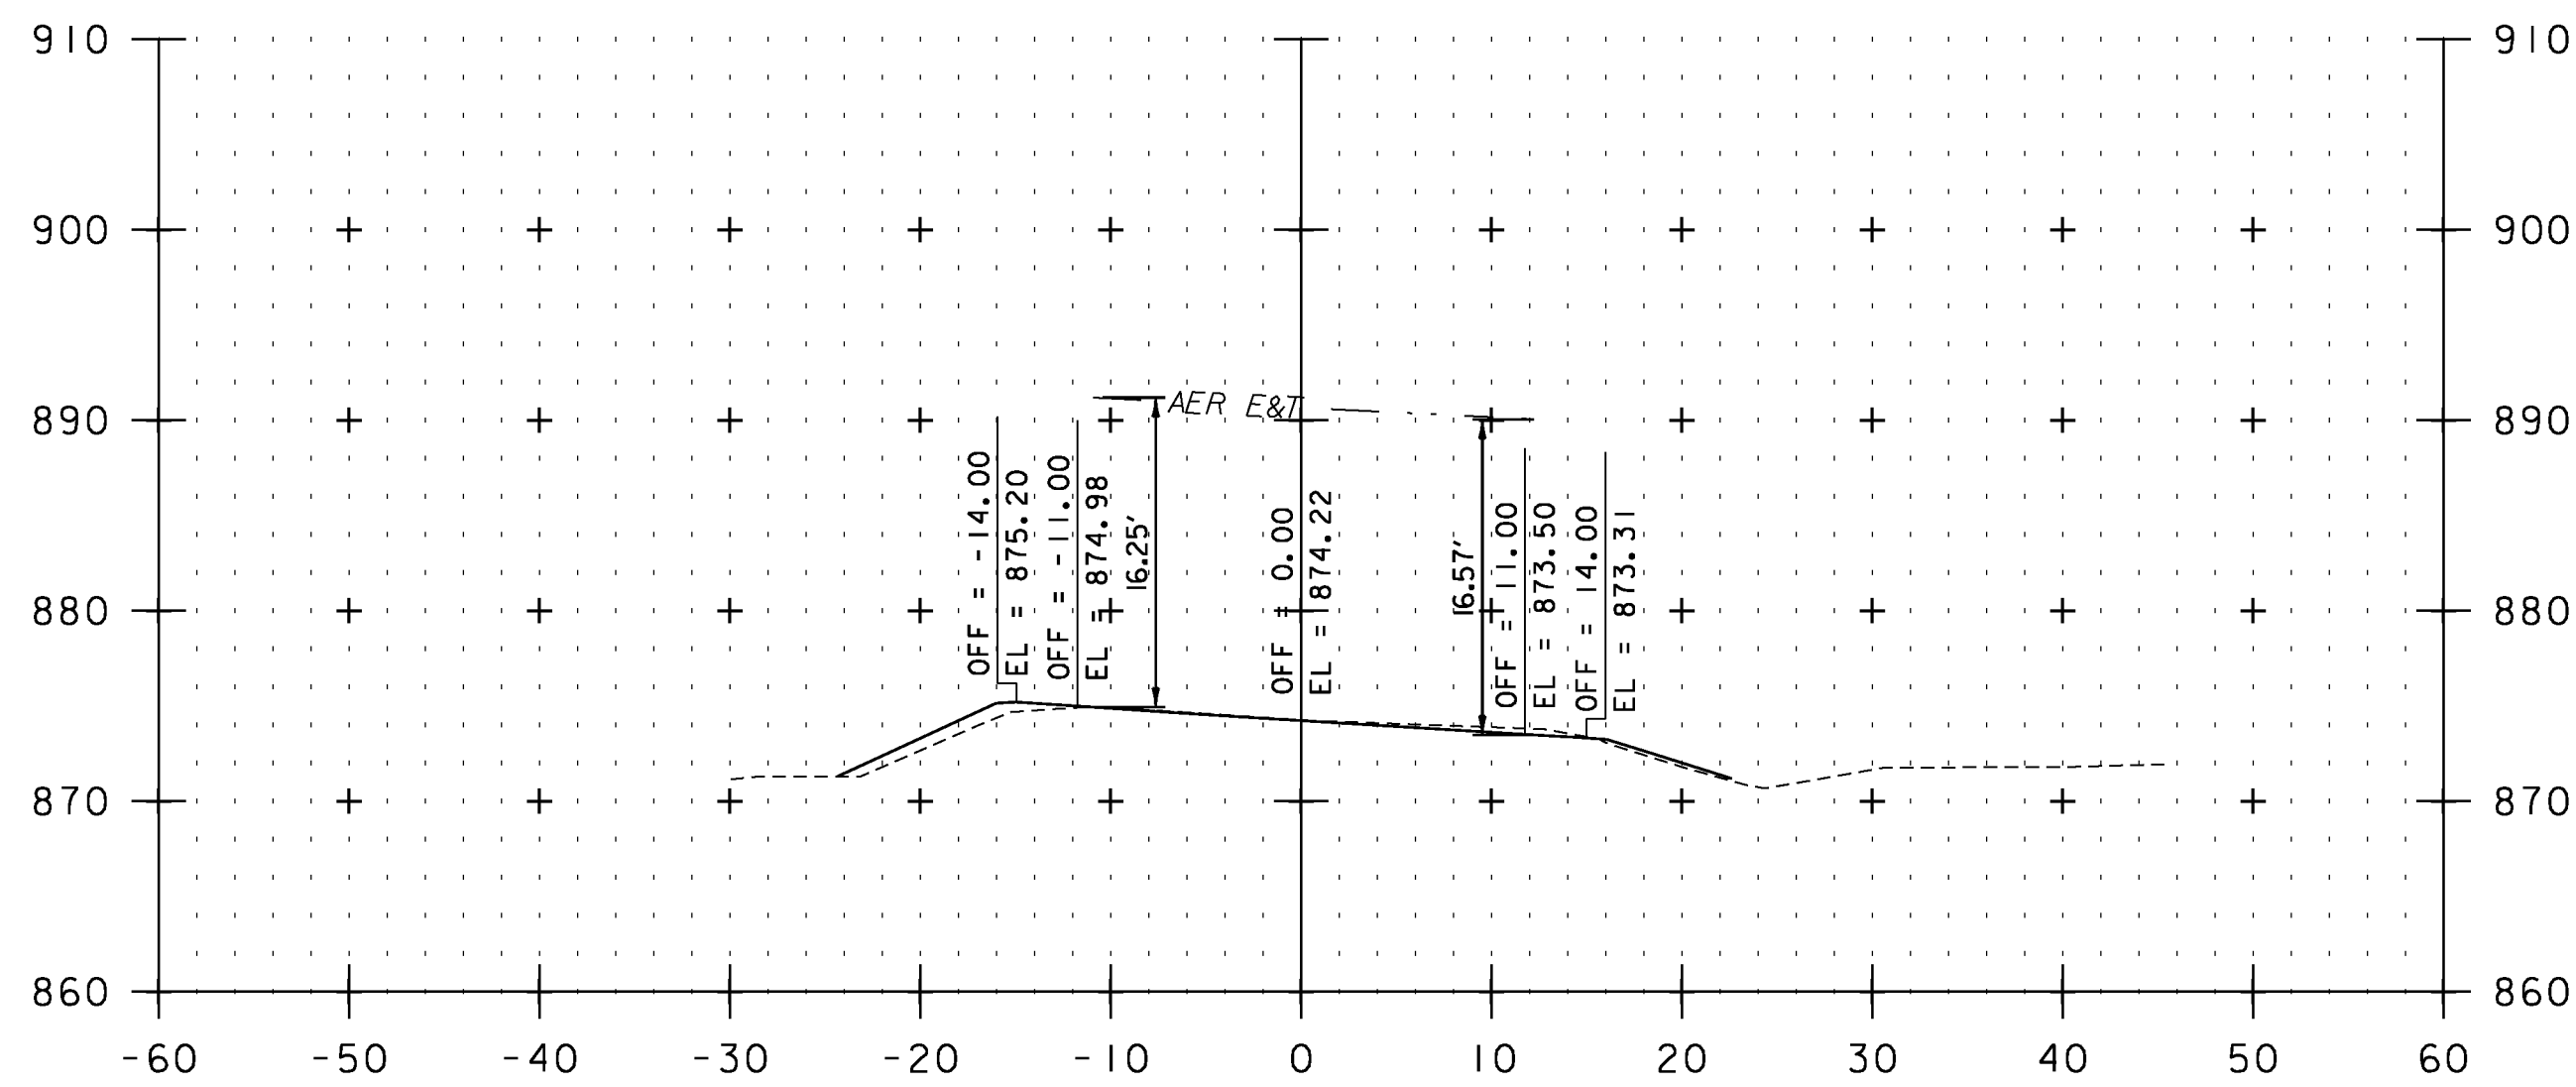


325+45

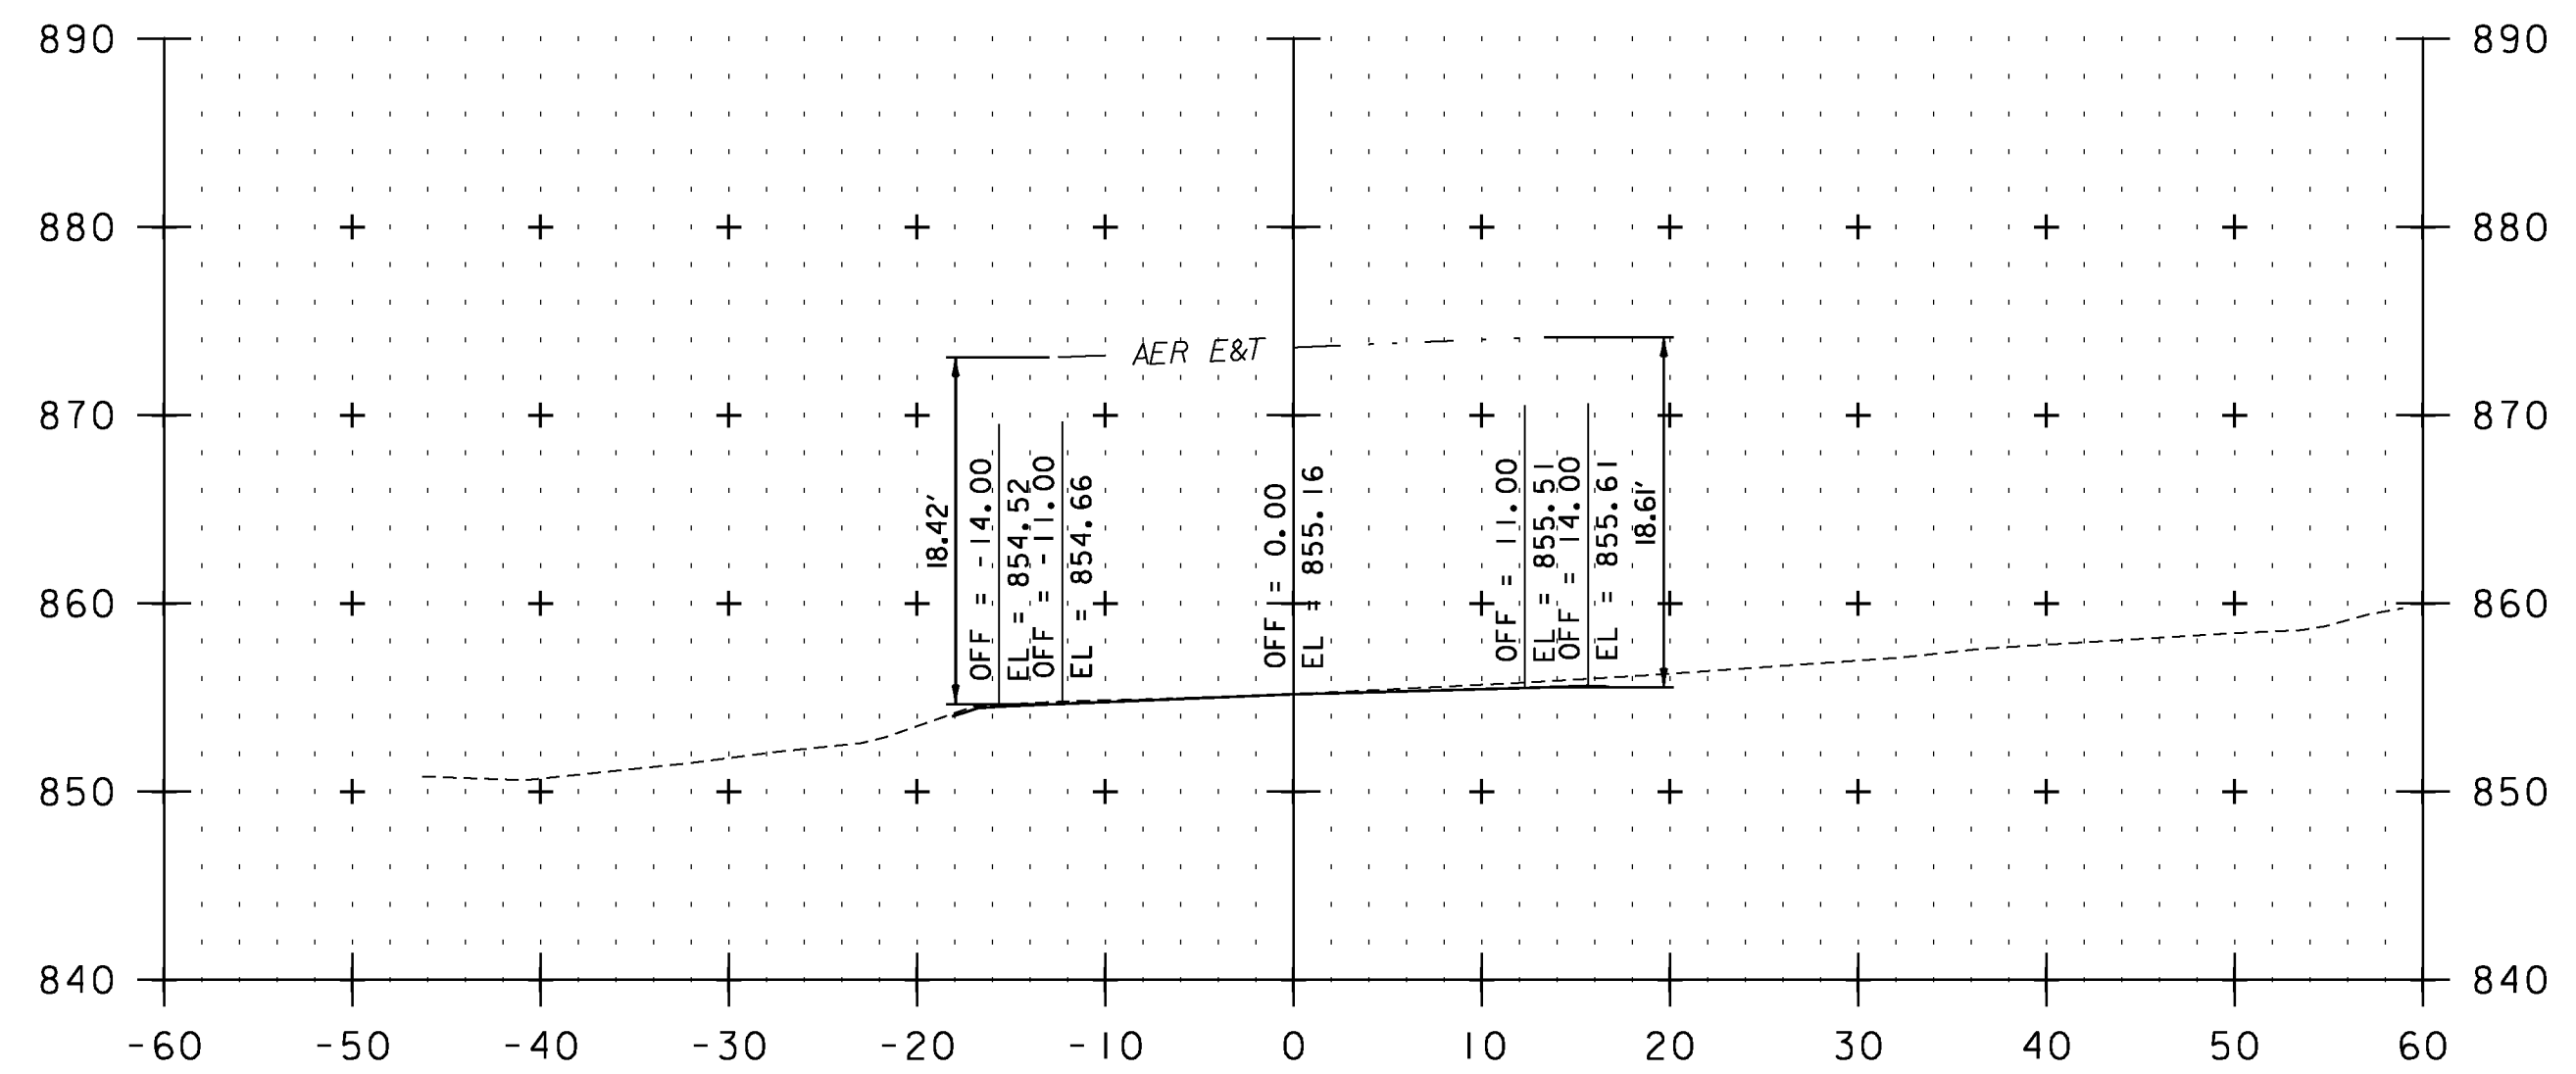

348+06

STA. 325+45 TO STA. 350+14

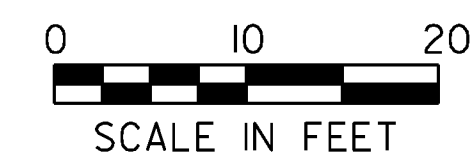

UTILITY CROSS SECTION SHEET 9

PROJECT NAME: VERSHIRE-THETFORD	PLOT DATE: 1/29/2013
PROJECT NUMBER: STP 2911(I)	DRAWN BY: JLS
FILE NAME: pl0c224.dgn	CHECKED BY: PTS
PROJECT LEADER: PTS	SHEET 213 OF 232
DESIGNED BY: NULL	
IPARM FILE NAME: IOC224_213	