



368+07

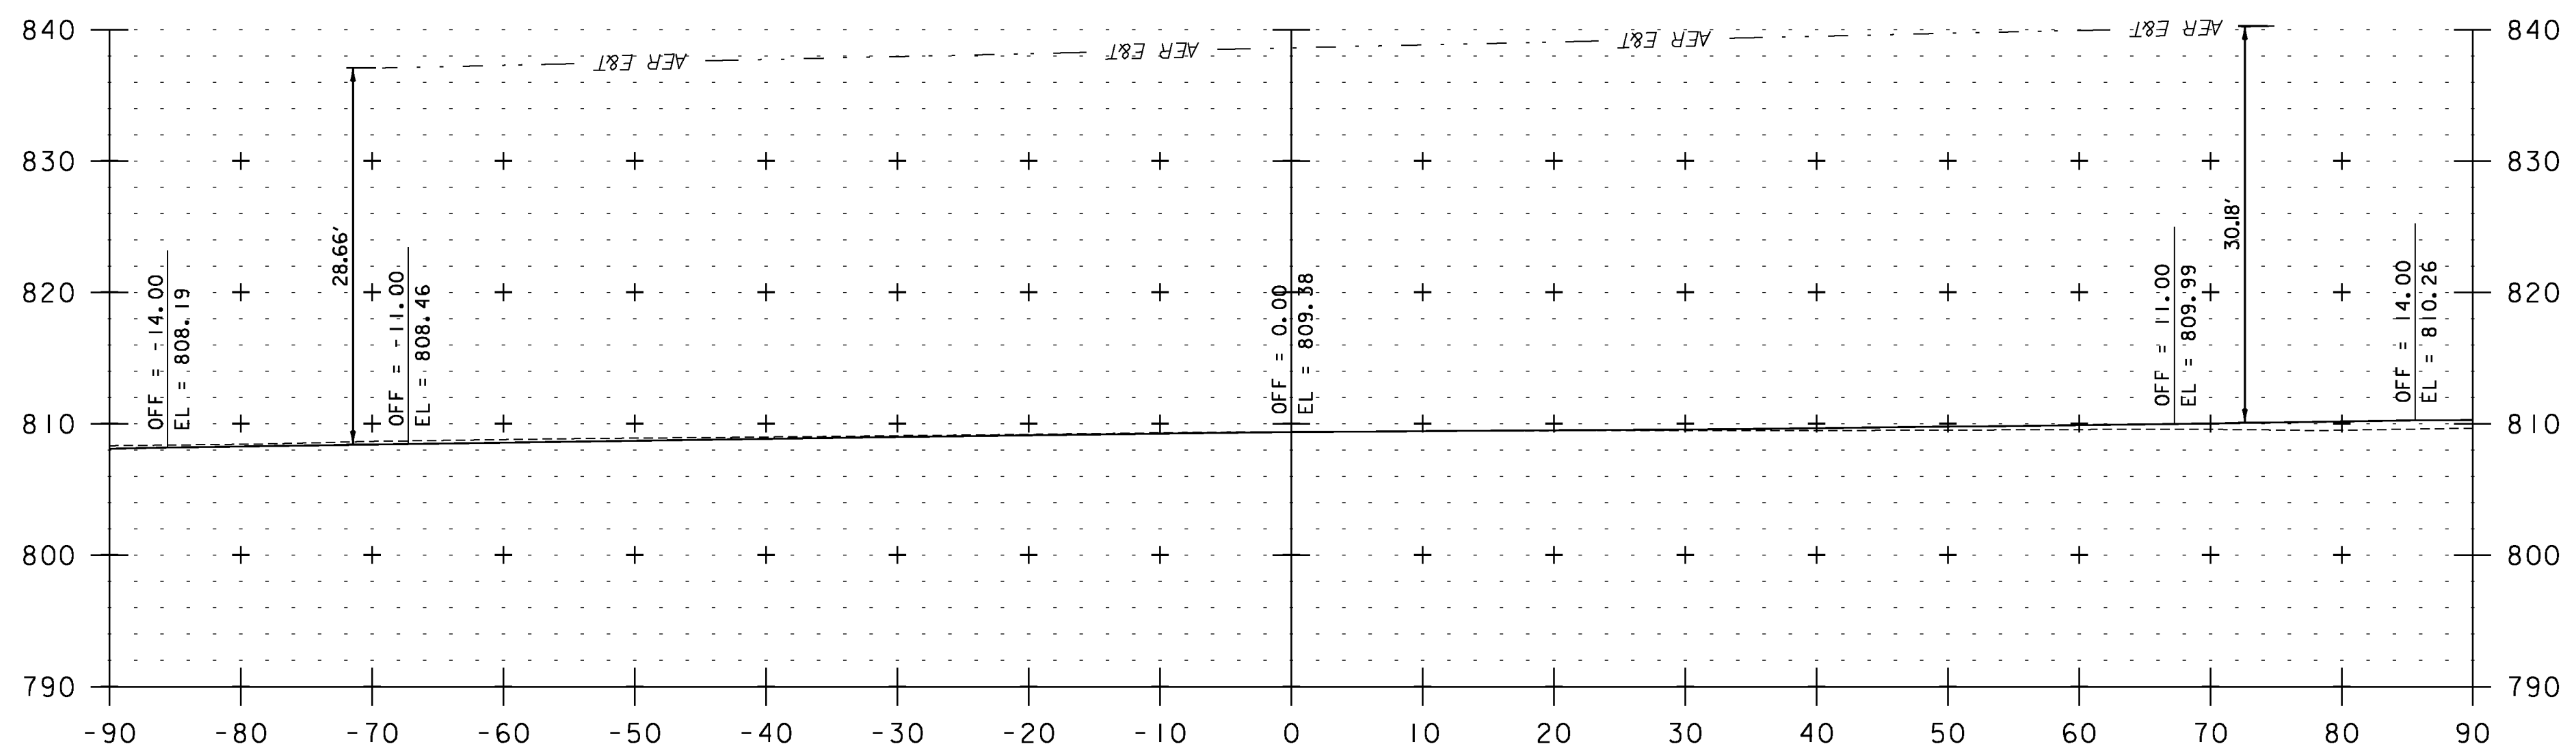

366+19

STA. 366+19 TO STA. 368+07

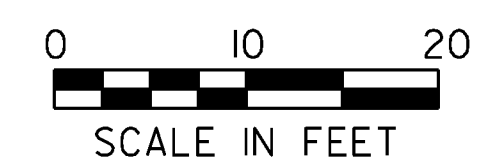

UTILITY CROSS SECTION SHEET 11

PROJECT NAME: VERSHIRE-THETFORD	PLOT DATE: 1/29/2013
PROJECT NUMBER: STP 2911(I)	DRAWN BY: JLS
FILE NAME: pl0c224.dgn	CHECKED BY: PTS
PROJECT LEADER: PTS	SHEET 215 OF 232
DESIGNED BY: NLL	
IPARM FILE NAME: IOC224_215	