




373+14

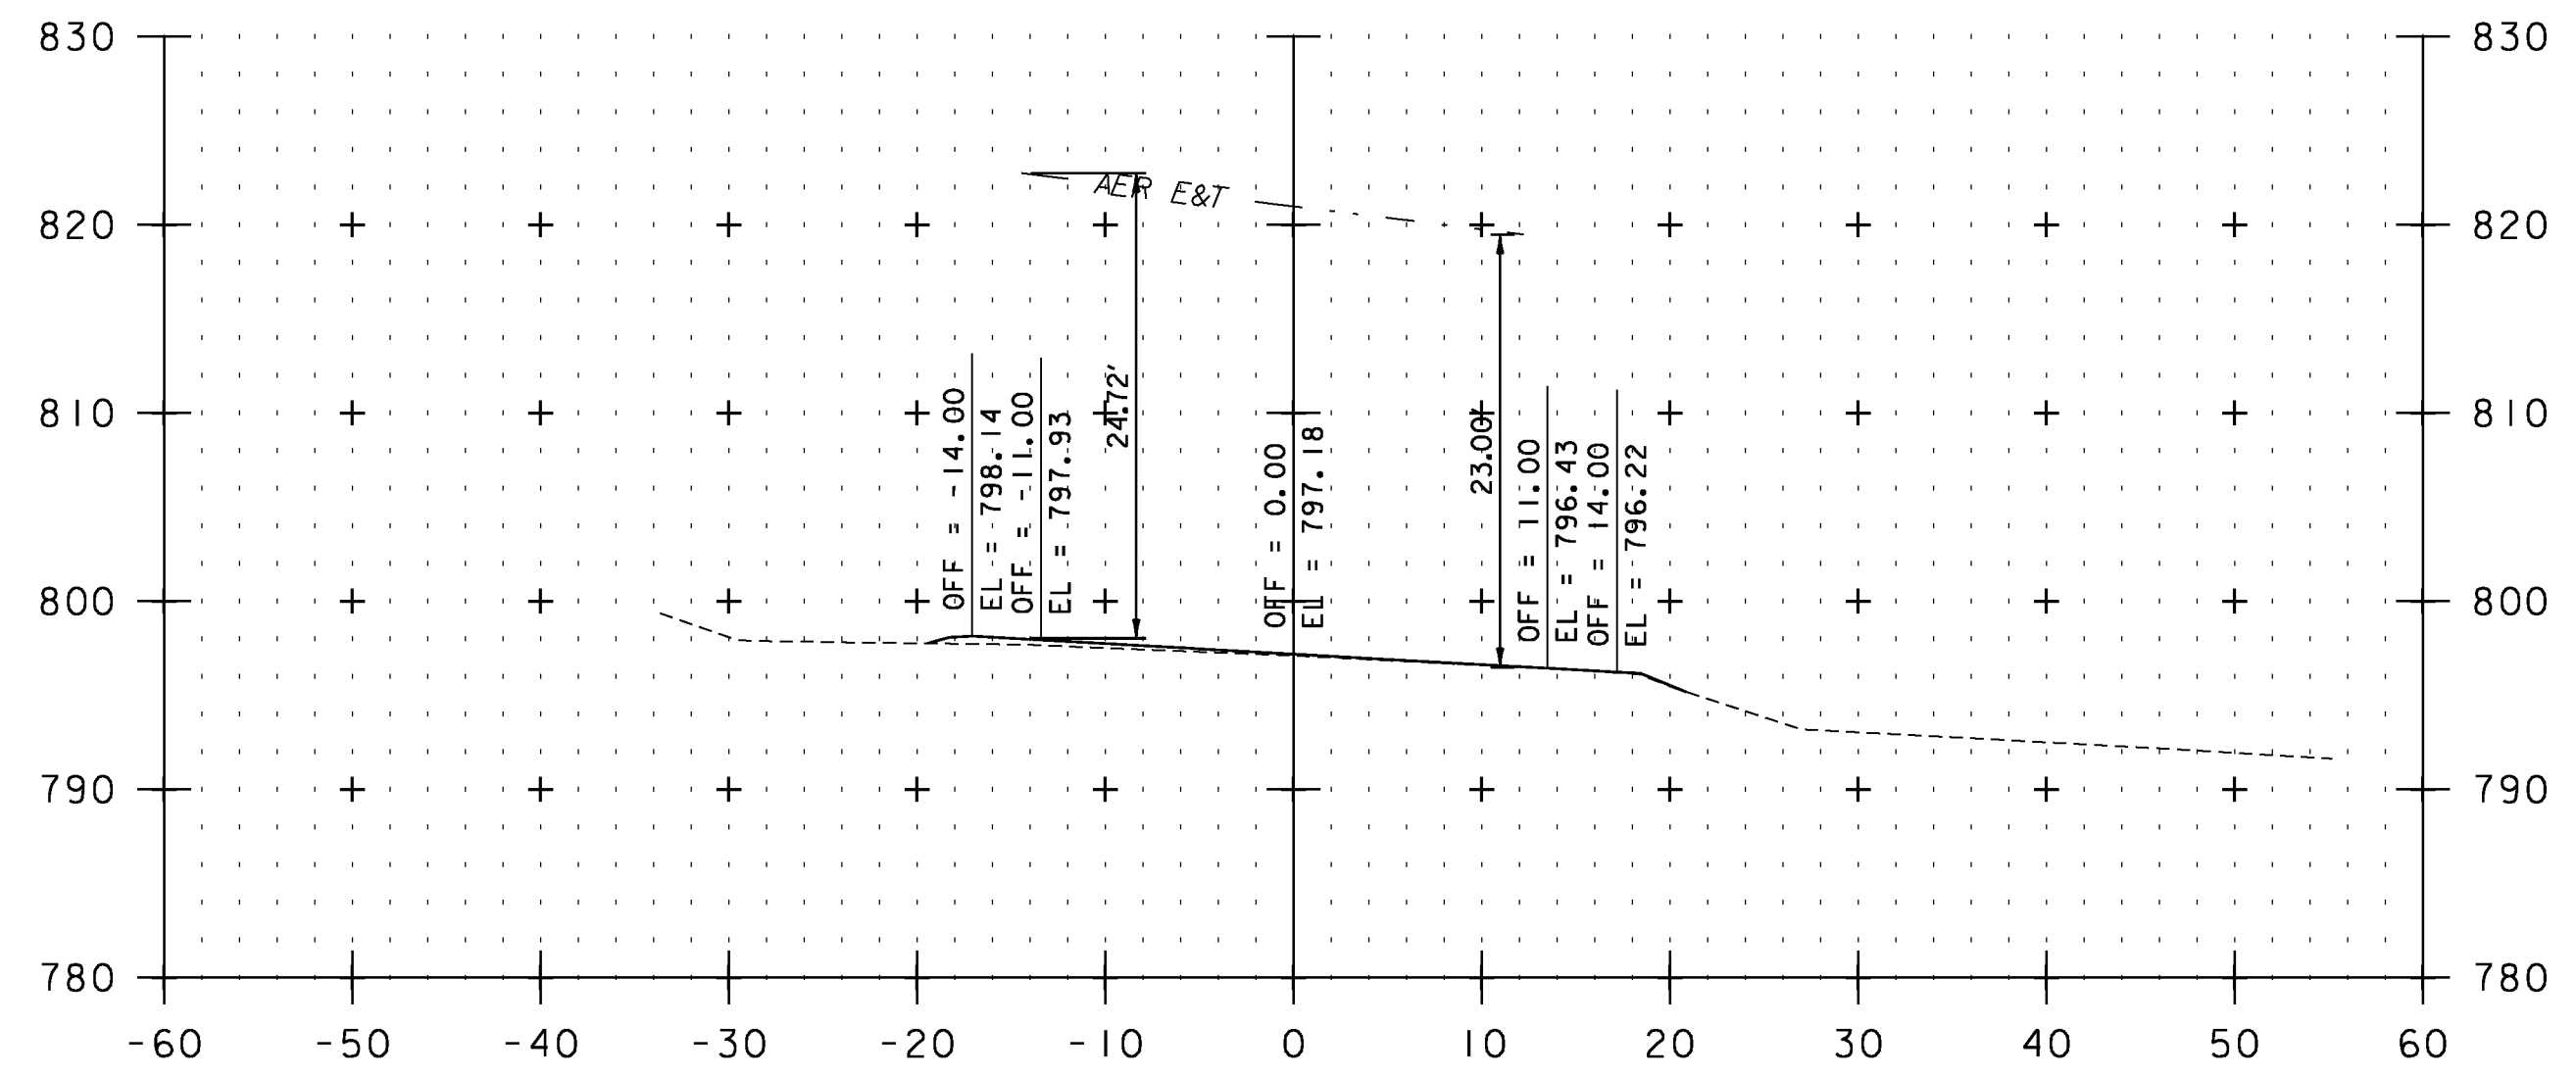

380+32

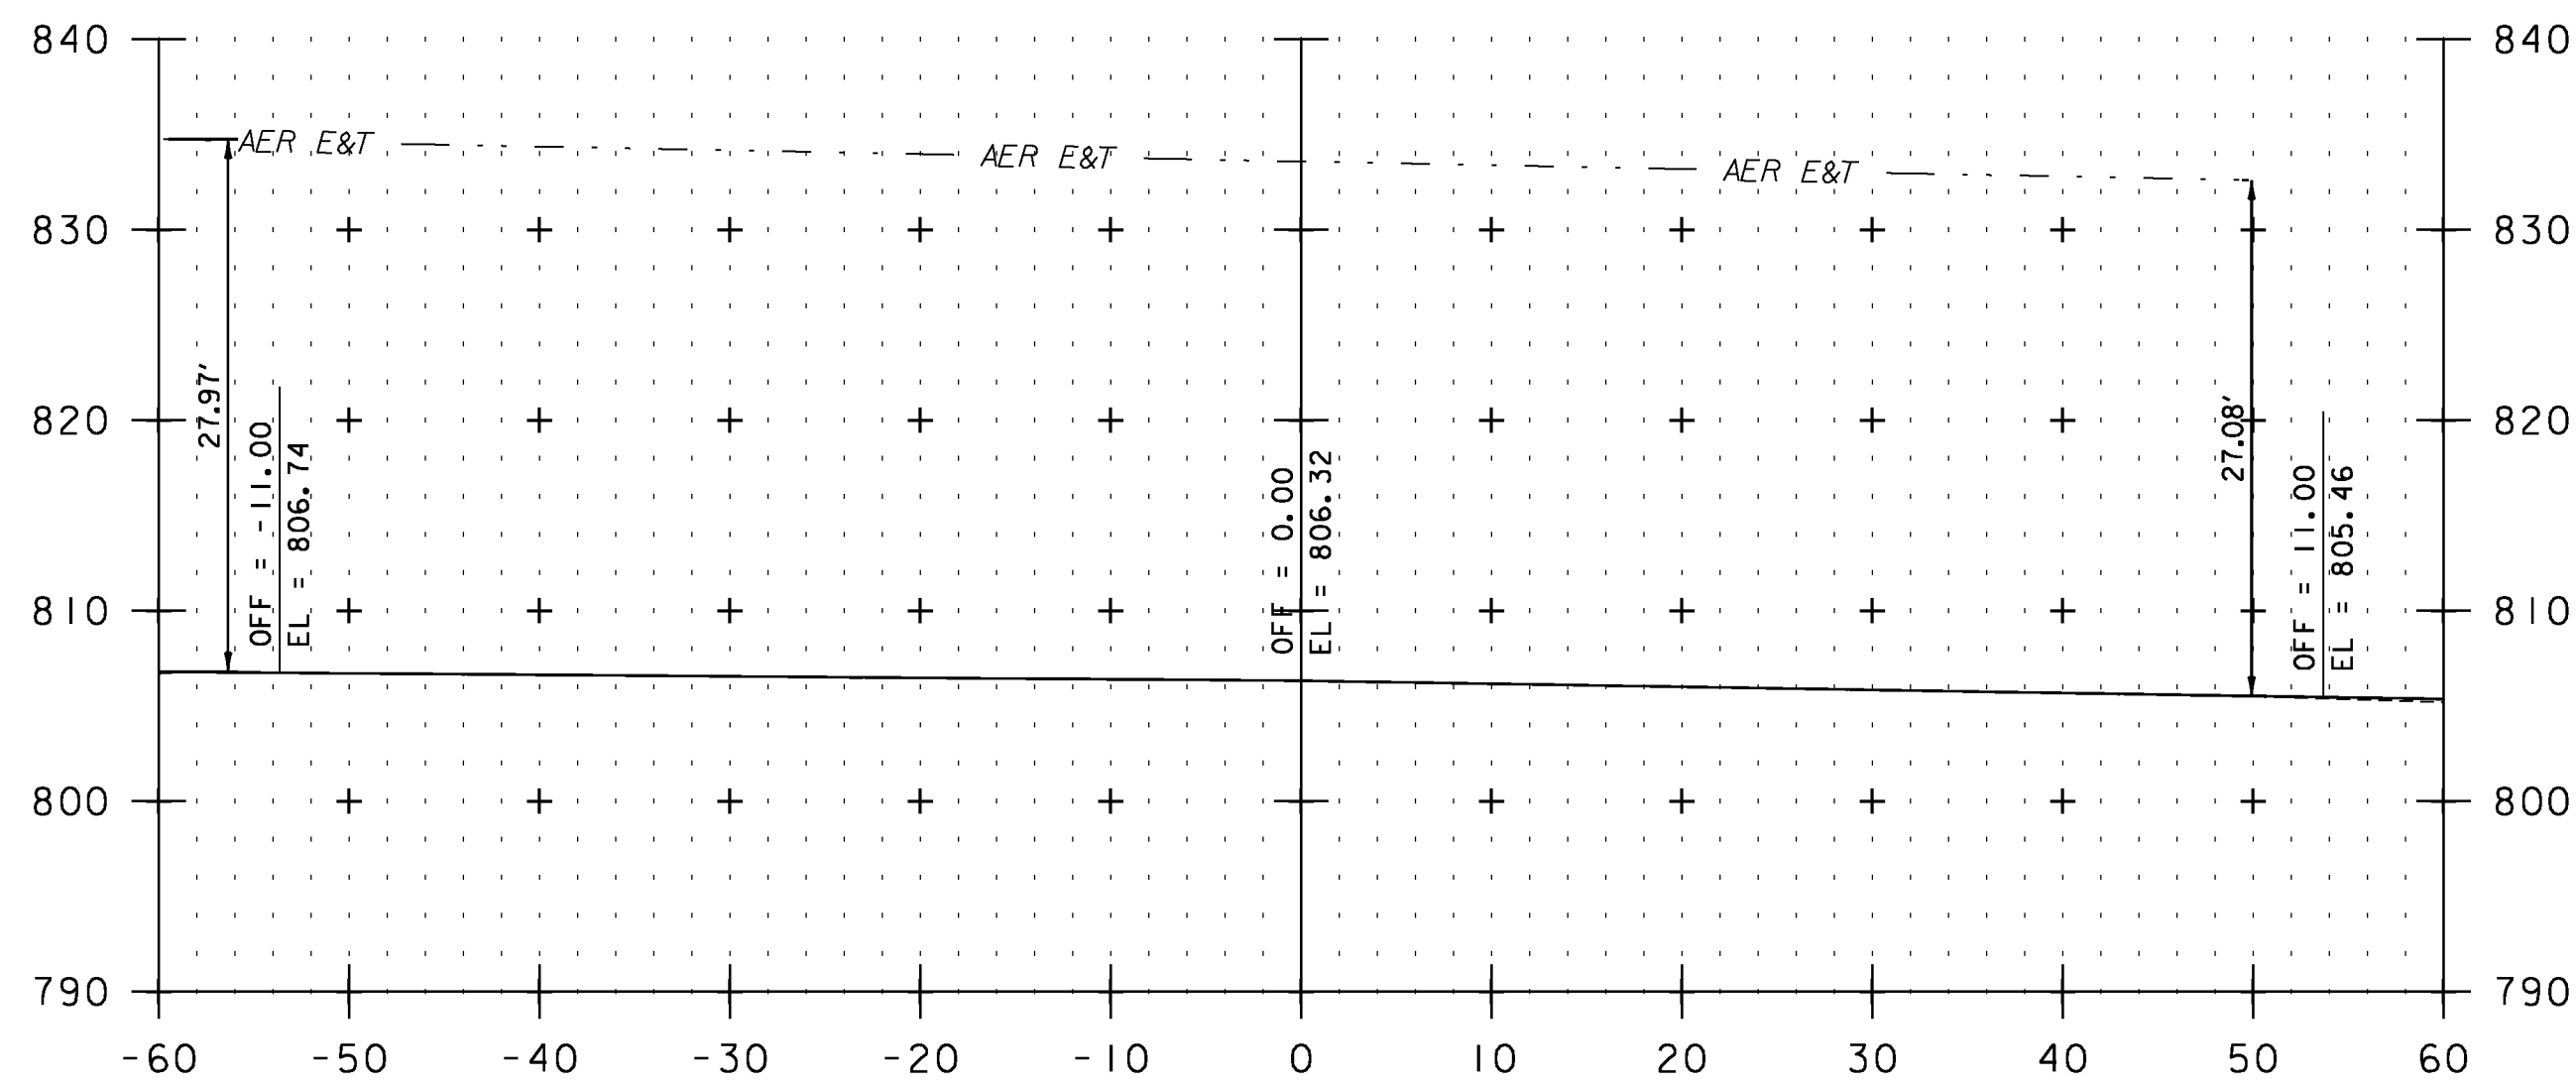


368+80

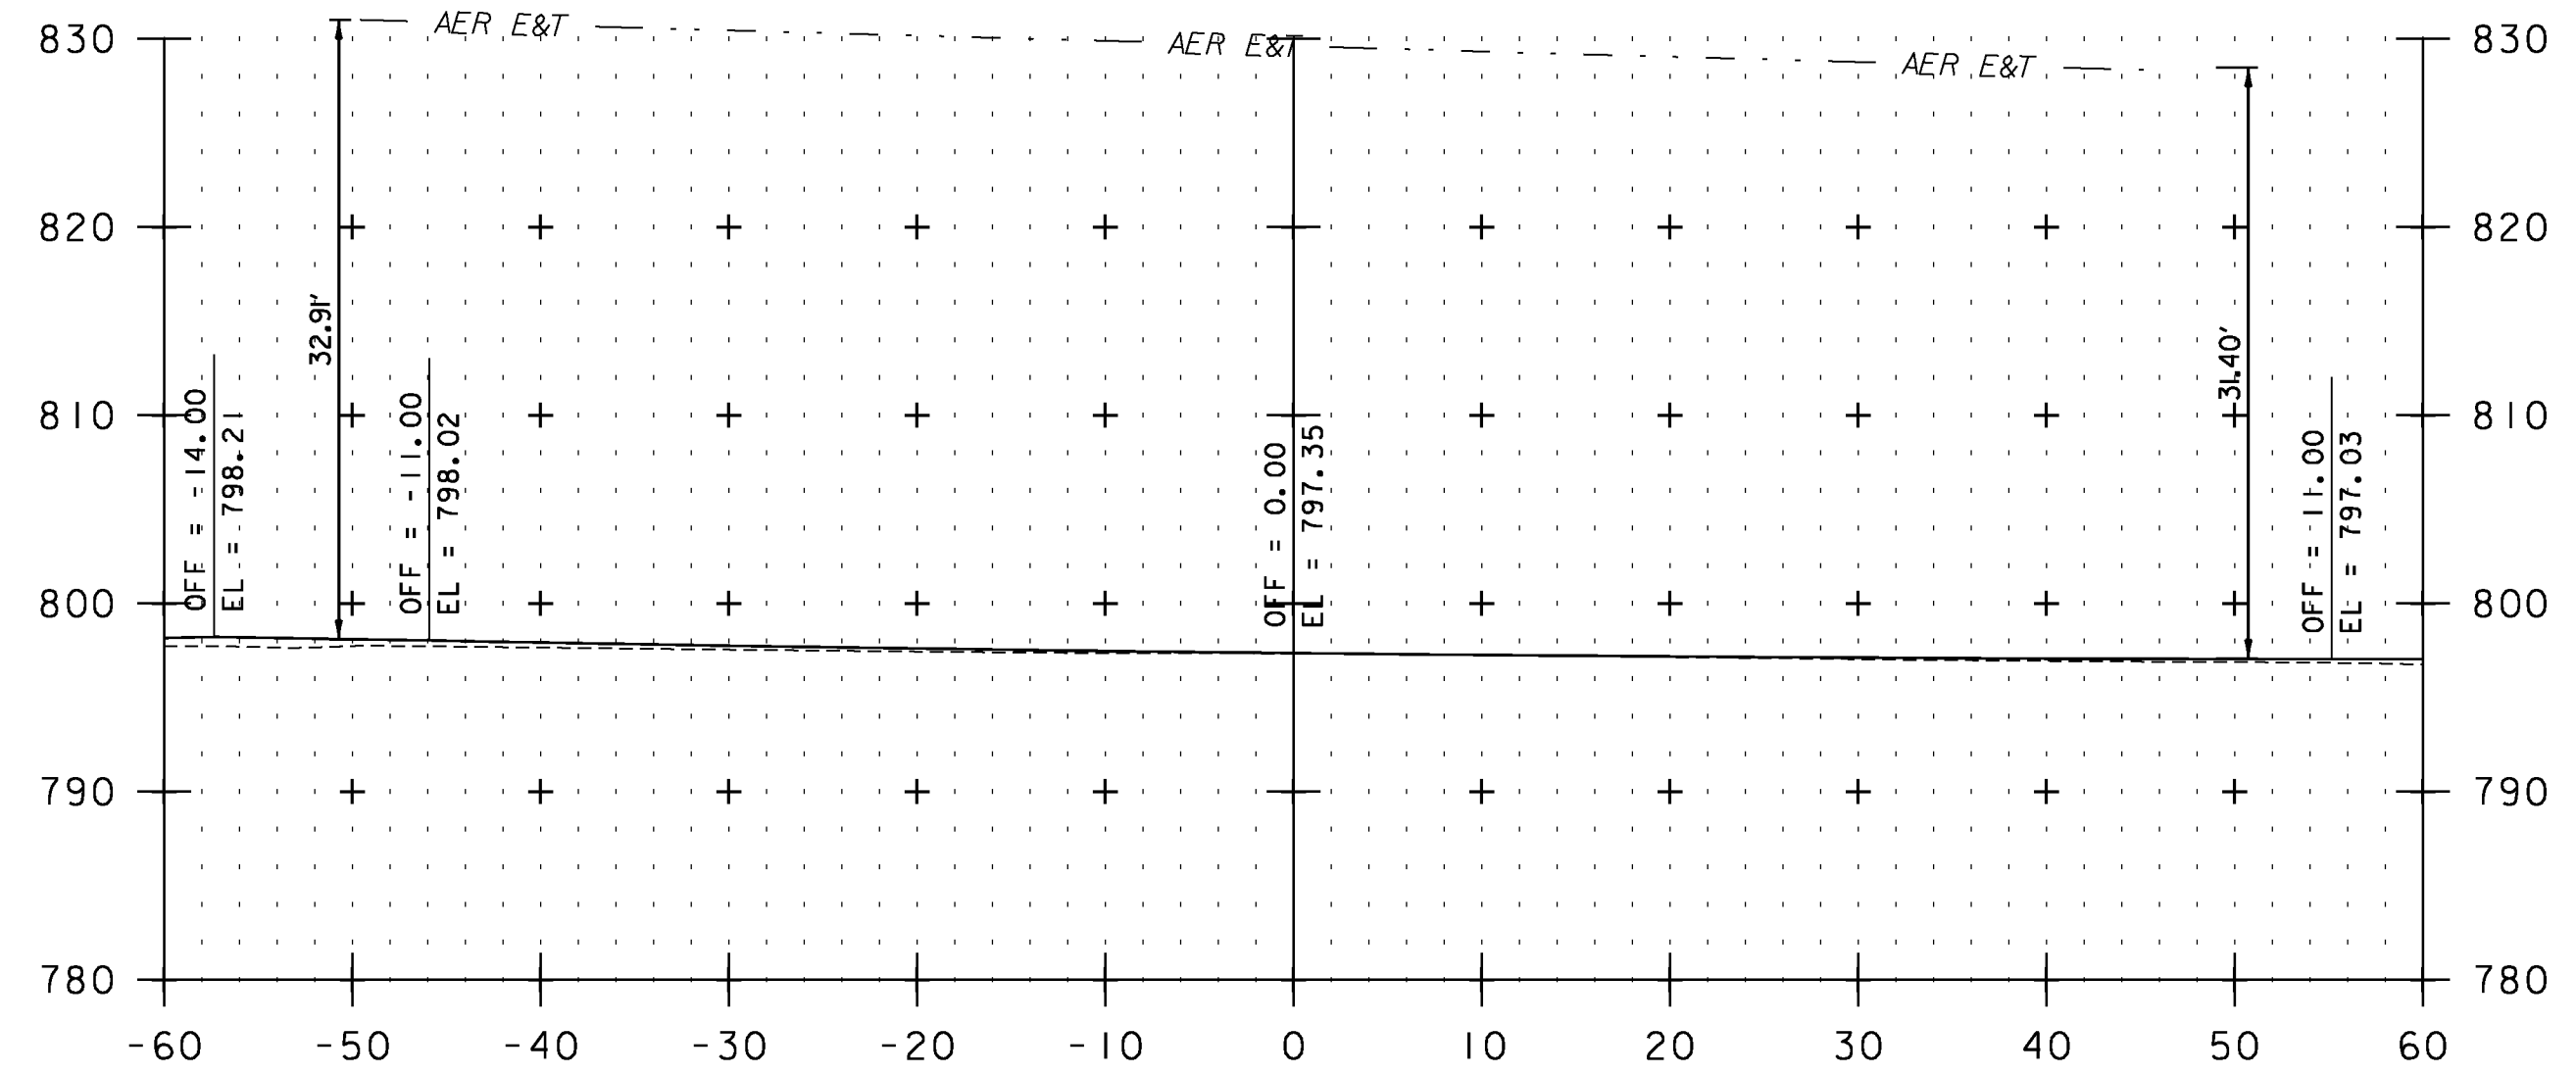

379+55

STA. 368+80 TO STA. 380+32

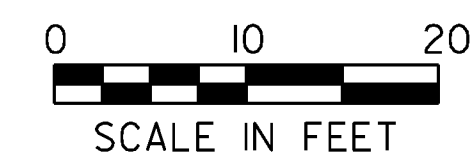

**UTILITY CROSS SECTION SHEET 12**

PROJECT NAME: VERSHIRE-THETFORD	PLOT DATE: 1/29/2013
PROJECT NUMBER: STP 2911(I)	DRAWN BY: JLS
FILE NAME: pl0c224.dgn	CHECKED BY: PTS
PROJECT LEADER: PTS	SHEET 216 OF 232
DESIGNED BY: NLL	
IPARM FILE NAME: IOC224_216	