


STA. 391+94 TO STA. 403+85

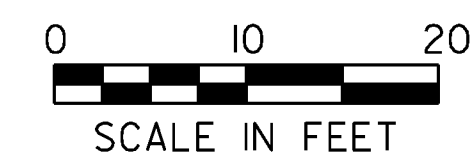

**UTILITY CROSS SECTION SHEET 13**

PROJECT NAME: VERSHIRE-THETFORD

PROJECT NUMBER: STP 291(I)

FILE NAME: pl0c224.dgn

PROJECT LEADER: PTS

DESIGNED BY: NLL

IPARM FILE NAME: IOC224\_217

PLOT DATE: 1/29/2013

DRAWN BY: JLS

CHECKED BY: PTS

SHEET 217 OF 232