




F 87+34

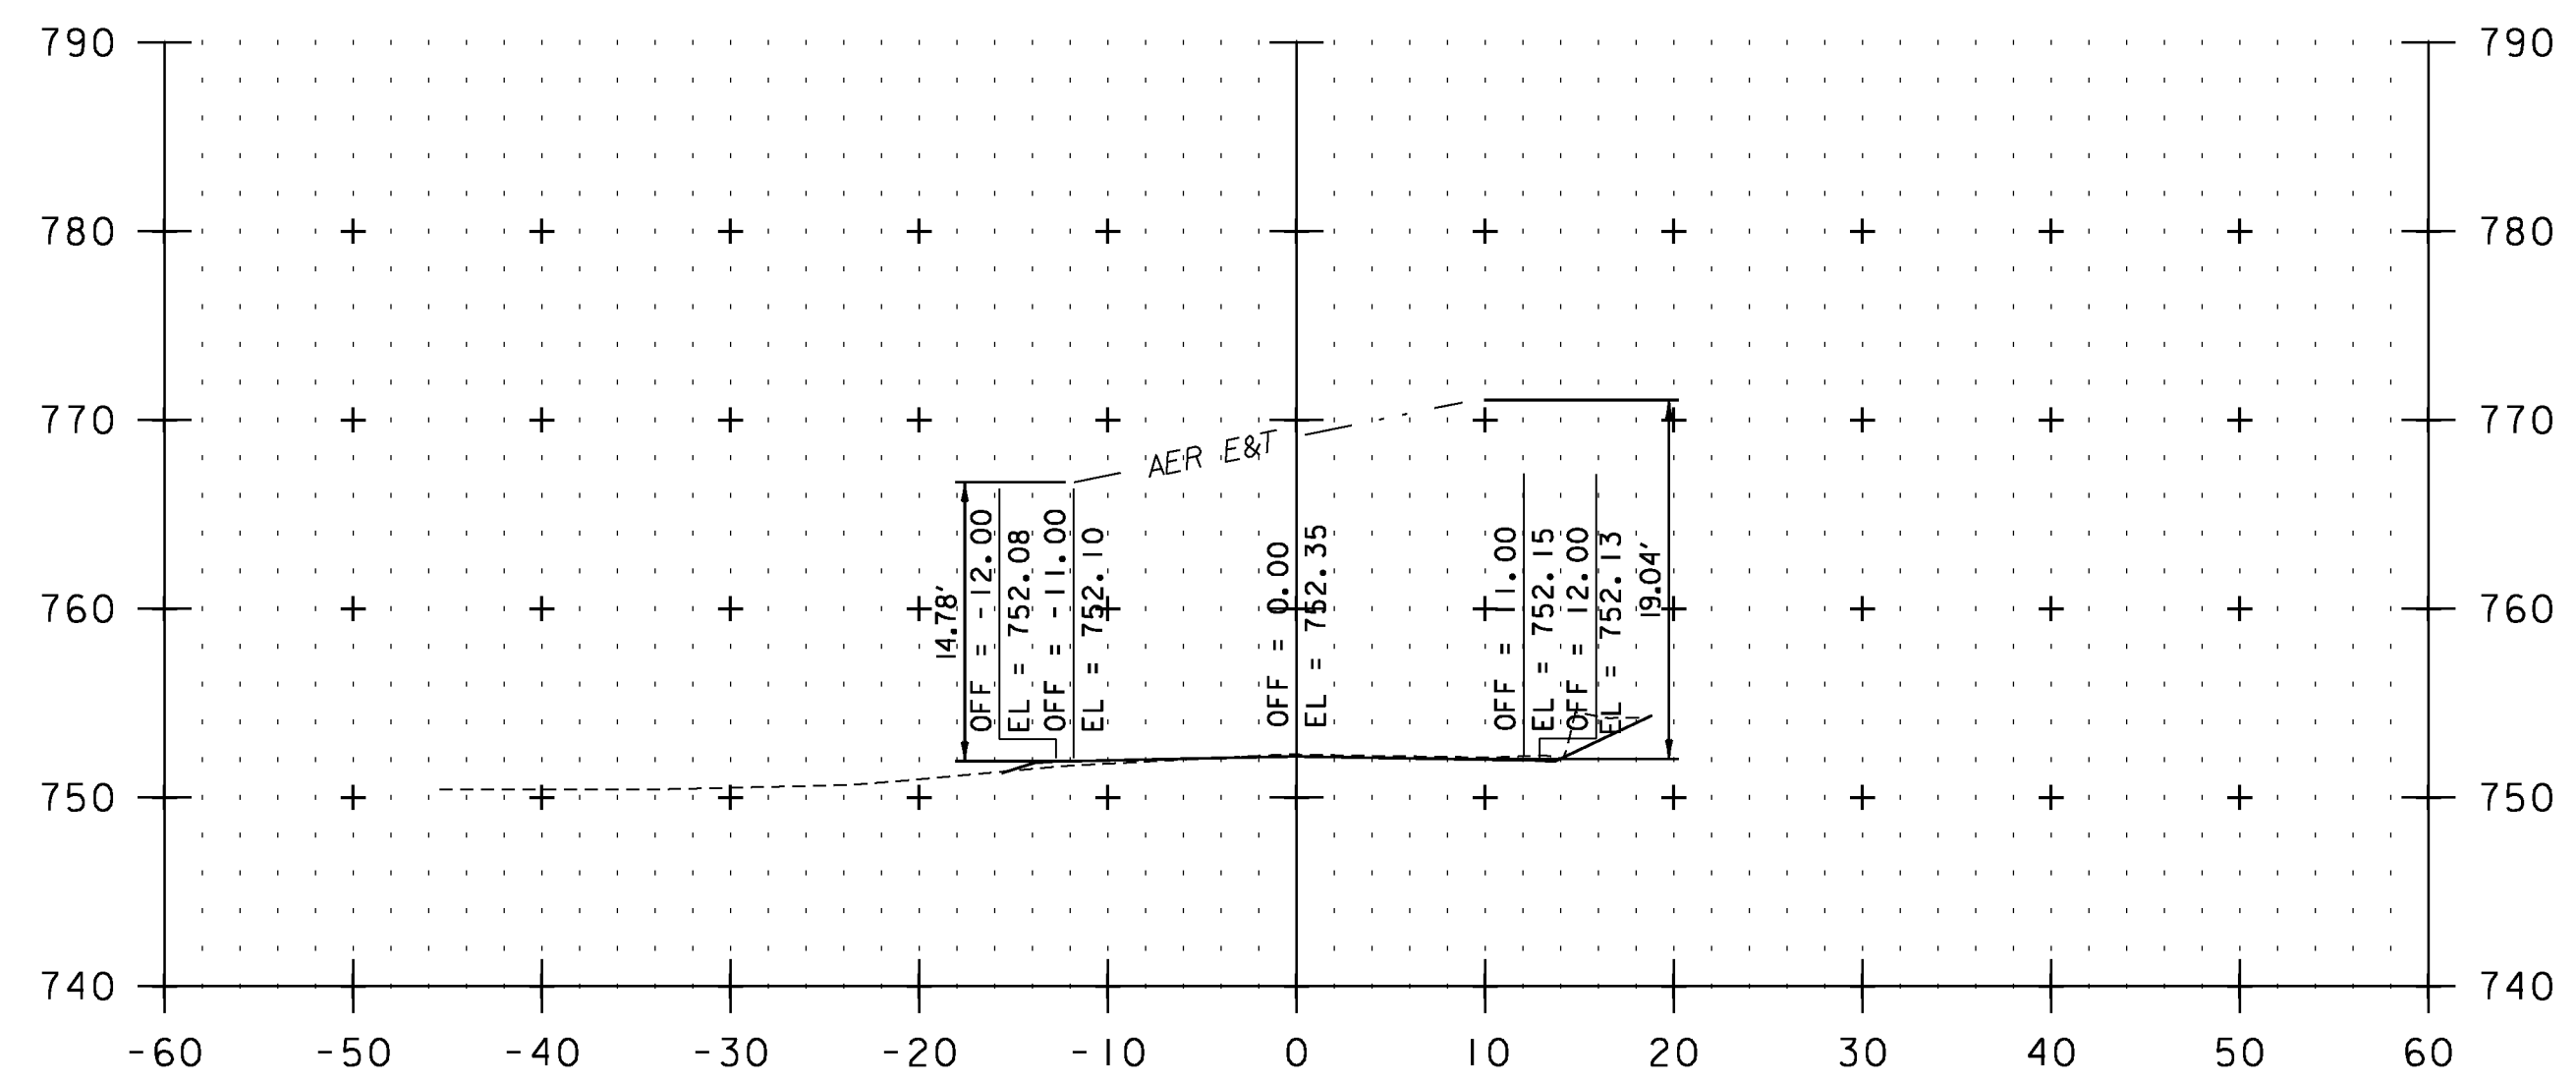

F 91+24

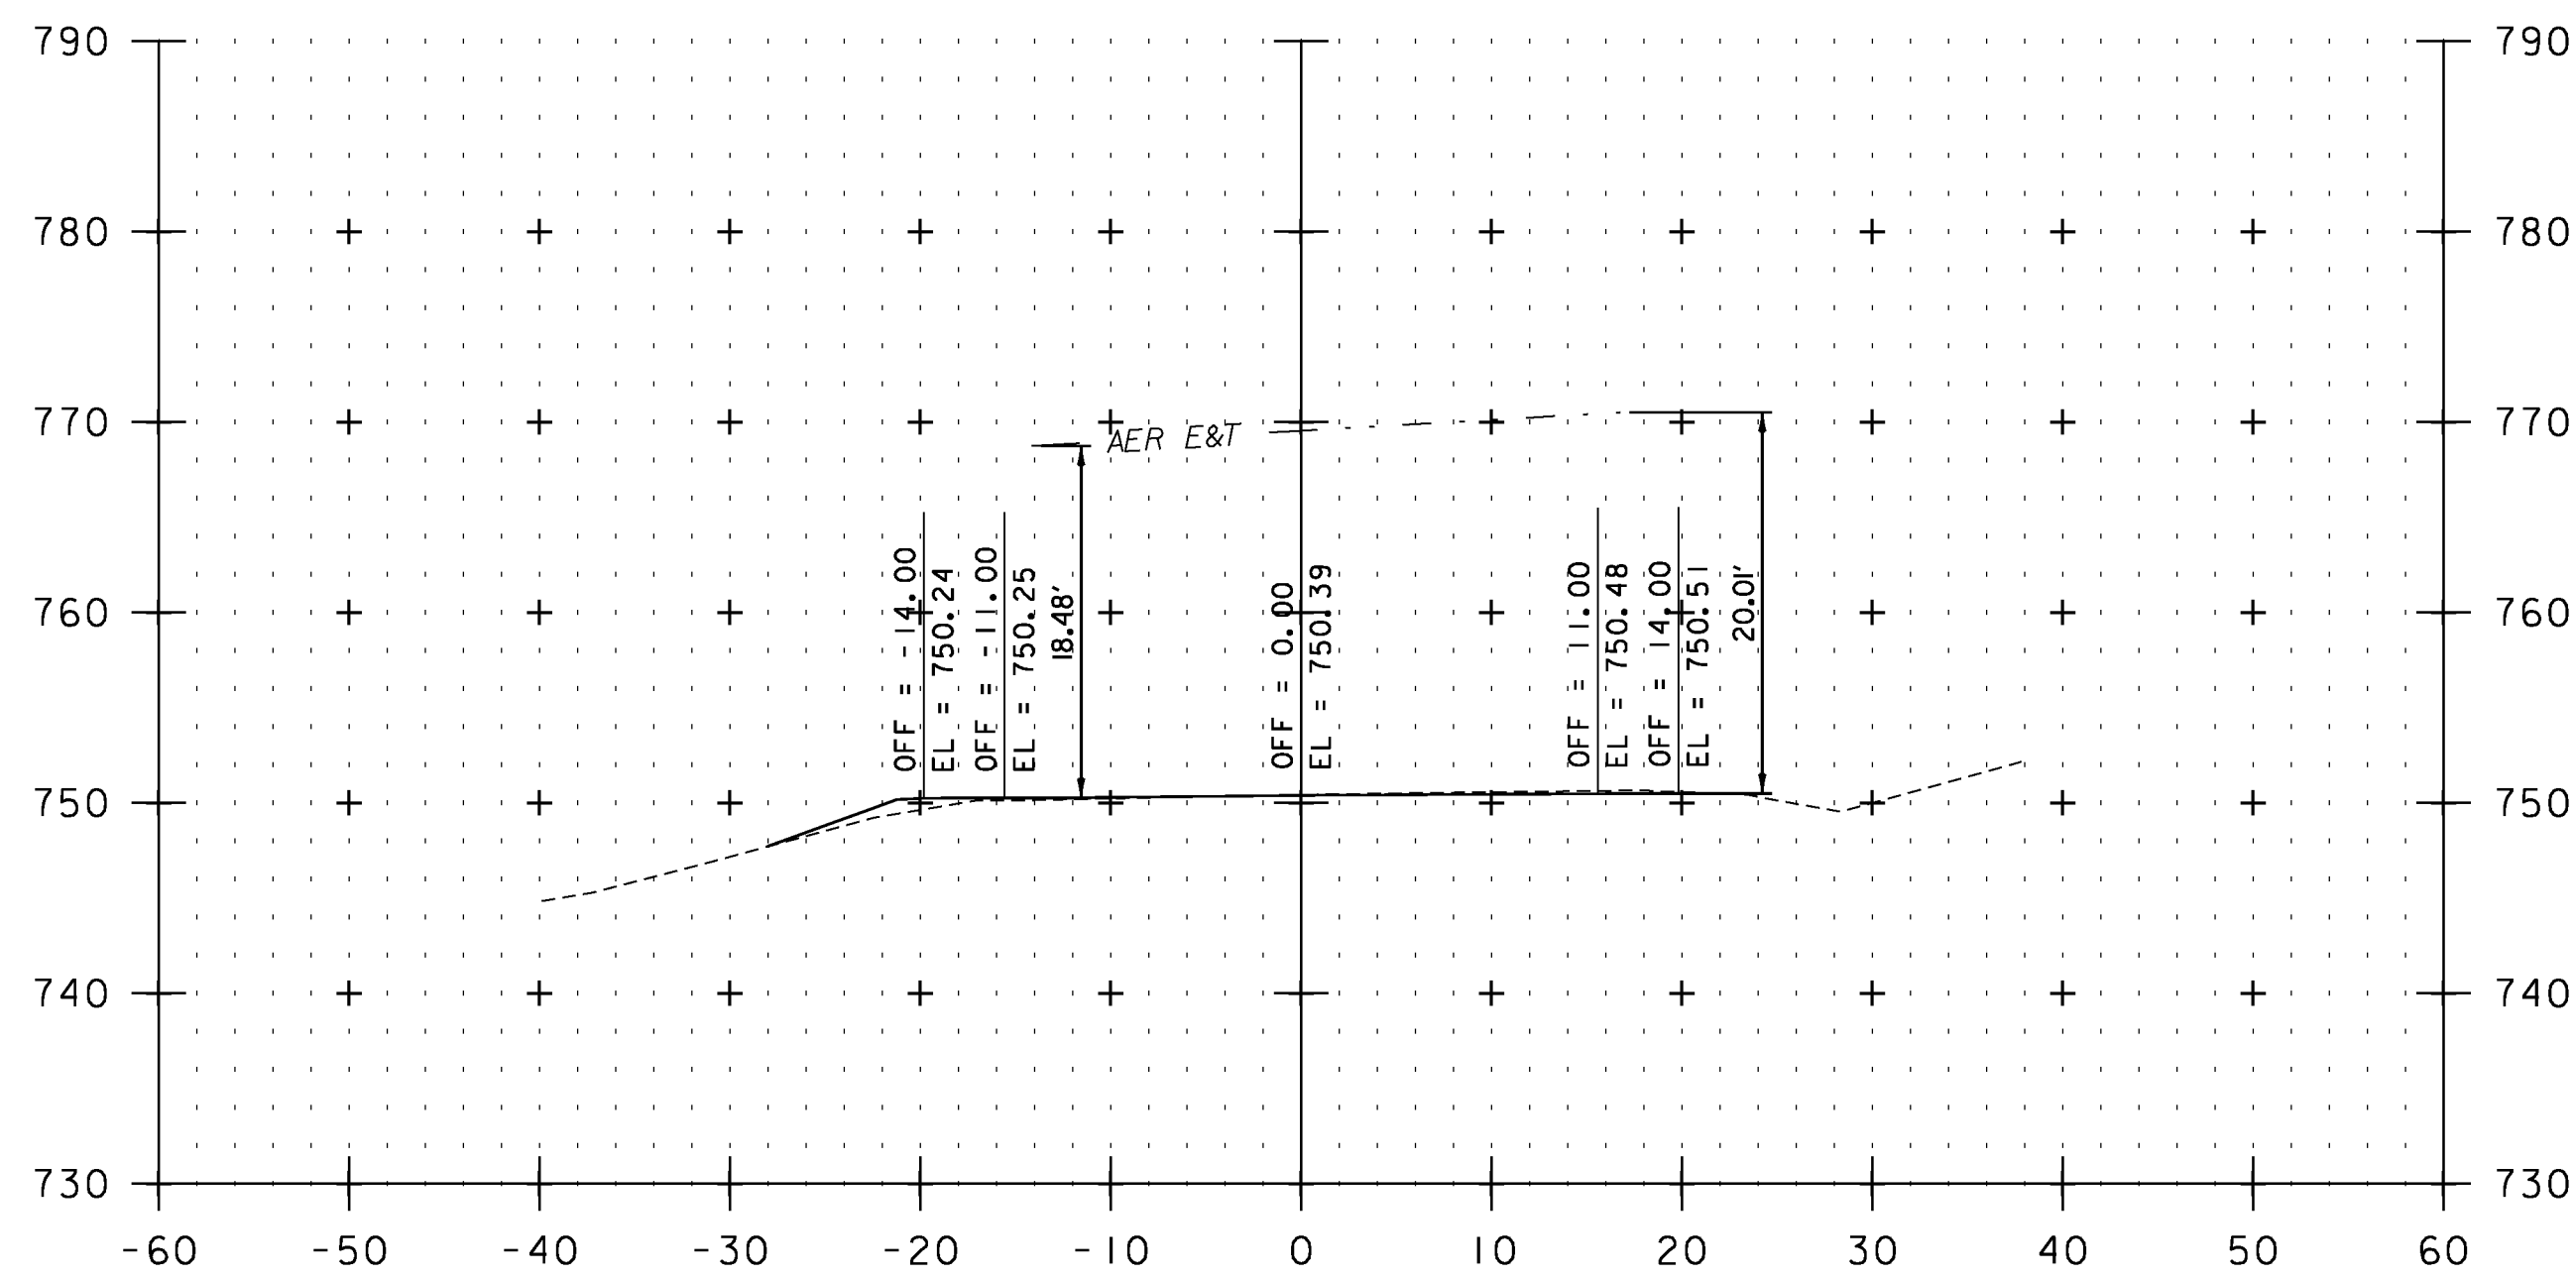

F 72+92

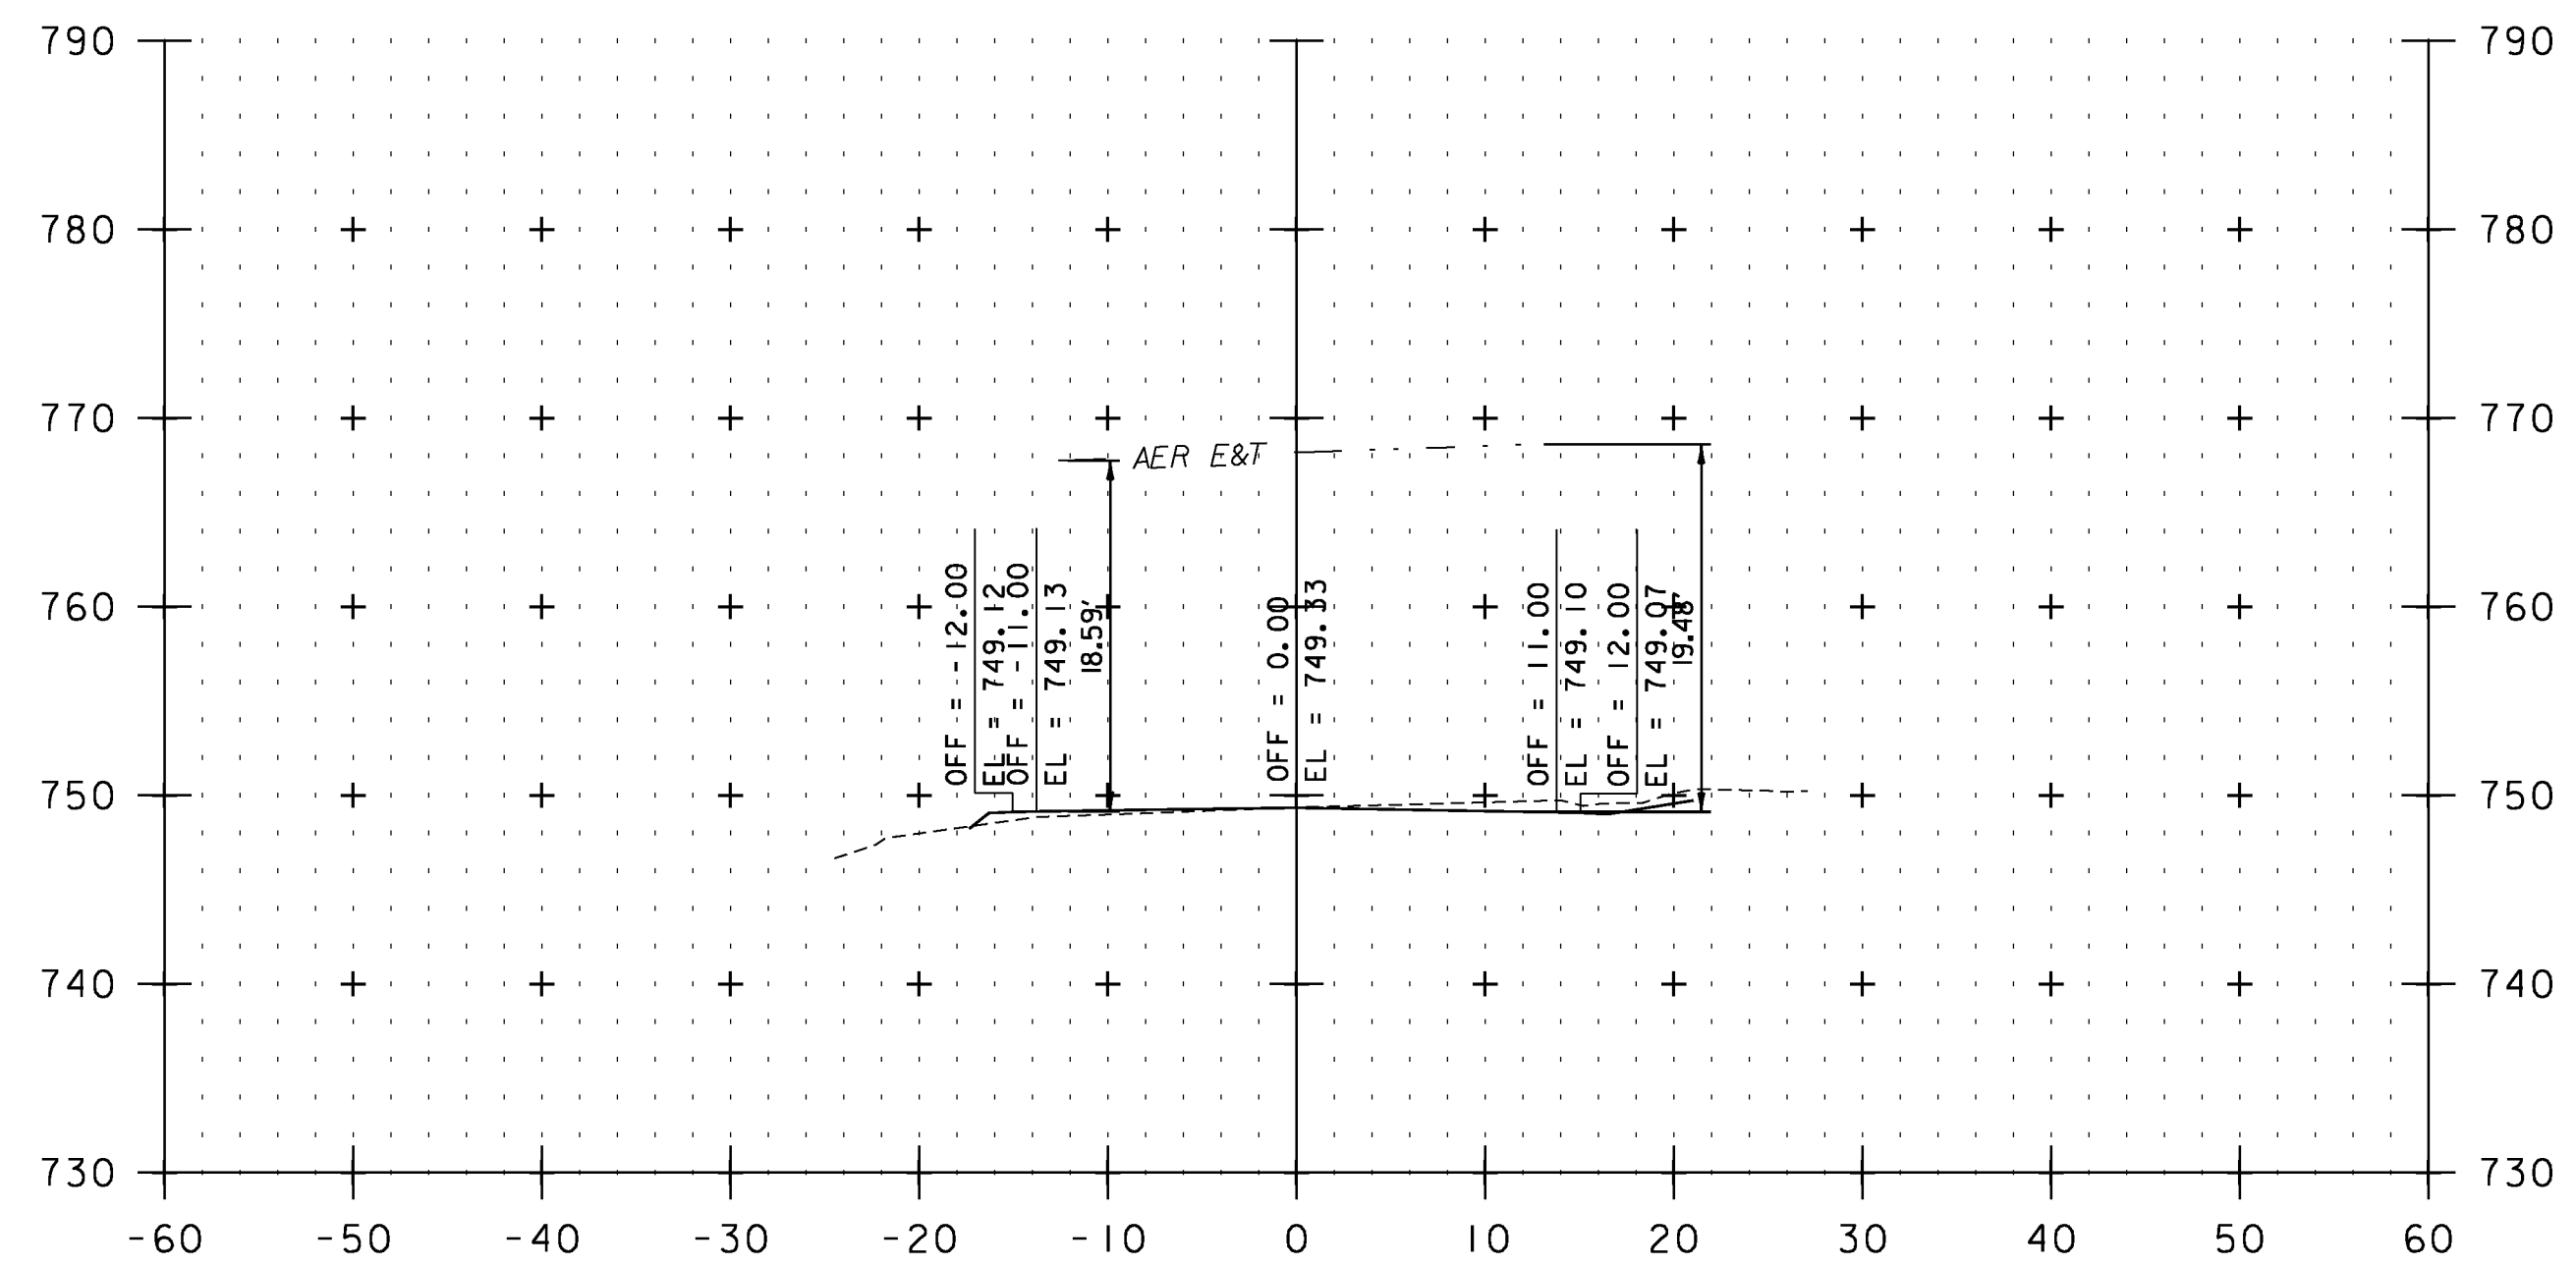

F 88+81

STA. F 72+92 TO STA. F 91+24



**UTILITY CROSS SECTION SHEET 17**

PROJECT NAME: VERSHIRE-THETFORD	PLOT DATE: 1/29/2013
PROJECT NUMBER: STP 2911(I)	DRAWN BY: JLS
FILE NAME: pl0c224.dgn	CHECKED BY: PTS
PROJECT LEADER: PTS	SHEET 221 OF 232
DESIGNED BY: NLL	
IPARM FILE NAME: IOC224_221	