




F 94+40

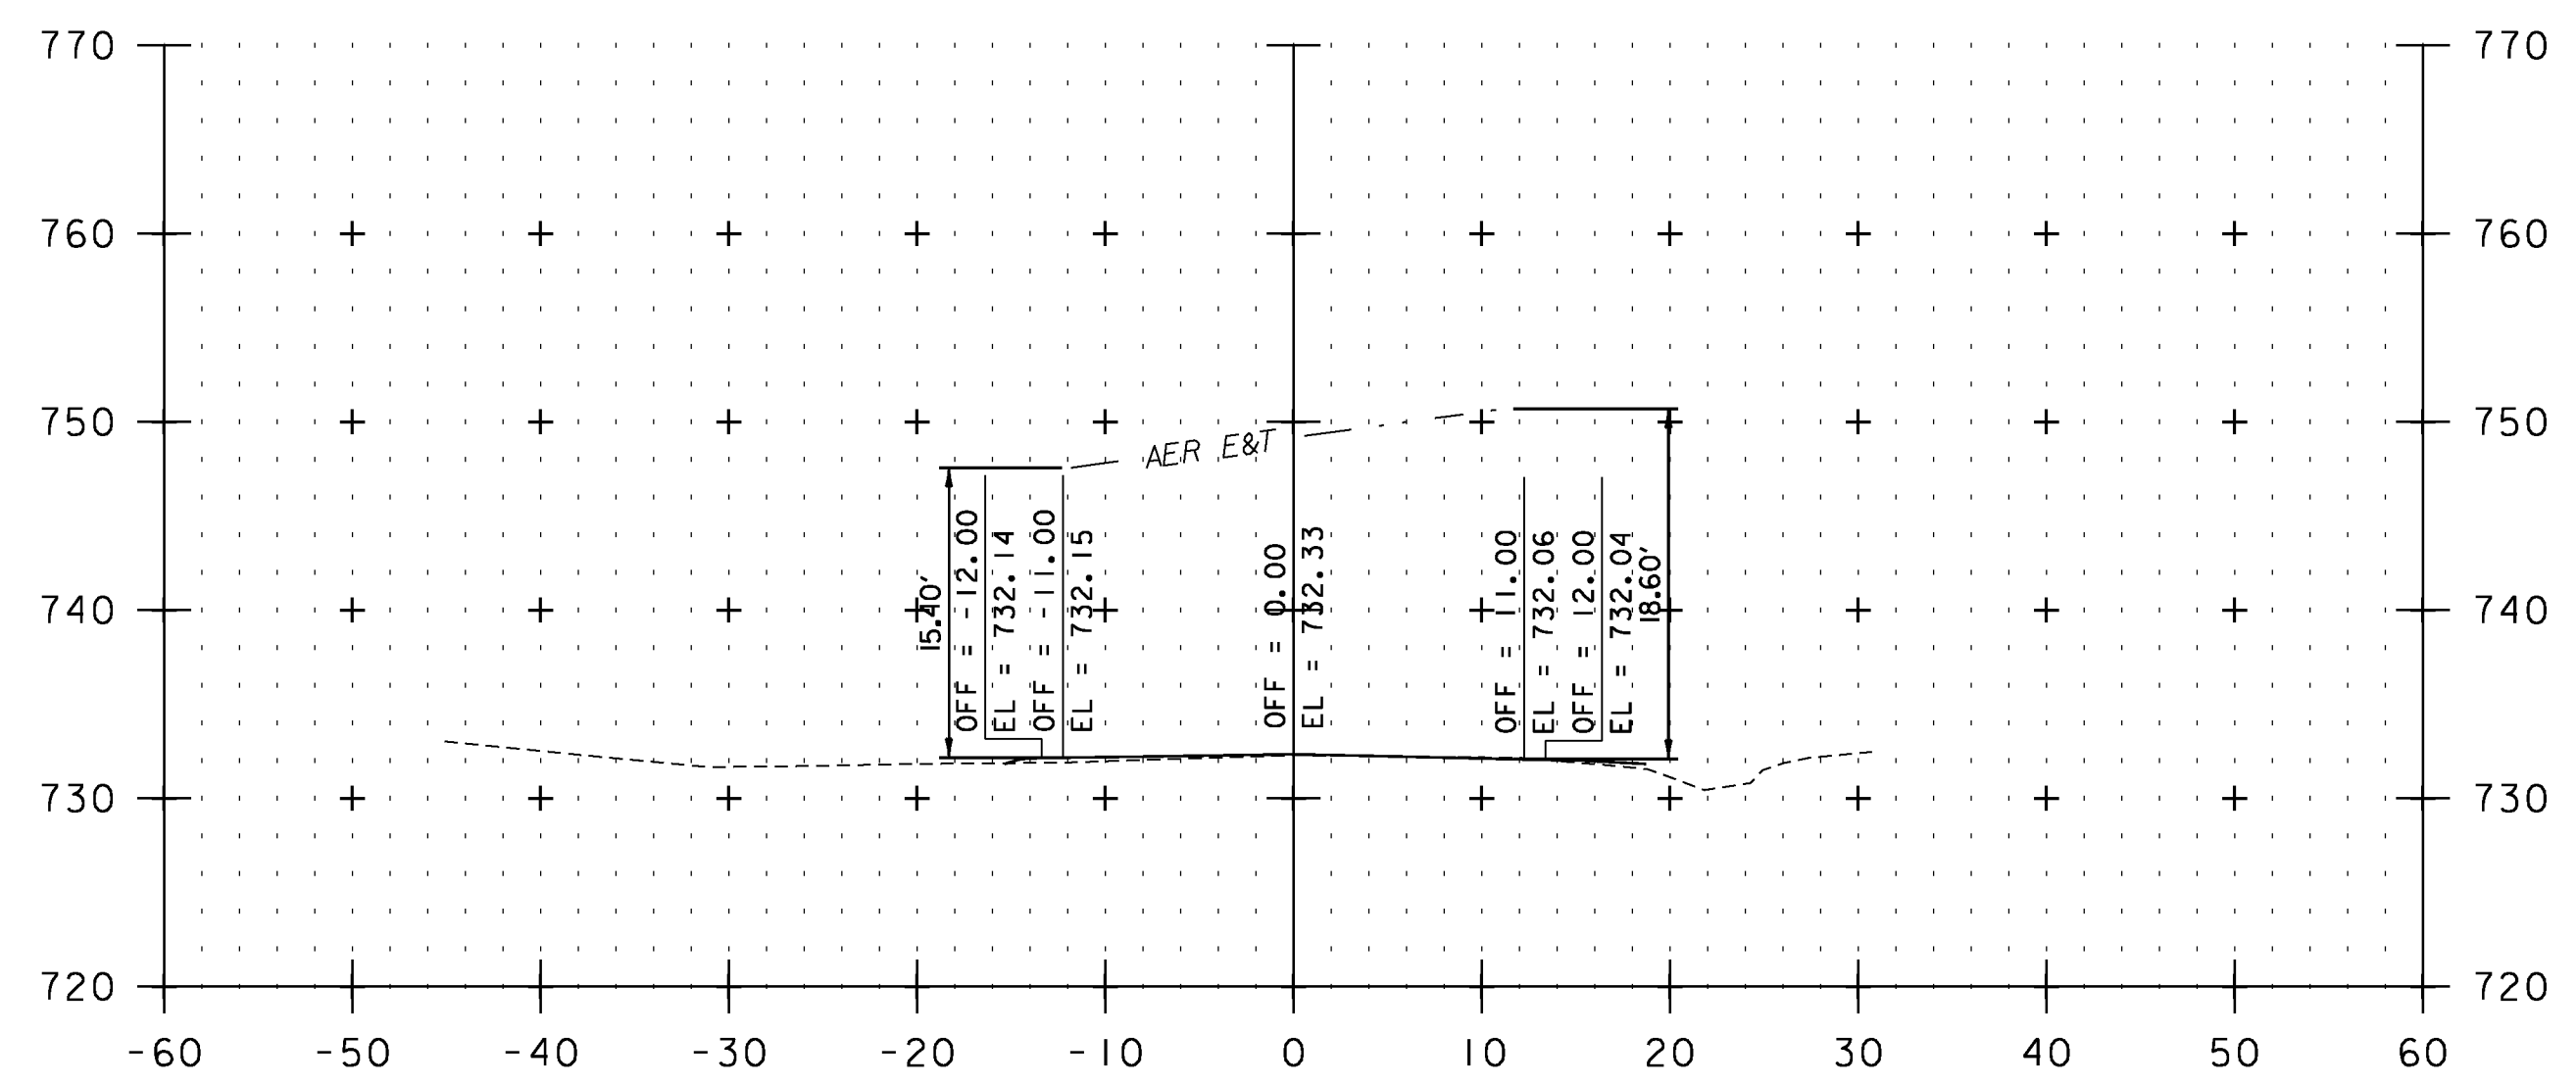

F 98+21

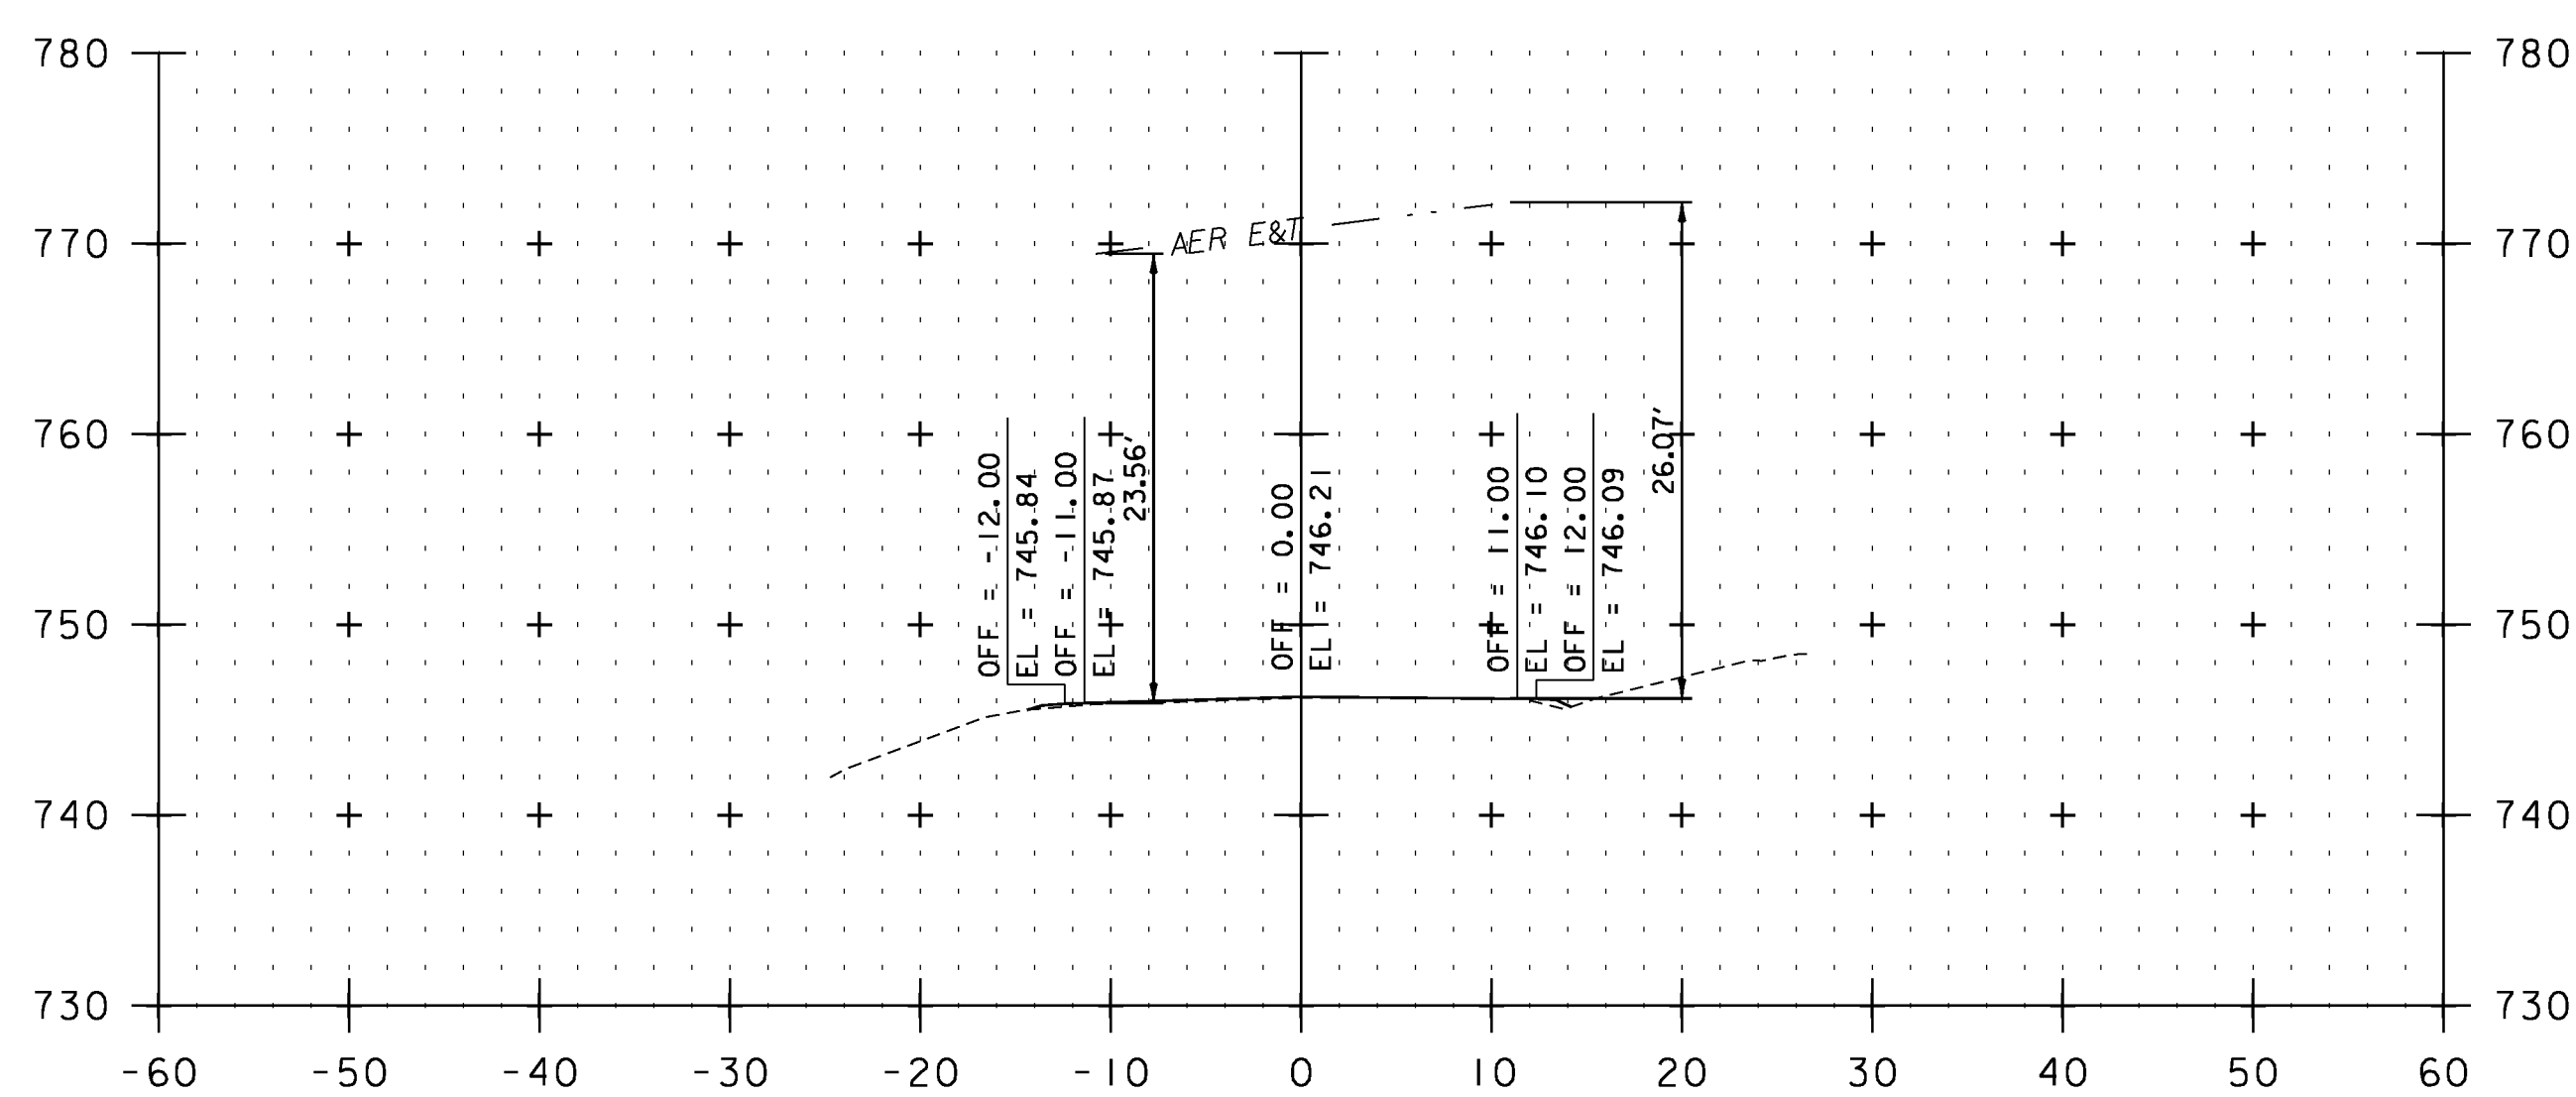


F 93+00

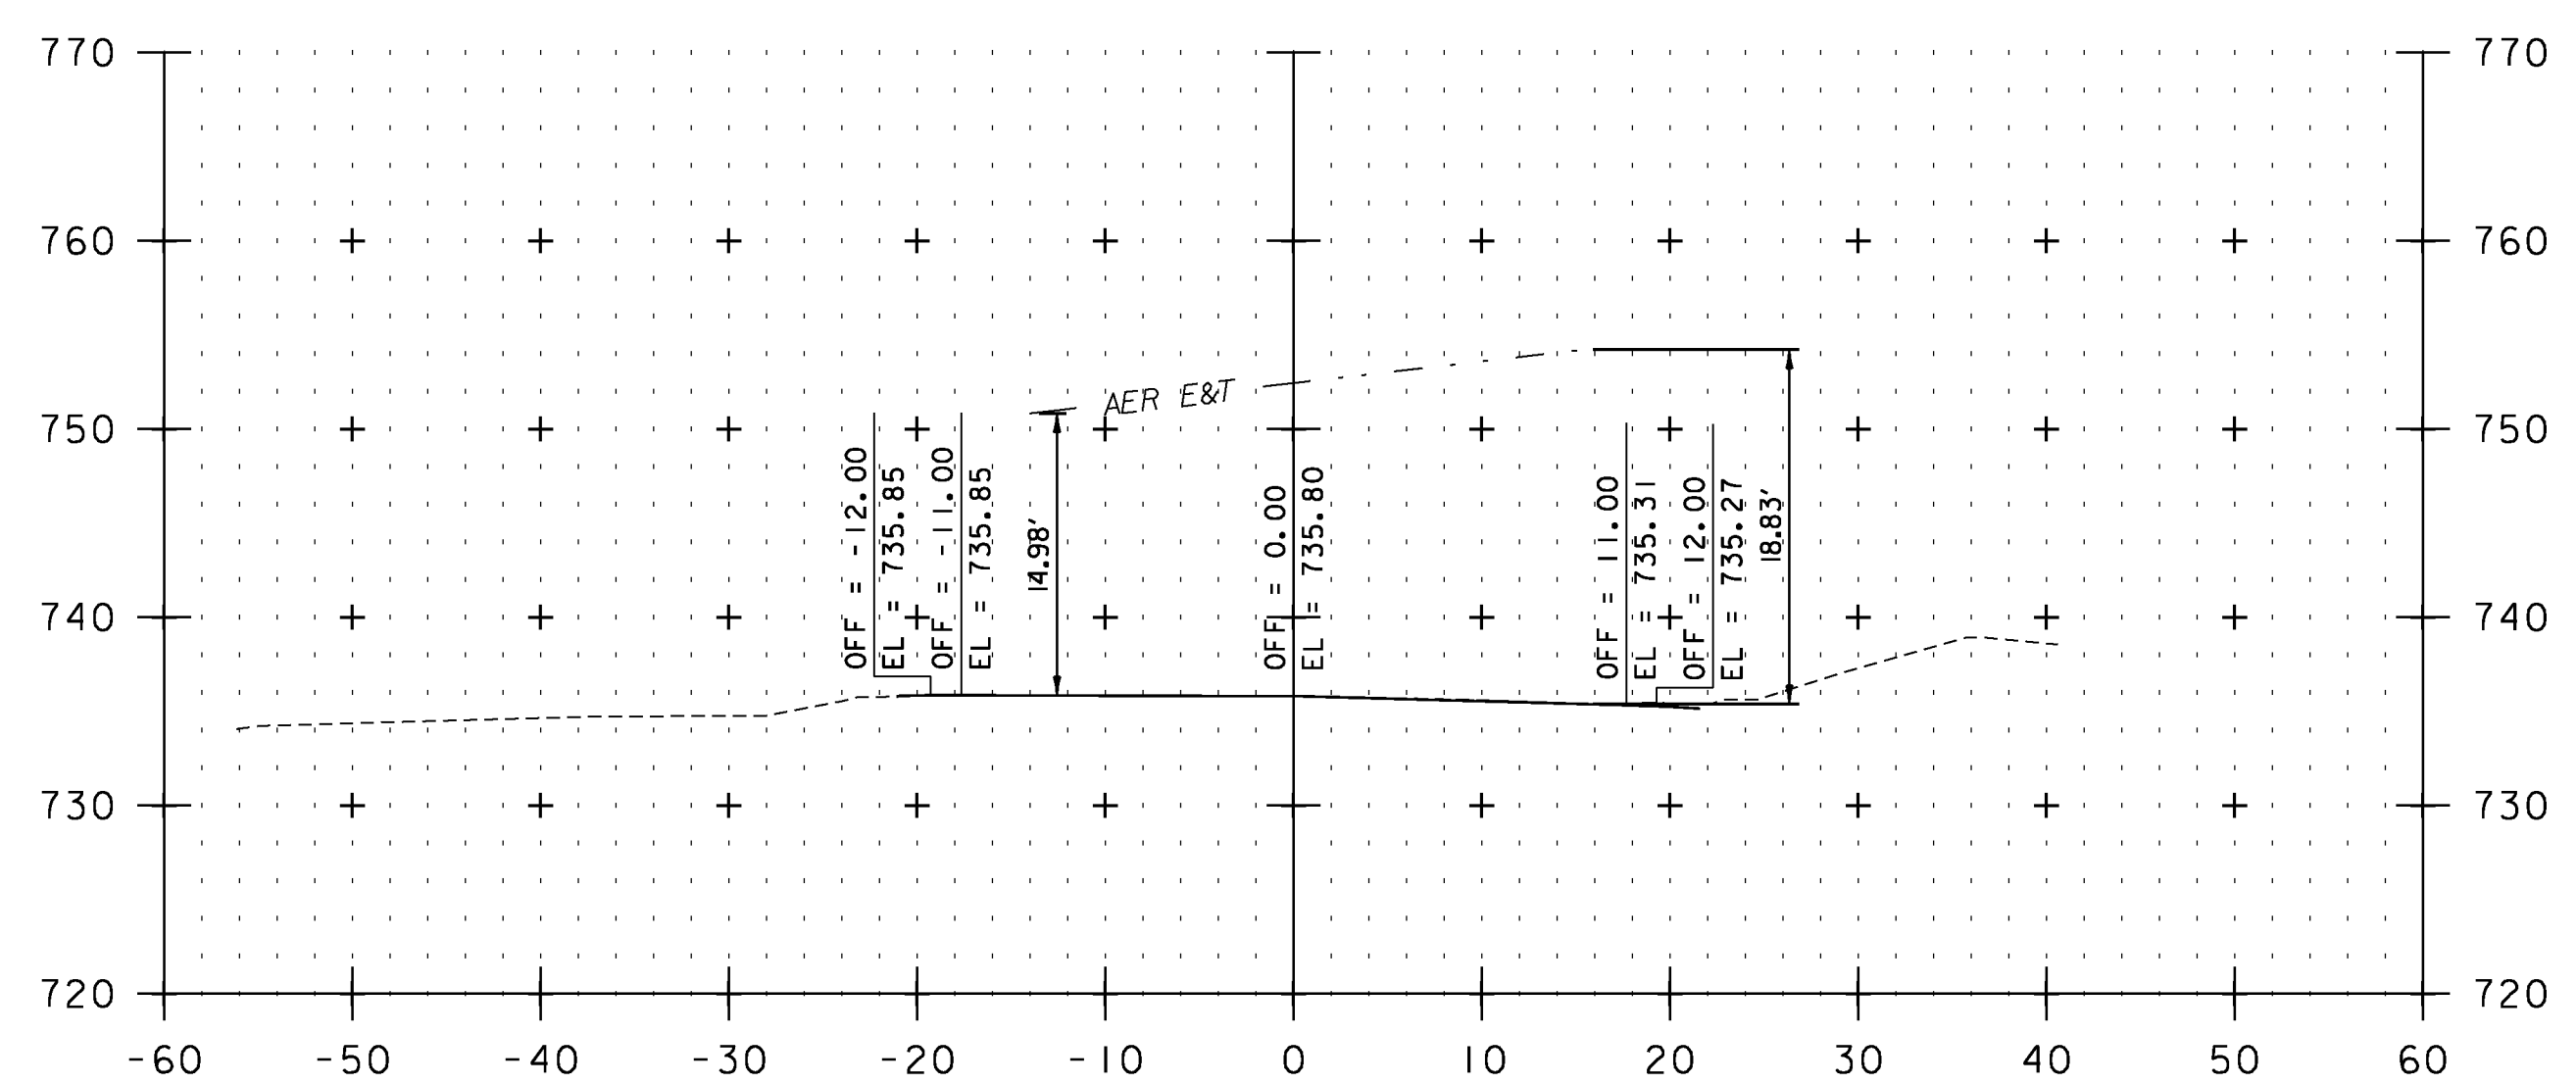

F 96+14

STA. F 93+00 TO STA. F 98+21

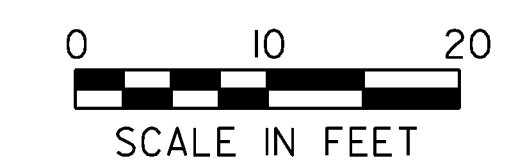

UTILITY CROSS SECTION SHEET 18	
PROJECT NAME: VERSHIRE-THETFORD	PROJECT NUMBER: STP 2911(I)
FILE NAME: pl0c224.dgn	PLOT DATE: 1/29/2013
PROJECT LEADER: PTS	DRAWN BY: JLS
DESIGNED BY: NLL	CHECKED BY: PTS
IPARM FILE NAME: IOC224_222	SHEET 222 OF 232