




F 100+87

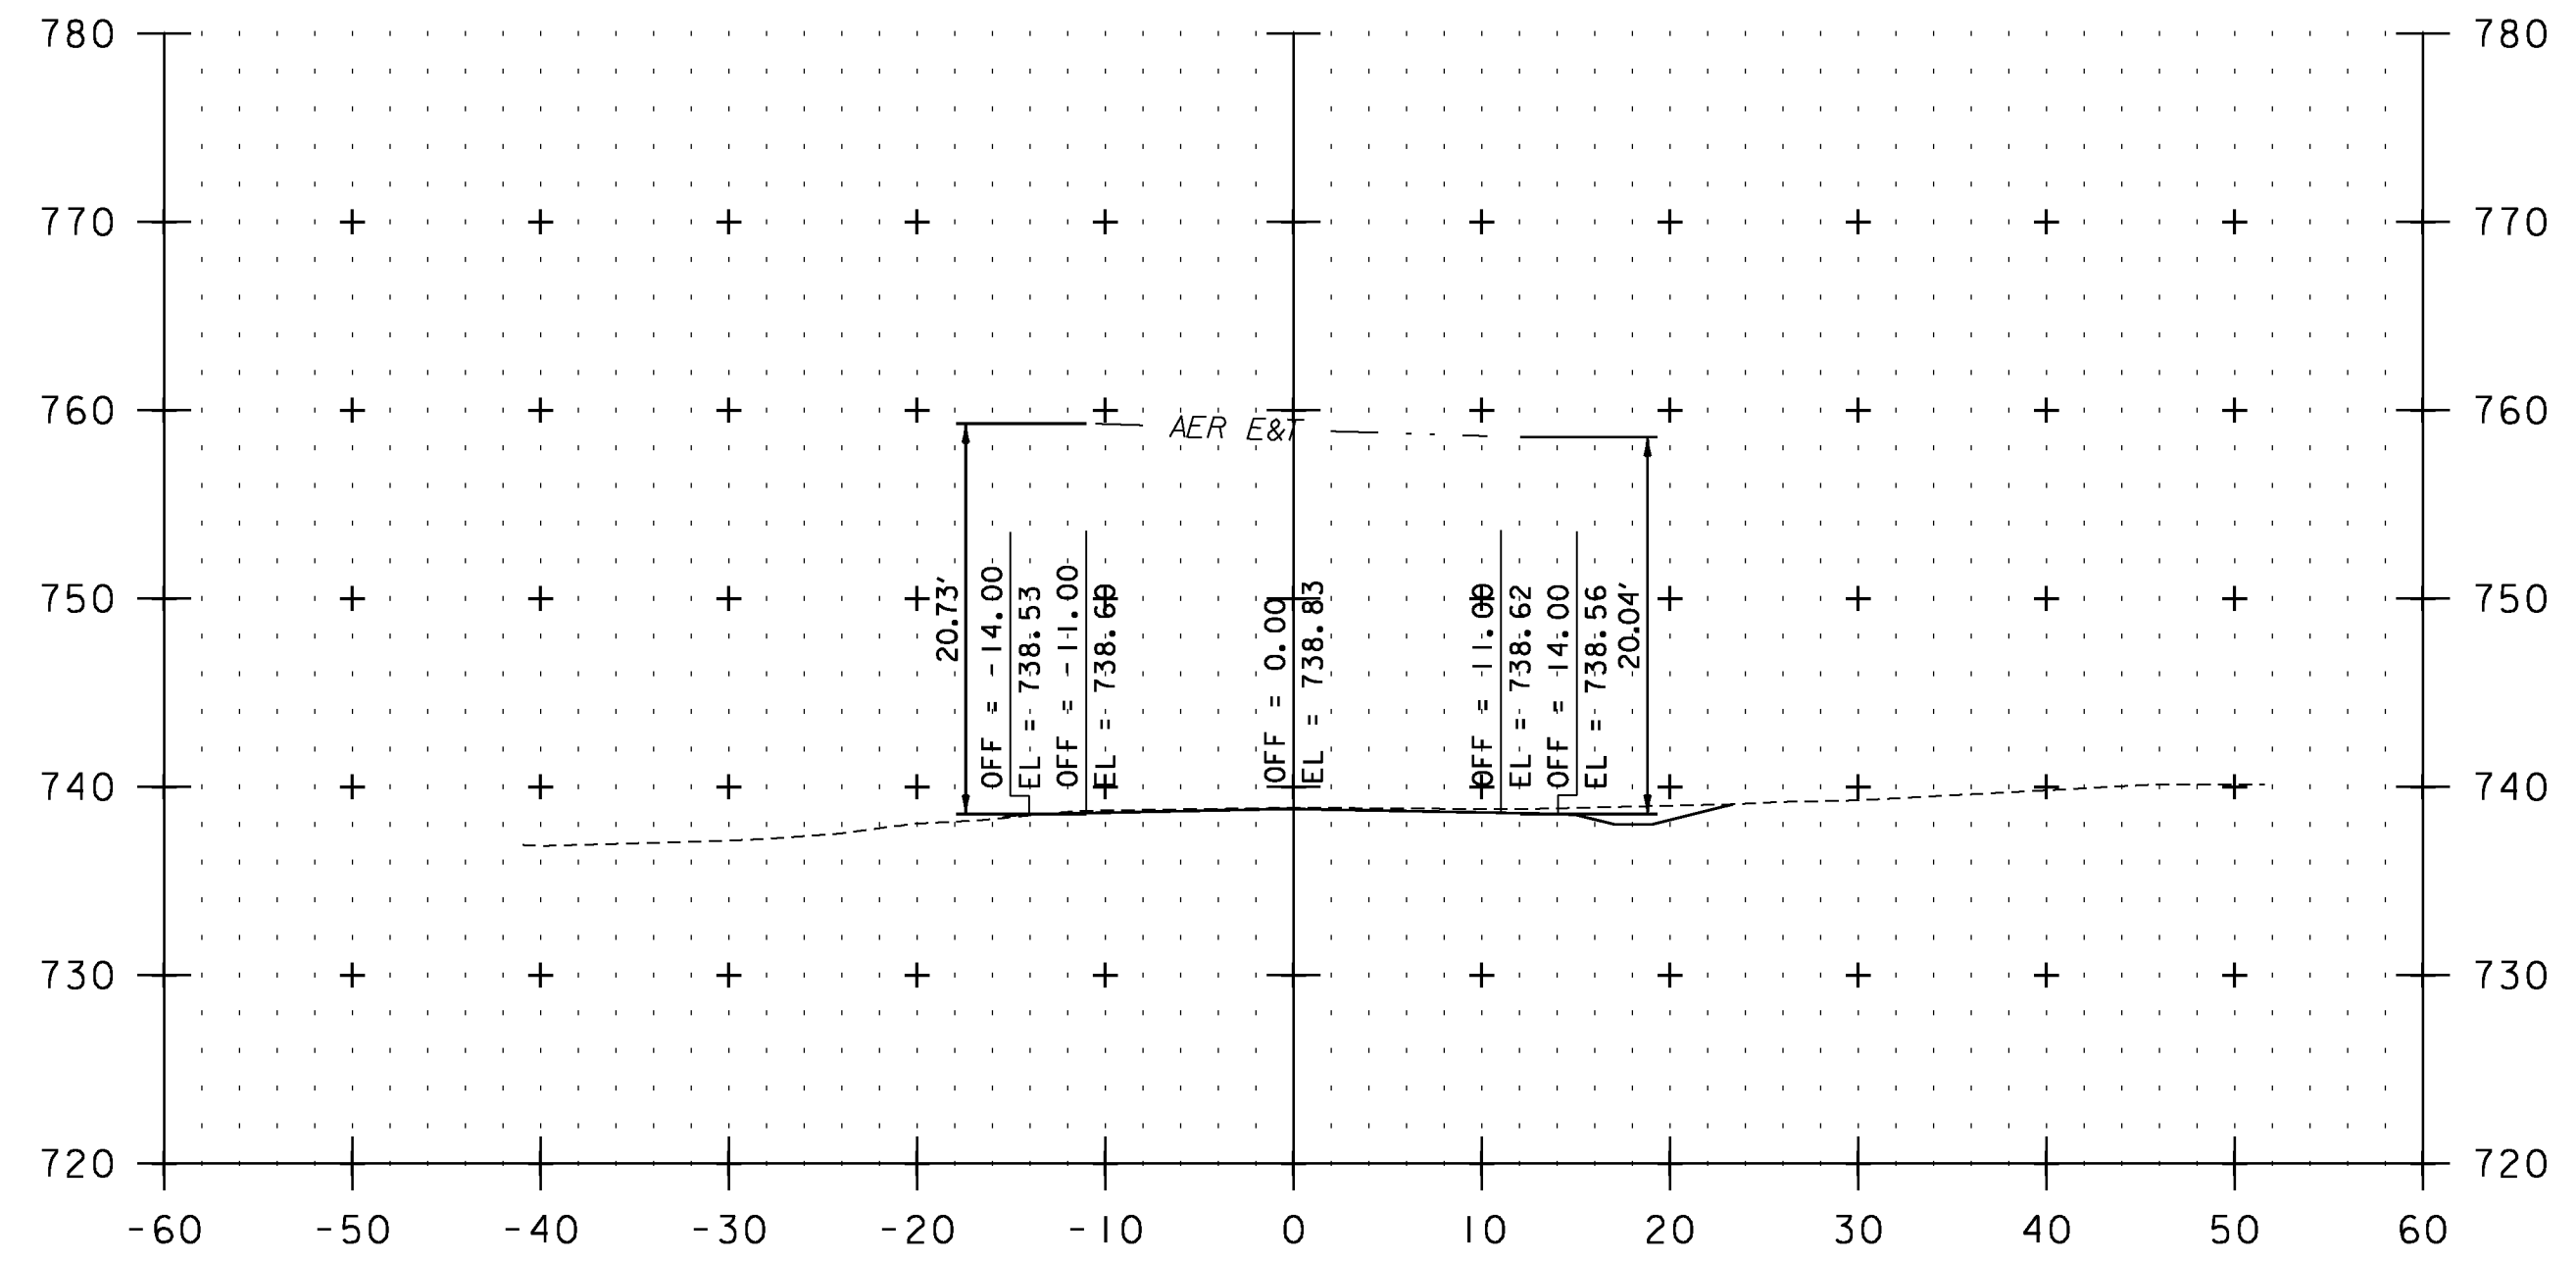

F 103+24

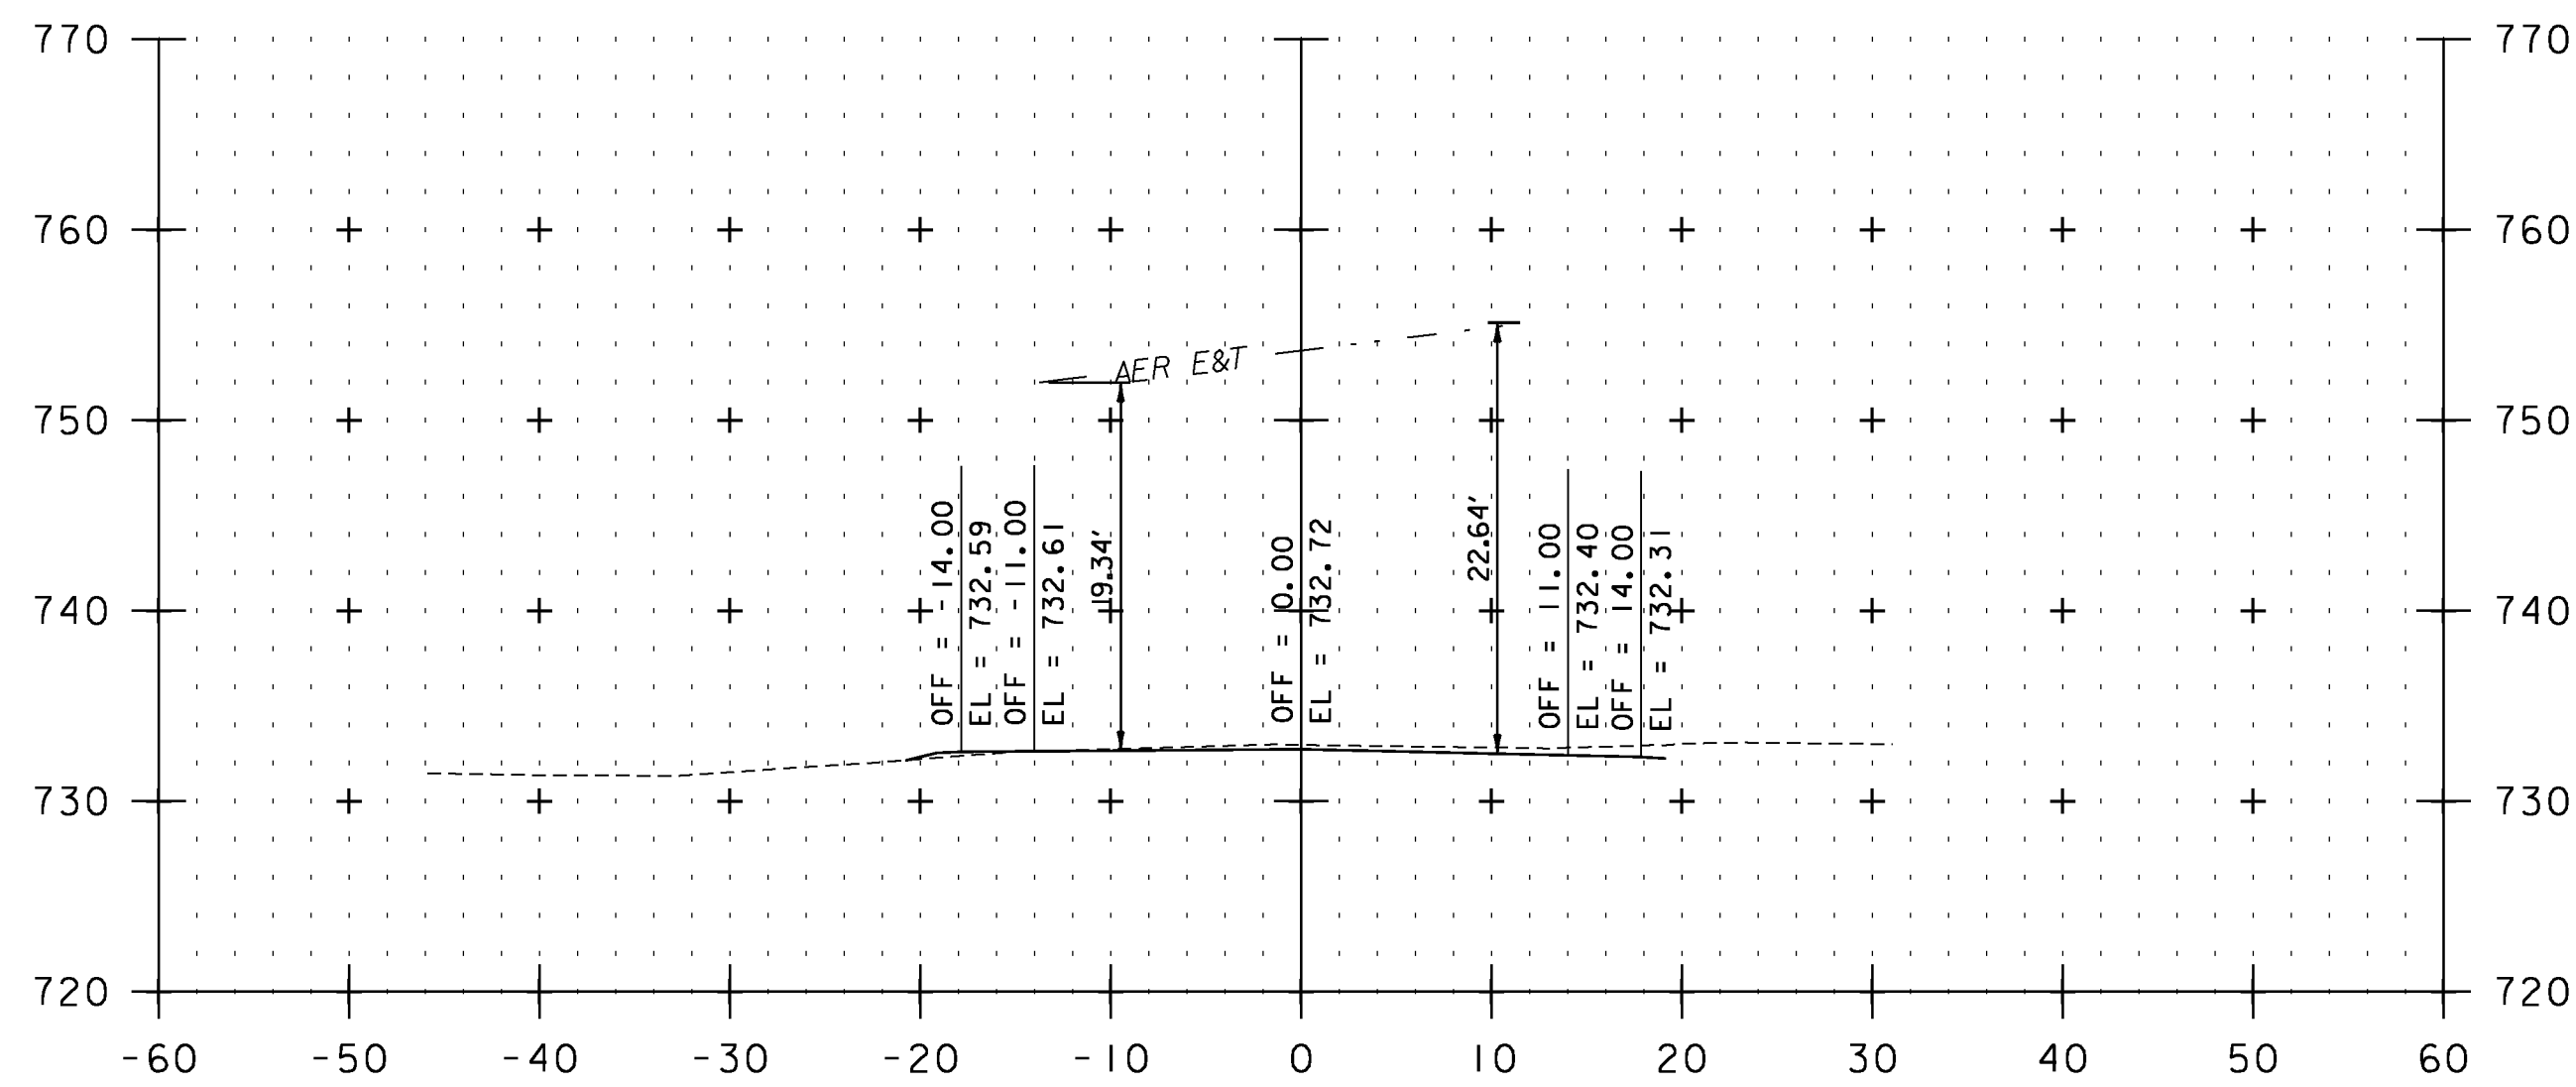


F 100+31

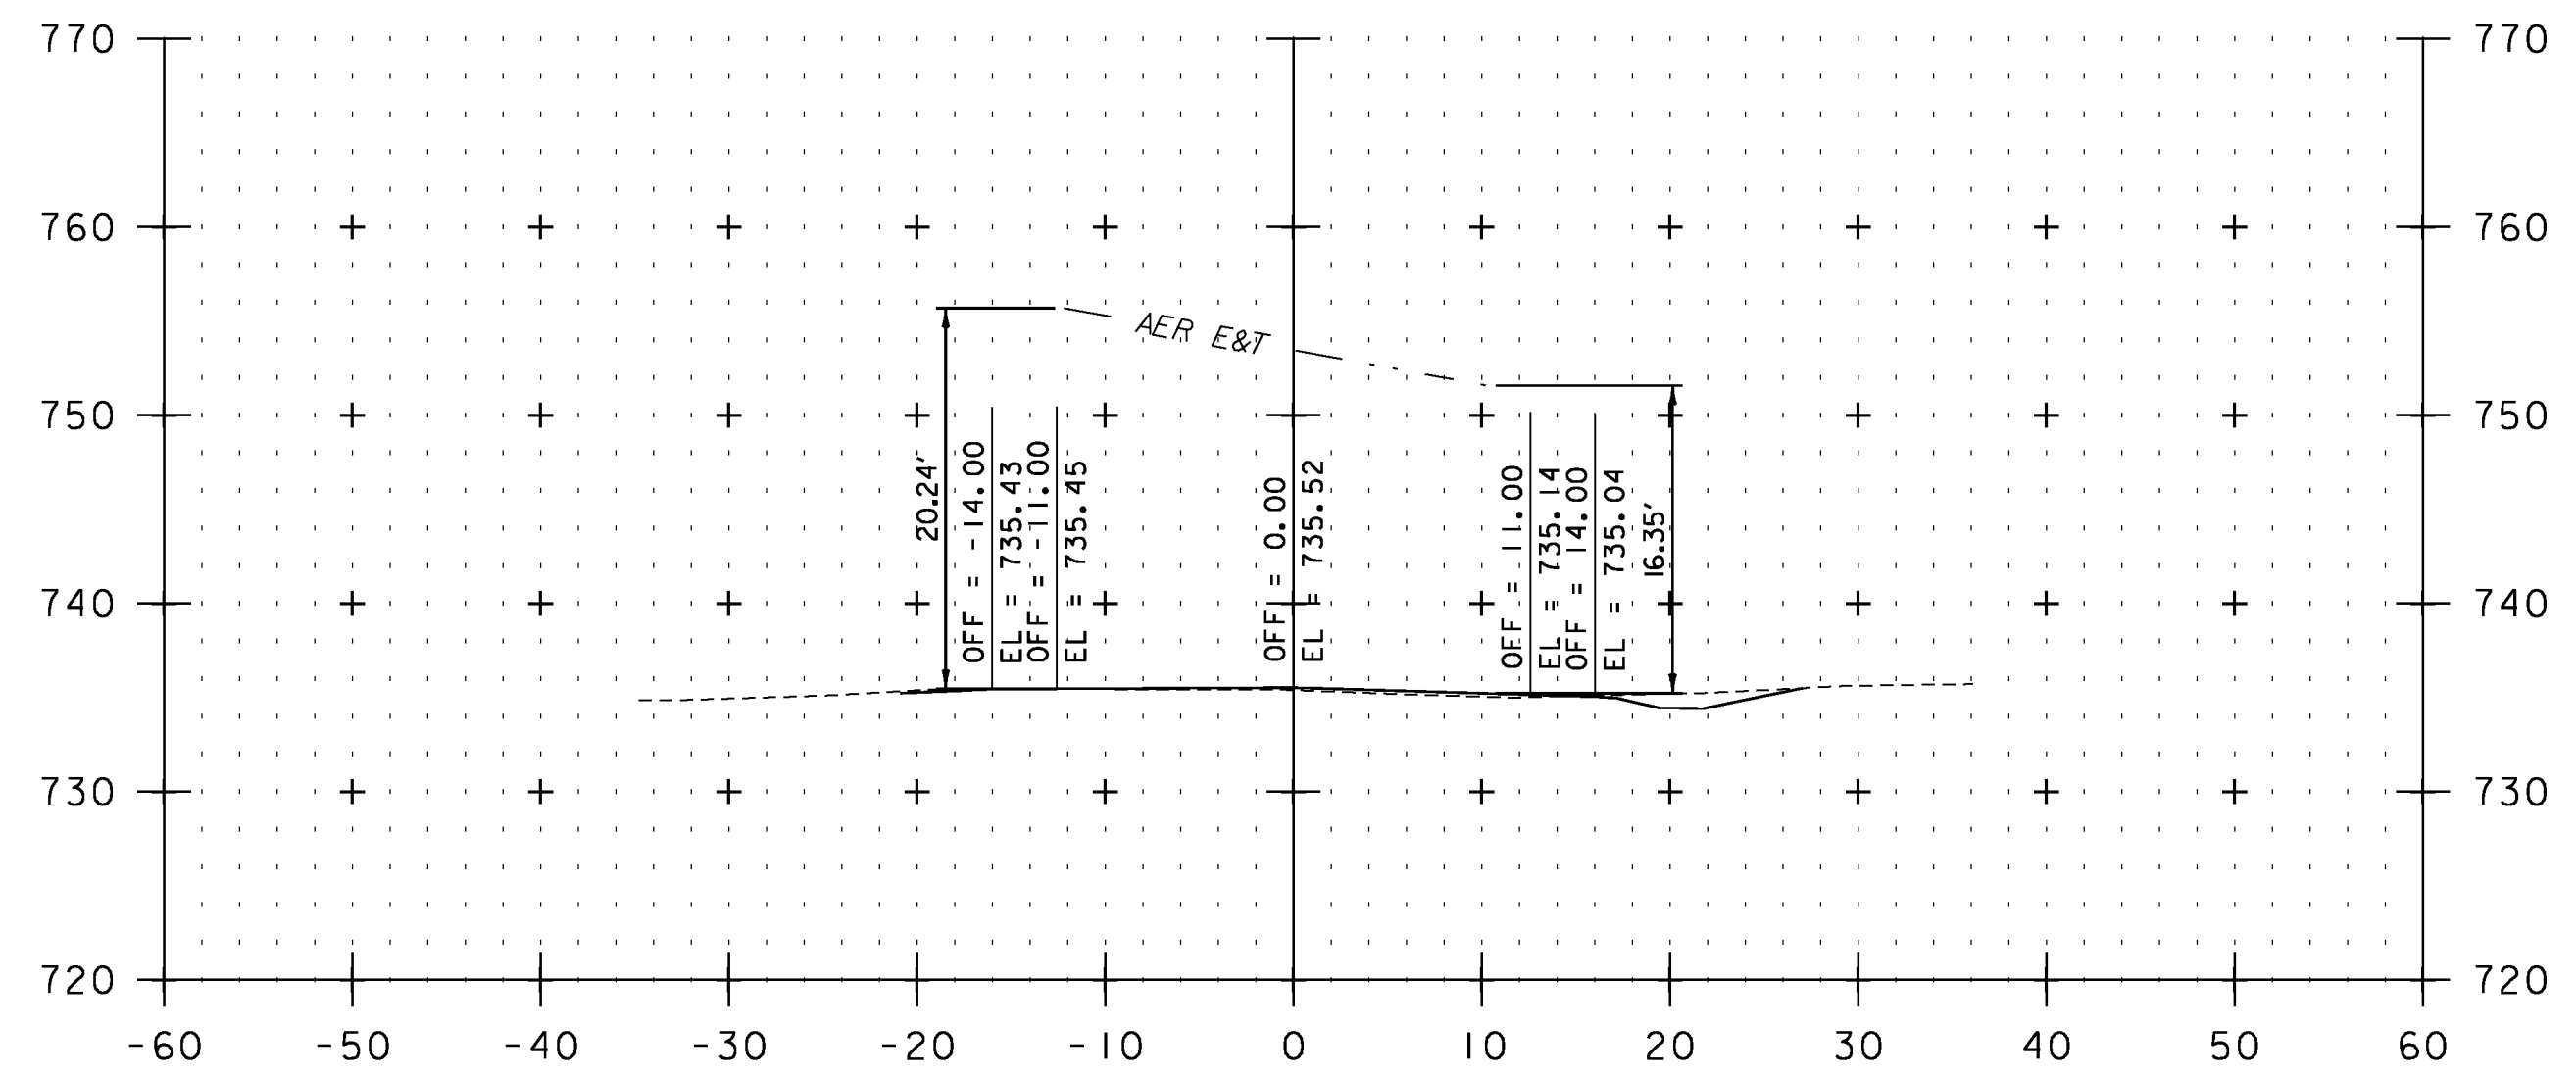

F 101+76

STA. F 100+31 TO STA. F 103+24

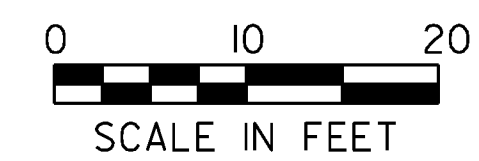

**UTILITY CROSS SECTION SHEET 19**

PROJECT NAME: VERSHIRE-THETFORD

PROJECT NUMBER: STP 2911(I)

FILE NAME: pl0c224.dgn

PLOT DATE: 1/29/2013

PROJECT LEADER: PTS

DRAWN BY: JLS

DESIGNED BY: NLL

CHECKED BY: PTS

IPARM FILE NAME: IOC224\_223

SHEET 223 OF 232