




F 104+63

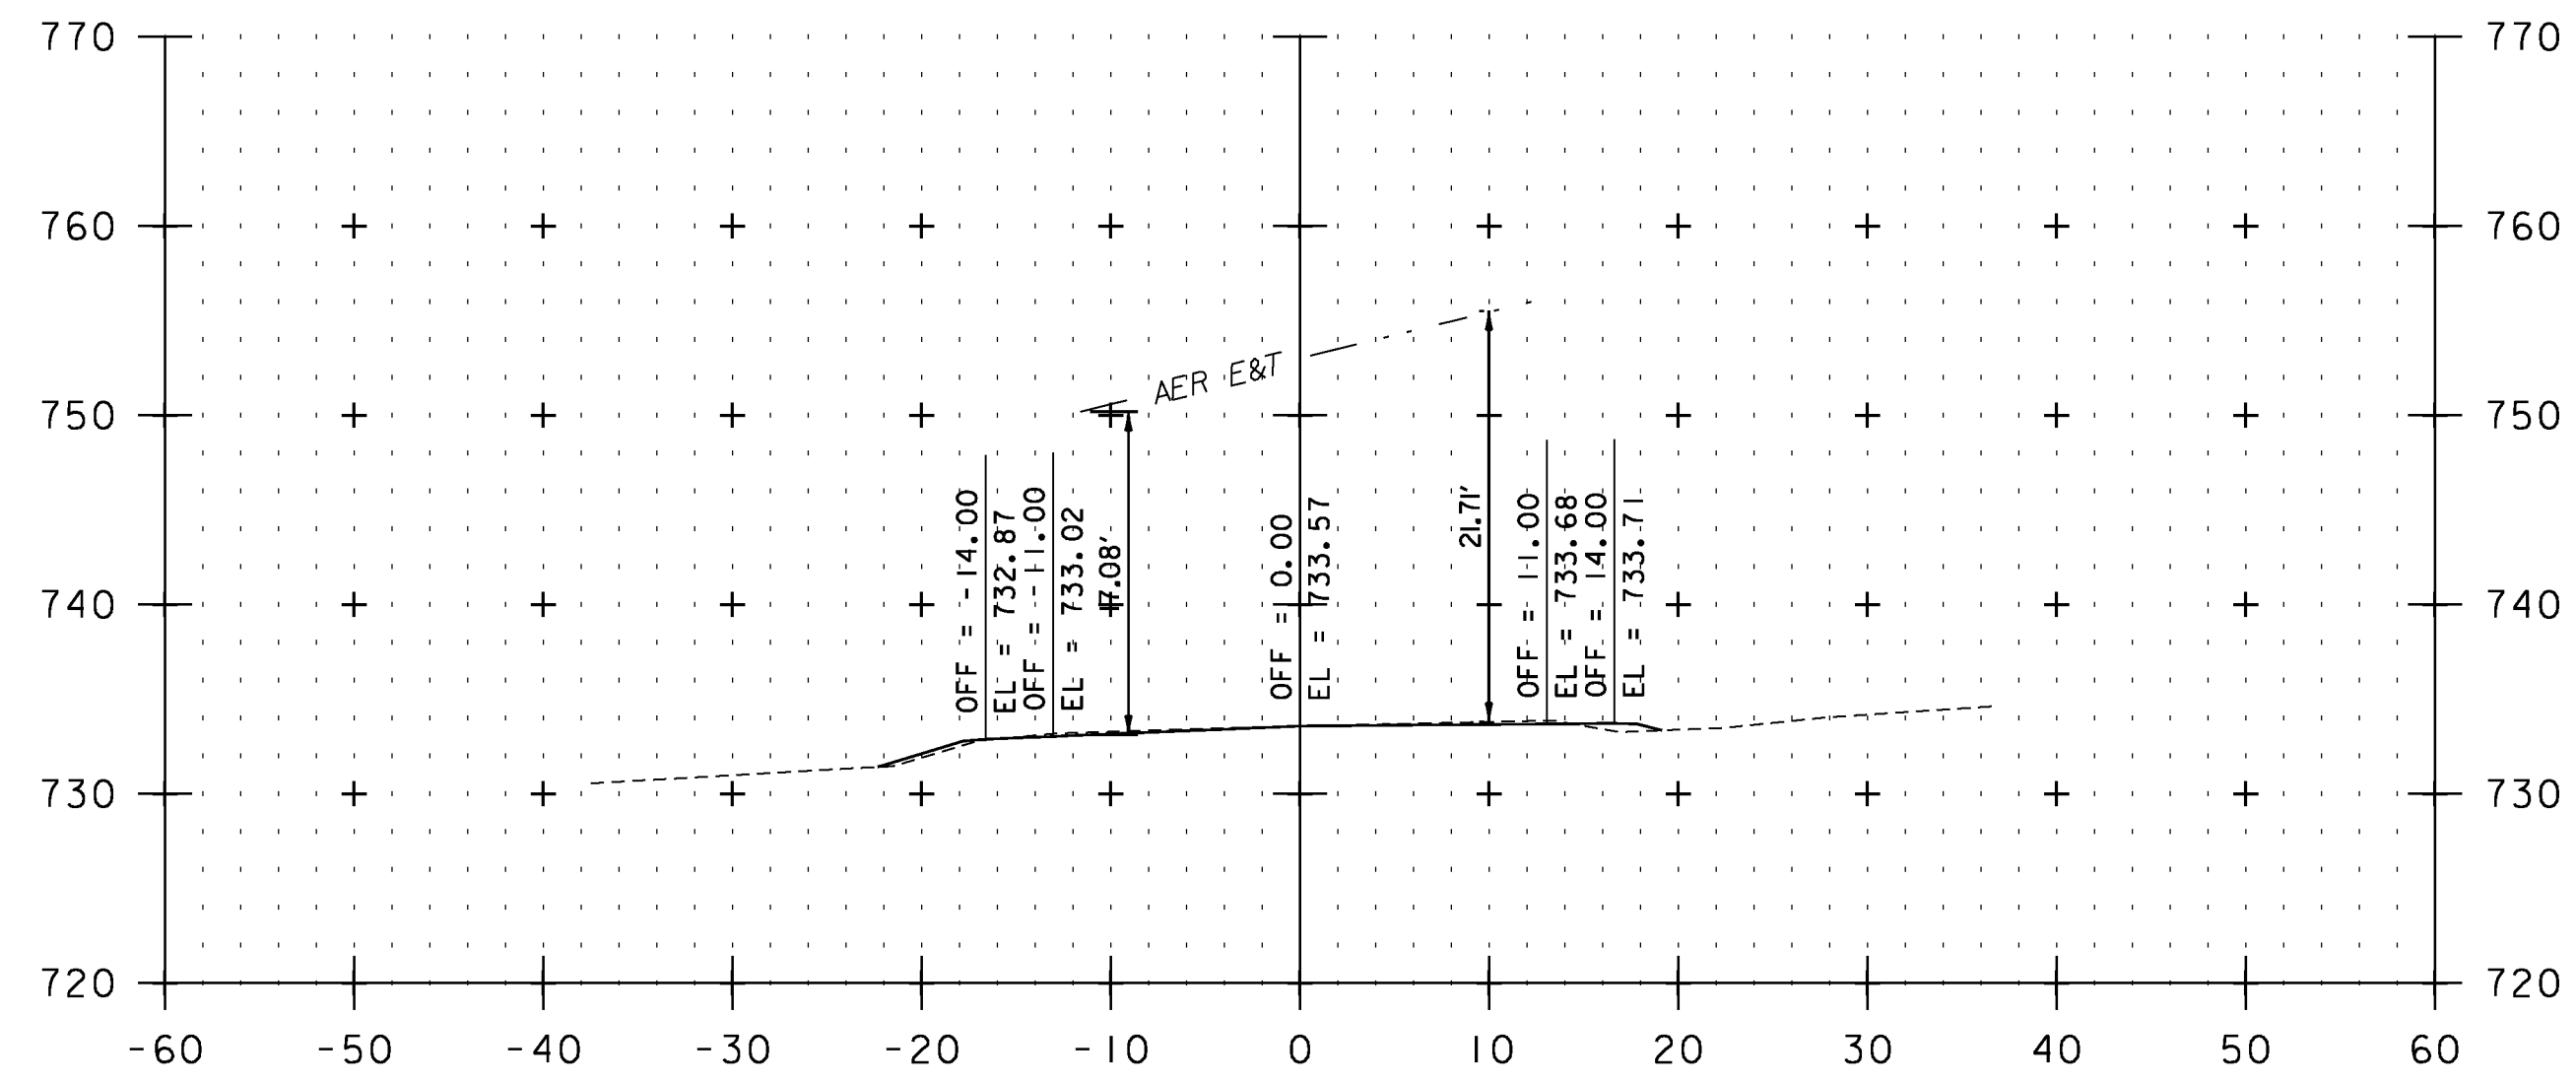

F 106+08

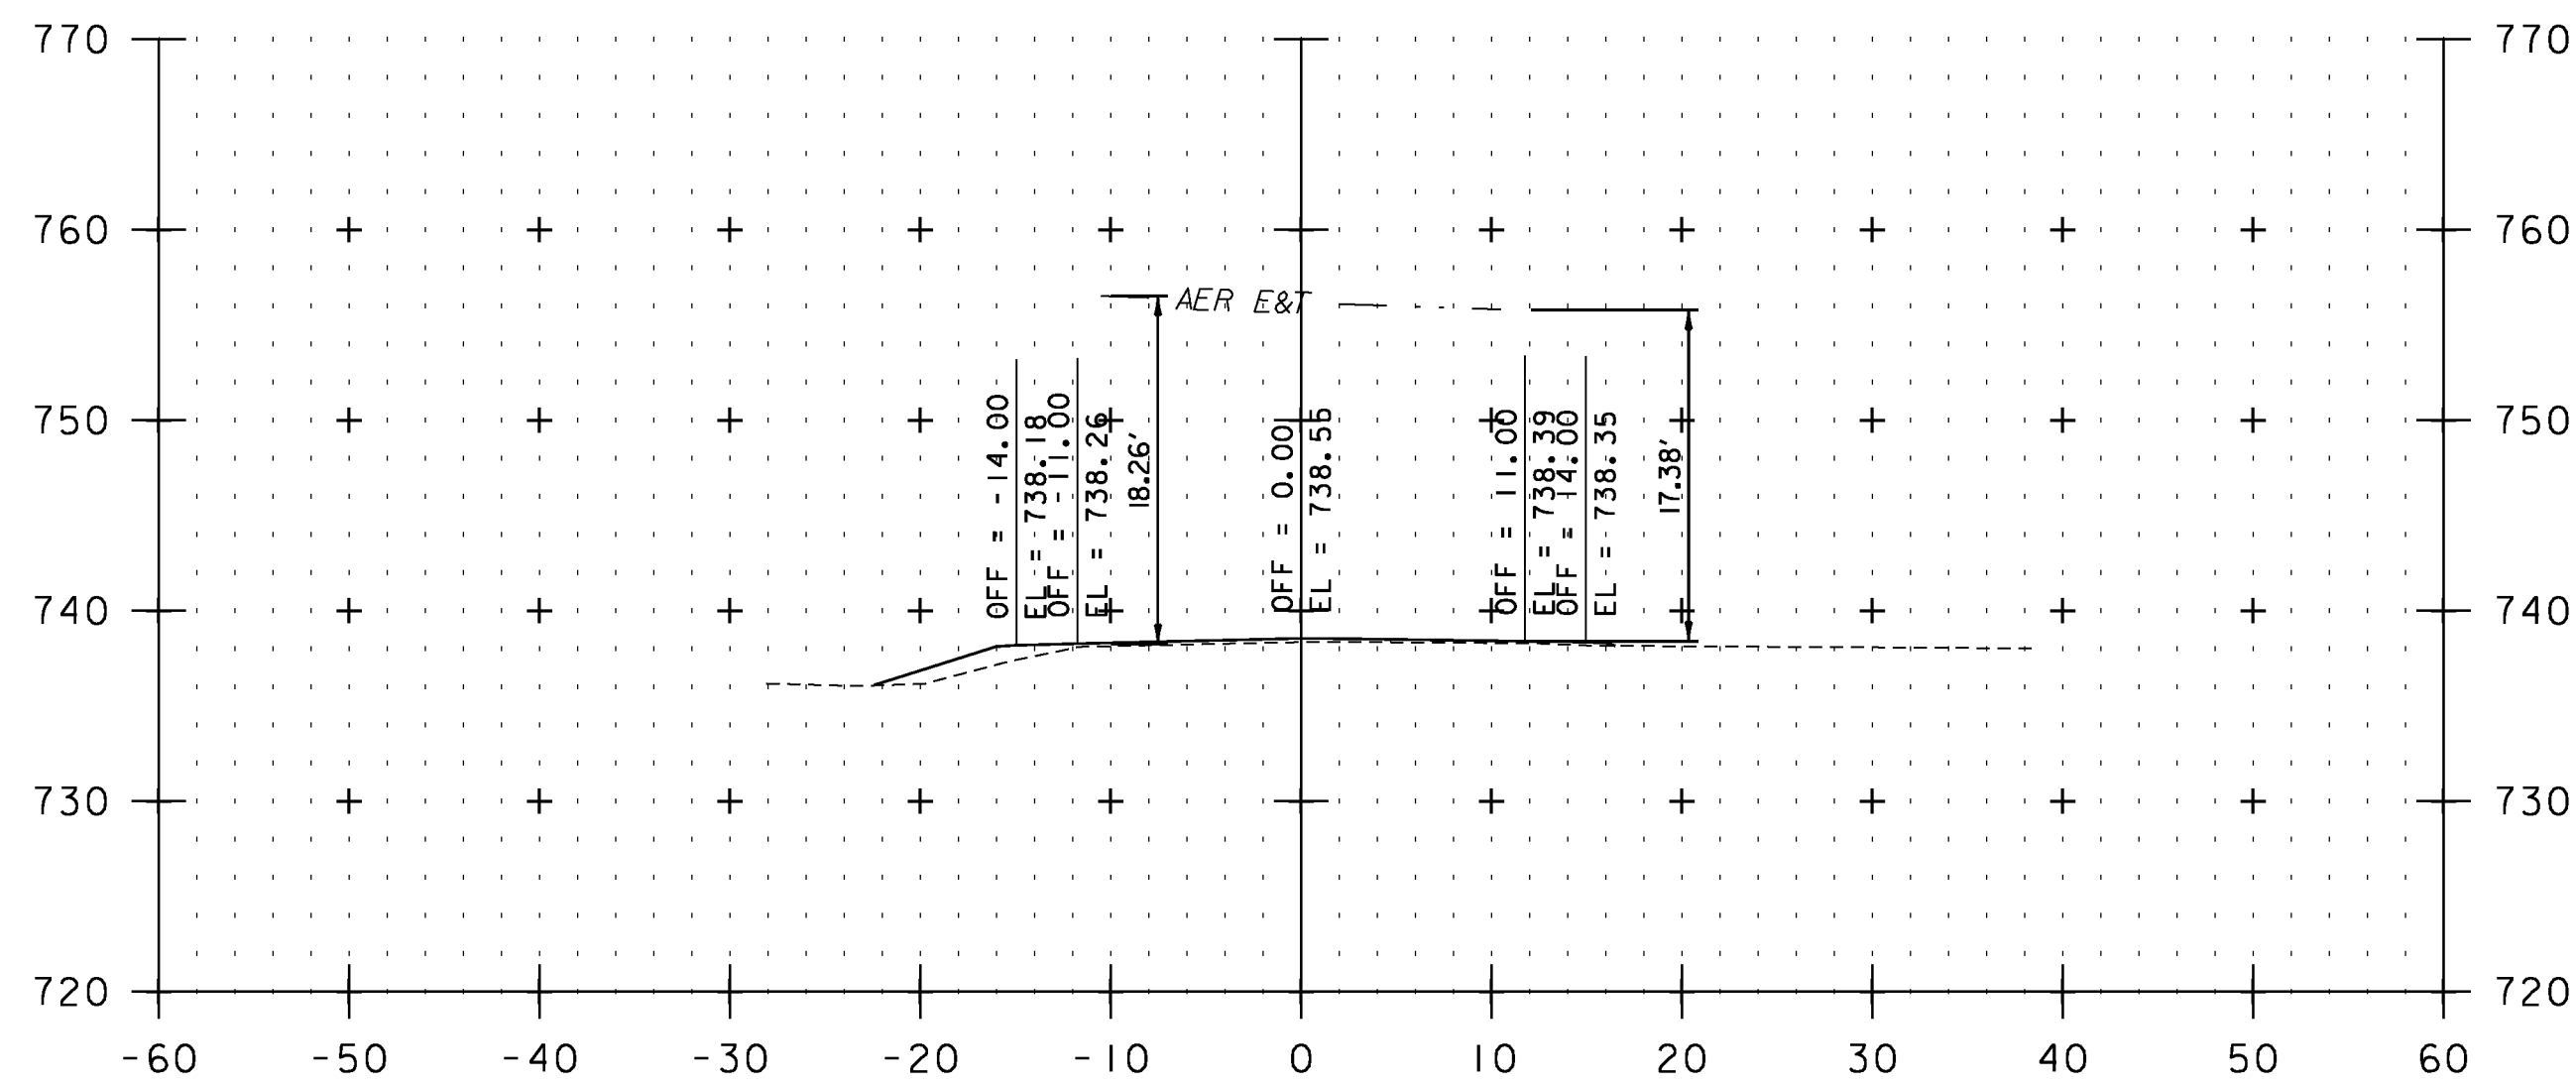

F 104+54

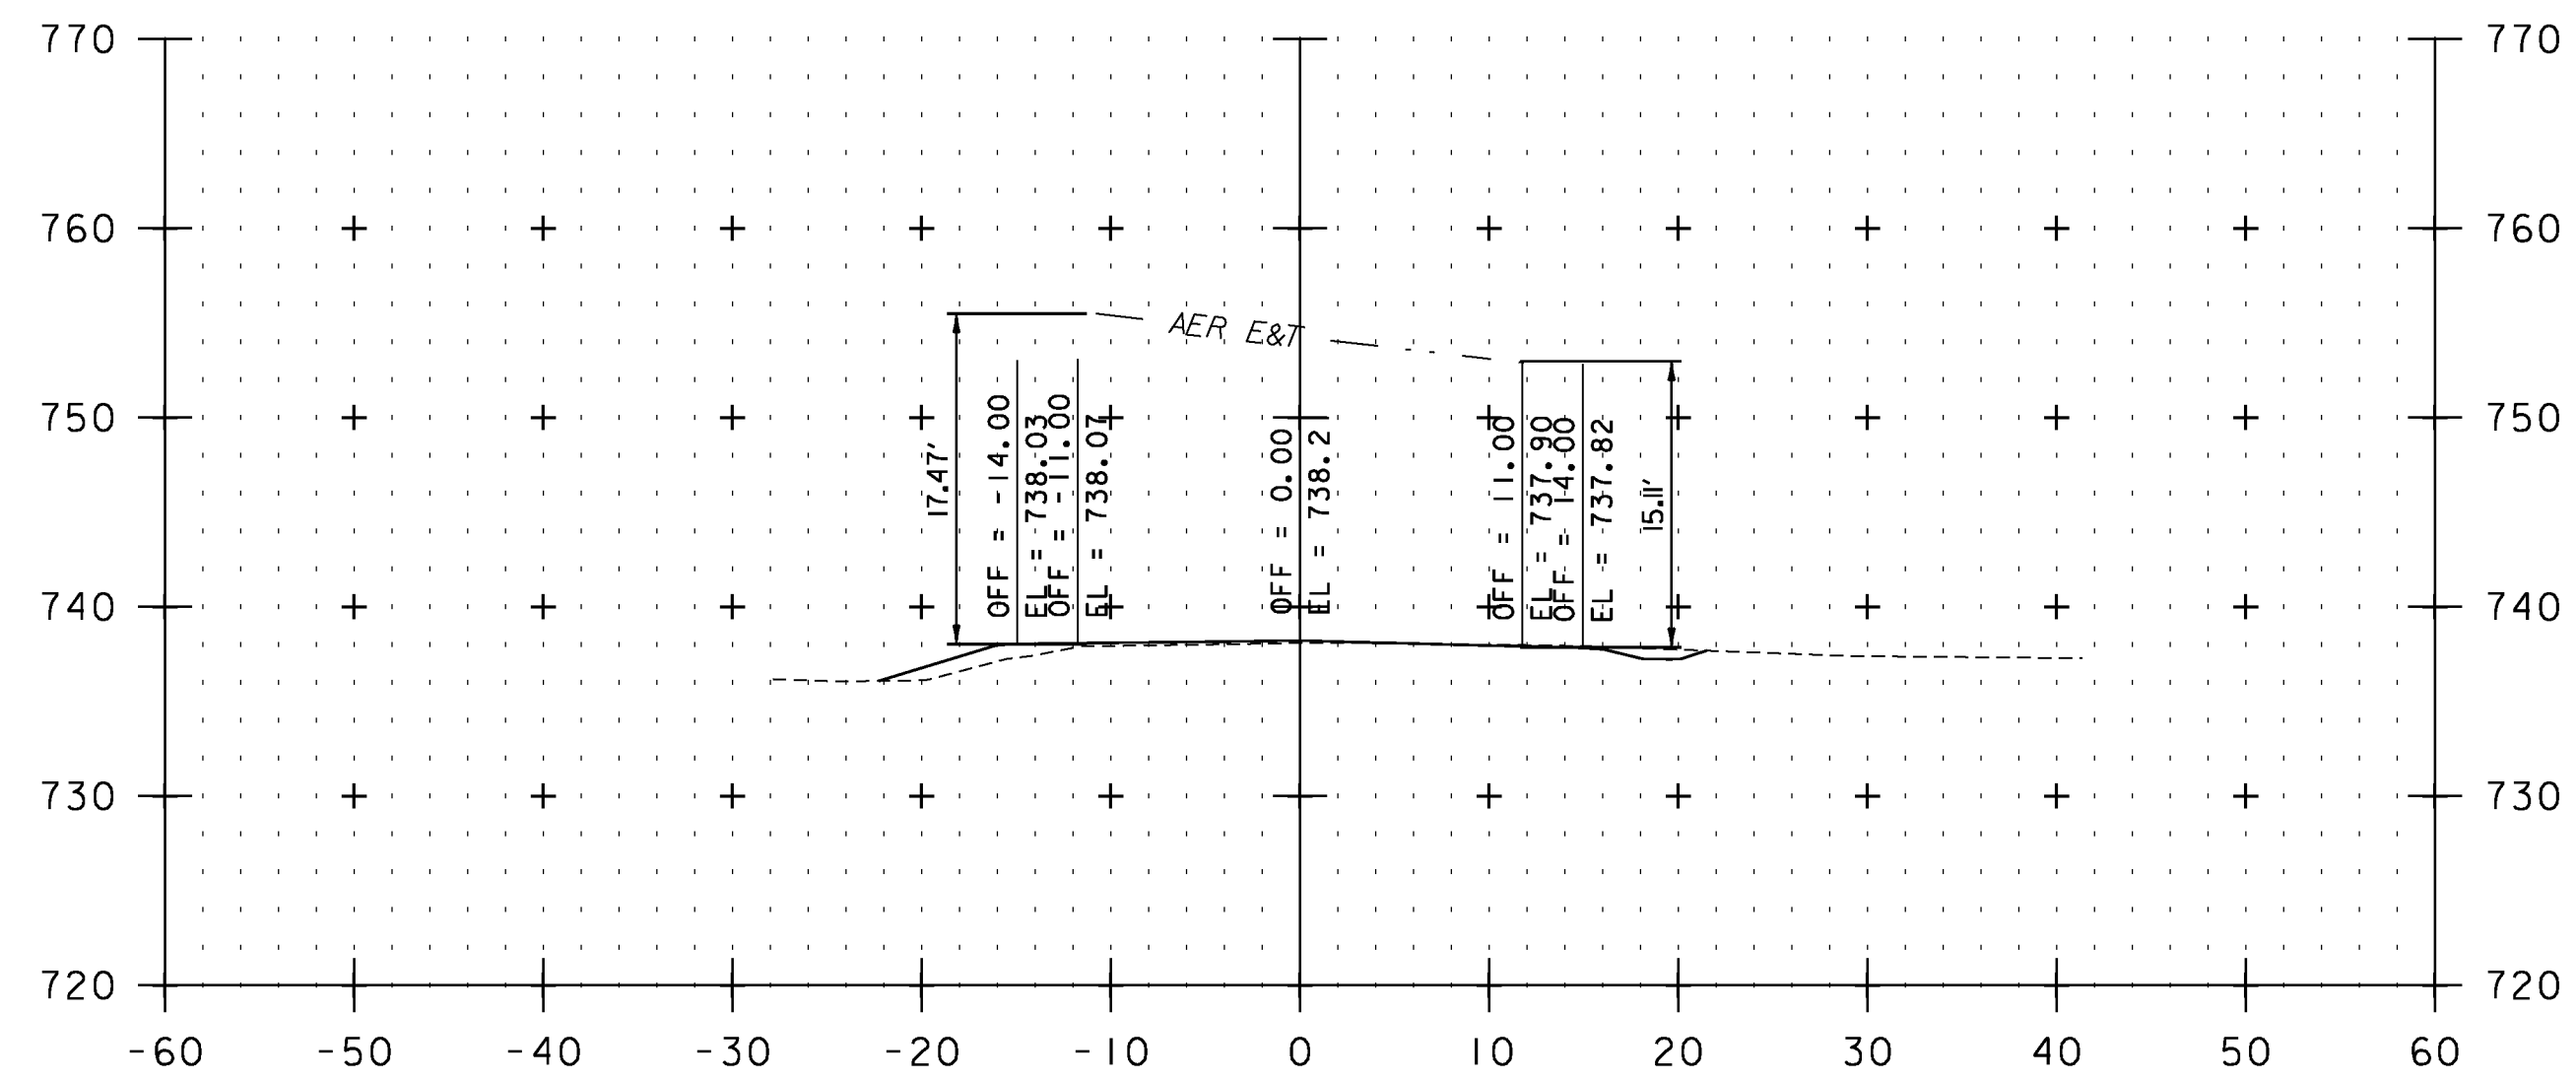

F 104+73

STA. F 104+54 TO STA. F 106+08



UTILITY CROSS SECTION SHEET 20

PROJECT NAME: VERSHIRE-THETFORD

PROJECT NUMBER: STP 2911(I)

FILE NAME: pl0c224.dgn

PLOT DATE: 1/29/2013

PROJECT LEADER: PTS

DRAWN BY: JLS

DESIGNED BY: NLL

CHECKED BY: PTS

IPARM FILE NAME: IOC224_224

SHEET 224 OF 232