




F 111+22

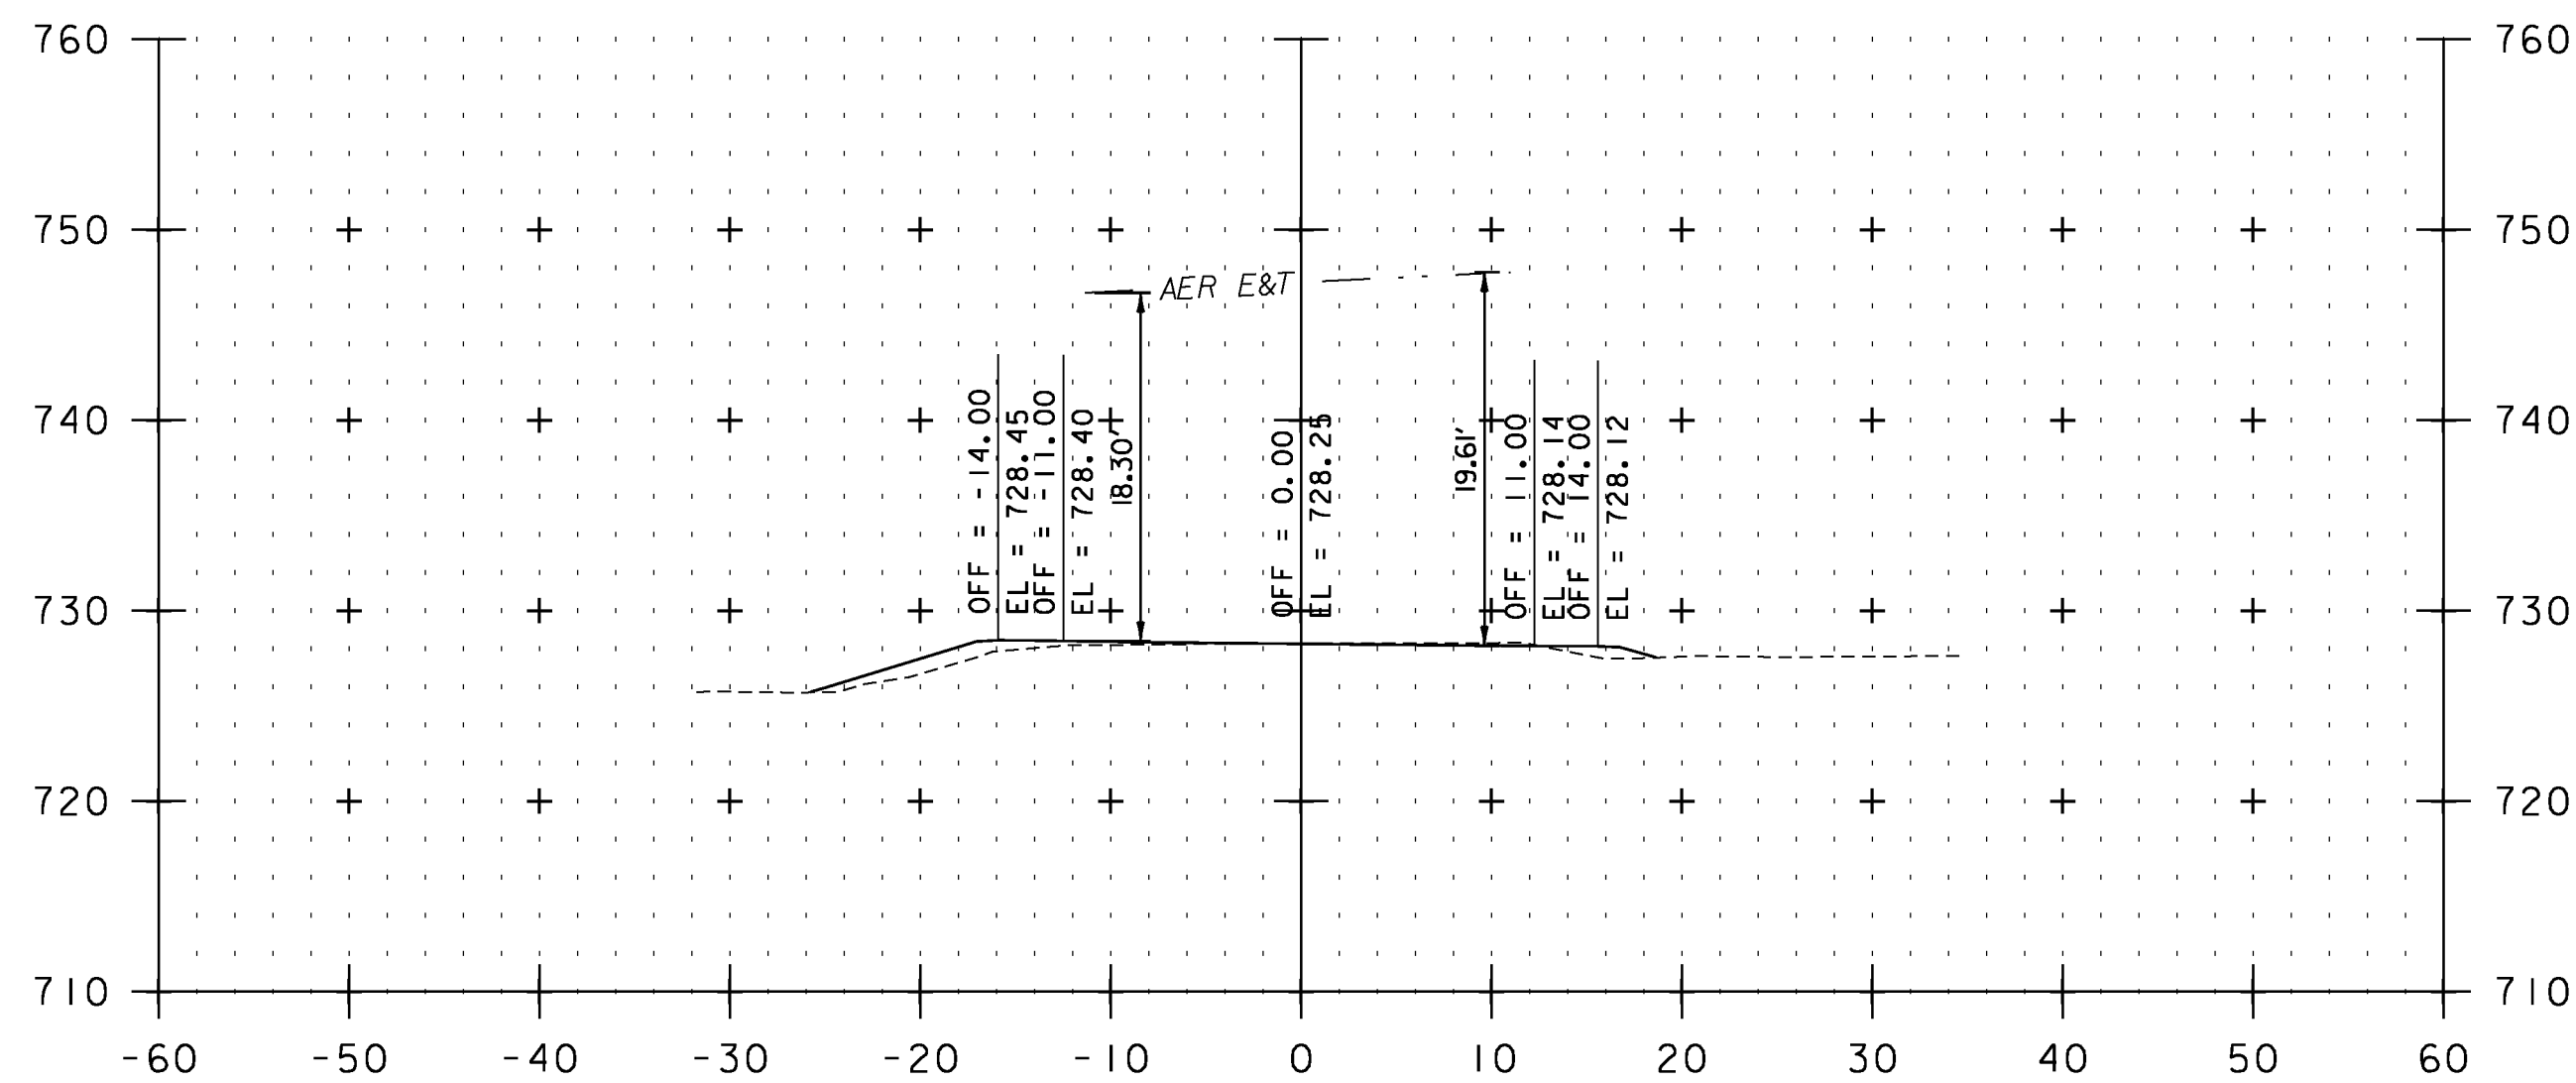

F 107+53

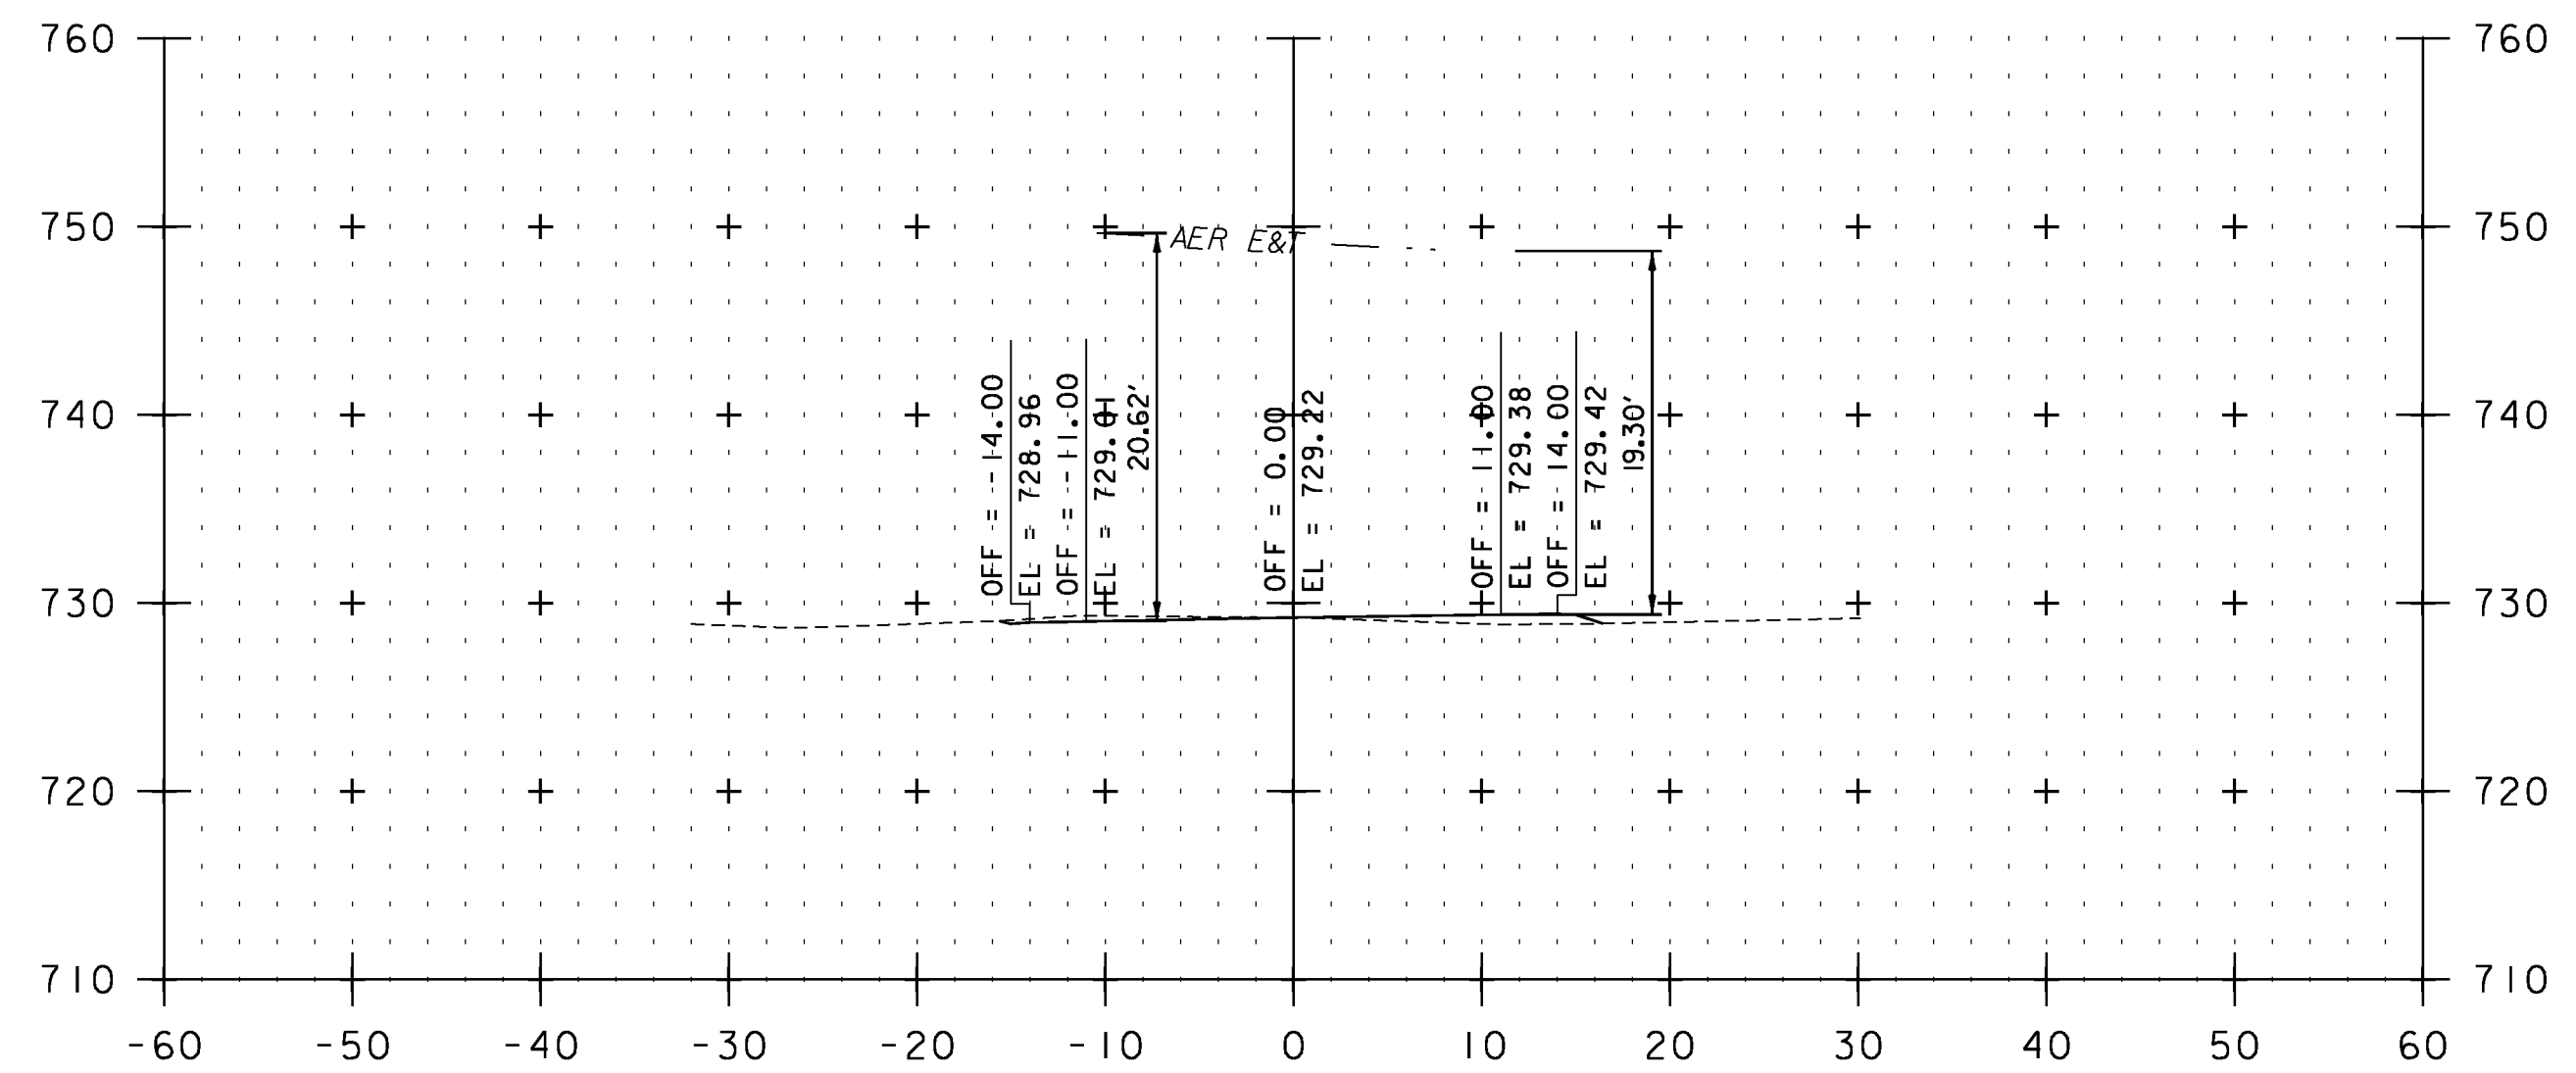

F 115+20

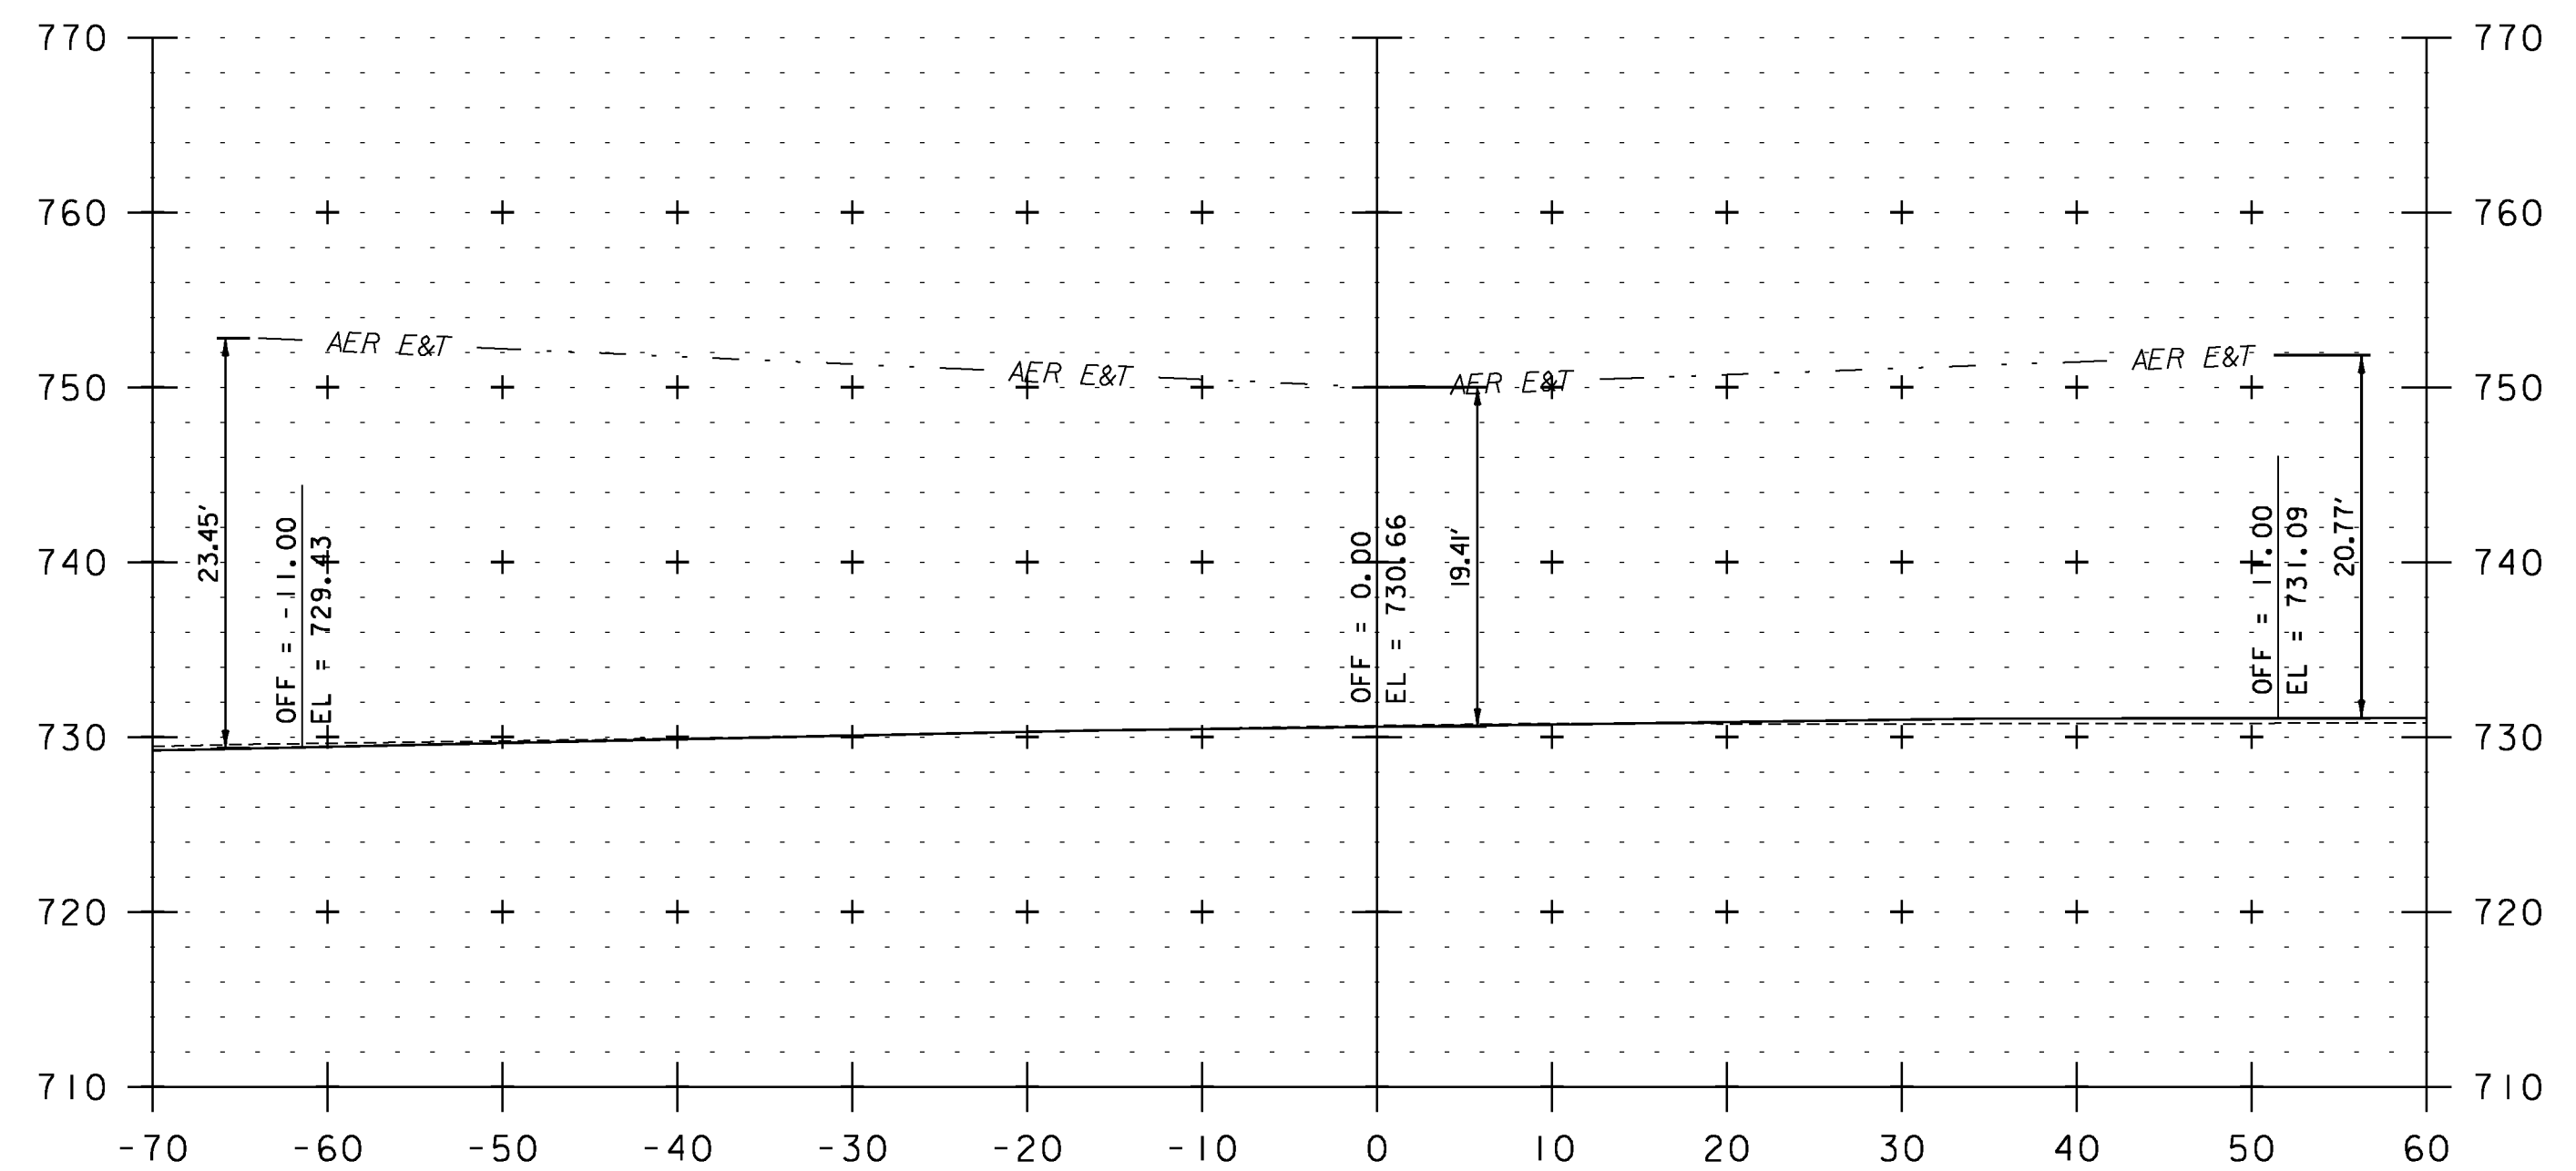

F 114+34

UTILITY CROSS SECTION SHEET 21

PROJECT NAME: VERSHIRE-THETFORD

PROJECT NUMBER: STP 2911(I)

FILE NAME: pl0c224.dgn

PLOT DATE: 1/29/2013

PROJECT LEADER: PTS

DRAWN BY: JLS

DESIGNED BY: NLL

CHECKED BY: PTS

IPARM FILE NAME: IOC224_225

SHEET 225 OF 232

STA. F 107+53 TO STA. F 115+20

