




F 147+37

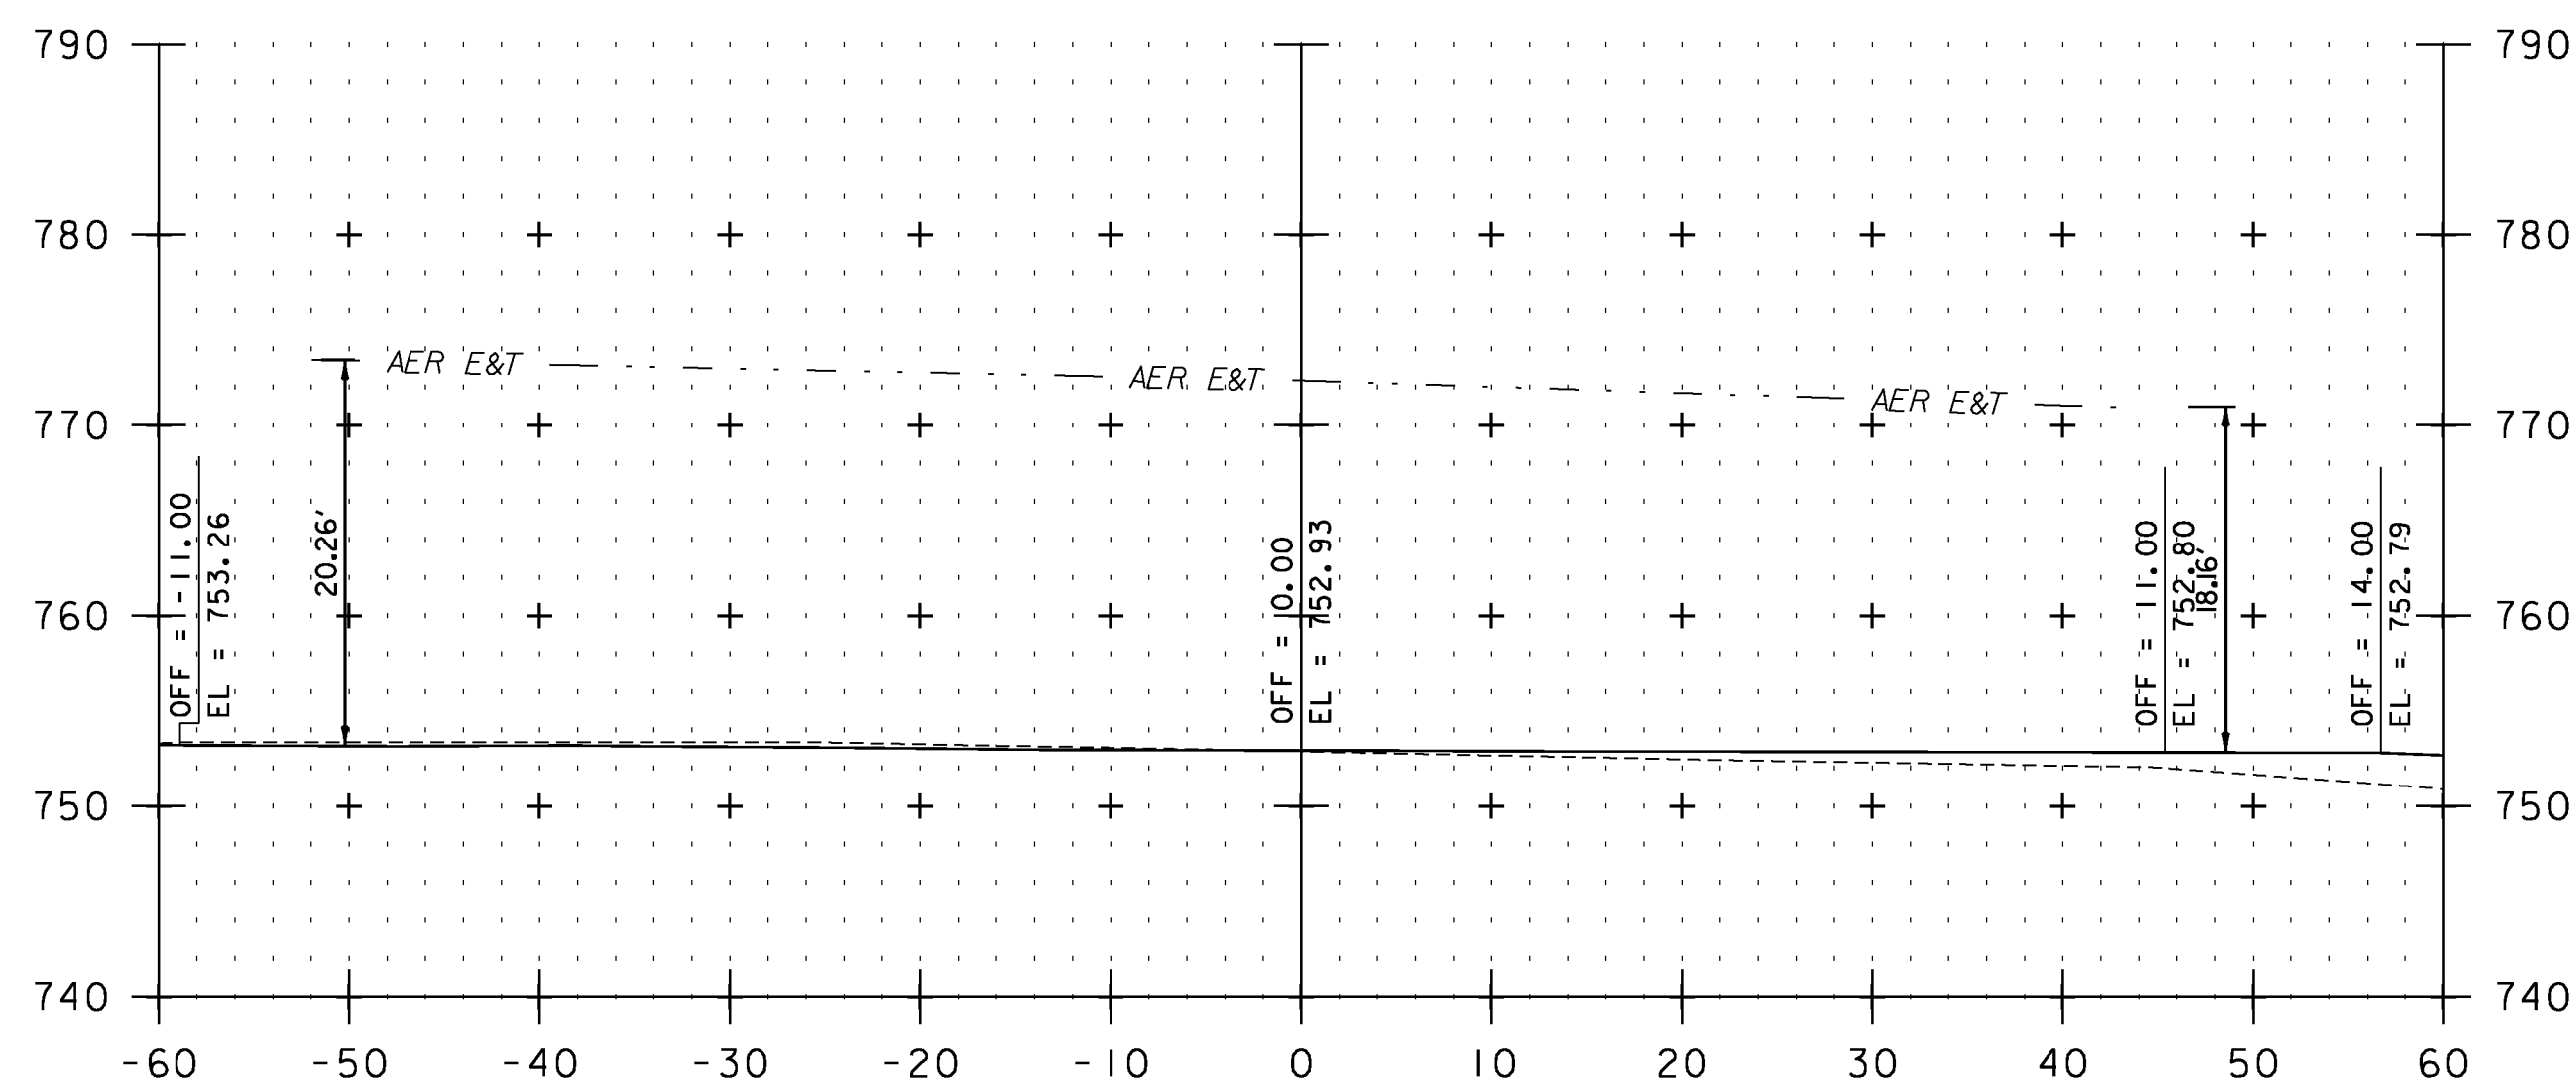

F 137+88

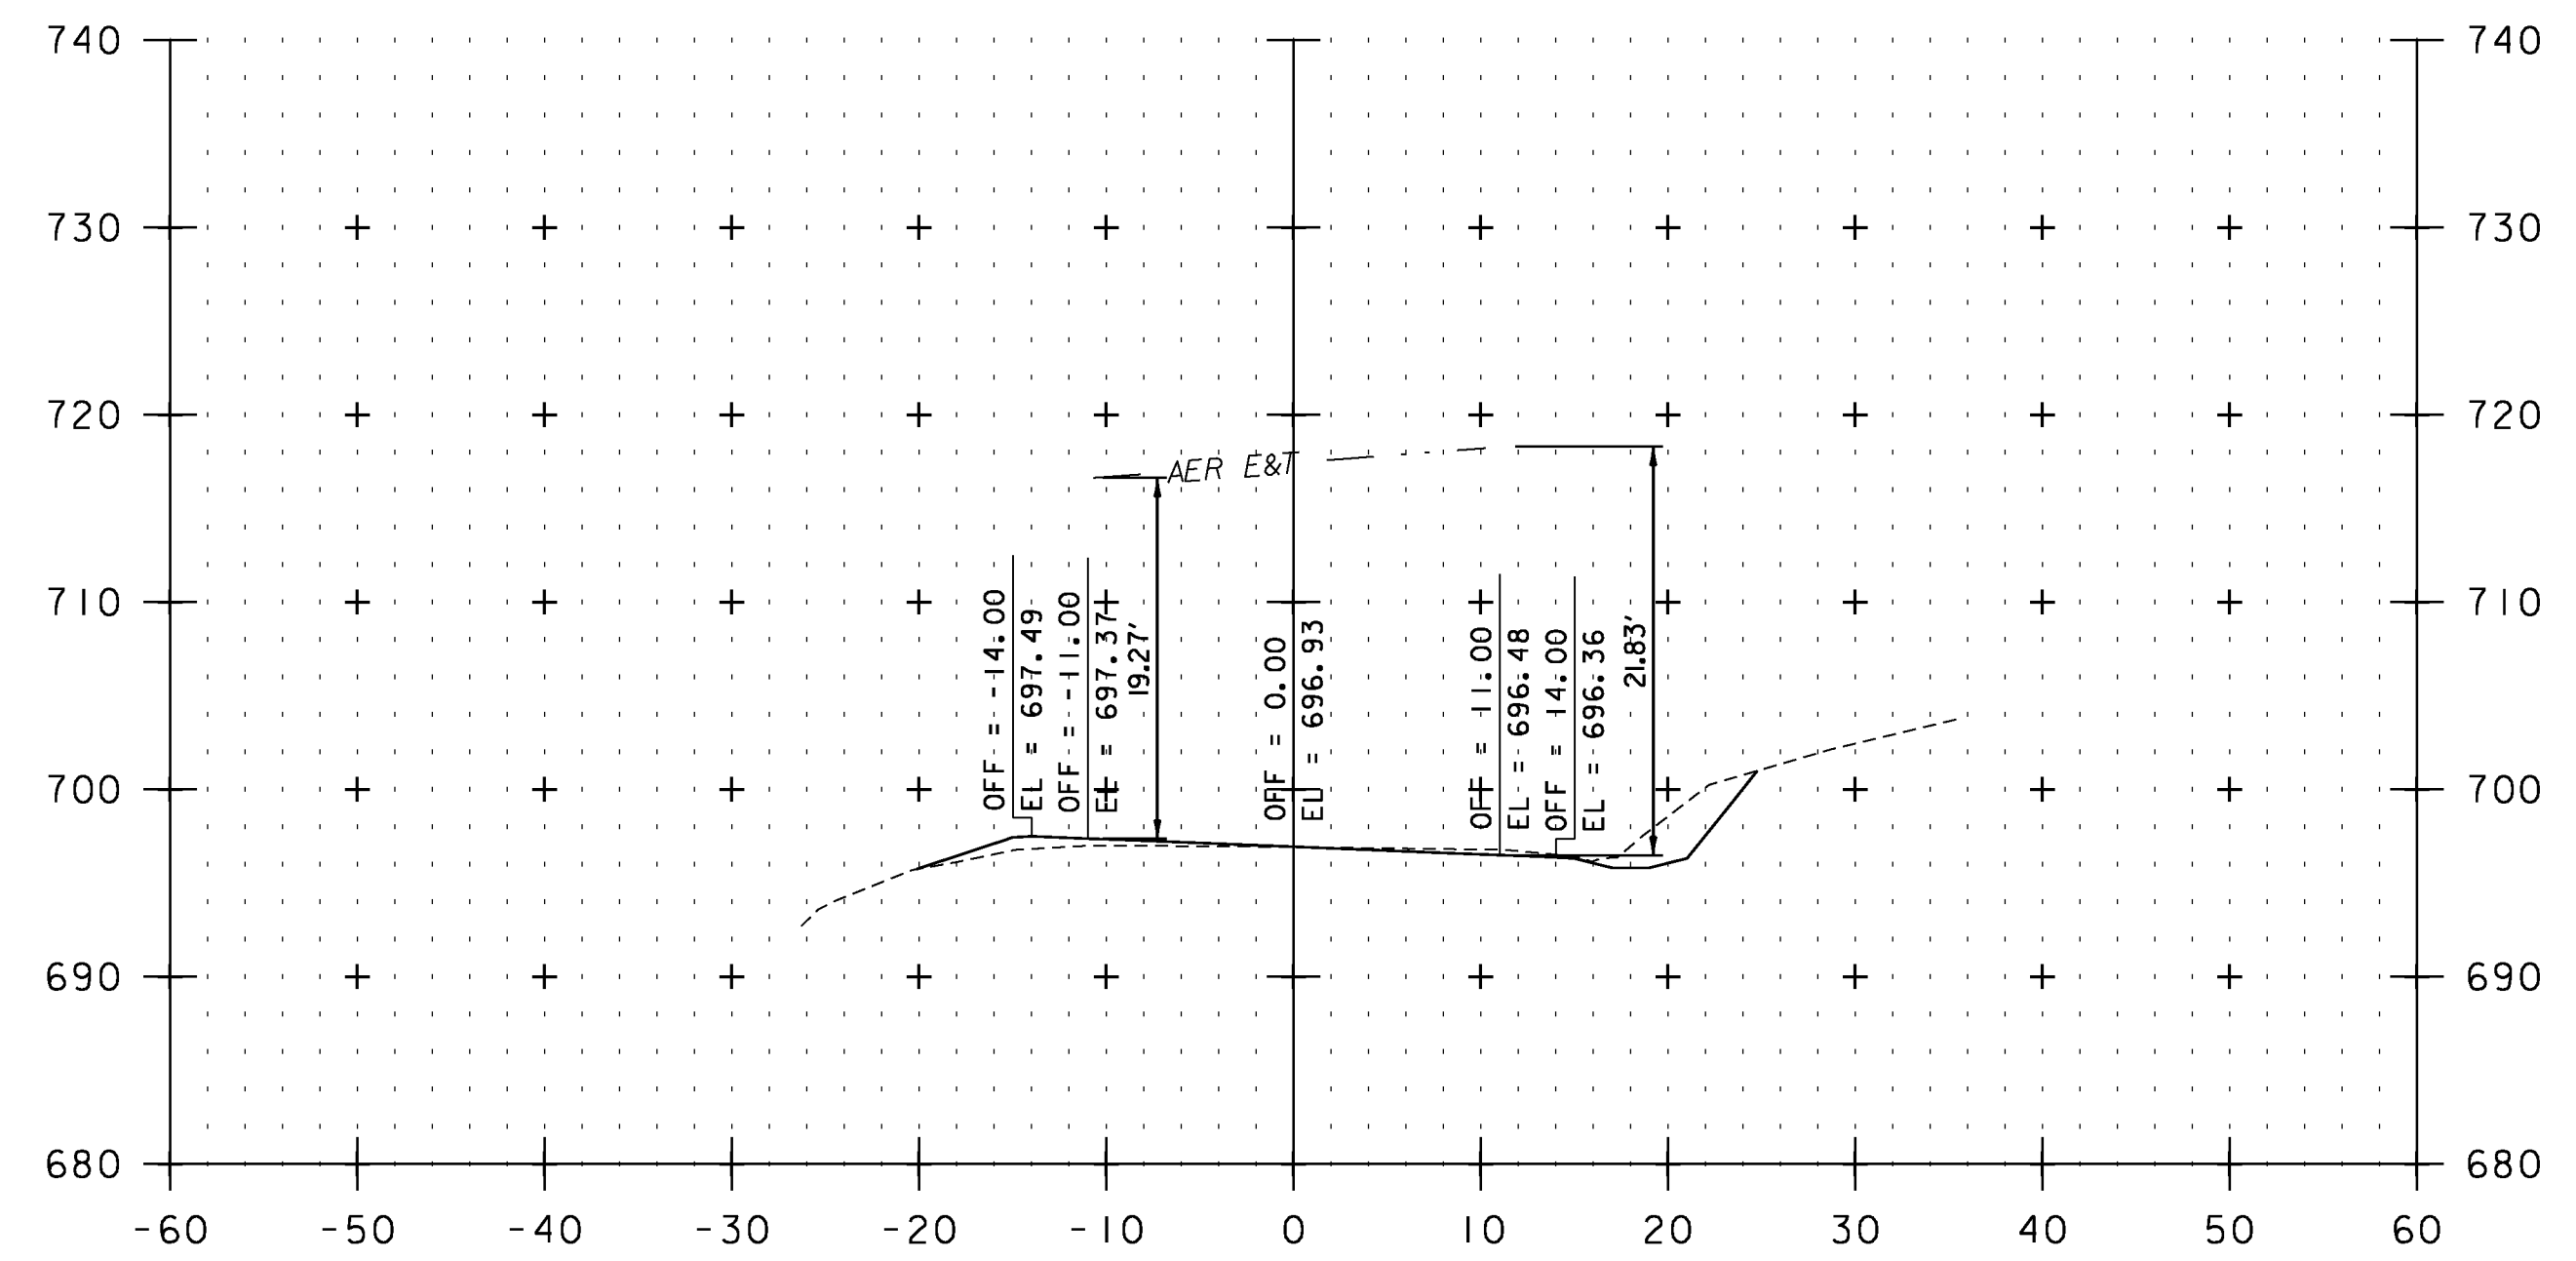

T 6+44

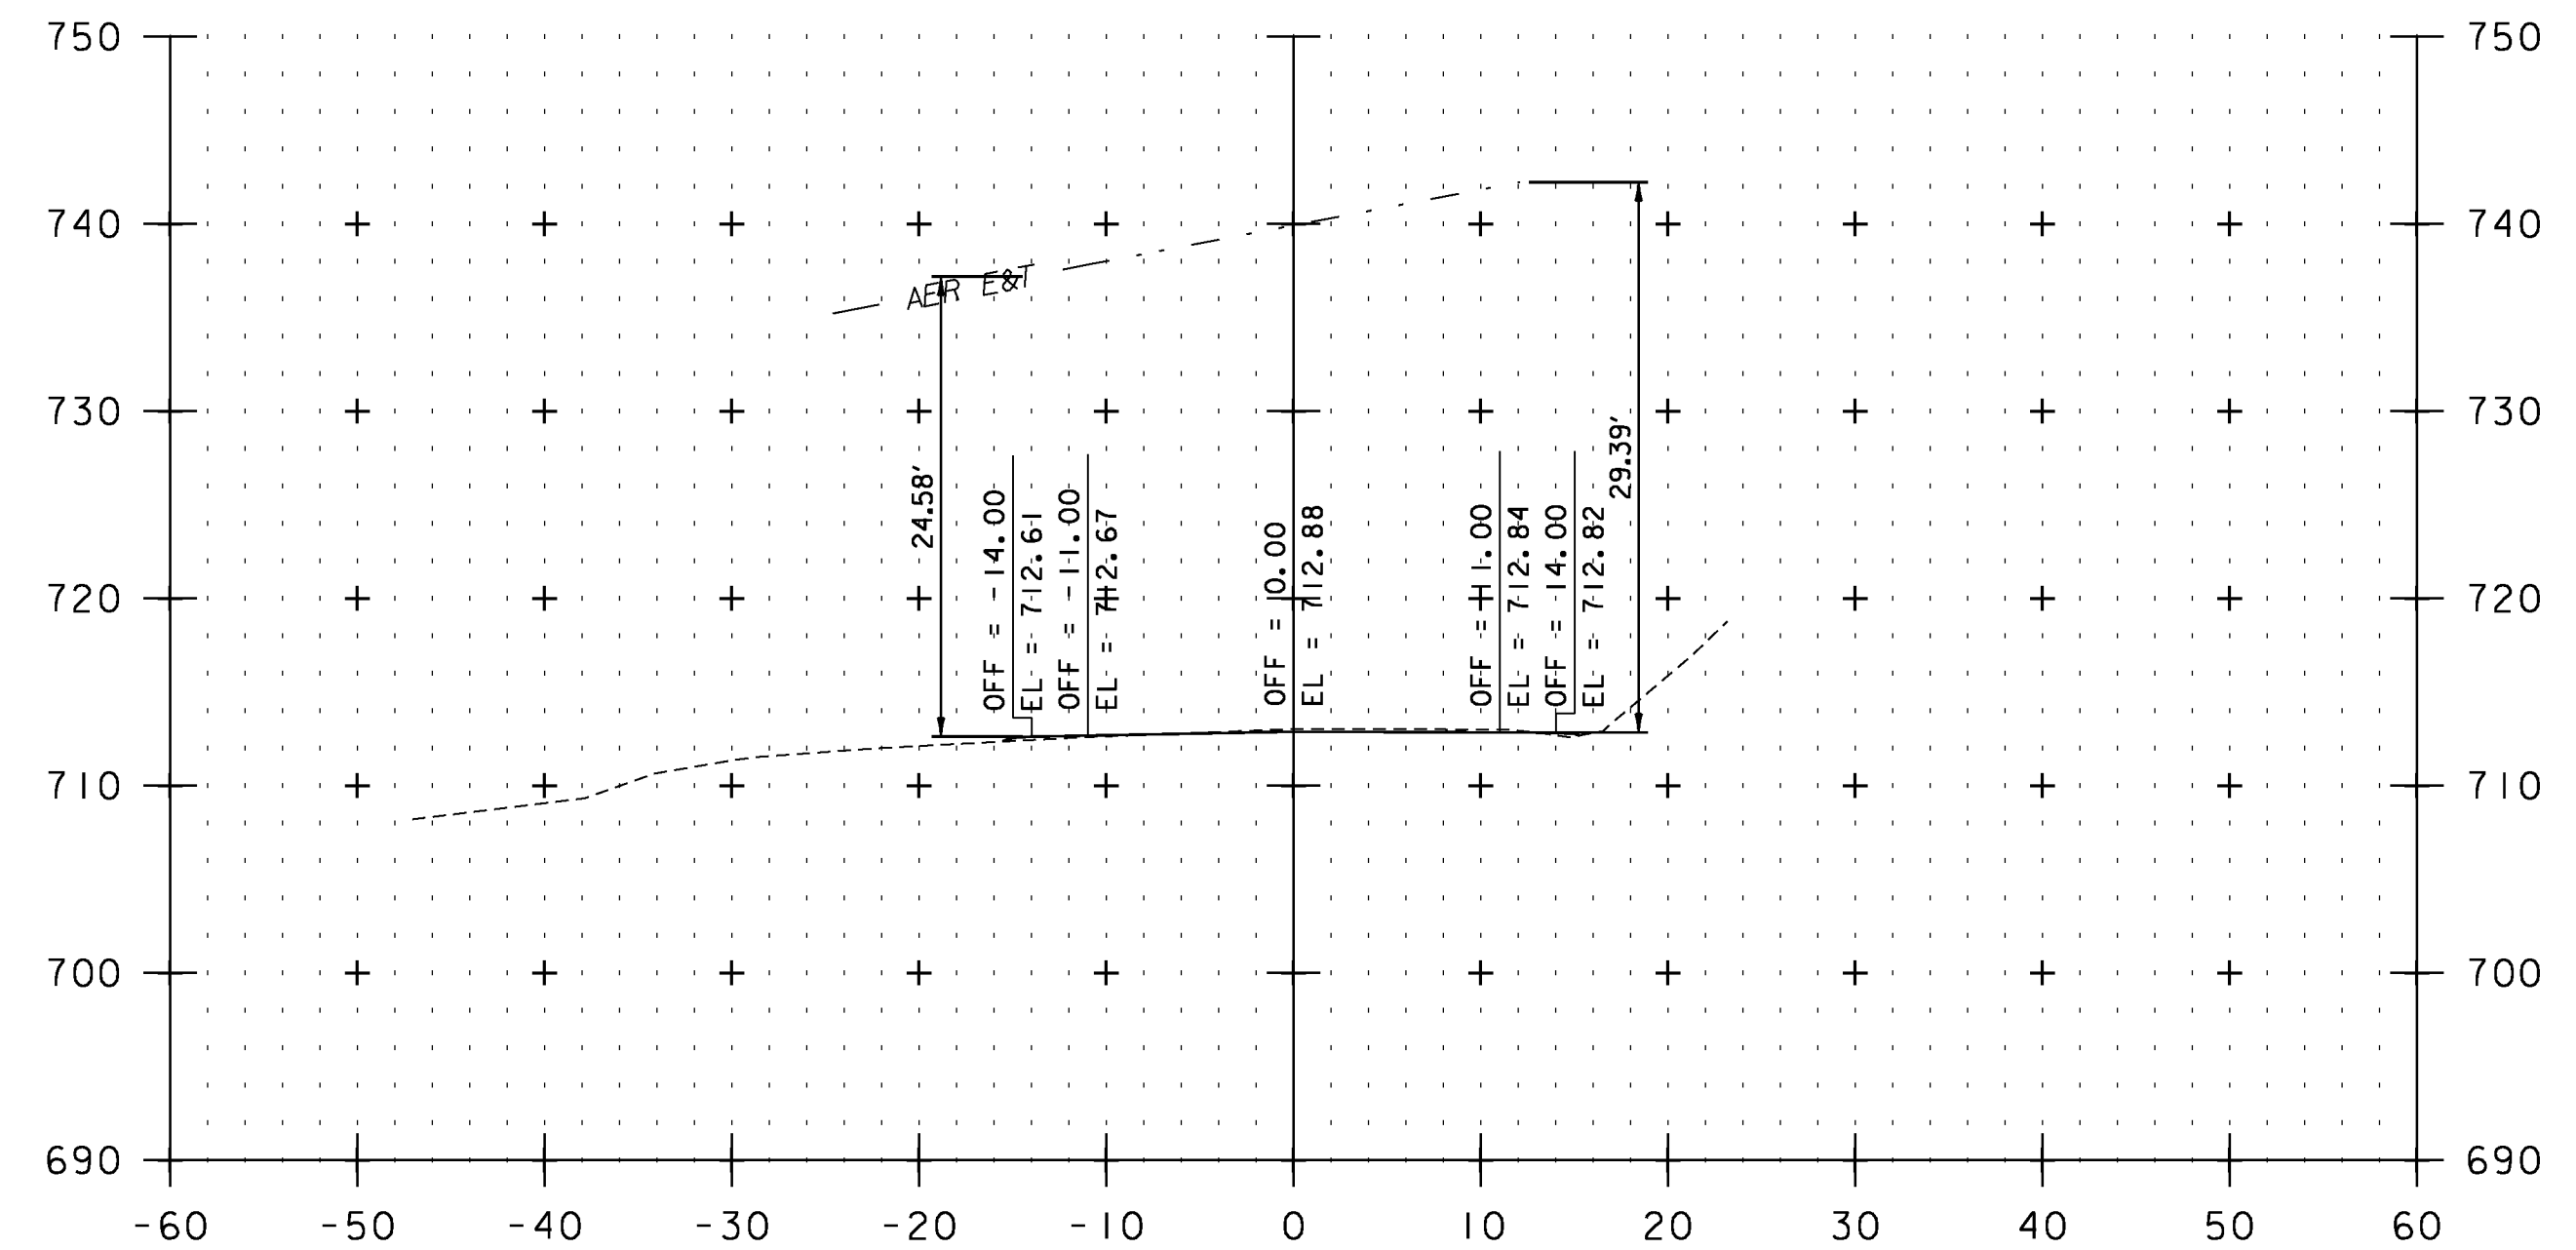

T 2+49

**UTILITY CROSS SECTION SHEET 24**

PROJECT NAME: VERSHIRE-THETFORD

PROJECT NUMBER: STP 2911(I)

FILE NAME: pl0c224.dgn

PLOT DATE: 1/29/2013

PROJECT LEADER: PTS

DRAWN BY: JLS

DESIGNED BY: NLL

CHECKED BY: PTS

IPARM FILE NAME: IOC224\_228

SHEET 228 OF 232

STA. F 137+88 TO STA. T 6+44

