



T 42+84

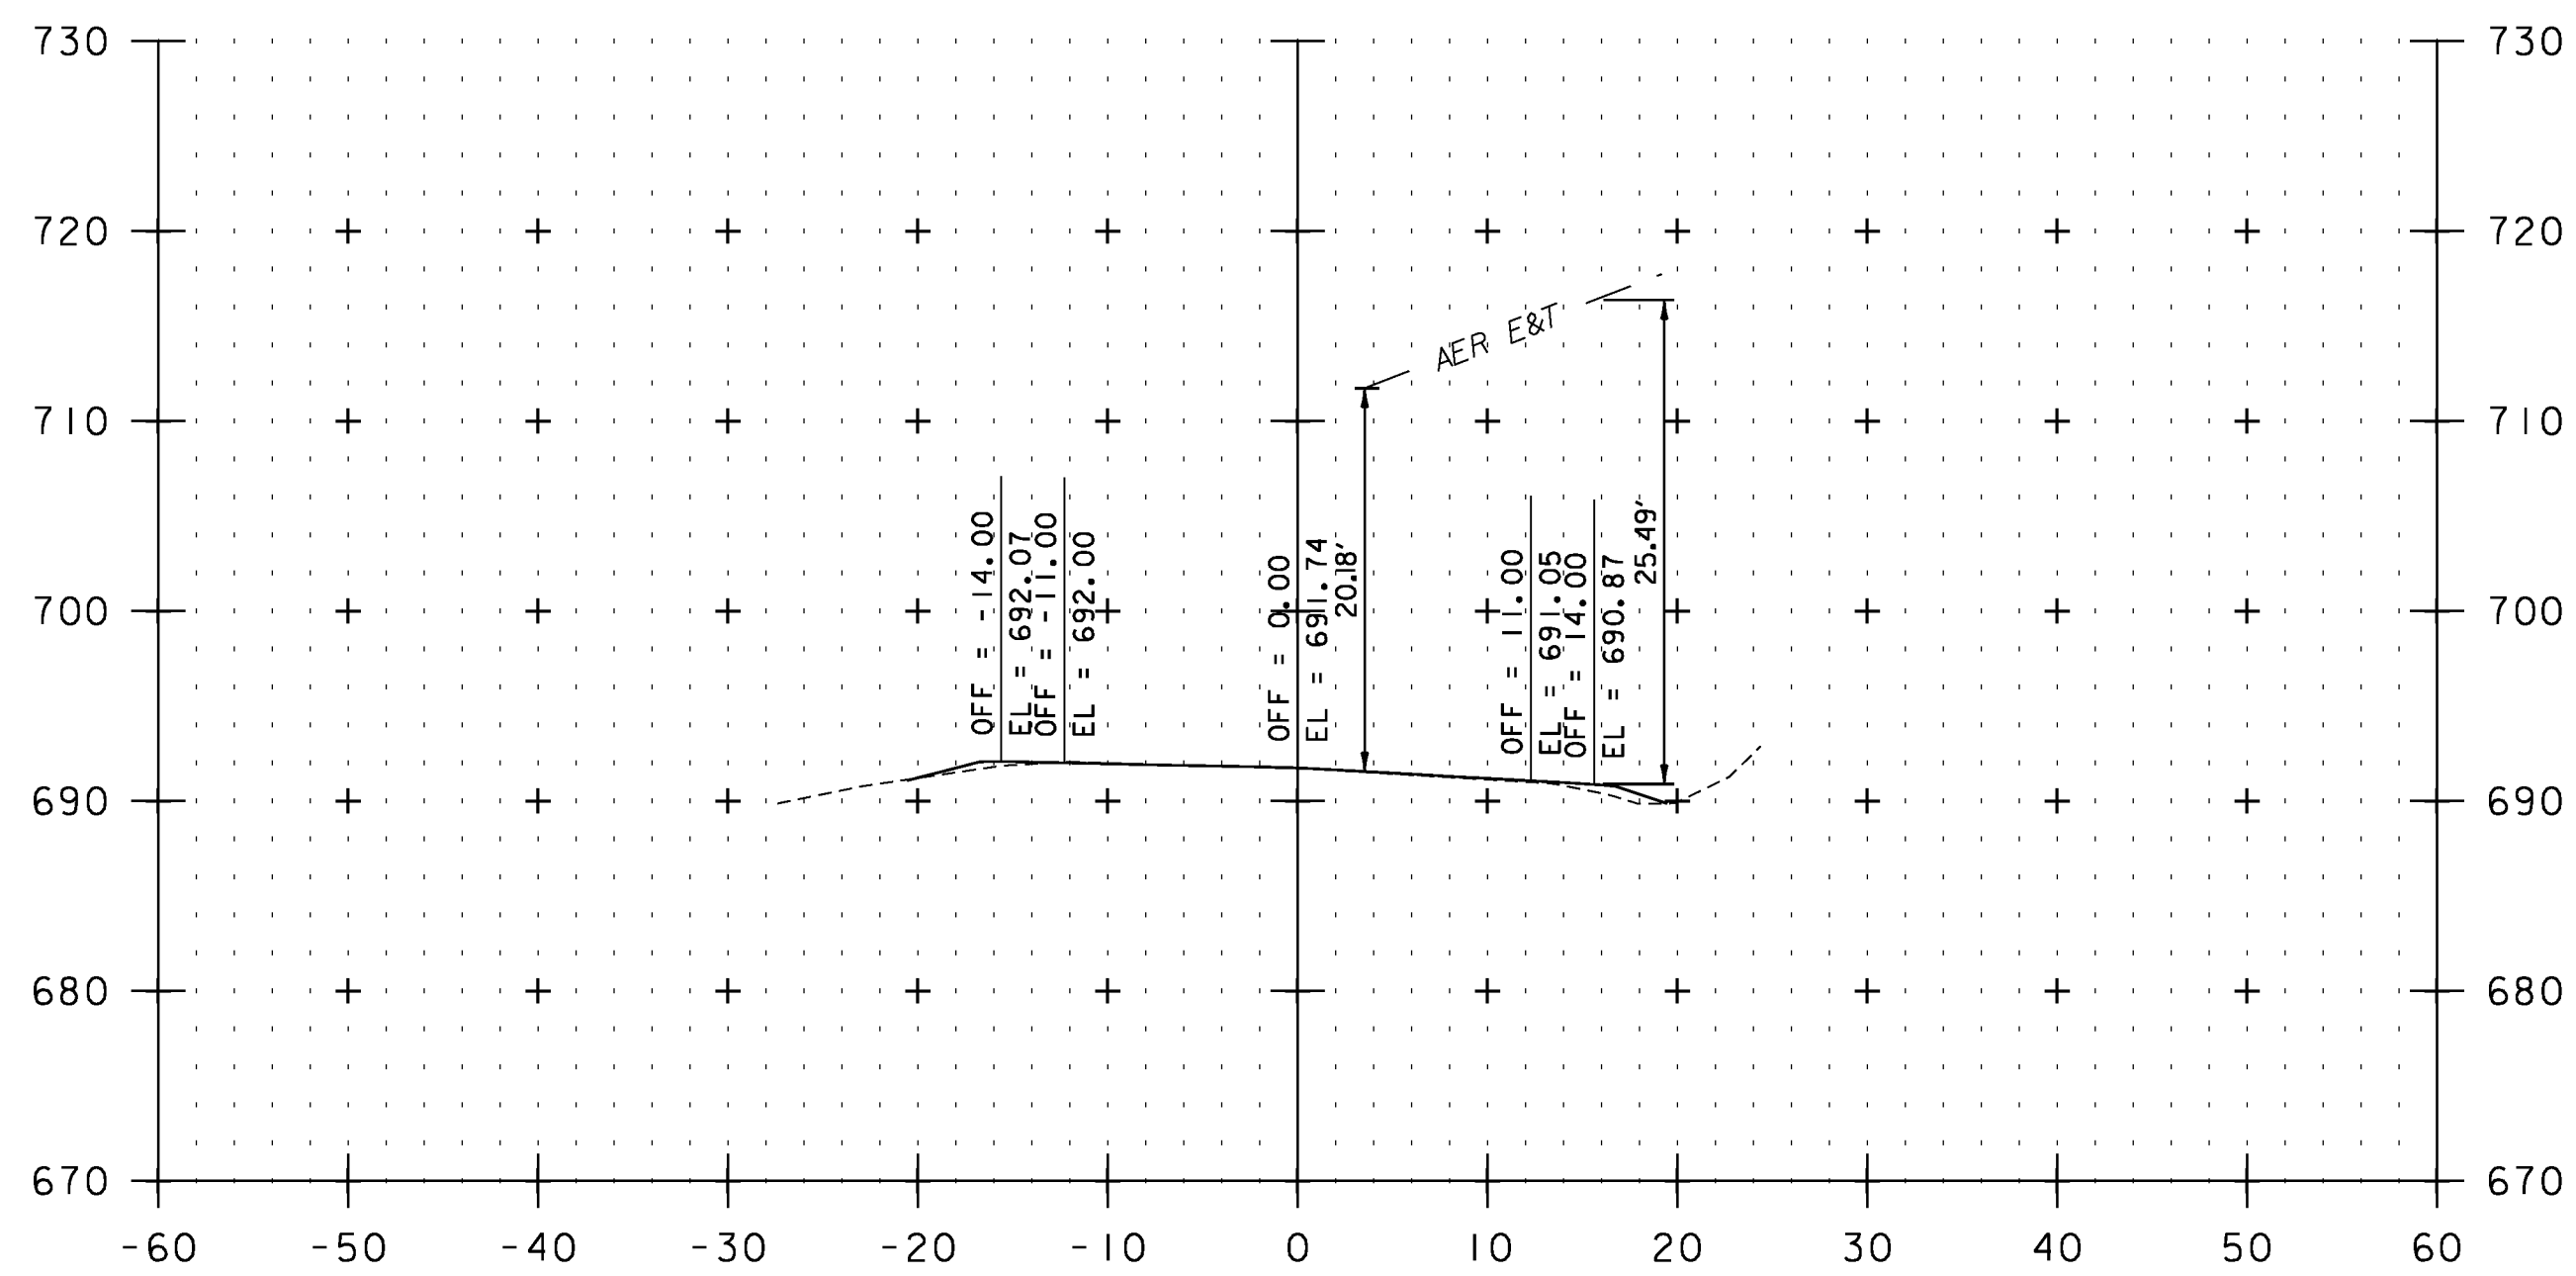

T 39+79

STA. T 39+79 TO STA. T 42+84

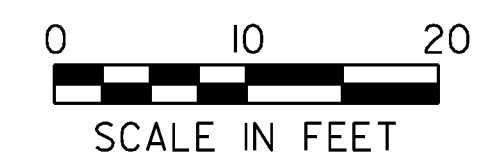

UTILITY CROSS SECTION SHEET 27

PROJECT NAME: VERSHIRE-THETFORD	PLOT DATE: 1/29/2013
PROJECT NUMBER: STP 2911(I)	DRAWN BY: JLS
FILE NAME: pl0c224.dgn	CHECKED BY: PTS
PROJECT LEADER: PTS	SHEET 231 OF 232
DESIGNED BY: NLL	
IPARM FILE NAME: 10C224_231	