

**STEEL BEAM GUARDRAIL, GALVANIZED**  
 STA. 53+43.5 TO 54+18.5, RT 53+43 TO 54+43.5  
 STA. 53+43.5 TO 54+18.5, LT 53+43.5 TO 54+43.5  
 STA. 55+56.0 TO 56+31.0, RT 55+31 TO 56+31  
 STA. 55+56.0 TO 56+31.0, LT 55+31 TO 56+50

**HD STEEL BEAM GUARDRAIL, GALVANIZED W/8 FEET POSTS**  
 STA. 54+18.5 TO 54+43.5, RT 53+43 TO 54+43.5  
 STA. 54+18.5 TO 54+43.5, LT 53+43.5 TO 54+43.5  
 STA. 55+31.0 TO 55+56.0, RT 55+31 TO 56+31  
 STA. 55+31.0 TO 55+56.0, LT 55+31 TO 56+50

**ANCHOR FOR STEEL BEAM RAIL**  
 STA. 53+43.5, LT  
 STA. 53+43.5, RT  
 STA. 56+31.0, RT

**REMOVAL AND DISPOSAL OF GUARDRAIL**  
 STA. 53+79 TO 54+43.5, RT  
 STA. 53+82 TO 54+43.5, LT  
 STA. 55+31 TO 55+94, RT  
 STA. 55+31 TO 55+93, LT


**DURABLE 4 INCH WHITE LINE**  
 (ALL LINES WILL INCLUDE EDGE LINE BREAKS AND RADII FOR SIDE ROADS)  
 STA. 50+50 TO 56+50, SOLID LT & RT

**DURABLE 4 INCH YELLOW LINE**  
 (ALL LINES WILL INCLUDE C BREAKS FOR SIDE ROADS)  
 STA. 50+50 TO 53+86, DASHED LT, SOLID RT  
 STA. 53+86 TO 56+50, SOLID LT & RT

**TEMPORARY 4 INCH WHITE LINE, PAINT**  
 (ALL LINES WILL INCLUDE EDGE LINE BREAKS AND RADII FOR SIDE ROADS)  
 STA. 50+50 TO 56+50, SOLID LT & RT

**TEMPORARY 4 INCH YELLOW LINE, PAINT**  
 (ALL LINES WILL INCLUDE C BREAKS FOR SIDE ROADS)  
 STA. 50+50 TO 53+86, DASHED LT, SOLID RT  
 STA. 53+86 TO 56+50, SOLID LT & RT

**REMOVING SIGNS**  
 AS SHOWN - 4

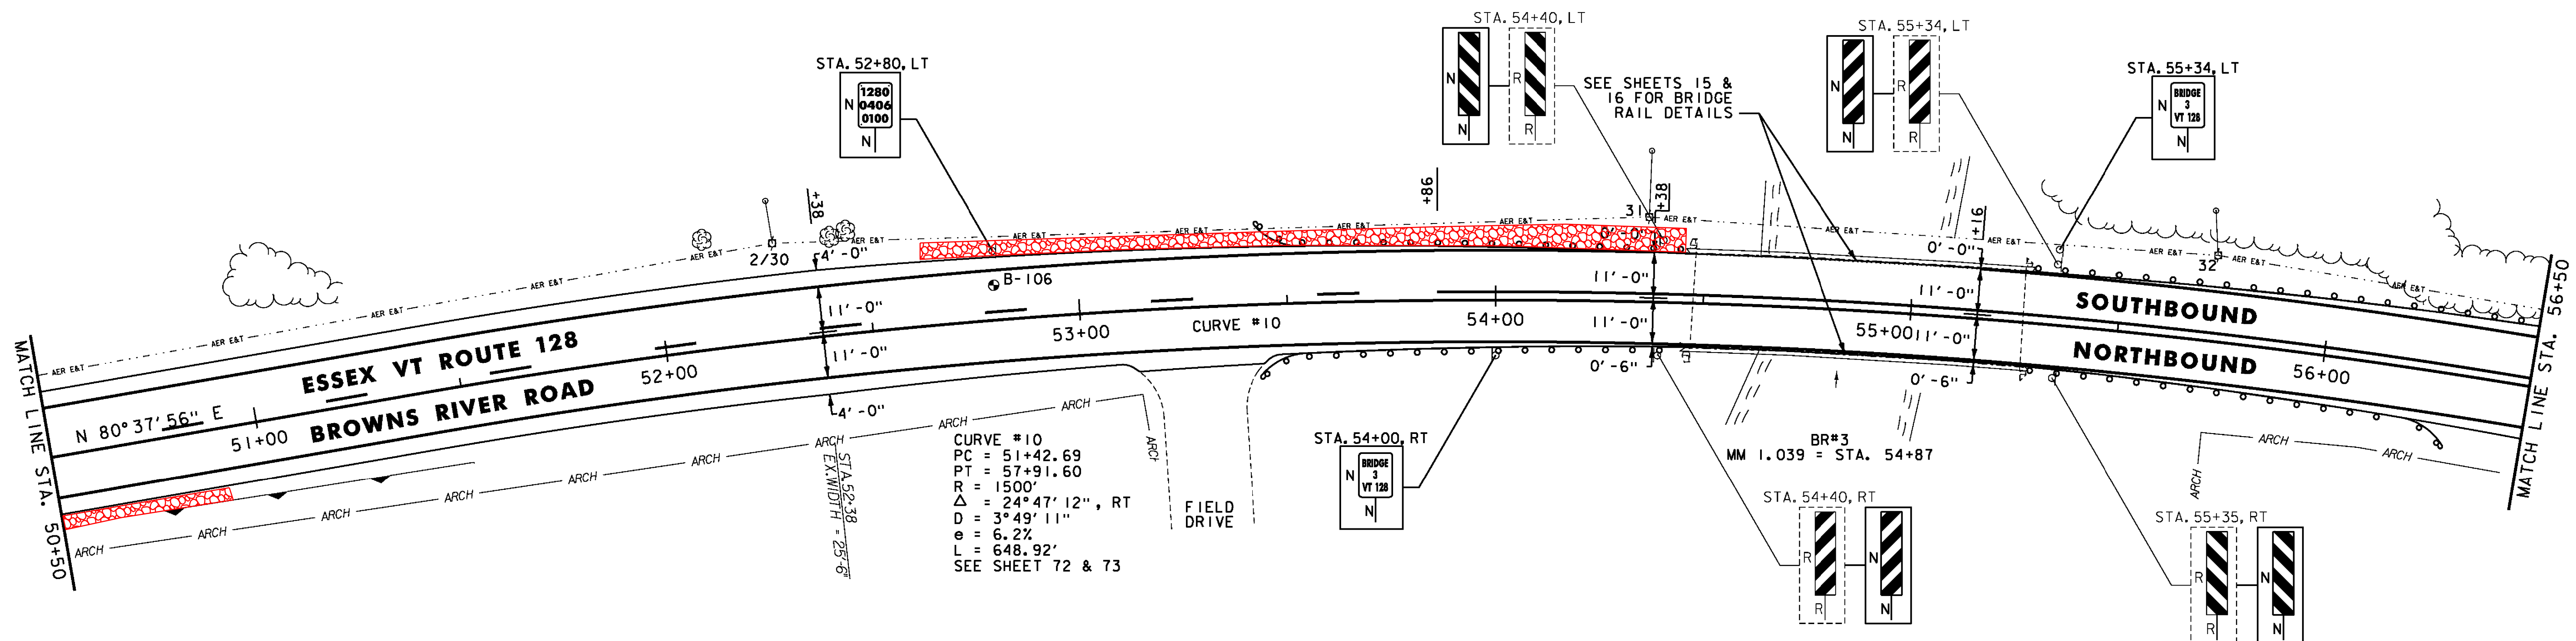

- NOTES:  
 1. FOR LEGENDS, SEE SHEET 20.  
 2. ALL EXISTING SIGNS NOT SHOWN SHALL BE RETAINED.  
 3. SEE SHEETS 8 & 9 FOR DURABLE PAVEMENT MARKINGS OPTIONS.

NOT TO SCALE

**PROJECT LAYOUT SHEET #7**

SOIL BORING DATA			
BORING#	DEPTH (FT.)	PCC	COMMENTS
B-106	5.0'	NO	



PROJECT NAME: ESSEX-WESTFORD  
 PROJECT NUMBER: STP 2912(I)

FILE NAME: p10c226.dgn  
 PROJECT LEADER: JLL  
 DESIGNED BY: STANTEC  
 IPARM FILE: p10c226i07.i

PLOT DATE: 2/20/2013  
 DRAWN BY: STANTEC  
 CHECKED BY: STANTEC  
 SHEET 26 OF 239