

RELOCATE MAILBOX, SINGLE SUPPORT
STA. 71+62, LT
STA. 73+01, RT

RELOCATE MAILBOX, MULTIPLE SUPPORT
STA. 69+45, LT



DURABLE 4 INCH WHITE LINE
(ALL LINES WILL INCLUDE EDGE LINE BREAKS
AND RADII FOR SIDE ROADS)
STA. 68+50 TO 74+50, SOLID LT & RT

DURABLE 4 INCH YELLOW LINE
(ALL LINES WILL INCLUDE ϕ BREAKS FOR SIDE ROADS)
STA. 68+50 TO 74+50, SOLID LT & RT

TEMPORARY 4 INCH WHITE LINE, PAINT
(ALL LINES WILL INCLUDE EDGE LINE BREAKS
AND RADII FOR SIDE ROADS)
STA. 68+50 TO 74+50, SOLID LT & RT

TEMPORARY 4 INCH YELLOW LINE, PAINT
(ALL LINES WILL INCLUDE ϕ BREAKS FOR SIDE ROADS)
STA. 68+50 TO 74+50, SOLID LT & RT

UD-8 STA. 72+10 TO 77+10, RT
CONSTRUCT 6 INCH UNDERDRAIN PIPE,
SEE SHEET 12 FOR DETAIL AND
ASSOCIATED QUANTITIES.

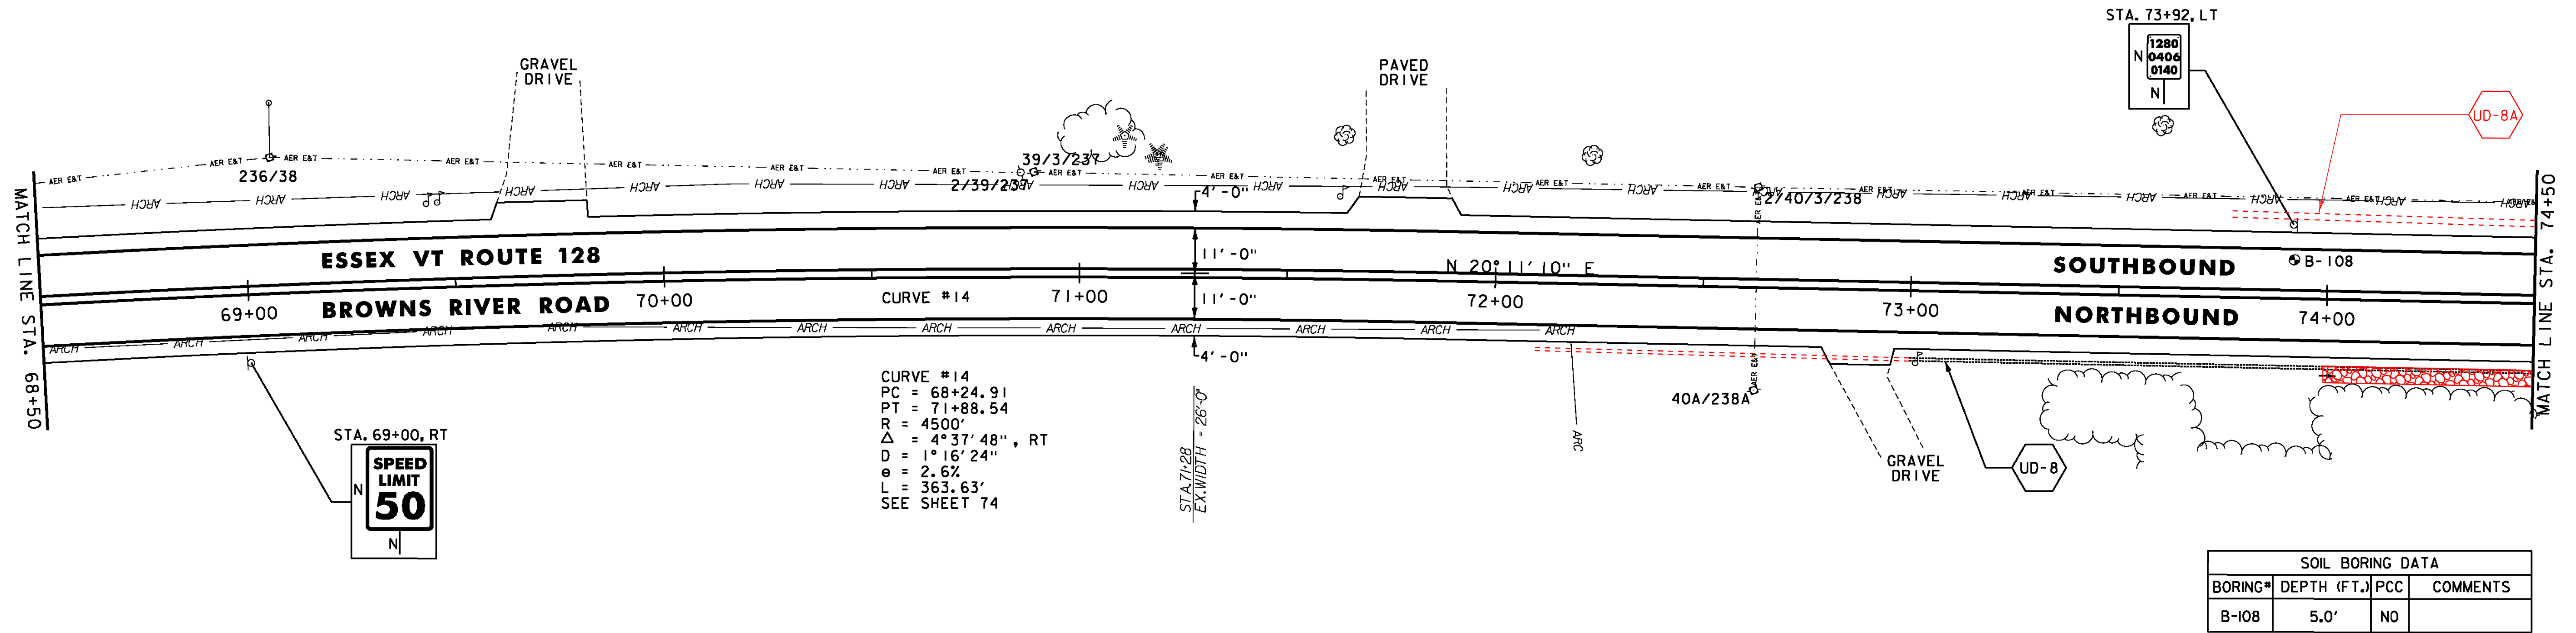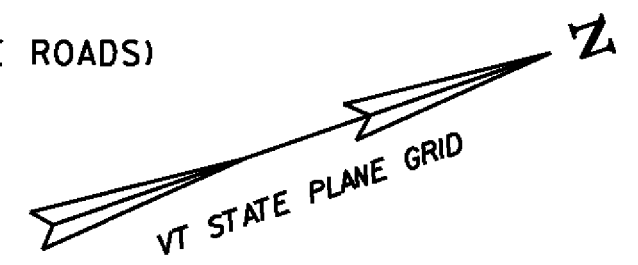

STONE FILL, TYPE I
STA. 76+60 TO 78+50, RT
STA. 77+50 TO 78+10, LT
STA. 79+80 TO 80+40, RT

DURABLE 4 INCH WHITE LINE
(ALL LINES WILL INCLUDE EDGE LINE BREAKS
AND RADII FOR SIDE ROADS)
STA. 74+50 TO 80+50, SOLID LT & RT

TEMPORARY 4 INCH WHITE LINE, PAINT
(ALL LINES WILL INCLUDE EDGE LINE BREAKS
AND RADII FOR SIDE ROADS)
STA. 74+50 TO 80+50, SOLID LT & RT

GEOTEXTILE UNDER STONE FILL
STA. 76+60 TO 78+50, RT
STA. 77+50 TO 78+10, LT
STA. 79+80 TO 80+40, RT

RELOCATE MAILBOX, SINGLE SUPPORT
STA. 75+19, LT
STA. 79+08, RT
STA. 80+48, LT



DURABLE 4 INCH YELLOW LINE
(ALL LINES WILL INCLUDE ϕ BREAKS FOR SIDE ROADS)
STA. 74+50 TO 79+73, SOLID LT & RT
STA. 79+73 TO 80+50, SOLID LT, DASHED RT

TEMPORARY 4 INCH YELLOW LINE, PAINT
(ALL LINES WILL INCLUDE ϕ BREAKS FOR SIDE ROADS)
STA. 74+50 TO 79+73, SOLID LT & RT
STA. 79+73 TO 80+50, SOLID LT, DASHED RT

GRUBBING MATERIAL
STA. 76+60 TO 78+50, RT
STA. 77+50 TO 78+10, LT
STA. 79+80 TO 80+40, RT

SPECIAL PROVISION (RELOCATE FLASHING
BEACON, GROUND MOUNTED)
STA. 74+61, LT

UD-8A STA. 73+80 TO 77+20, LT
CONSTRUCT 6 INCH UNDERDRAIN PIPE,
SEE SHEET 12 FOR DETAIL.

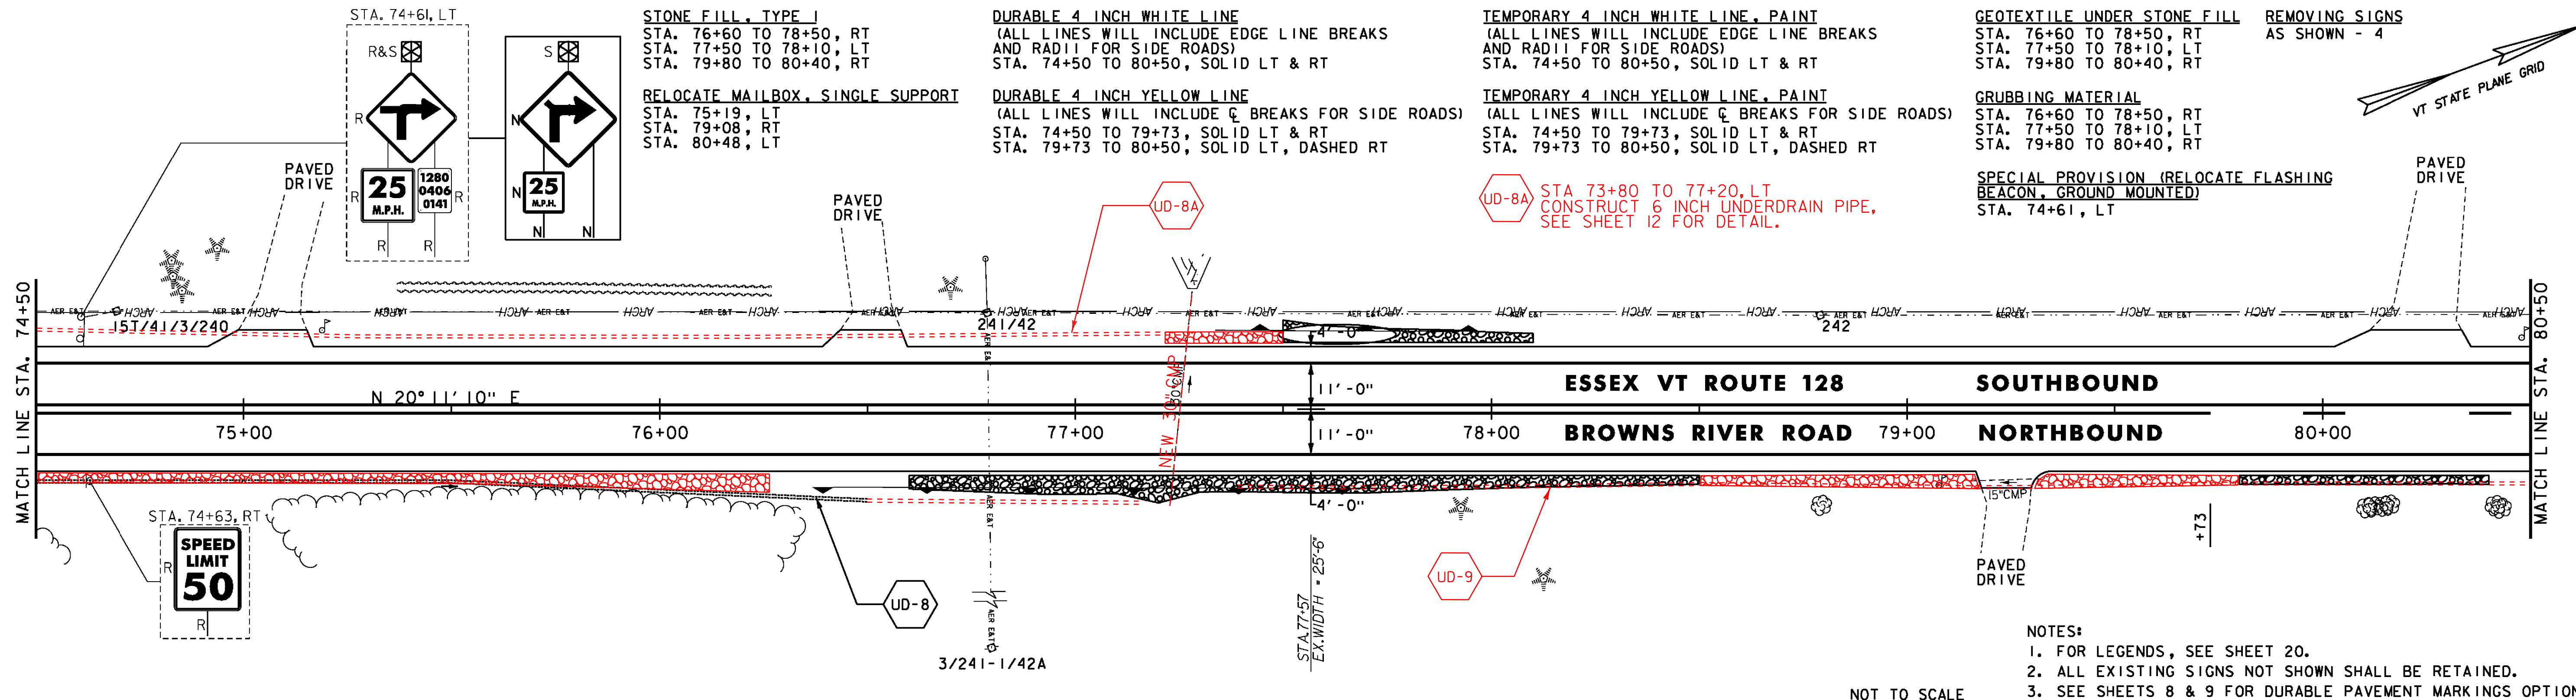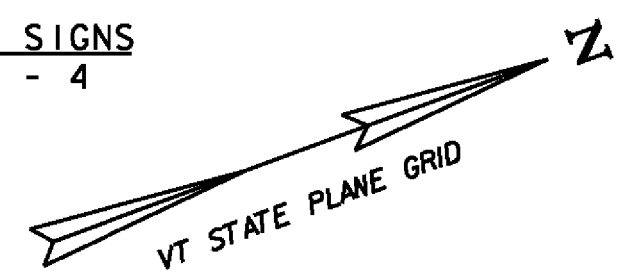

- NOTES:
- FOR LEGENDS, SEE SHEET 20.
 - ALL EXISTING SIGNS NOT SHOWN SHALL BE RETAINED.
 - SEE SHEETS 8 & 9 FOR DURABLE PAVEMENT MARKINGS OPTIONS.

NOT TO SCALE

PROJECT LAYOUT SHEET #10

PROJECT NAME: ESSEX-WESTFORD	FILE NAME: p10c226.dgn	PLOT DATE: 2/20/2013
PROJECT NUMBER: STP 2912(I)	DESIGNED BY: STANTEC	DRAWN BY: STANTEC
	IPARM FILE: p10c226110.i	CHECKED BY: STANTEC
		SHEET 29 OF 239

