

STONE FILL, TYPE J
 STA. 110+00 TO 110+30, LT

RELOCATE MAILBOX, SINGLE SUPPORT
 STA. 112+69, LT
 STA. 112+71, LT

STEEL BEAM GUARDRAIL, GALVANIZED W/8 FEET POSTS
 STA. 108+50.0 TO 111+59.0, LT
 STA. 108+50.0 TO 110+90.5, RT

ANCHOR FOR STEEL BEAM RAIL
 STA. 110+90.5, RT
 STA. 111+59.0, LT

REMOVAL AND DISPOSAL OF GUARDRAIL
 STA. 108+50 TO 110+62, LT
 STA. 108+61 TO 111+11, RT

DURABLE 4 INCH WHITE LINE
 (ALL LINES WILL INCLUDE EDGE LINE BREAKS AND RADII FOR SIDE ROADS)
 STA. 108+50 TO 114+00, SOLID LT & RT
 STA. 109+86 & 111+13, SOLID RT (EDGELINES, OSGOOD HILL ROAD TH-51)

DURABLE 4 INCH YELLOW LINE
 (ALL LINES WILL INCLUDE $\frac{1}{2}$ BREAKS FOR SIDE ROADS)
 STA. 108+50 TO 114+00, SOLID LT & RT
 STA. 111+13, DOUBLE SOLID RT (OSGOOD HILL ROAD TH-51)
 STA. 109+86, SOLID RT (OSGOOD HILL ROAD APPROACH TH-51)

DURABLE 24 INCH STOP BAR
 STA. 111+13, RT (OSGOOD HILL ROAD TH-51)

DURABLE LETTER OR SYMBOL
 STA. 110+75, RT WRONG WAY ARROW (OSGOOD HILL ROAD TH-51) (FOR DETAIL SEE SHEET 18)
 STA. 110+86, RT YIELD BAR (OSGOOD HILL ROAD TH-51) (4 EA)
 STA. 111+13, RT "STOP" (OSGOOD HILL ROAD TH-51)

TEMPORARY 4 INCH WHITE LINE, PAINT
 (ALL LINES WILL INCLUDE EDGE LINE BREAKS AND RADII FOR SIDE ROADS)
 STA. 108+50 TO 114+00, SOLID LT & RT
 STA. 109+86 & 111+13, SOLID RT (EDGELINES, OSGOOD HILL ROAD TH-51)

TEMPORARY 4 INCH YELLOW LINE, PAINT
 (ALL LINES WILL INCLUDE $\frac{1}{2}$ BREAKS FOR SIDE ROADS)
 STA. 108+50 TO 114+00, SOLID LT & RT
 STA. 111+13, DOUBLE SOLID RT (OSGOOD HILL ROAD TH-51)
 STA. 109+86, SOLID RT (OSGOOD HILL ROAD APPROACH TH-51)


TEMPORARY 24 INCH STOP BAR, PAINT
 STA. 111+13, RT (OSGOOD HILL ROAD TH-51)

TEMPORARY LETTER OR SYMBOL, PAINT
 STA. 110+75, RT WRONG WAY ARROW (OSGOOD HILL ROAD TH-51) (FOR DETAIL SEE SHEET 18)
 STA. 110+86, RT YIELD BAR (OSGOOD HILL ROAD TH-51) (4 EA)
 STA. 111+13, RT "STOP" (OSGOOD HILL ROAD TH-51)

GEOTEXTILE UNDER STONE FILL
 STA. 110+00 TO 110+30, LT

GRUBBING MATERIAL
 STA. 110+00 TO 110+30, LT

REMOVING SIGNS
 AS SHOWN - 8

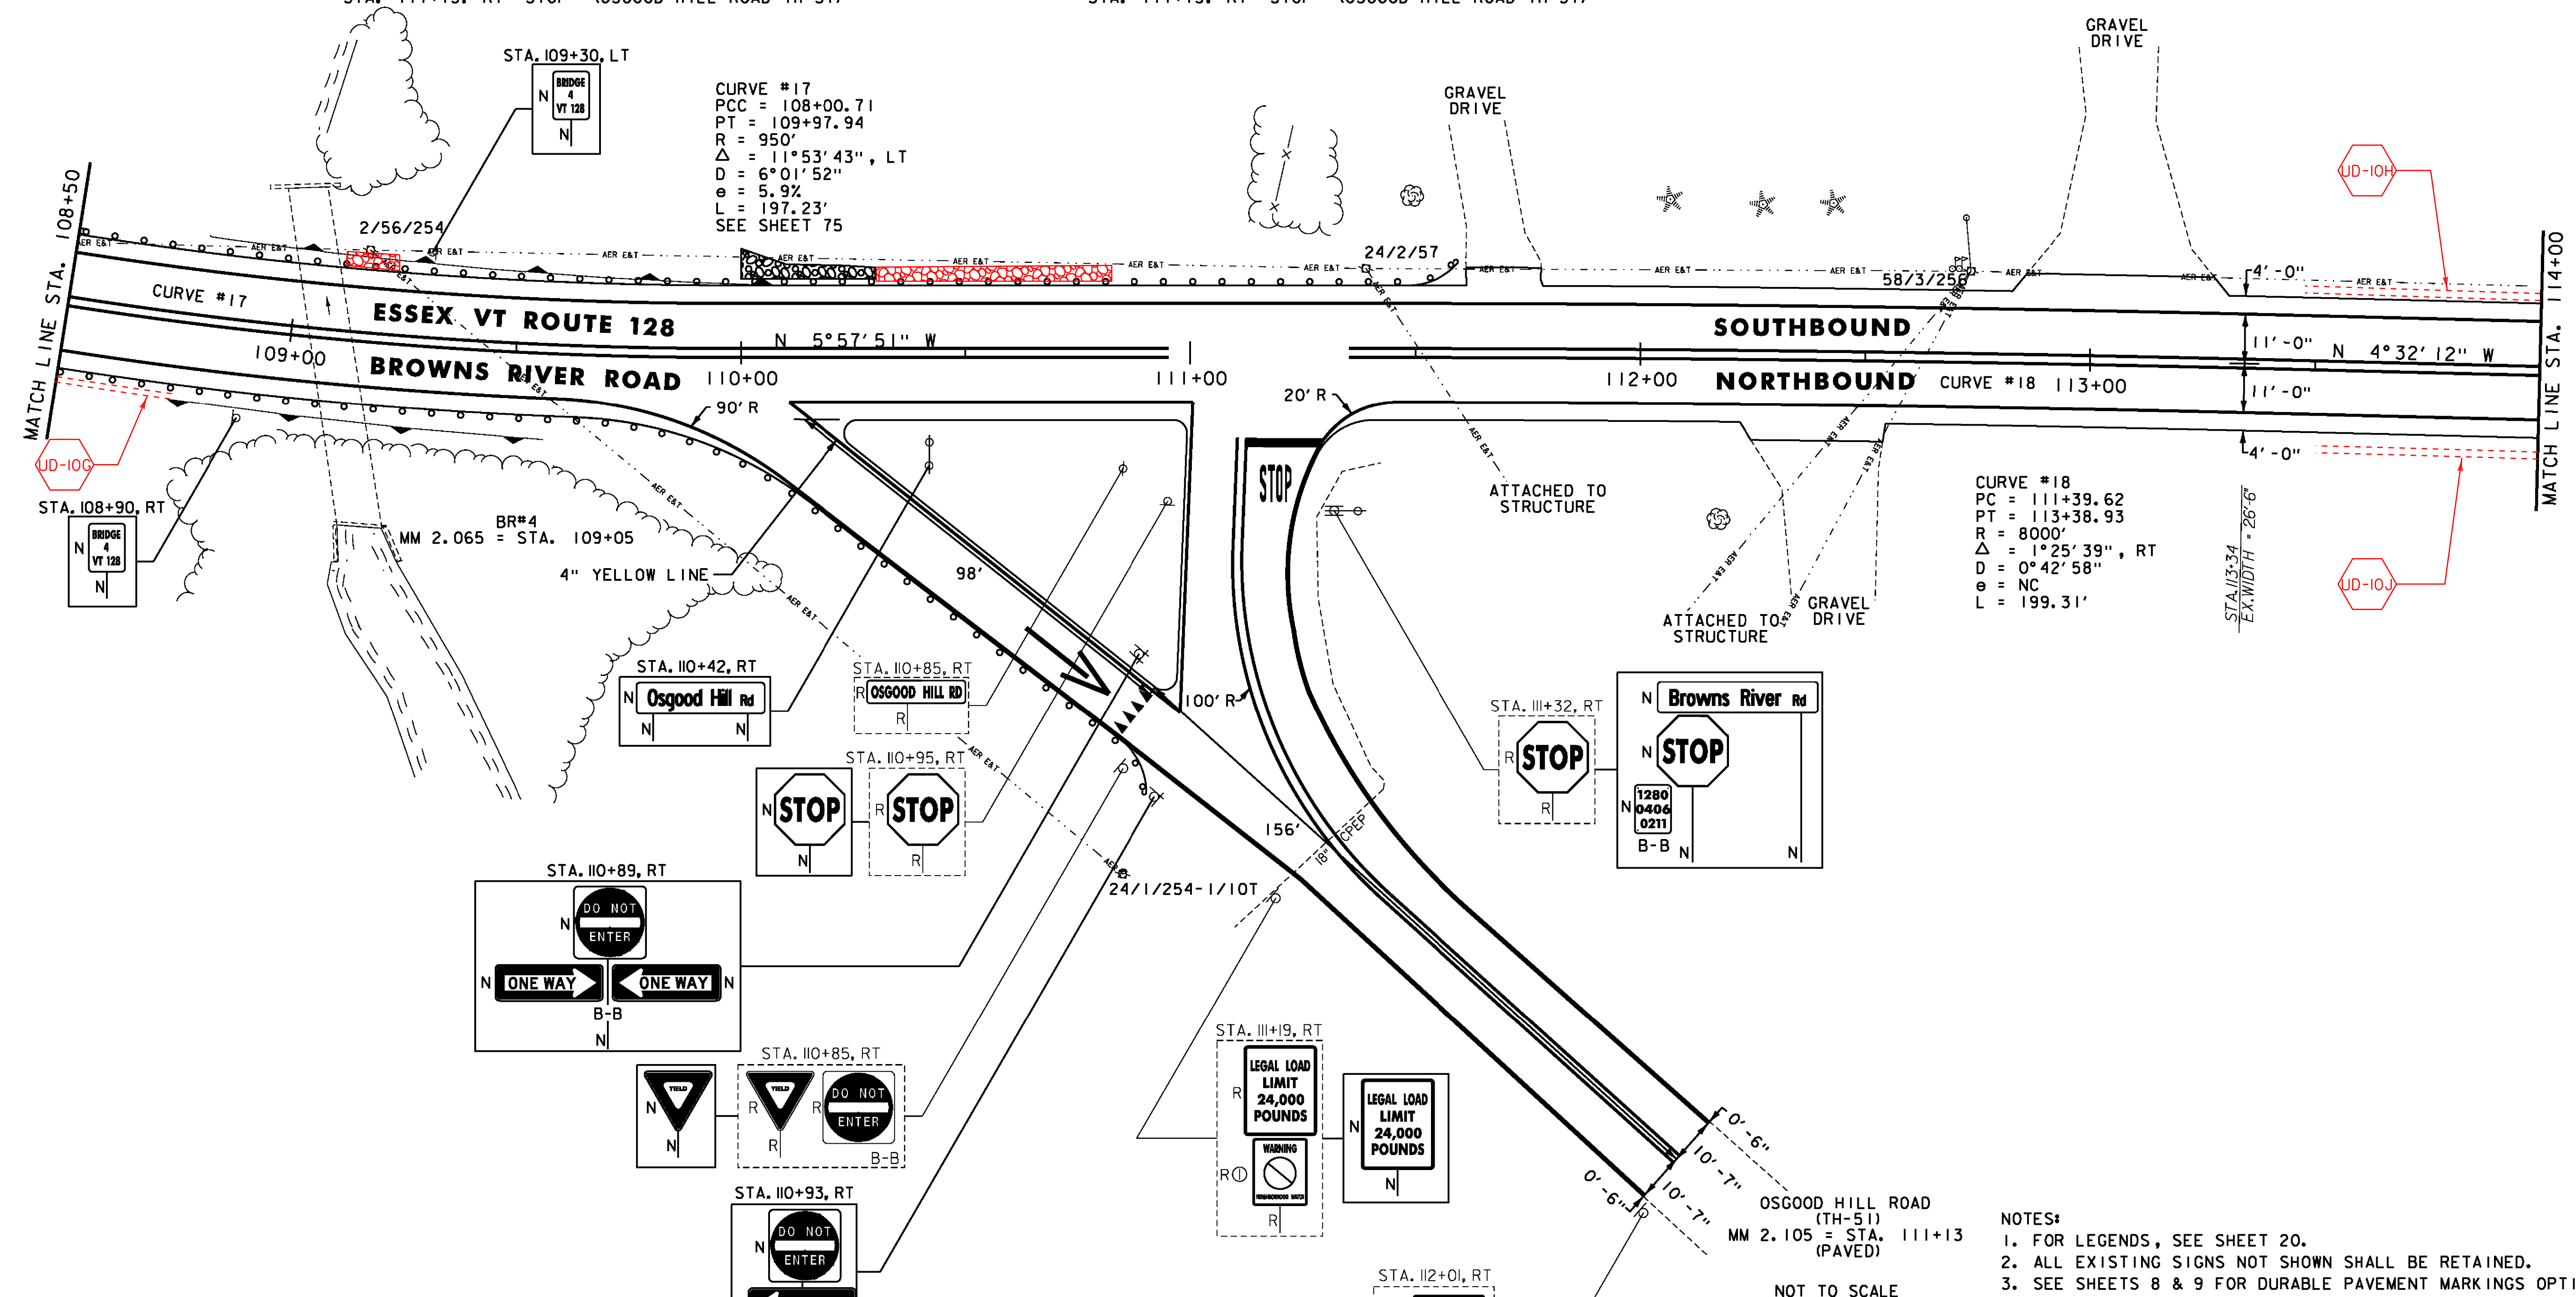

- NOTES:**
1. FOR LEGENDS, SEE SHEET 20.
 2. ALL EXISTING SIGNS NOT SHOWN SHALL BE RETAINED.
 3. SEE SHEETS 8 & 9 FOR DURABLE PAVEMENT MARKINGS OPTIONS.

<p>PROJECT LAYOUT SHEET #14</p>	<p>PROJECT NAME: ESSEX-WESTFORD</p> <p>PROJECT NUMBER: STP 2912(I)</p>
	<p>FILE NAME: p10c226.dgn</p> <p>DESIGNED BY: STANTEC</p> <p>IPARM FILE: p10c226114.i</p>
	<p>PLOT DATE: 2/20/2013</p> <p>DRAWN BY: STANTEC</p> <p>CHECKED BY: STANTEC</p> <p>SHEET 33 OF 239</p>
	<p>NOT TO SCALE</p>