


DURABLE 4 INCH WHITE LINE
 (ALL LINES WILL INCLUDE EDGE LINE BREAKS AND RADII FOR SIDE ROADS)
 STA. 114+00 TO 119+50, SOLID LT & RT

DURABLE 4 INCH YELLOW LINE
 (ALL LINES WILL INCLUDE C BREAKS FOR SIDE ROADS)
 STA. 114+00 TO 119+50, SOLID LT & RT

TEMPORARY 4 INCH WHITE LINE, PAINT
 (ALL LINES WILL INCLUDE EDGE LINE BREAKS AND RADII FOR SIDE ROADS)
 STA. 114+00 TO 119+50, SOLID LT & RT

TEMPORARY 4 INCH YELLOW LINE, PAINT
 (ALL LINES WILL INCLUDE C BREAKS FOR SIDE ROADS)
 STA. 114+00 TO 119+50, SOLID LT & RT

REMOVING SIGNS
 AS SHOWN - 5

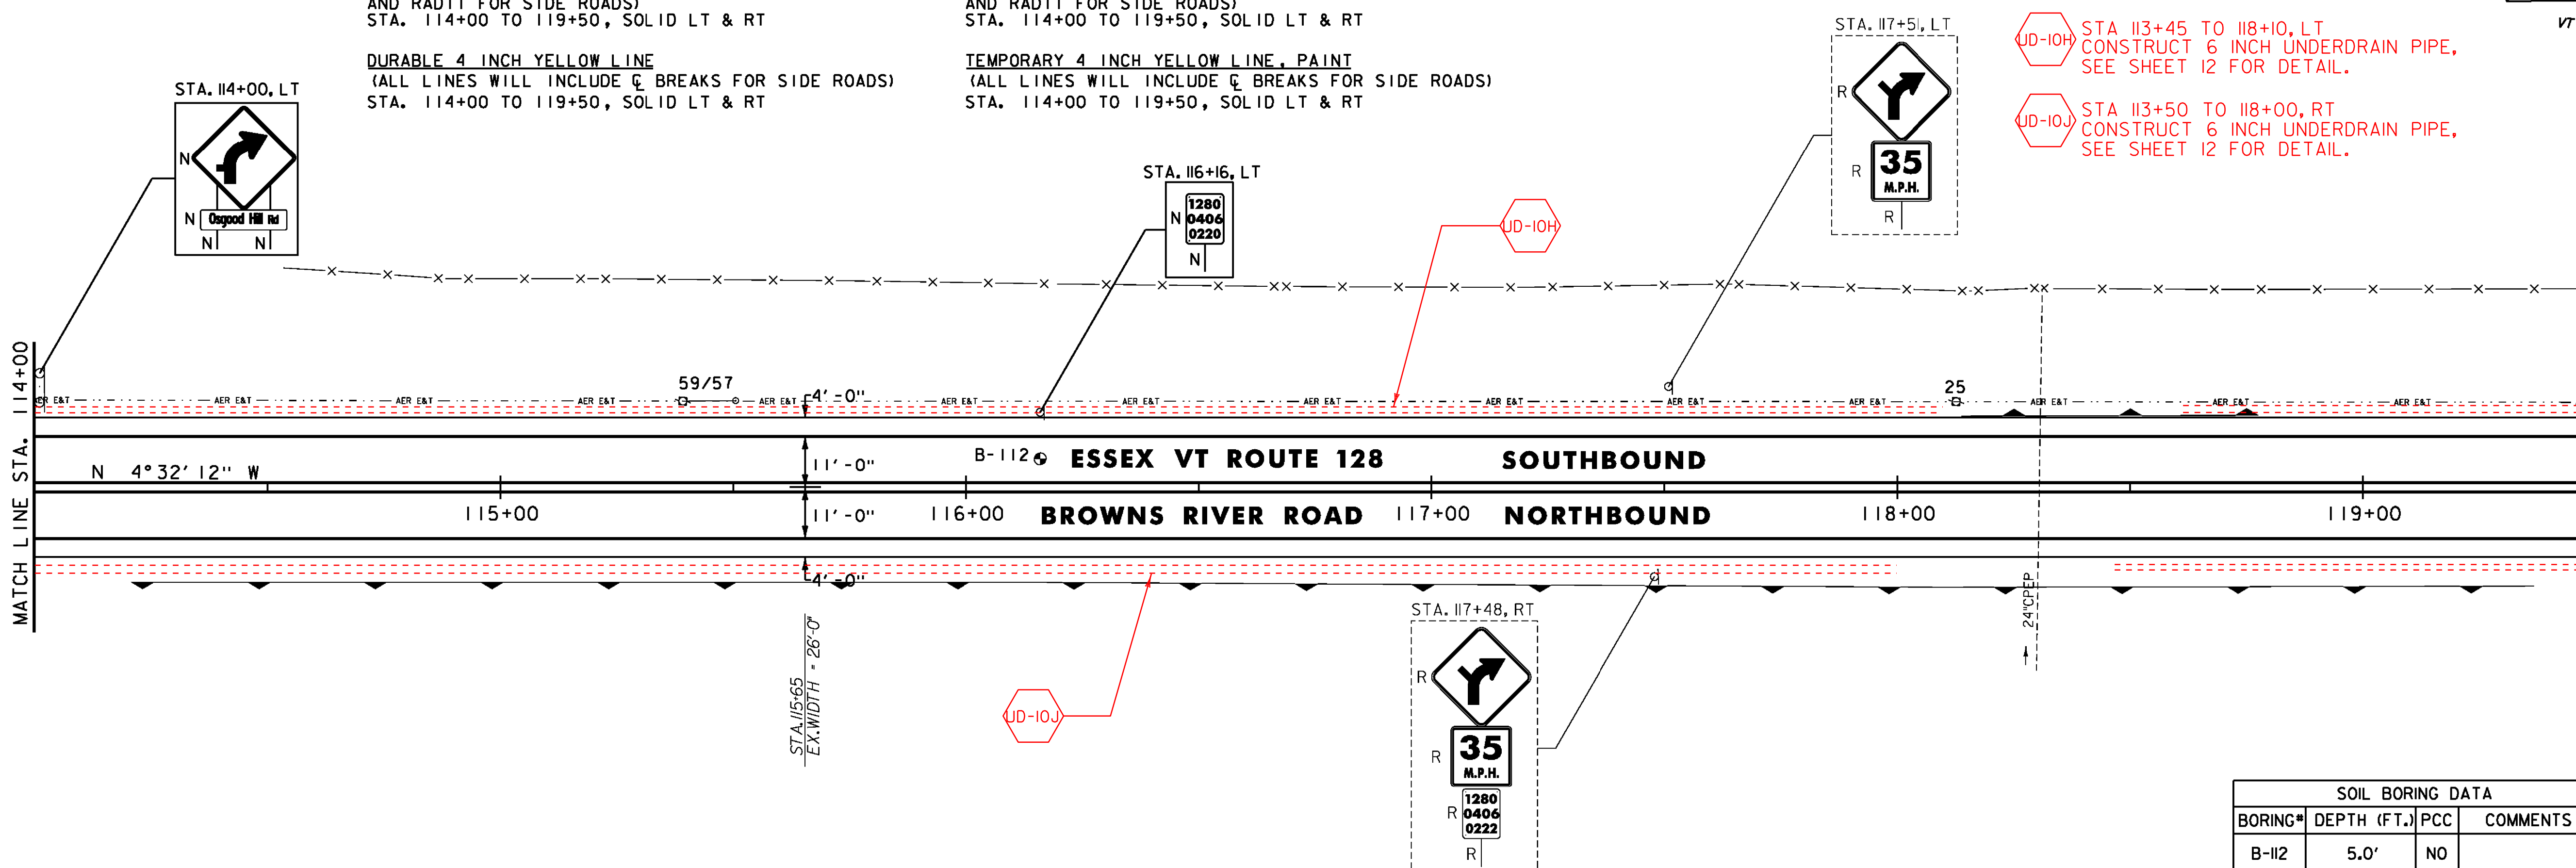

SOIL BORING DATA			
BORING#	DEPTH (FT.)	PCC	COMMENTS
B-112	5.0'	NO	

STONE FILL, TYPE J
 STA. 124+40 TO 124+70, LT

DURABLE 4 INCH WHITE LINE
 (ALL LINES WILL INCLUDE EDGE LINE BREAKS AND RADII FOR SIDE ROADS)
 STA. 119+50 TO 125+50, SOLID LT & RT

DURABLE 4 INCH YELLOW LINE
 (ALL LINES WILL INCLUDE C BREAKS FOR SIDE ROADS)
 STA. 119+50 TO 120+65, SOLID LT & RT
 STA. 120+65 TO 125+50, SOLID LT, DASHED RT

TEMPORARY 4 INCH WHITE LINE, PAINT
 (ALL LINES WILL INCLUDE EDGE LINE BREAKS AND RADII FOR SIDE ROADS)
 STA. 119+50 TO 125+50, SOLID LT & RT

TEMPORARY 4 INCH YELLOW LINE, PAINT
 (ALL LINES WILL INCLUDE C BREAKS FOR SIDE ROADS)
 STA. 119+50 TO 120+65, SOLID LT & RT
 STA. 120+65 TO 125+50, SOLID LT, DASHED RT


GEOTEXTILE UNDER STONE FILL
 STA. 124+40 TO 124+70, LT

GRUBBING MATERIAL
 STA. 124+40 TO 124+70, LT

REMOVING SIGNS
 AS SHOWN - 1

UD-10K STA 118+60 TO 125+10, LT
 CONSTRUCT 6 INCH UNDERDRAIN PIPE.

UD-10L STA 118+45 RT TO 124+90, LT
 CONSTRUCT 6 INCH UNDERDRAIN PIPE.

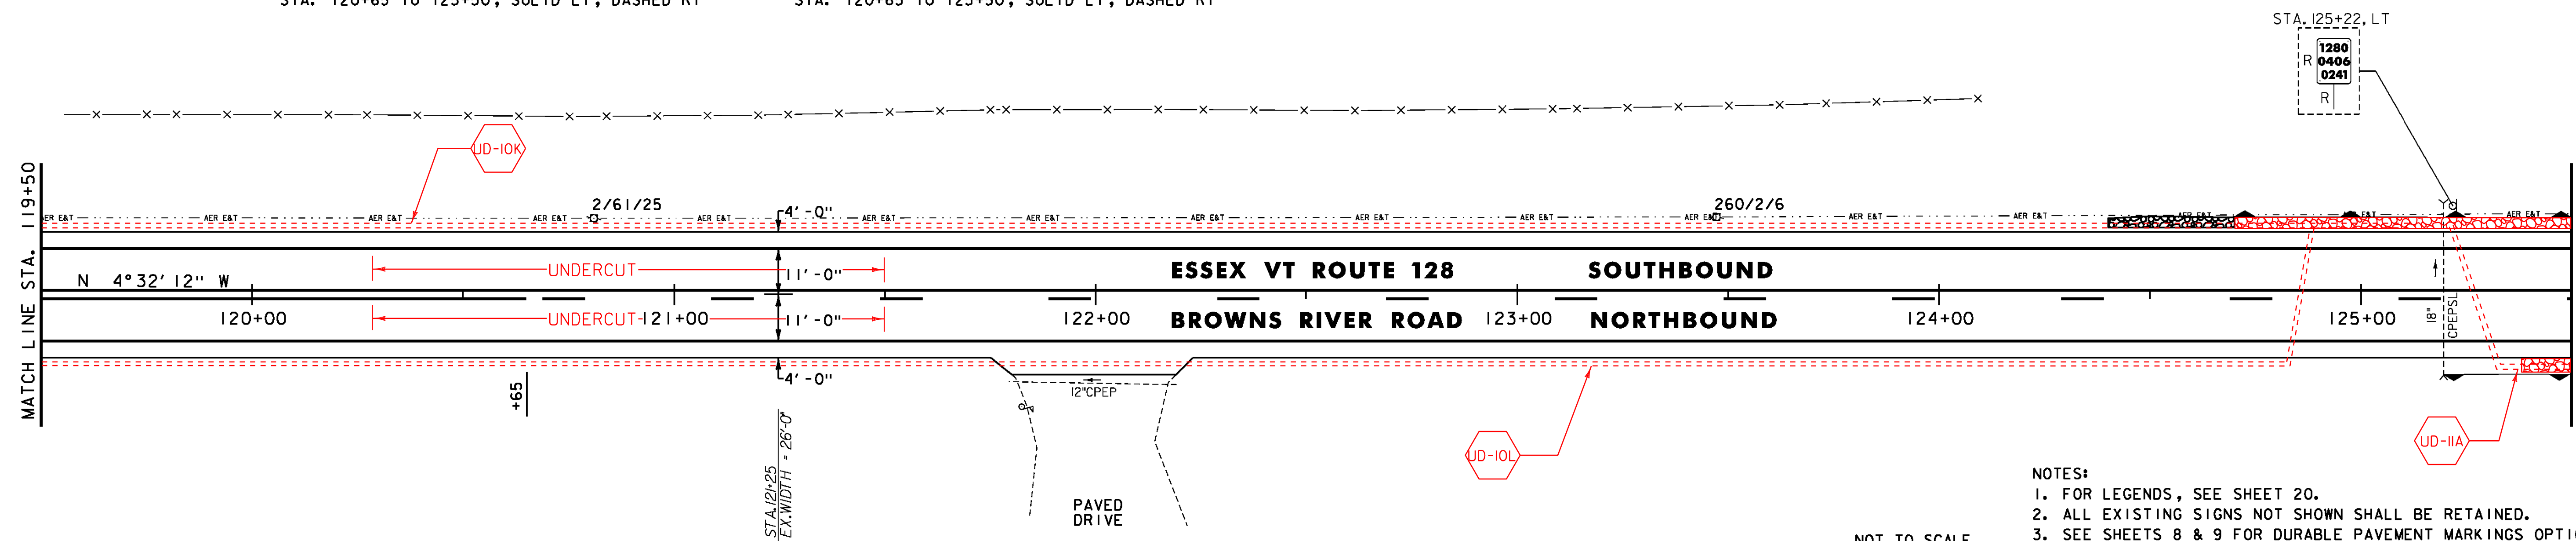

- NOTES:**
- FOR LEGENDS, SEE SHEET 20.
 - ALL EXISTING SIGNS NOT SHOWN SHALL BE RETAINED.
 - SEE SHEETS 8 & 9 FOR DURABLE PAVEMENT MARKINGS OPTIONS.

NOT TO SCALE

PROJECT LAYOUT SHEET #15



PROJECT NAME: ESSEX-WESTFORD
 PROJECT NUMBER: STP 2912(1)

FILE NAME: p10c226.dgn
 PROJECT LEADER: JLL
 DESIGNED BY: STANTEC
 IPARM FILE: p10c226115.i

PLOT DATE: 2/20/2013
 DRAWN BY: STANTEC
 CHECKED BY: STANTEC
 SHEET 34 OF 239