

STONE FILL, TYPE J
 STA. 139+10 TO 140+00, LT
 STA. 140+20 TO 141+00, LT
 STA. 142+64 TO 143+50, LT
 STA. 143+20 TO 143+50, RT

RELOCATE MAILBOX, SINGLE SUPPORT
 STA. 141+58, RT

DURABLE 4 INCH WHITE LINE
 (ALL LINES WILL INCLUDE EDGE LINE BREAKS
 AND RADII FOR SIDE ROADS)
 STA. 137+50 TO 143+50, SOLID LT & RT


DURABLE 4 INCH YELLOW LINE
 (ALL LINES WILL INCLUDE Q BREAKS FOR SIDE ROADS)
 STA. 137+50 TO 142+56, SOLID LT, DASHED RT
 STA. 142+56 TO 143+50, SOLID LT & RT

TEMPORARY 4 INCH WHITE LINE, PAINT
 (ALL LINES WILL INCLUDE EDGE LINE BREAKS
 AND RADII FOR SIDE ROADS)
 STA. 137+50 TO 143+50, SOLID LT & RT

TEMPORARY 4 INCH YELLOW LINE, PAINT
 (ALL LINES WILL INCLUDE Q BREAKS FOR SIDE ROADS)
 STA. 137+50 TO 142+56, SOLID LT, DASHED RT
 STA. 142+56 TO 143+50, SOLID LT & RT

GEOTEXTILE UNDER STONE FILL
 STA. 139+10 TO 140+00, LT
 STA. 140+20 TO 141+00, LT
 STA. 142+64 TO 143+50, LT
 STA. 143+20 TO 143+50, RT

REMOVING SIGNS
 AS SHOWN - 2

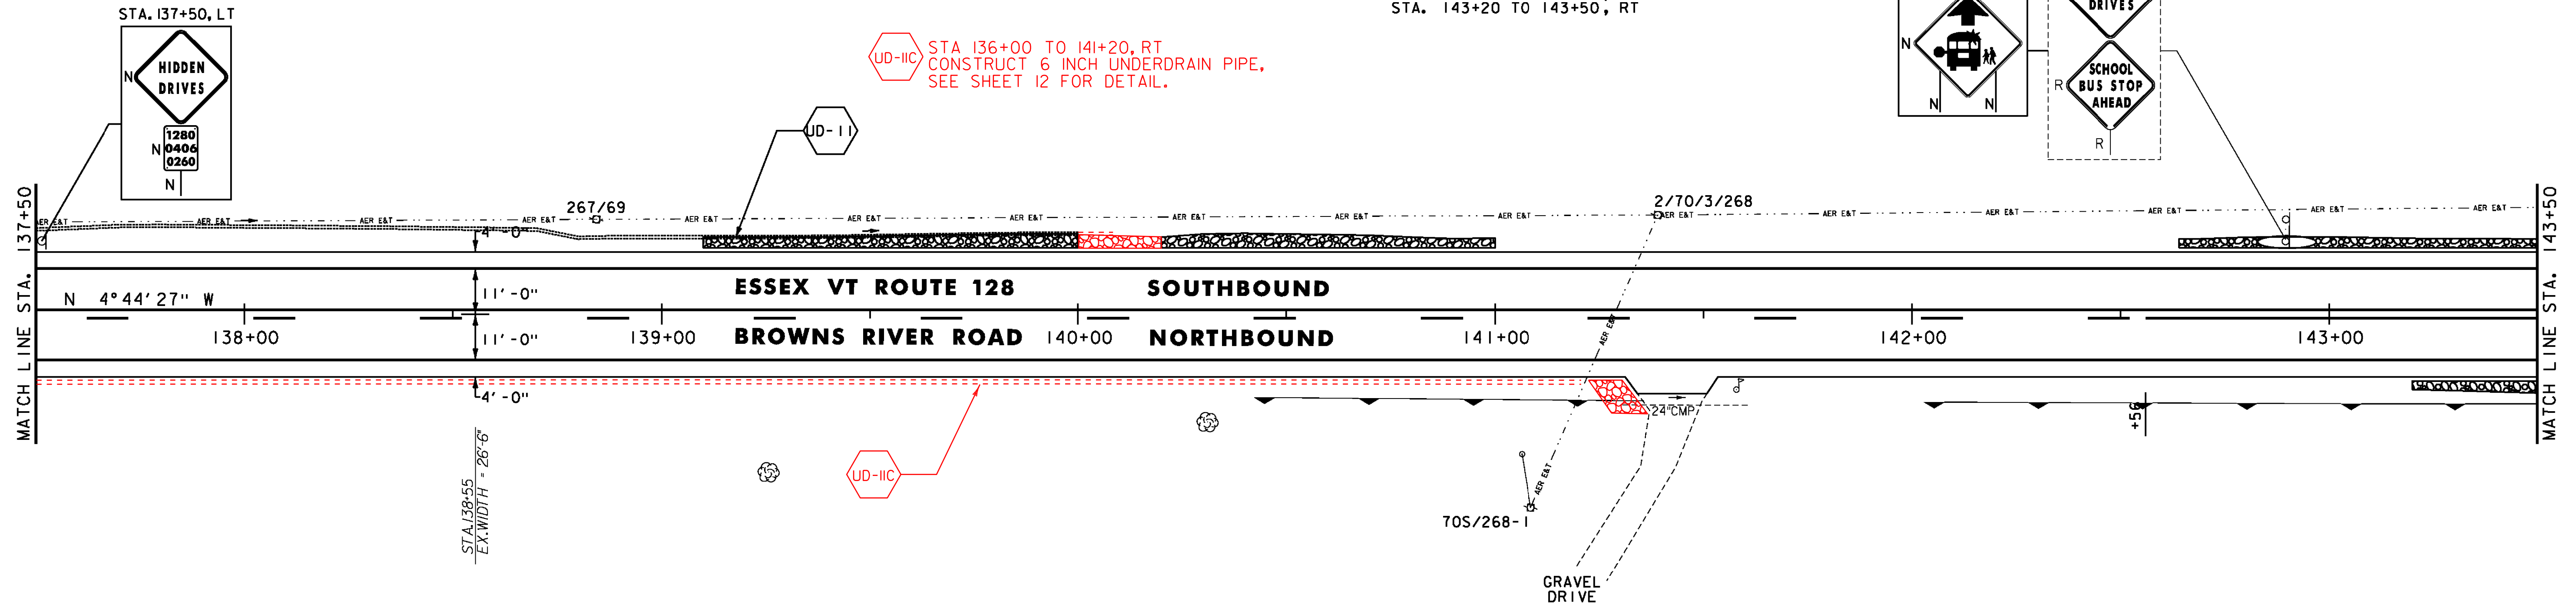

STONE FILL, TYPE J
 STA. 143+50 TO 143+80, LT
 STA. 143+50 TO 144+90, RT

RELOCATE MAILBOX, MULTIPLE SUPPORT
 STA. 147+65, LT

DURABLE 4 INCH WHITE LINE
 (ALL LINES WILL INCLUDE EDGE LINE BREAKS
 AND RADII FOR SIDE ROADS)
 STA. 143+50 TO 149+50, SOLID LT & RT



DURABLE 4 INCH YELLOW LINE
 (ALL LINES WILL INCLUDE Q BREAKS FOR SIDE ROADS)
 STA. 143+50 TO 149+50, SOLID LT & RT

TEMPORARY 4 INCH WHITE LINE, PAINT
 (ALL LINES WILL INCLUDE EDGE LINE BREAKS
 AND RADII FOR SIDE ROADS)
 STA. 143+50 TO 149+50, SOLID LT & RT

TEMPORARY 4 INCH YELLOW LINE, PAINT
 (ALL LINES WILL INCLUDE Q BREAKS FOR SIDE ROADS)
 STA. 143+50 TO 149+50, SOLID LT & RT

GEOTEXTILE UNDER STONE FILL
 STA. 143+50 TO 143+80, LT
 STA. 143+50 TO 144+90, RT

GRUBBING MATERIAL
 STA. 143+50 TO 143+80, LT
 STA. 143+50 TO 144+90, RT

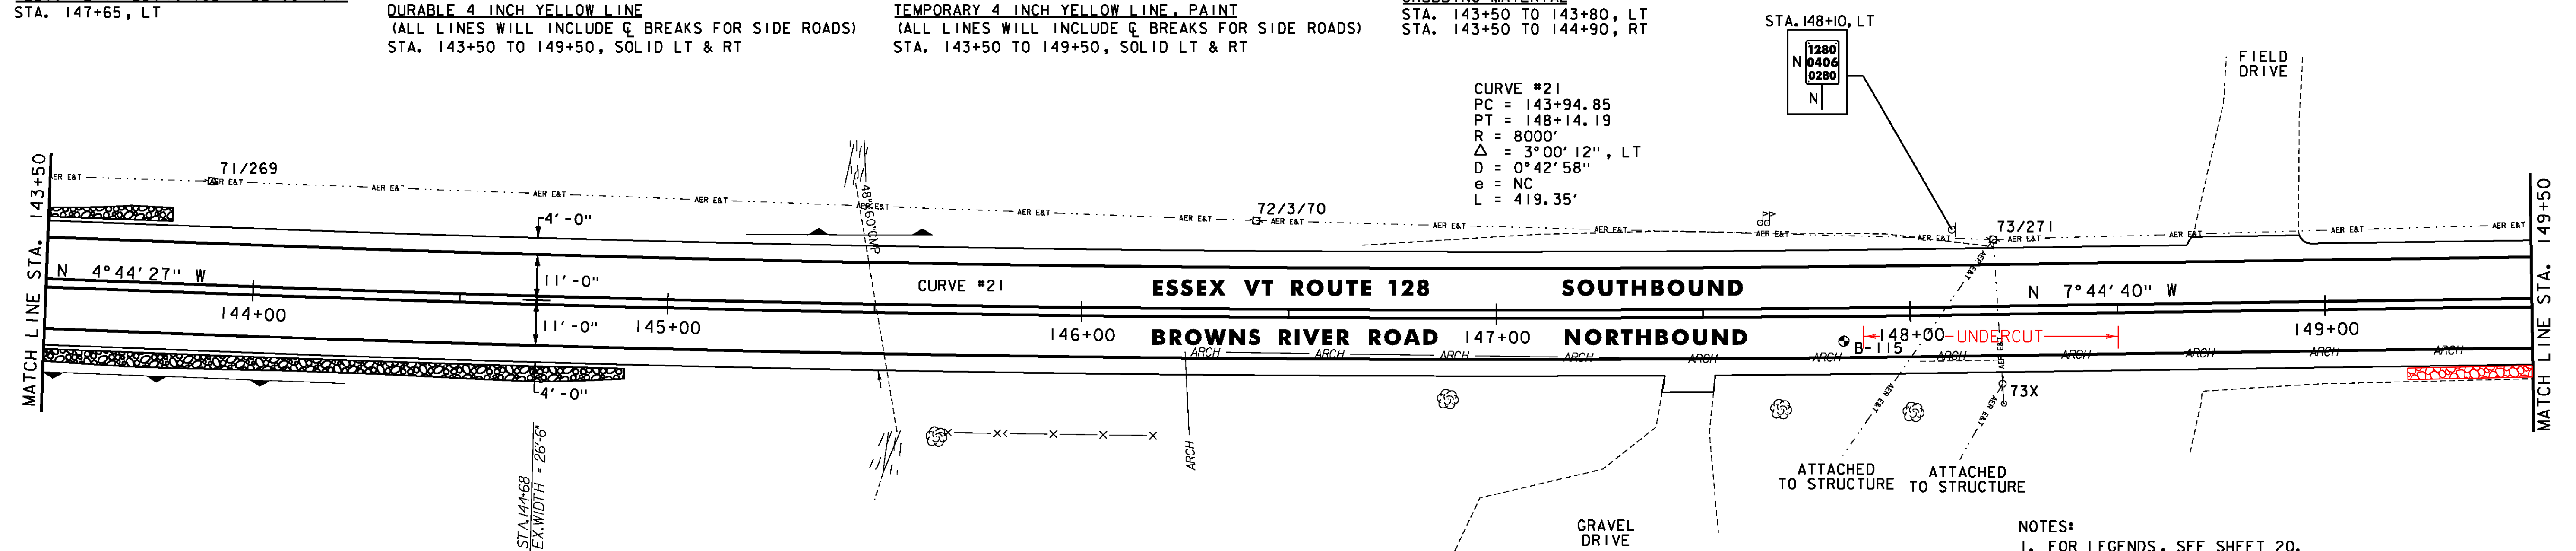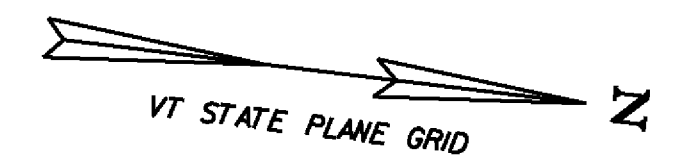

- NOTES:
1. FOR LEGENDS, SEE SHEET 20.
 2. ALL EXISTING SIGNS NOT SHOWN SHALL BE RETAINED.
 3. SEE SHEETS 8 & 9 FOR DURABLE PAVEMENT MARKINGS OPTIONS.

NOT TO SCALE

PROJECT LAYOUT SHEET #17

PROJECT NAME: ESSEX-WESTFORD
 PROJECT NUMBER: STP 2912(1)

FILE NAME: p10c226.dgn
 PROJECT LEADER: JLL
 DESIGNED BY: STANTEC
 IPARM FILE: p10c226117.i

PLOT DATE: 2/20/2013
 DRAWN BY: STANTEC
 CHECKED BY: STANTEC
 SHEET 36 OF 239

SOIL BORING DATA			
BORING#	DEPTH (FT.)	PCC	COMMENTS
B-115	5.0'	NO	

