


RELOCATE MAILBOX, SINGLE SUPPORT
STA. 153+64, RT

DURABLE 4 INCH WHITE LINE
(ALL LINES WILL INCLUDE EDGE LINE BREAKS
AND RADII FOR SIDE ROADS)
STA. 149+50 TO 155+50, SOLID LT & RT

TEMPORARY 4 INCH WHITE LINE, PAINT
(ALL LINES WILL INCLUDE EDGE LINE BREAKS
AND RADII FOR SIDE ROADS)
STA. 149+50 TO 155+50, SOLID LT & RT

DURABLE 4 INCH YELLOW LINE
(ALL LINES WILL INCLUDE ϕ BREAKS FOR SIDE ROADS)
STA. 149+50 TO 155+50, SOLID LT & RT

TEMPORARY 4 INCH YELLOW LINE, PAINT
(ALL LINES WILL INCLUDE ϕ BREAKS FOR SIDE ROADS)
STA. 149+50 TO 155+50, SOLID LT & RT

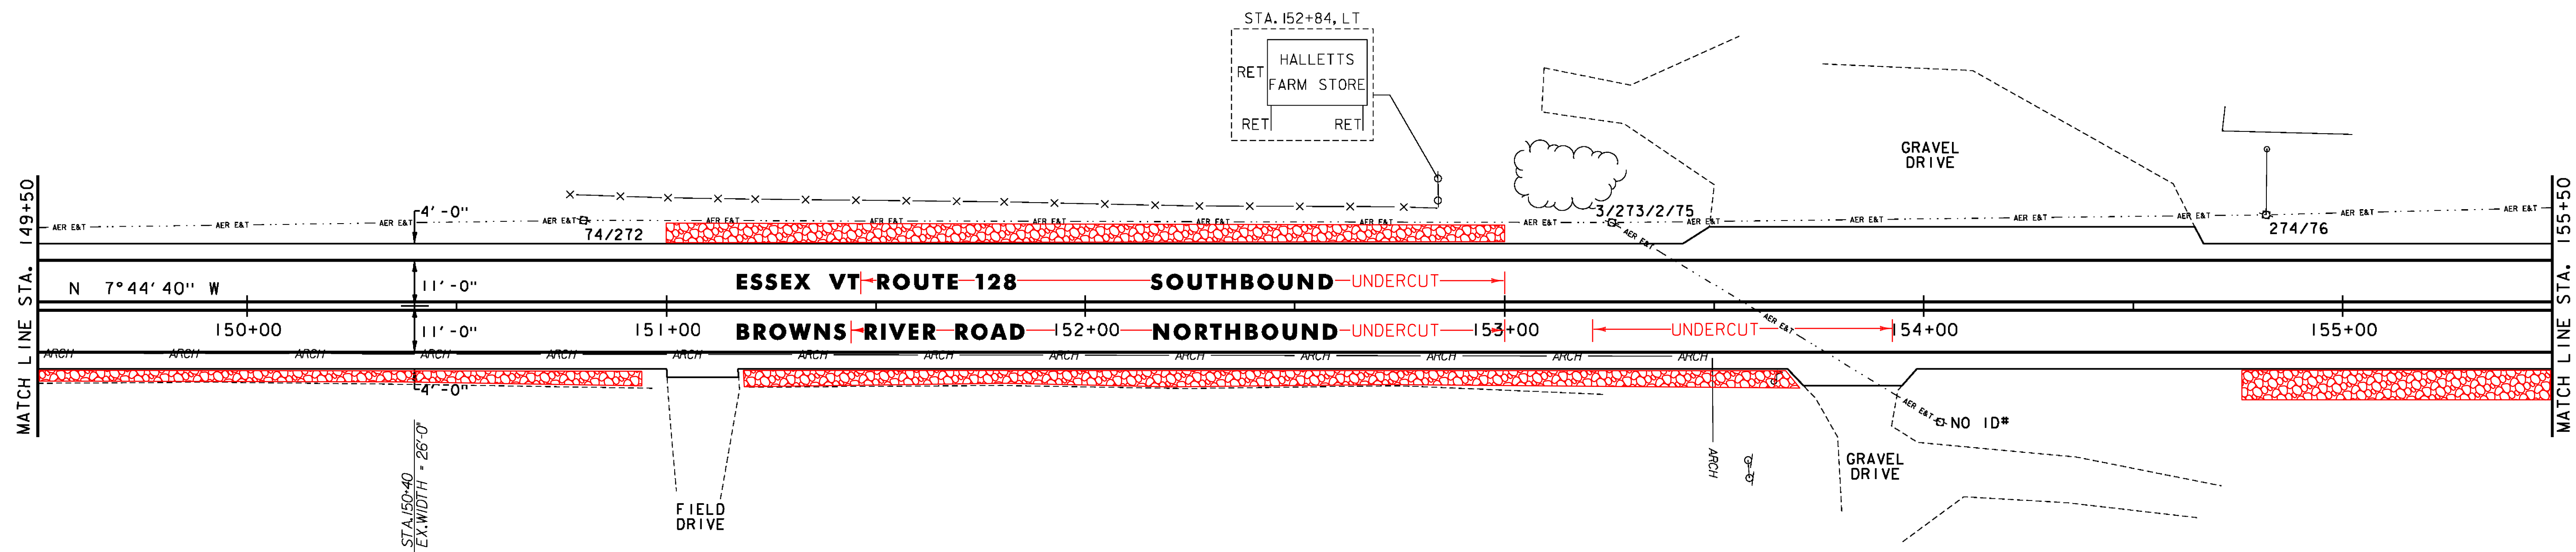

STONE FILL, TYPE I
STA. 156+20 TO 157+60, RT
STA. 156+50 TO 156+70, LT
STA. 157+30 TO 160+30, LT
STA. 158+00 TO 159+00, RT

DURABLE 4 INCH WHITE LINE
(ALL LINES WILL INCLUDE EDGE LINE BREAKS
AND RADII FOR SIDE ROADS)
STA. 155+50 TO 161+50, SOLID LT & RT

TEMPORARY 4 INCH WHITE LINE, PAINT
(ALL LINES WILL INCLUDE EDGE LINE BREAKS
AND RADII FOR SIDE ROADS)
STA. 155+50 TO 161+50, SOLID LT & RT


GEOTEXTILE UNDER STONE FILL
STA. 156+20 TO 157+60, RT
STA. 156+50 TO 156+70, LT
STA. 157+30 TO 160+30, LT
STA. 158+00 TO 159+00, RT

RELOCATE MAILBOX, SINGLE SUPPORT
STA. 157+69, RT
STA. 161+00, LT


DURABLE 4 INCH YELLOW LINE
(ALL LINES WILL INCLUDE ϕ BREAKS FOR SIDE ROADS)
STA. 155+50 TO 161+50, SOLID LT & RT

TEMPORARY 4 INCH YELLOW LINE, PAINT
(ALL LINES WILL INCLUDE ϕ BREAKS FOR SIDE ROADS)
STA. 155+50 TO 161+50, SOLID LT & RT

GRUBBING MATERIAL
STA. 156+20 TO 157+60, RT
STA. 156+50 TO 156+70, LT
STA. 157+30 TO 160+30, LT
STA. 158+00 TO 159+00, RT

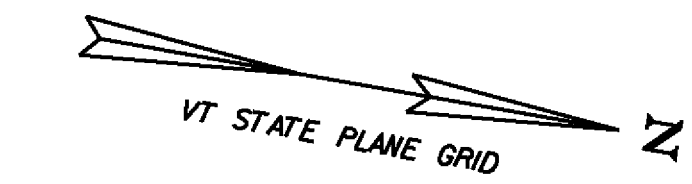

CURVE #22
PC = 156+31.49
PRC = 163+37.36
R = 6925'
 Δ = 5° 50' 25", LT
D = 0° 49' 39"
e = 2.0%
L = 705.87'
SEE SHEET 76

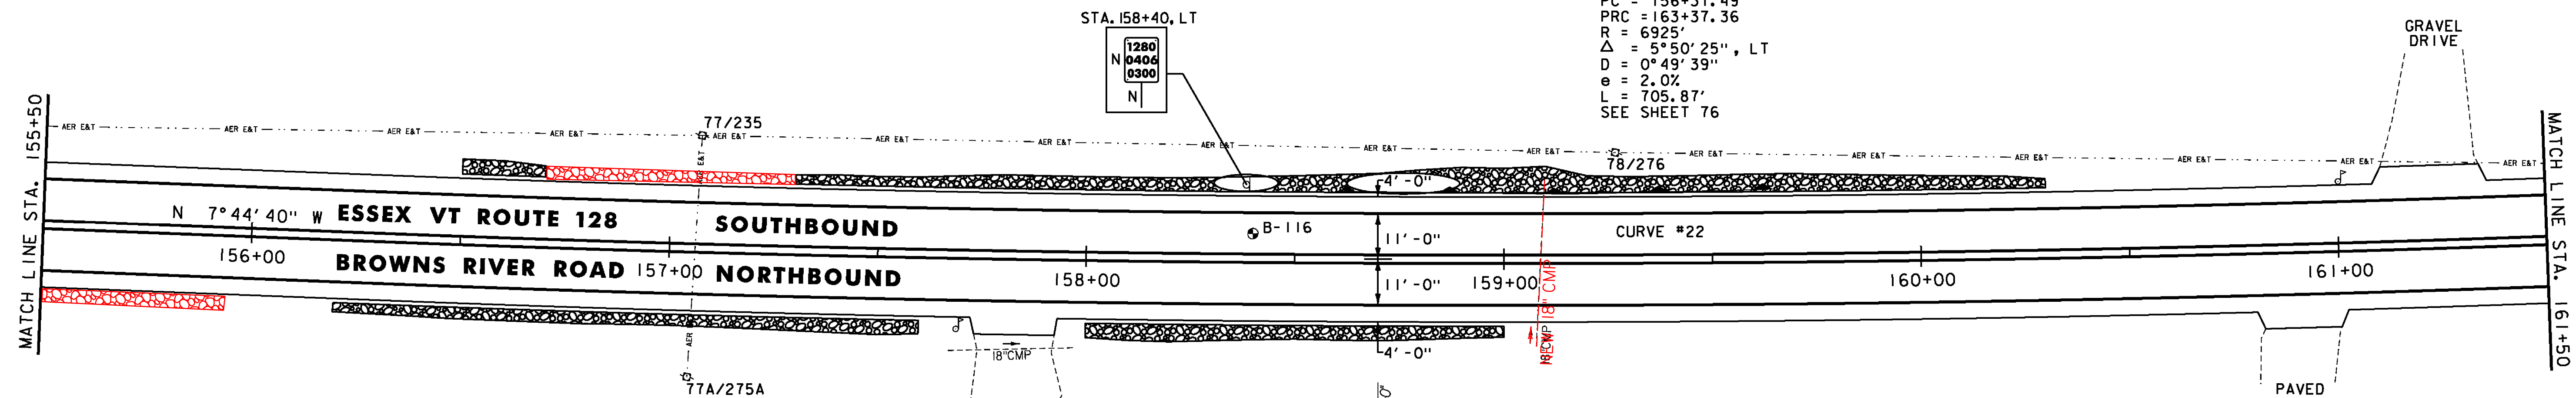

- NOTES:
1. FOR LEGENDS, SEE SHEET 20.
 2. ALL EXISTING SIGNS NOT SHOWN SHALL BE RETAINED.
 3. SEE SHEETS 8 & 9 FOR DURABLE PAVEMENT MARKINGS OPTIONS.

NOT TO SCALE

PROJECT LAYOUT SHEET #18

PROJECT NAME: ESSEX-WESTFORD
PROJECT NUMBER: STP 2912(I)

FILE NAME: p10c226.dgn
DESIGNED BY: STANTEC
IPARM FILE: p10c226118.i

PLOT DATE: 2/20/2013
DRAWN BY: STANTEC
CHECKED BY: STANTEC
SHEET 37 OF 239

SOIL BORING DATA			
BORING#	DEPTH (FT.)	PCC	COMMENTS
B-116	5.0'	NO	

