




22+00.00

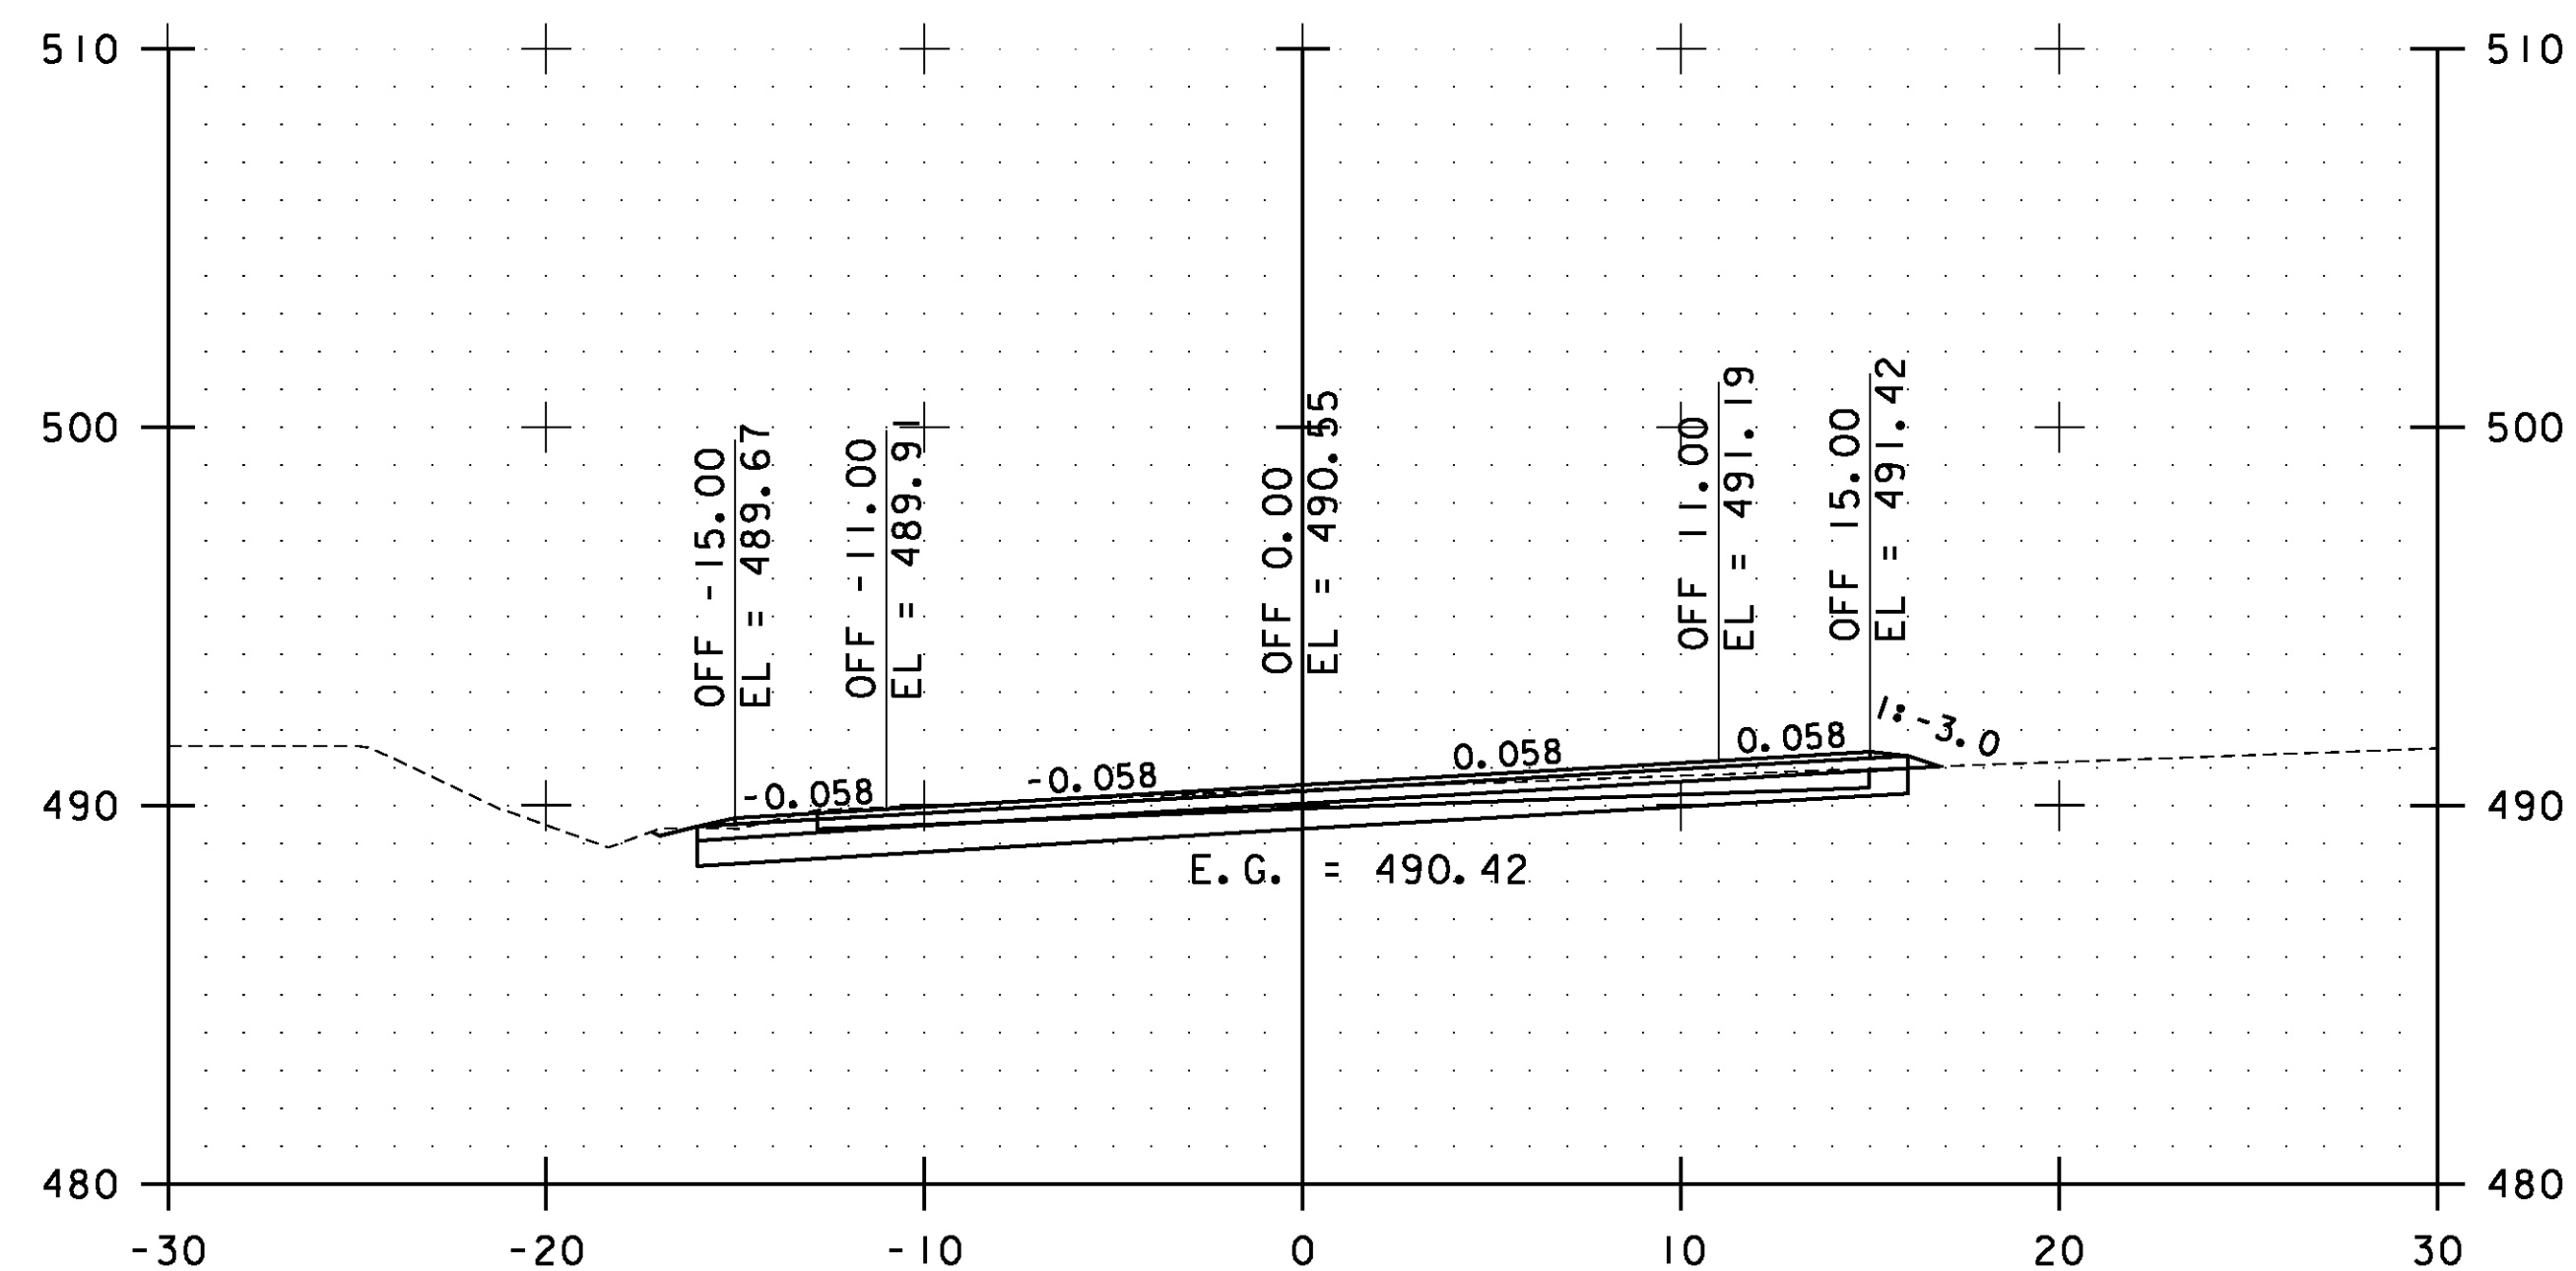

21+50.00

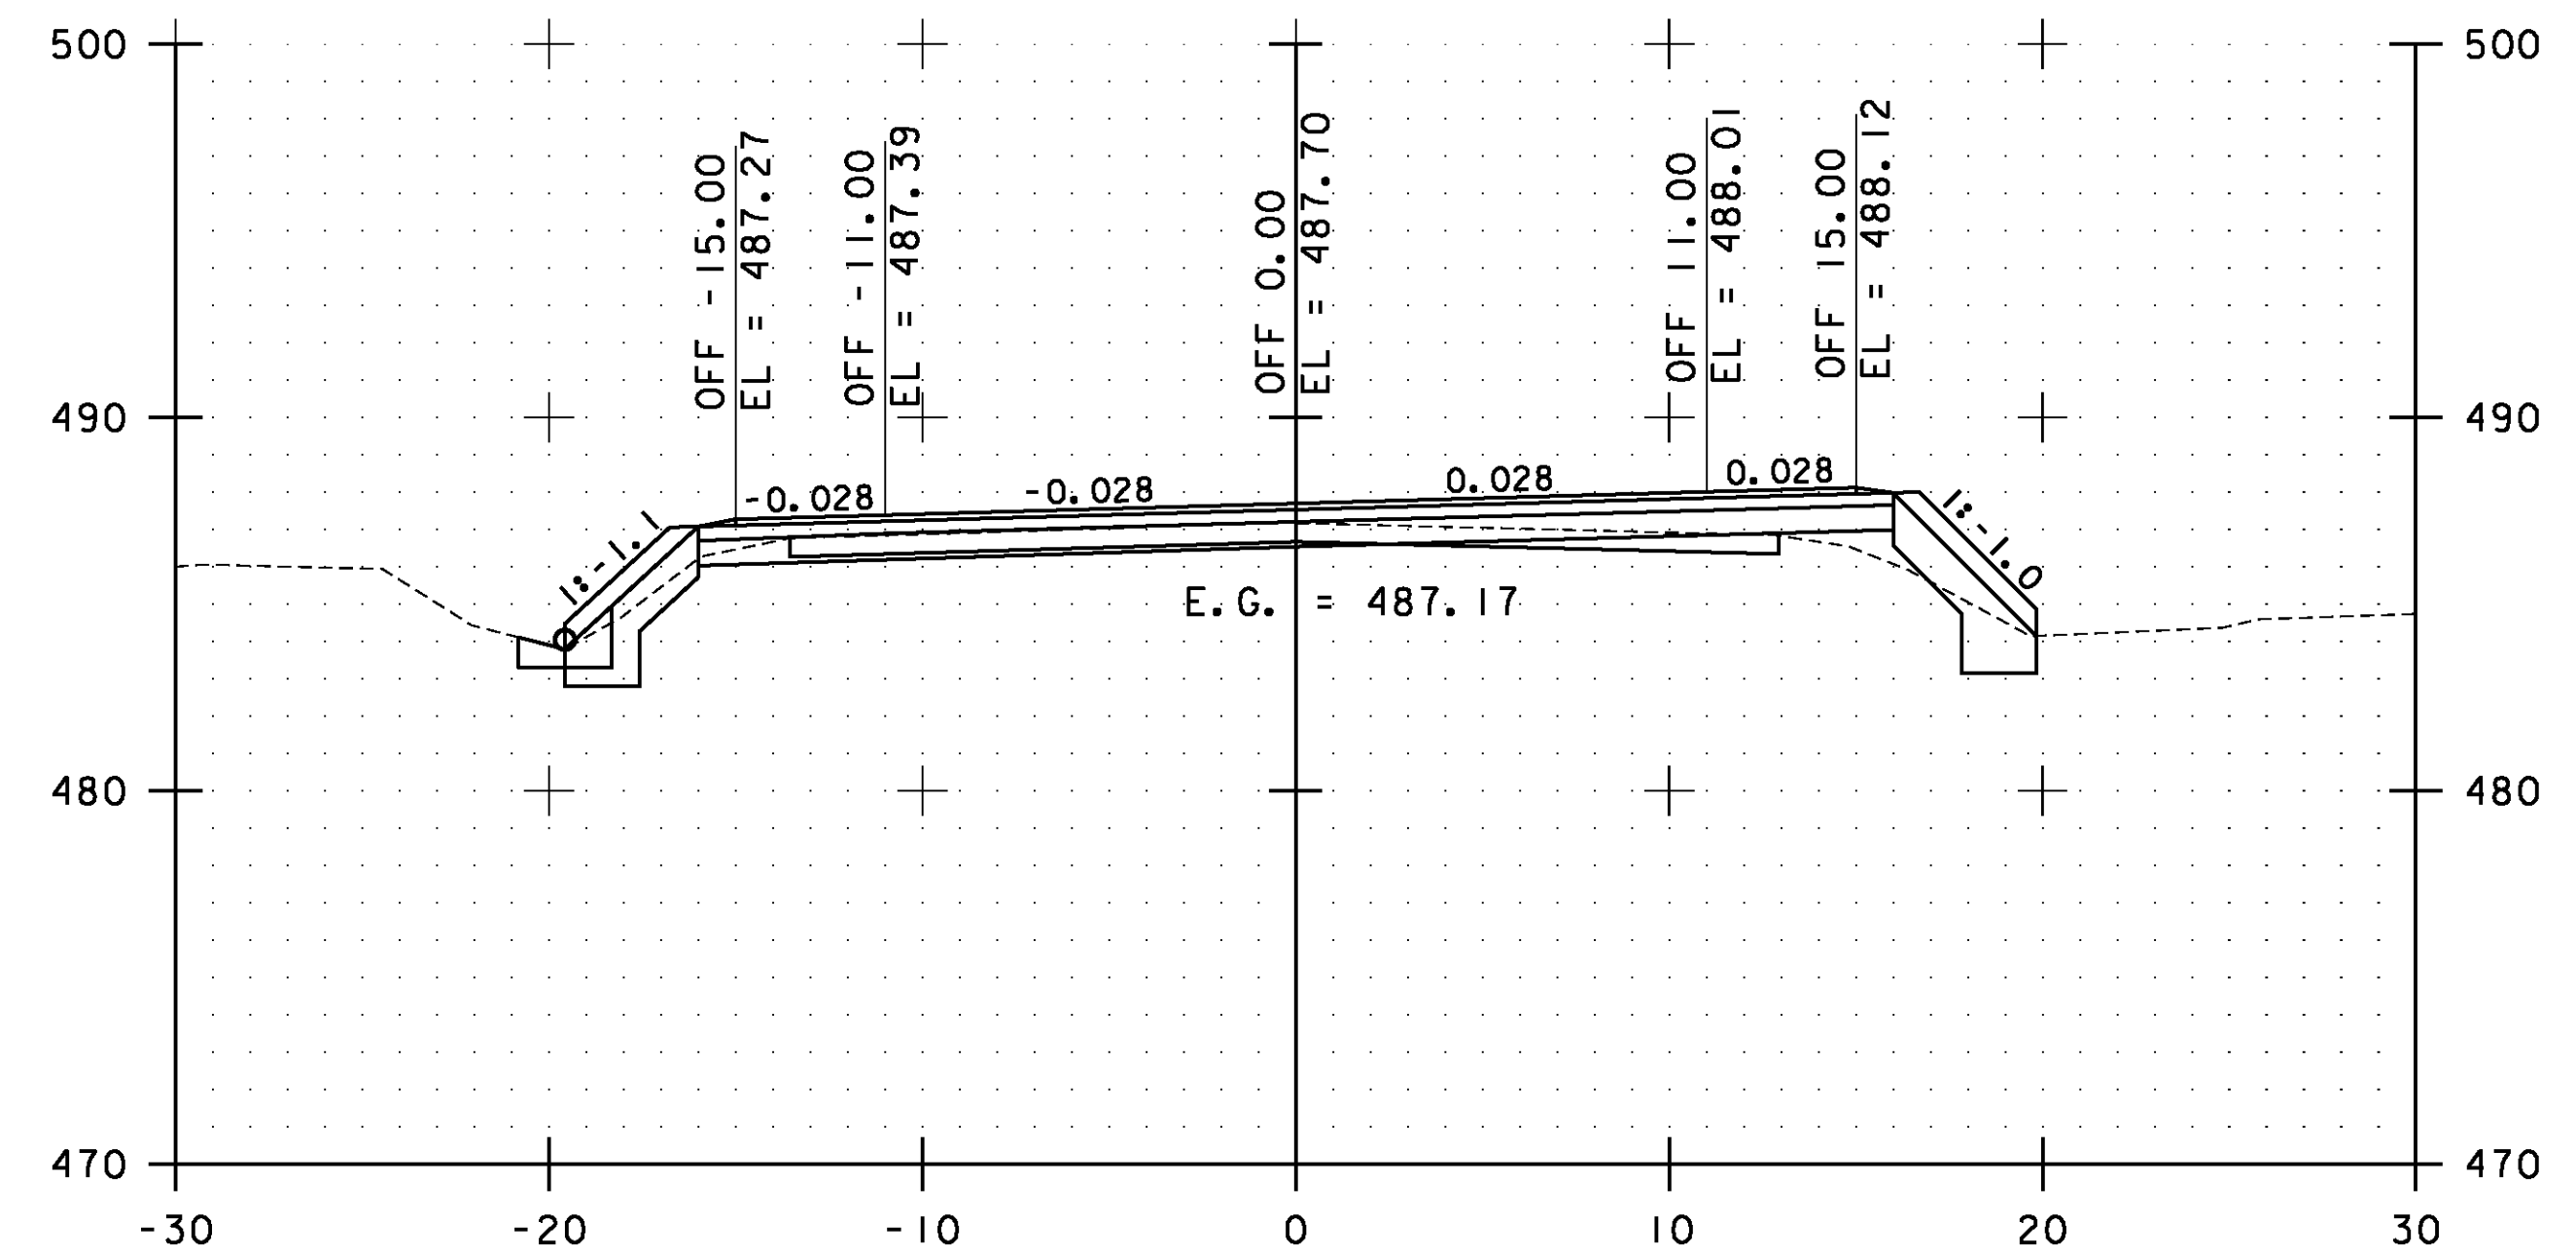


23+00.00

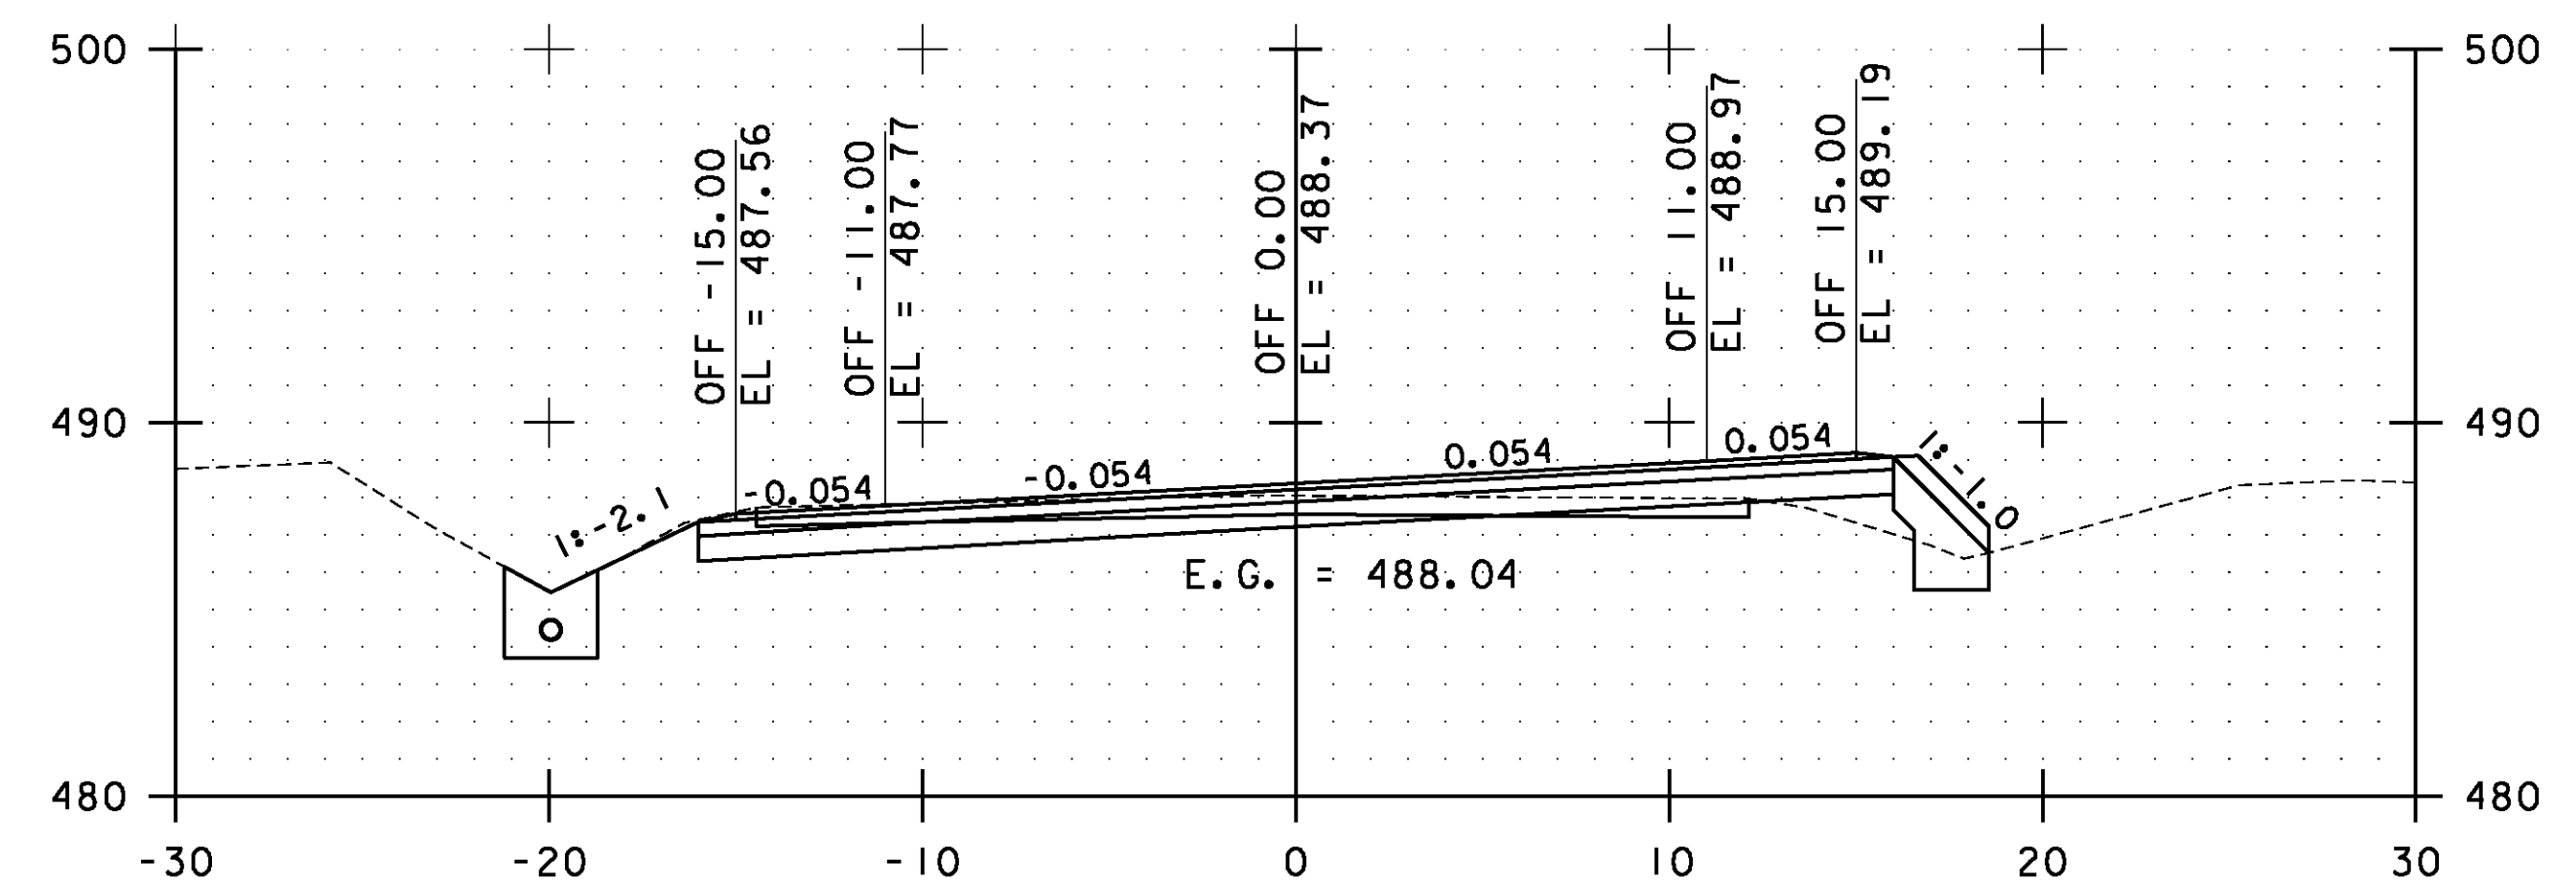

22+50.00

STA. 21+50.00 TO STA. 23+00.00

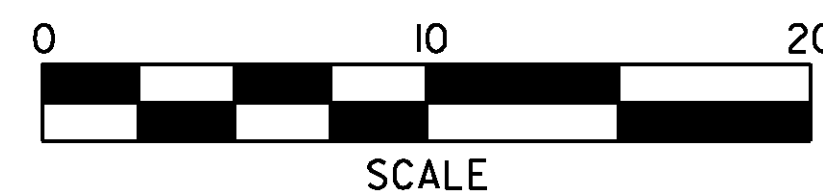

**ESSEX
CROSS
SECTIONS
SHEET #6**

PROJECT NAME: ESSEX-WESTFORD
PROJECT NUMBER: STP 2912(I)

FILE NAME: p10c226.dgn
PROJECT LEADER: JLL
DESIGNED BY: STANTEC
IPARM FILE: p10c226xs006.i

PLOT DATE: 2/20/2013
DRAWN BY: STANTEC
CHECKED BY: STANTEC
SHEET 97 OF 239