




28+00.00

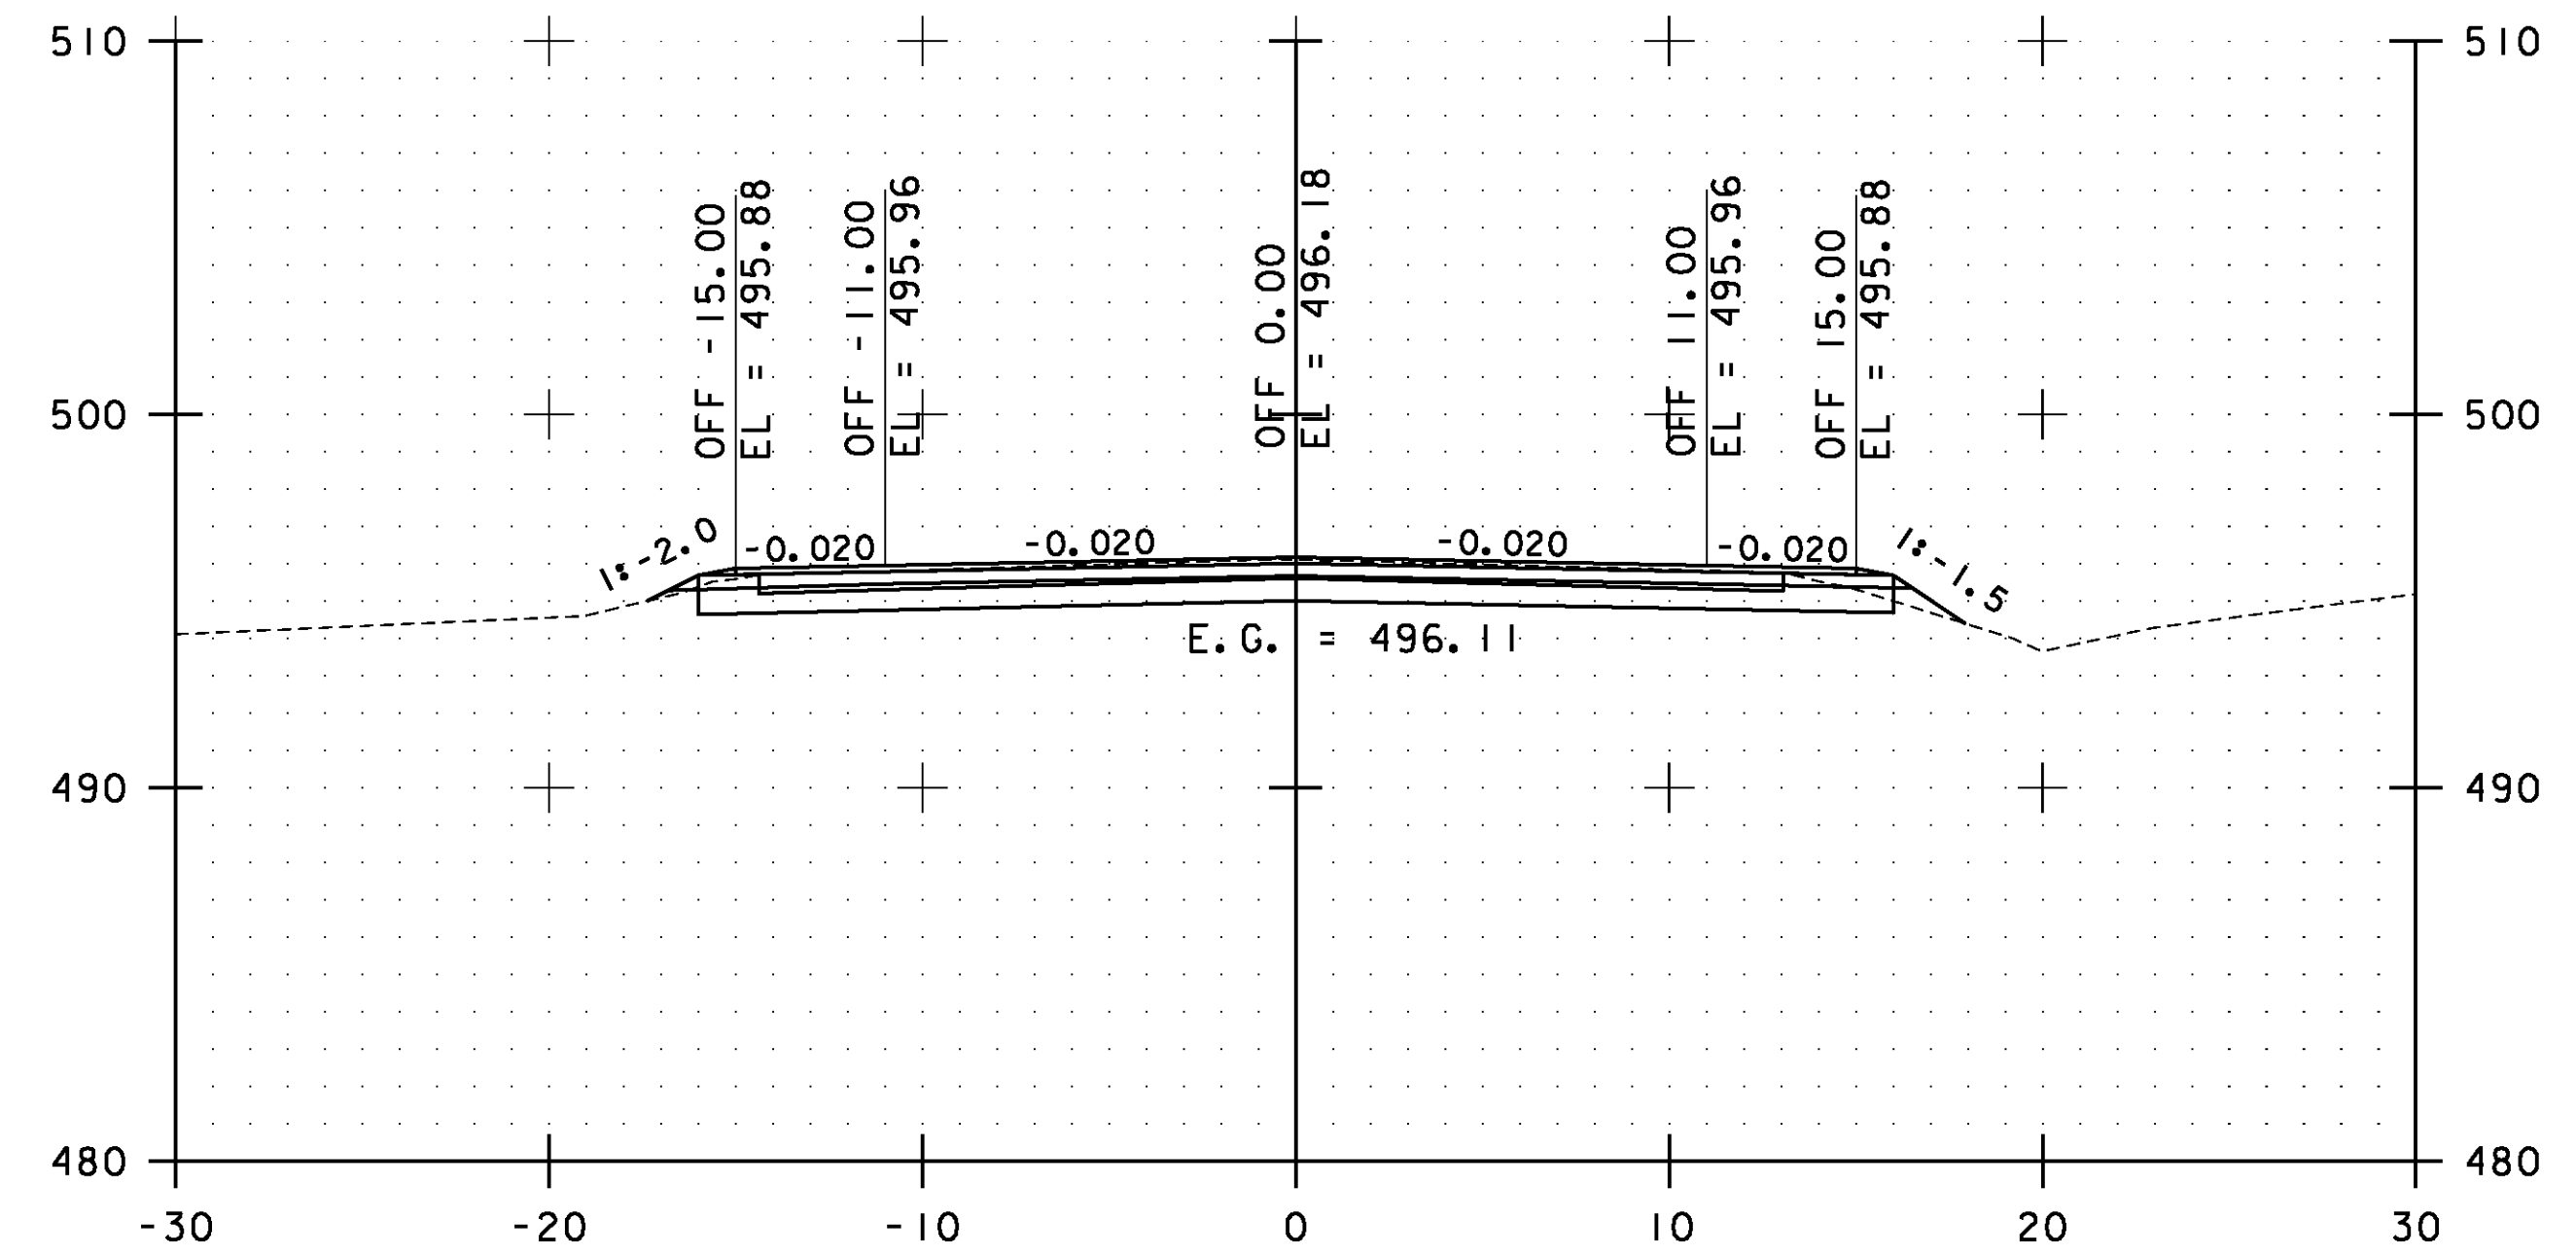

29+00.00

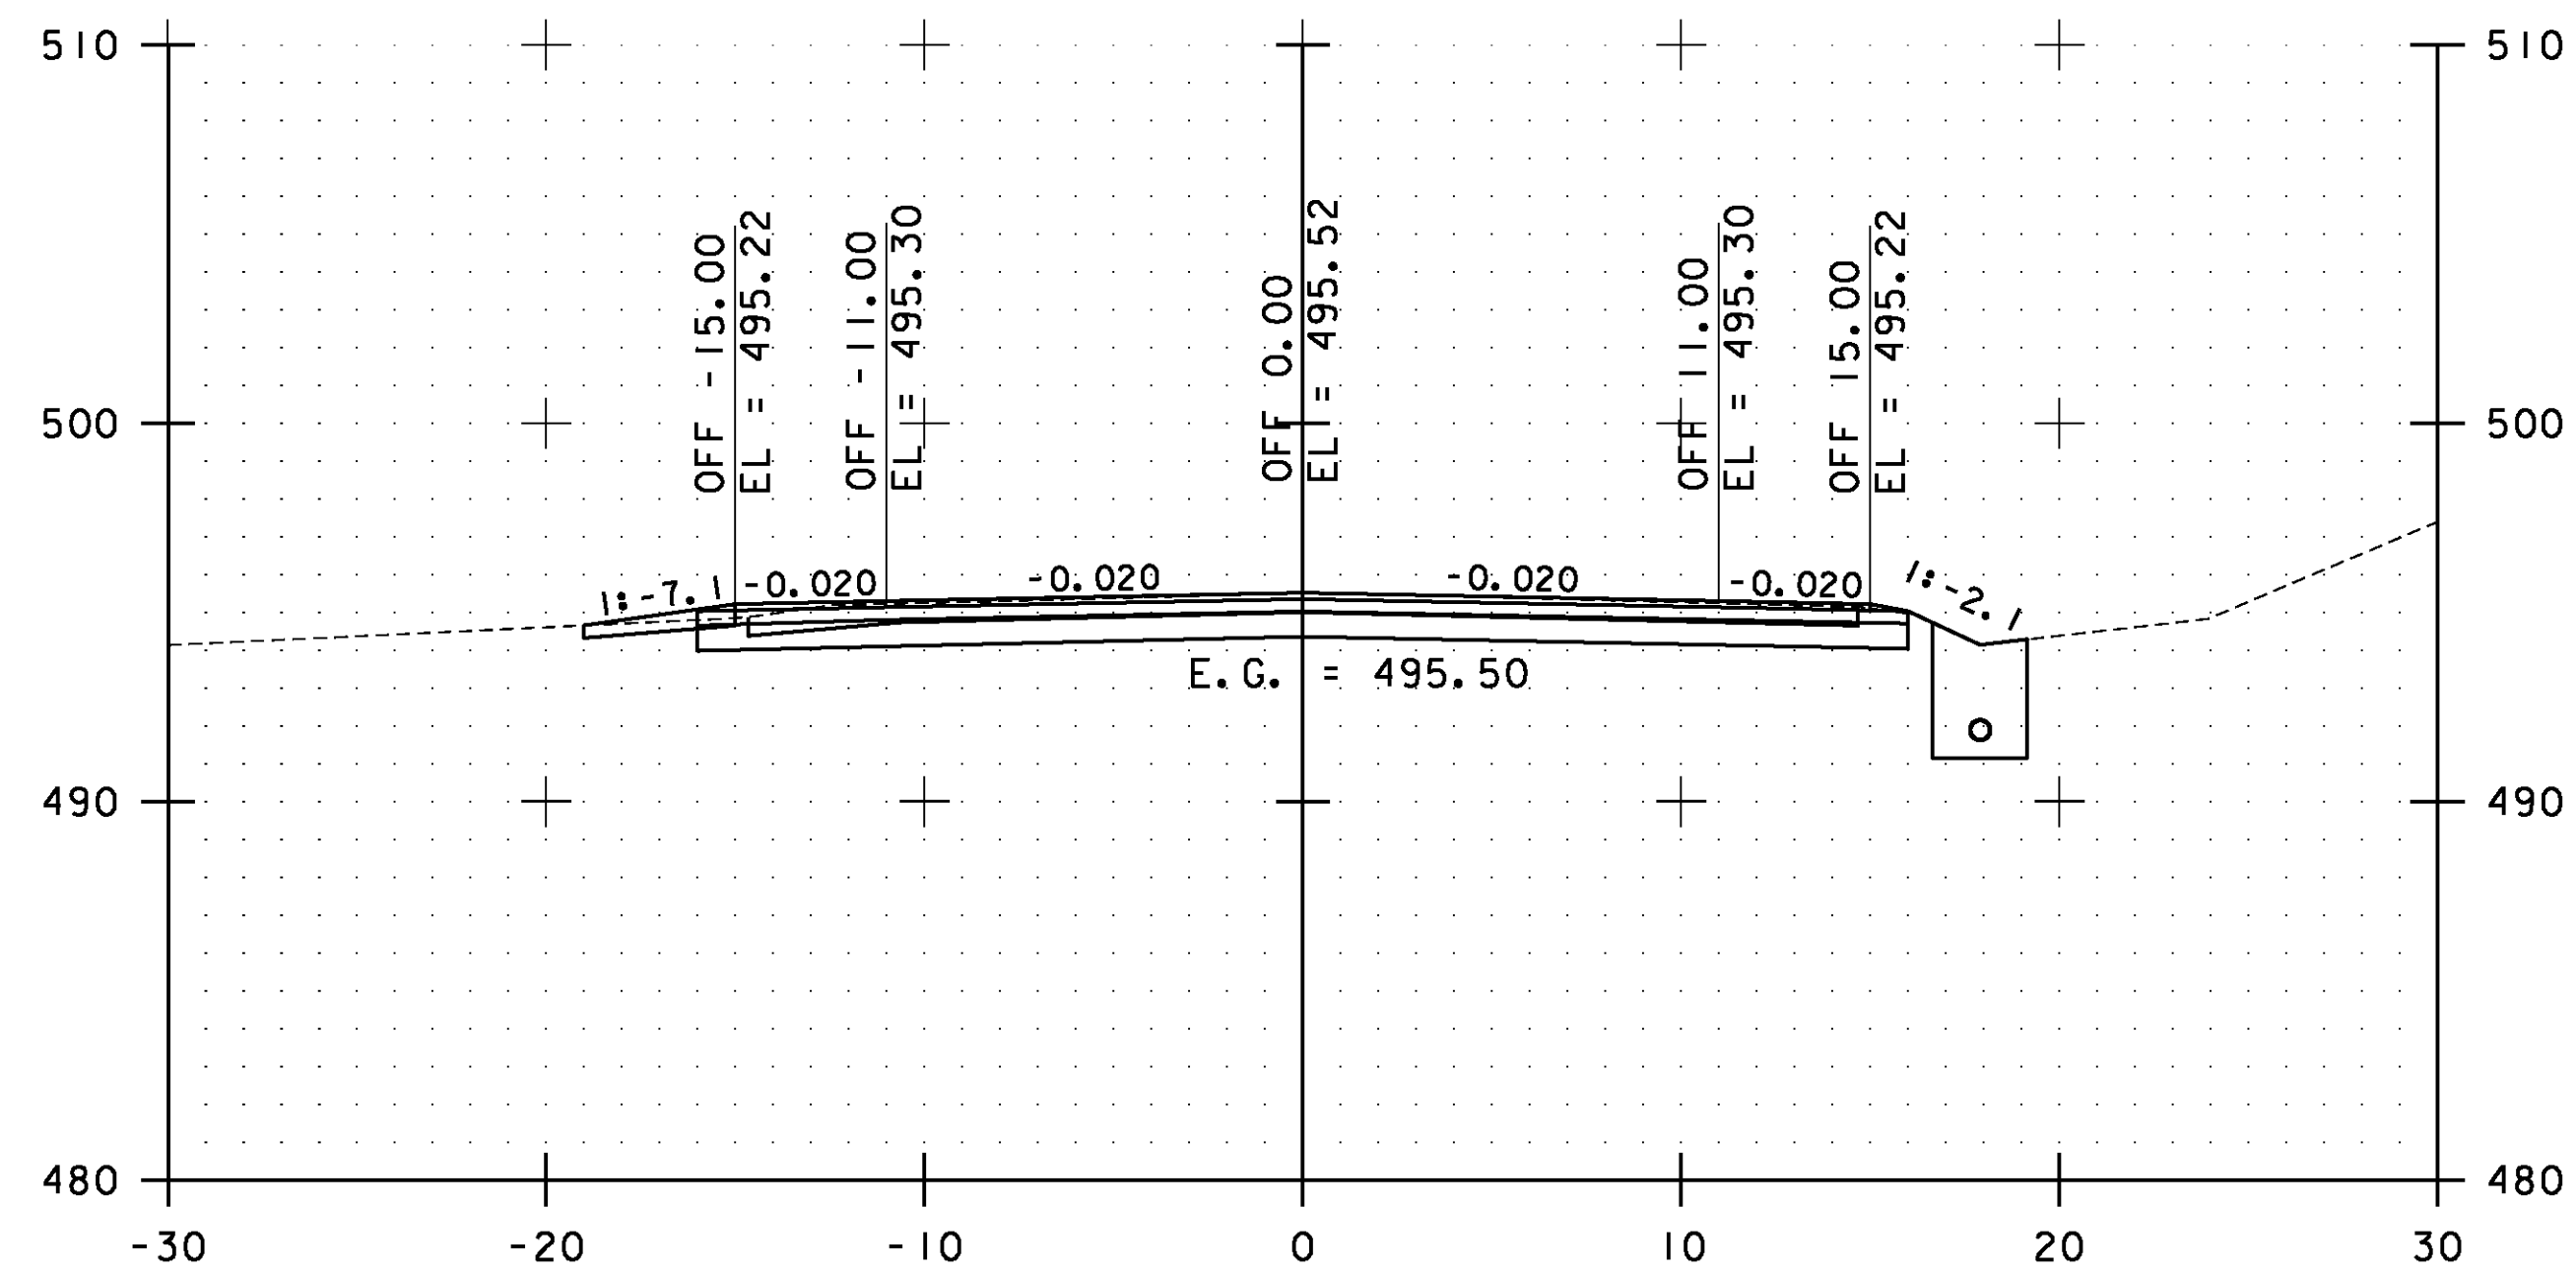

27+50.00

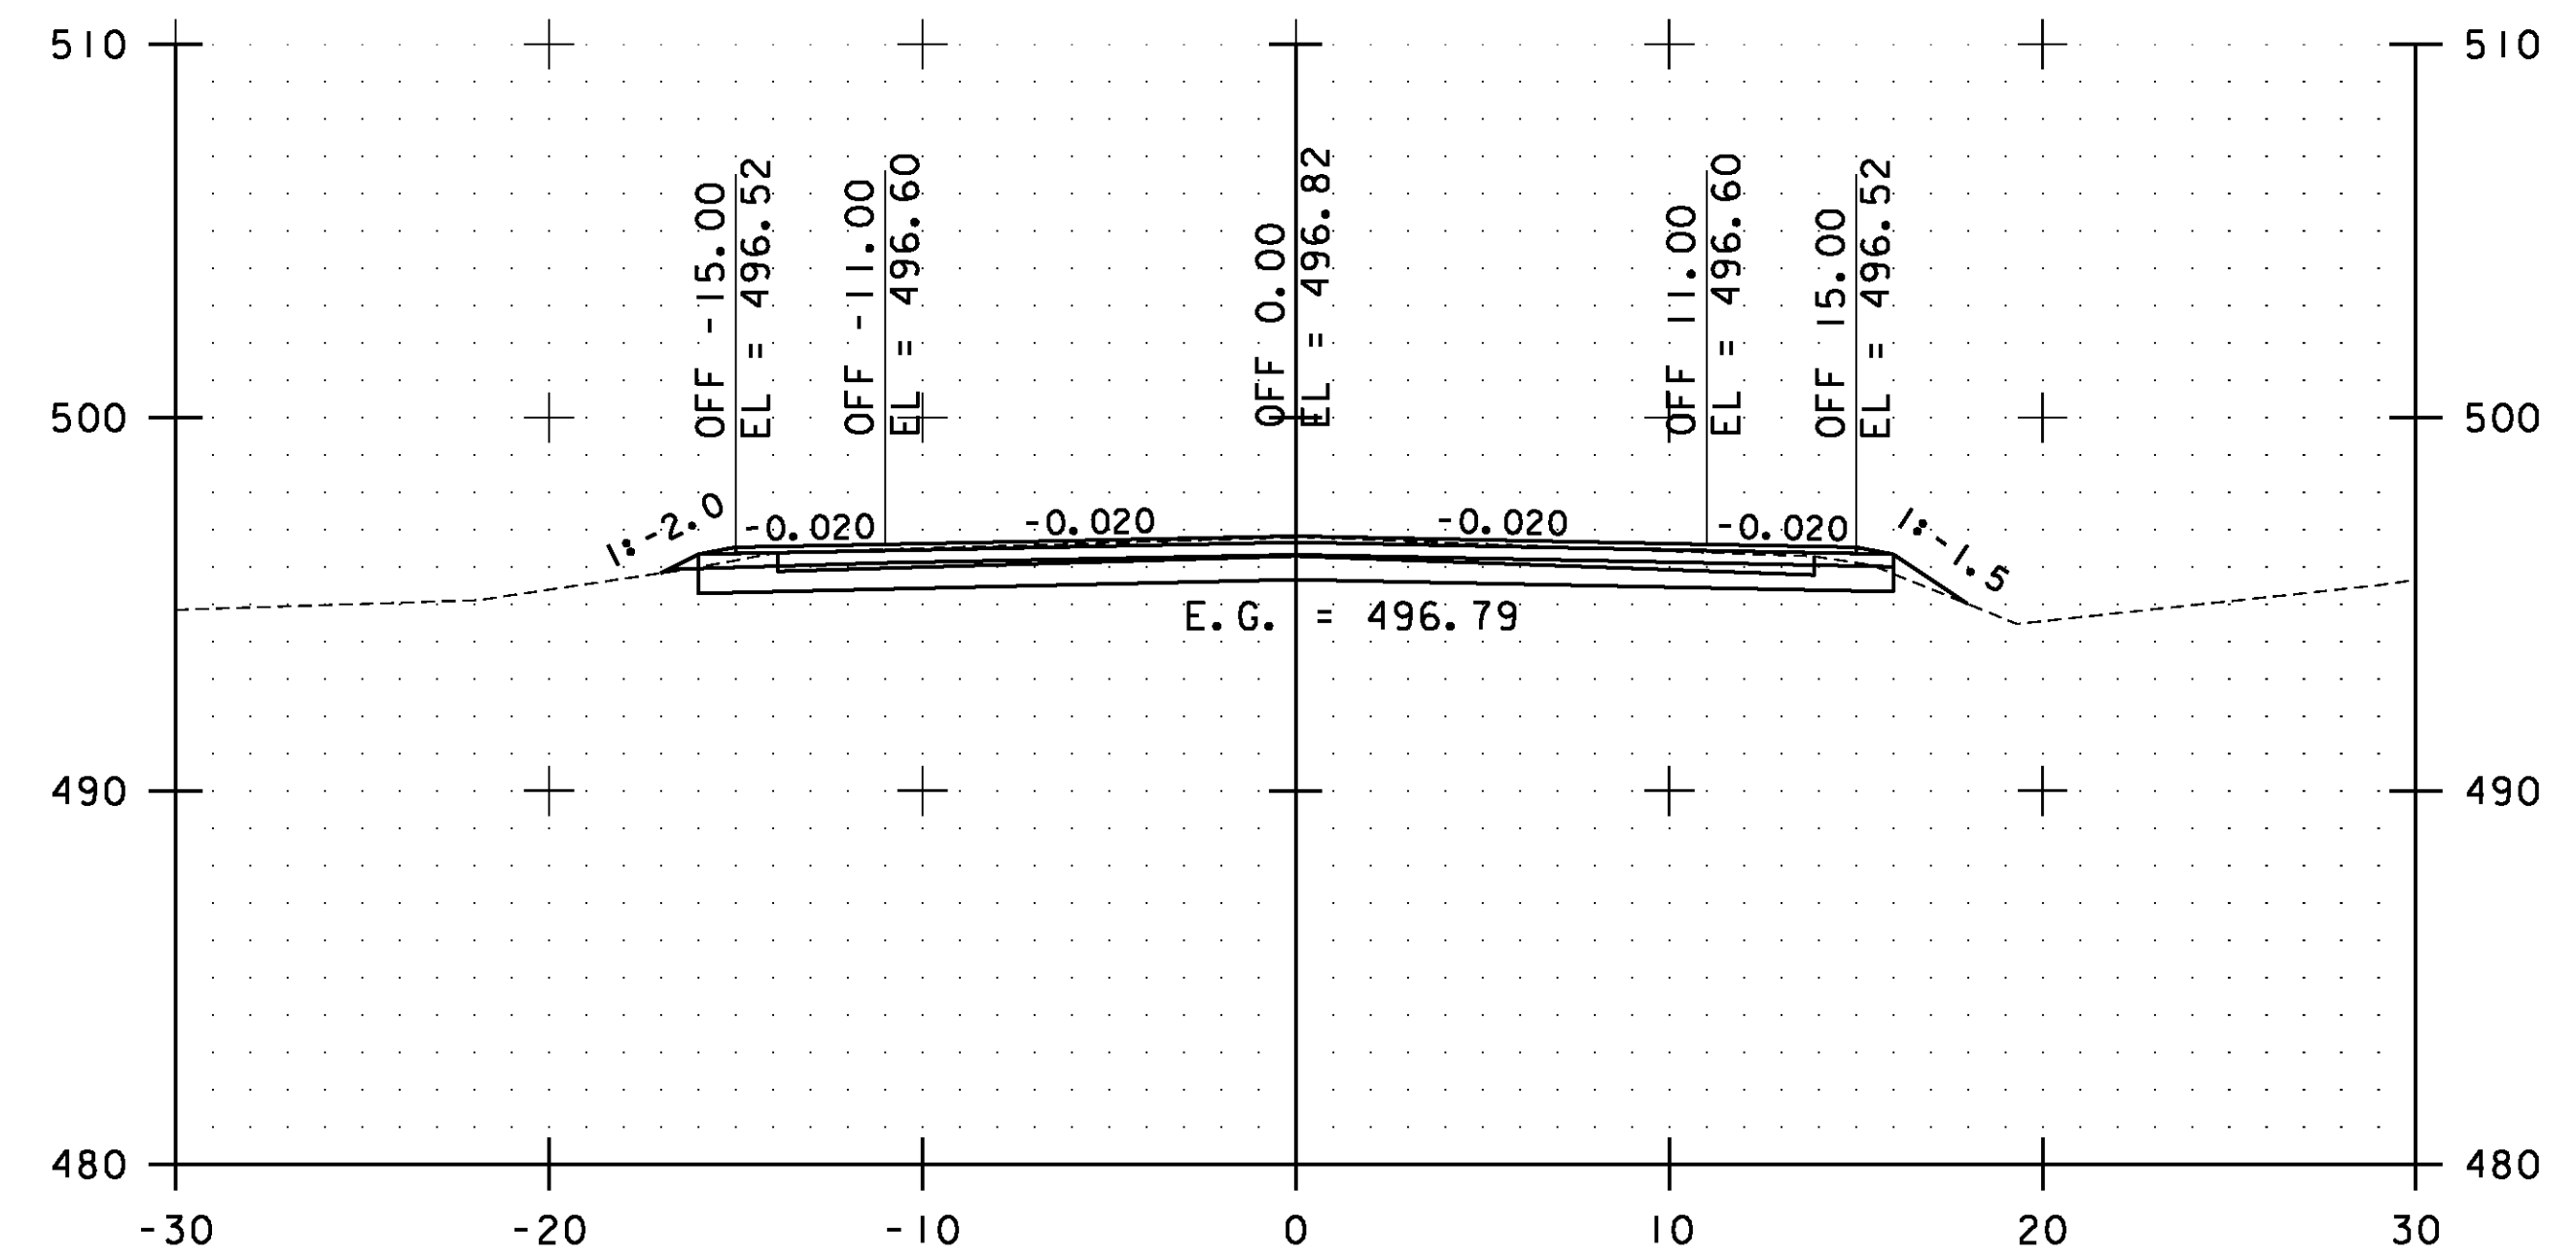

28+50.00

STA. 27+50.00 TO STA. 29+00.00



**ESSEX  
CROSS  
SECTIONS  
SHEET #9**

PROJECT NAME: ESSEX-WESTFORD  
PROJECT NUMBER: STP 2912(I)

FILE NAME: p10c226.dgn  
PROJECT LEADER: JLL  
DESIGNED BY: STANTEC  
IPARM FILE: p10c226xs009.i

PLOT DATE: 2/20/2013  
DRAWN BY: STANTEC  
CHECKED BY: STANTEC  
SHEET 100 OF 239