




42+00.00

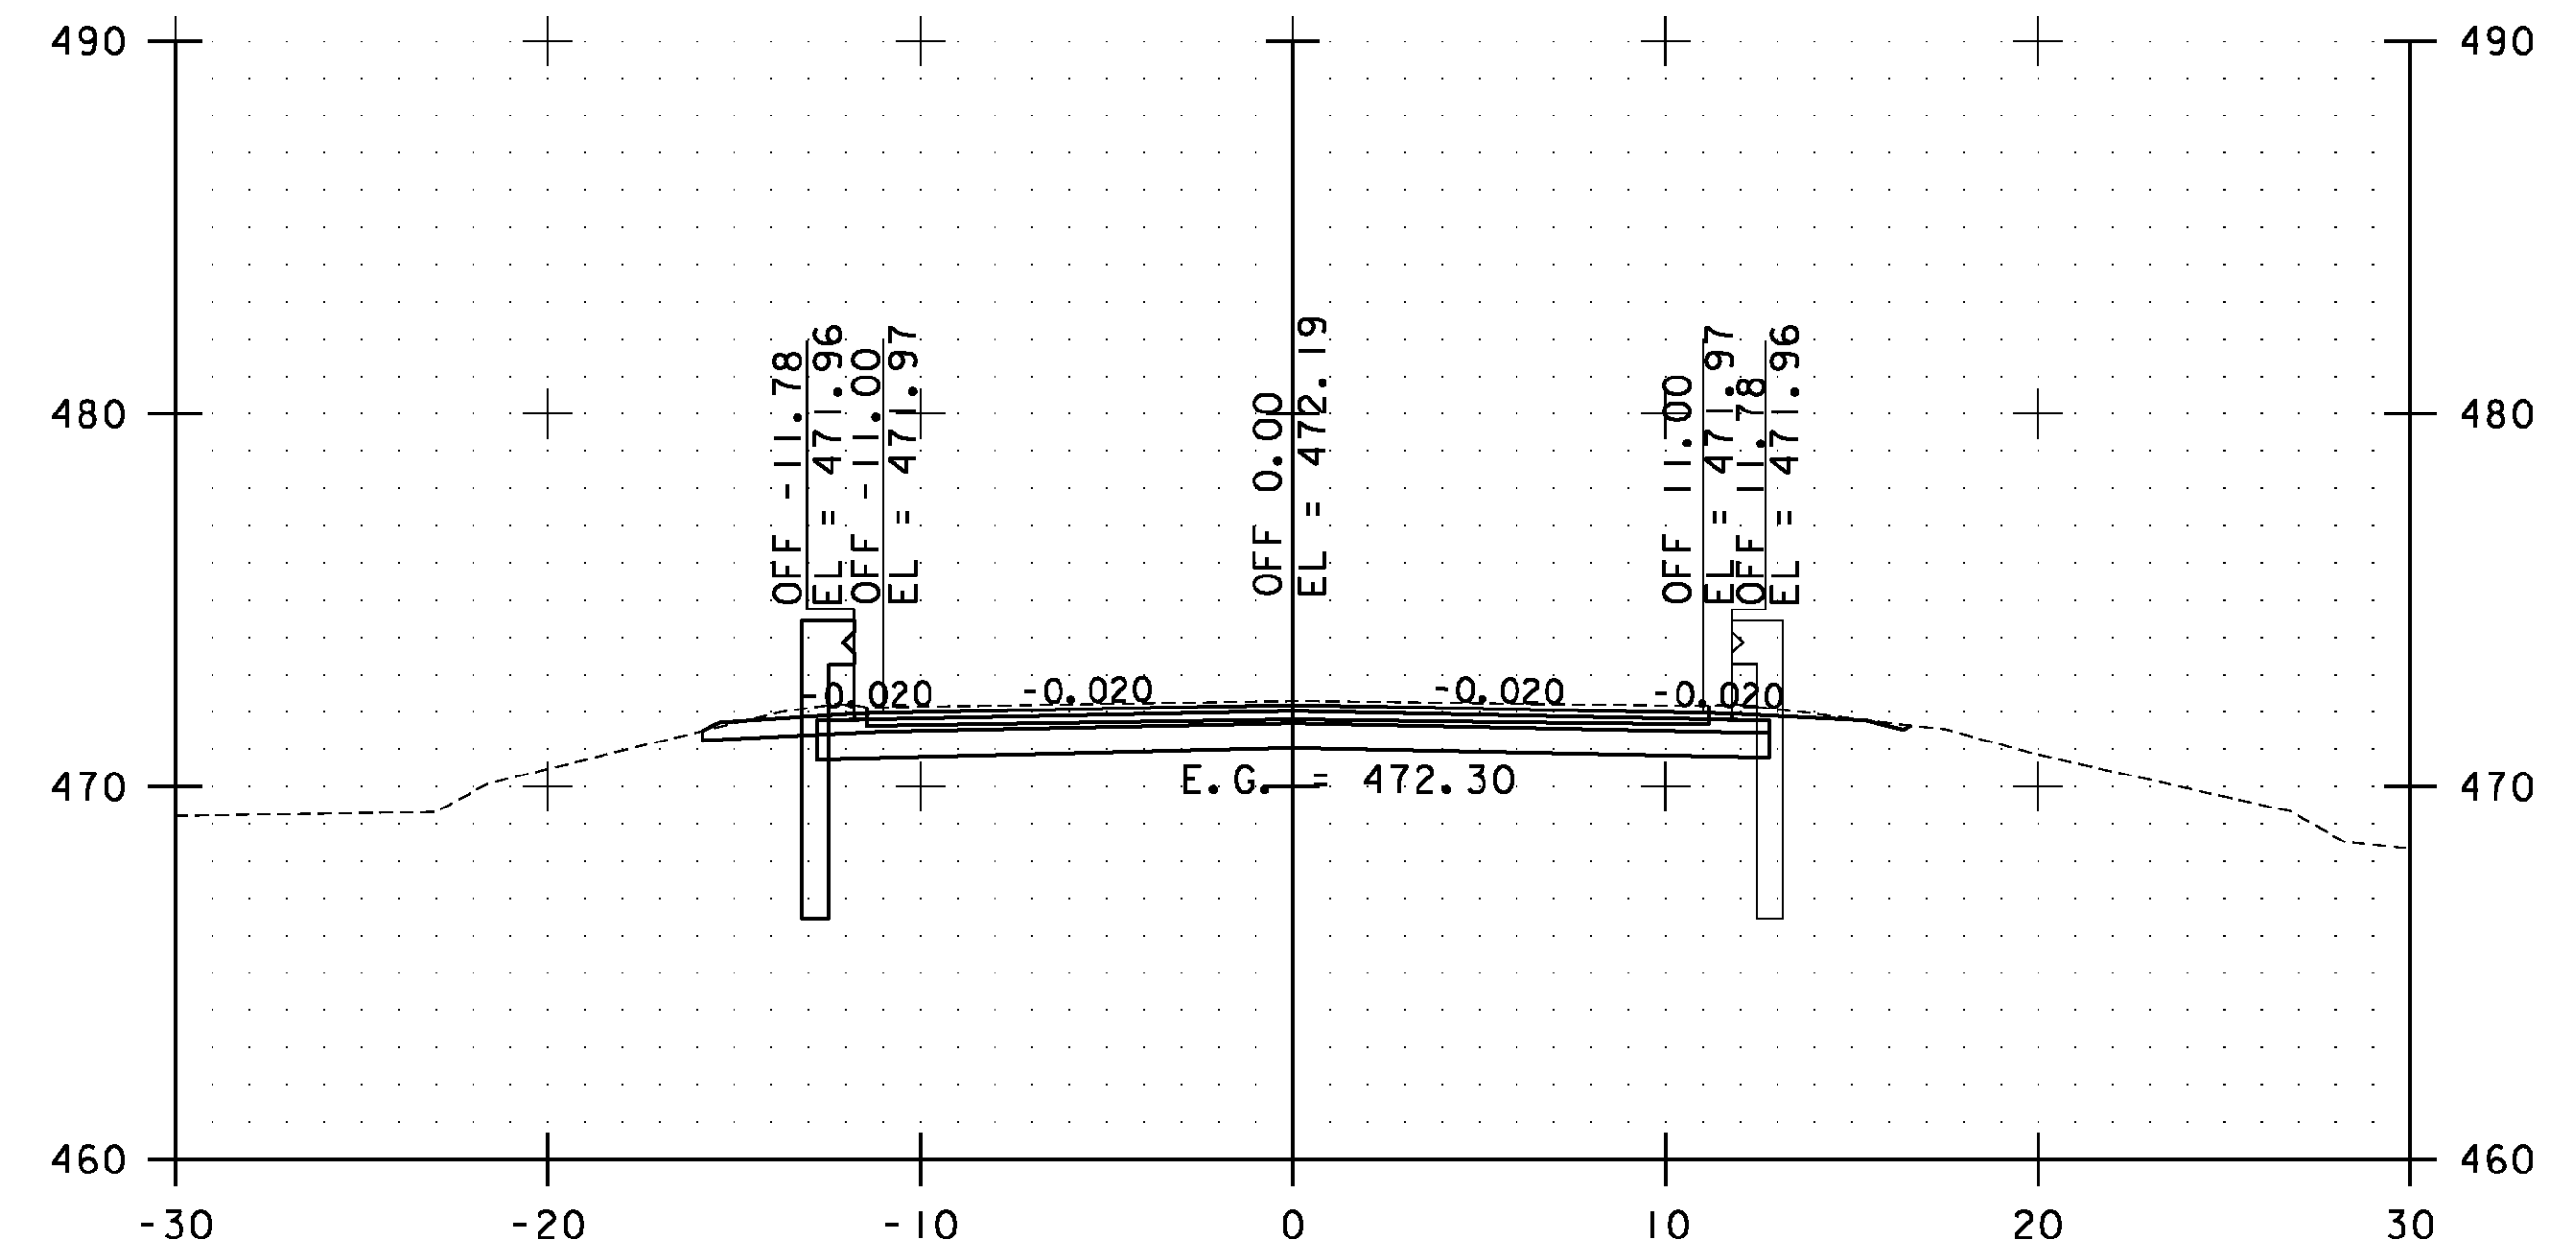

43+00.00

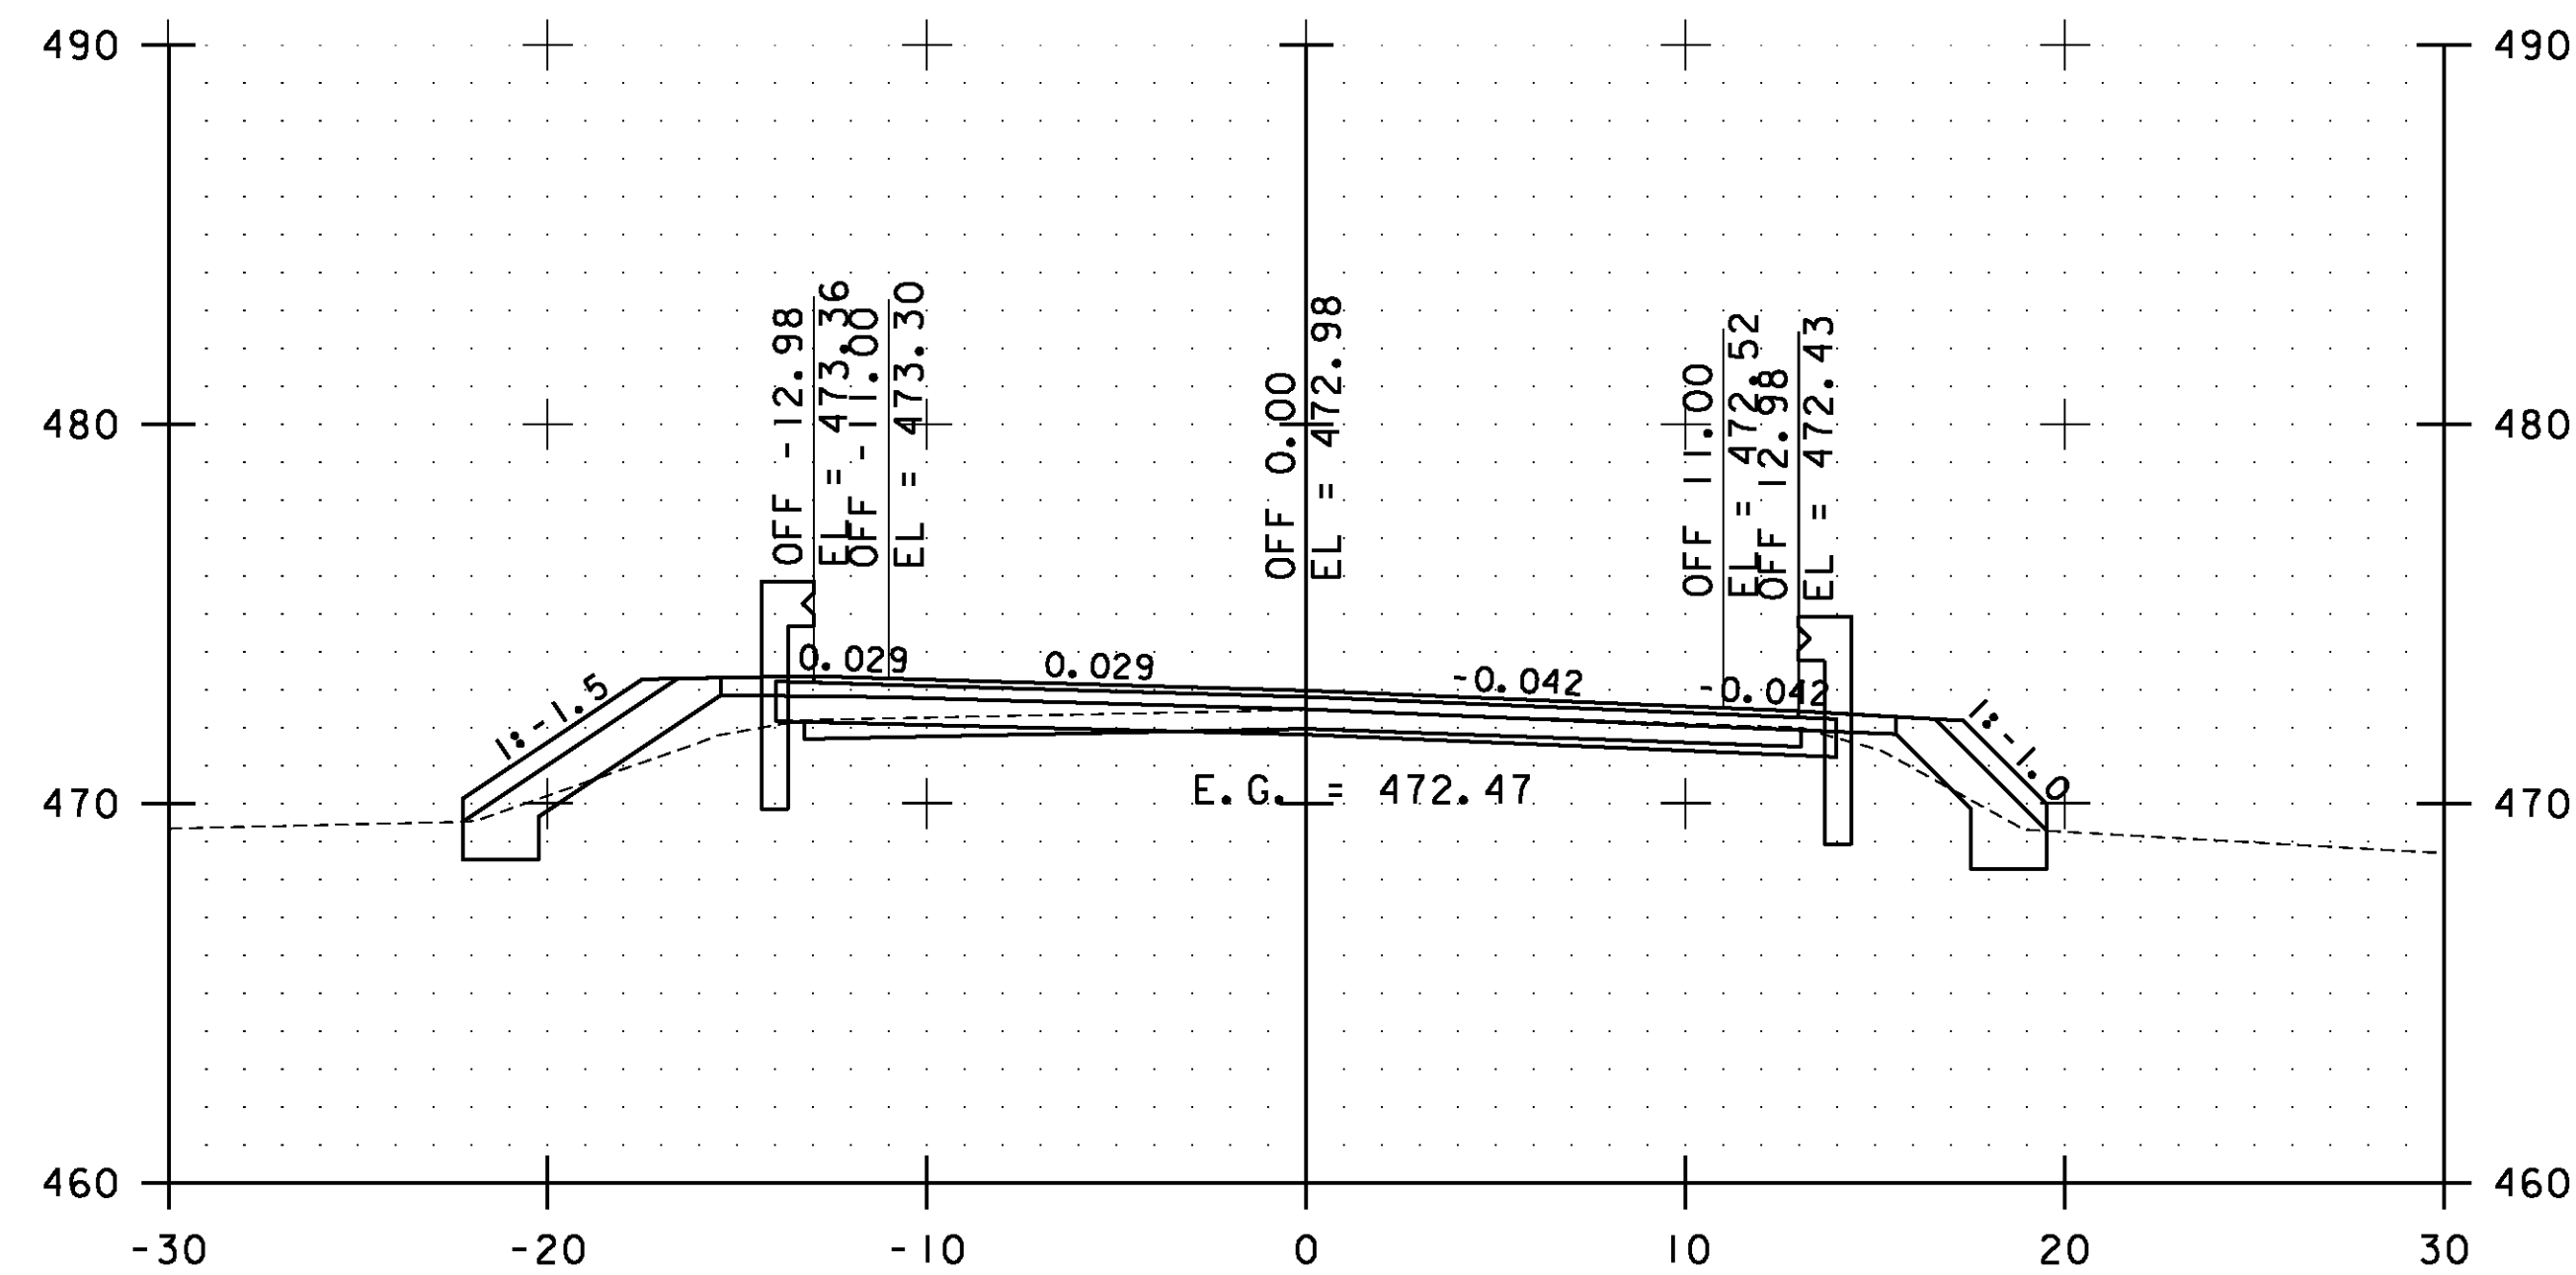


41+50.00

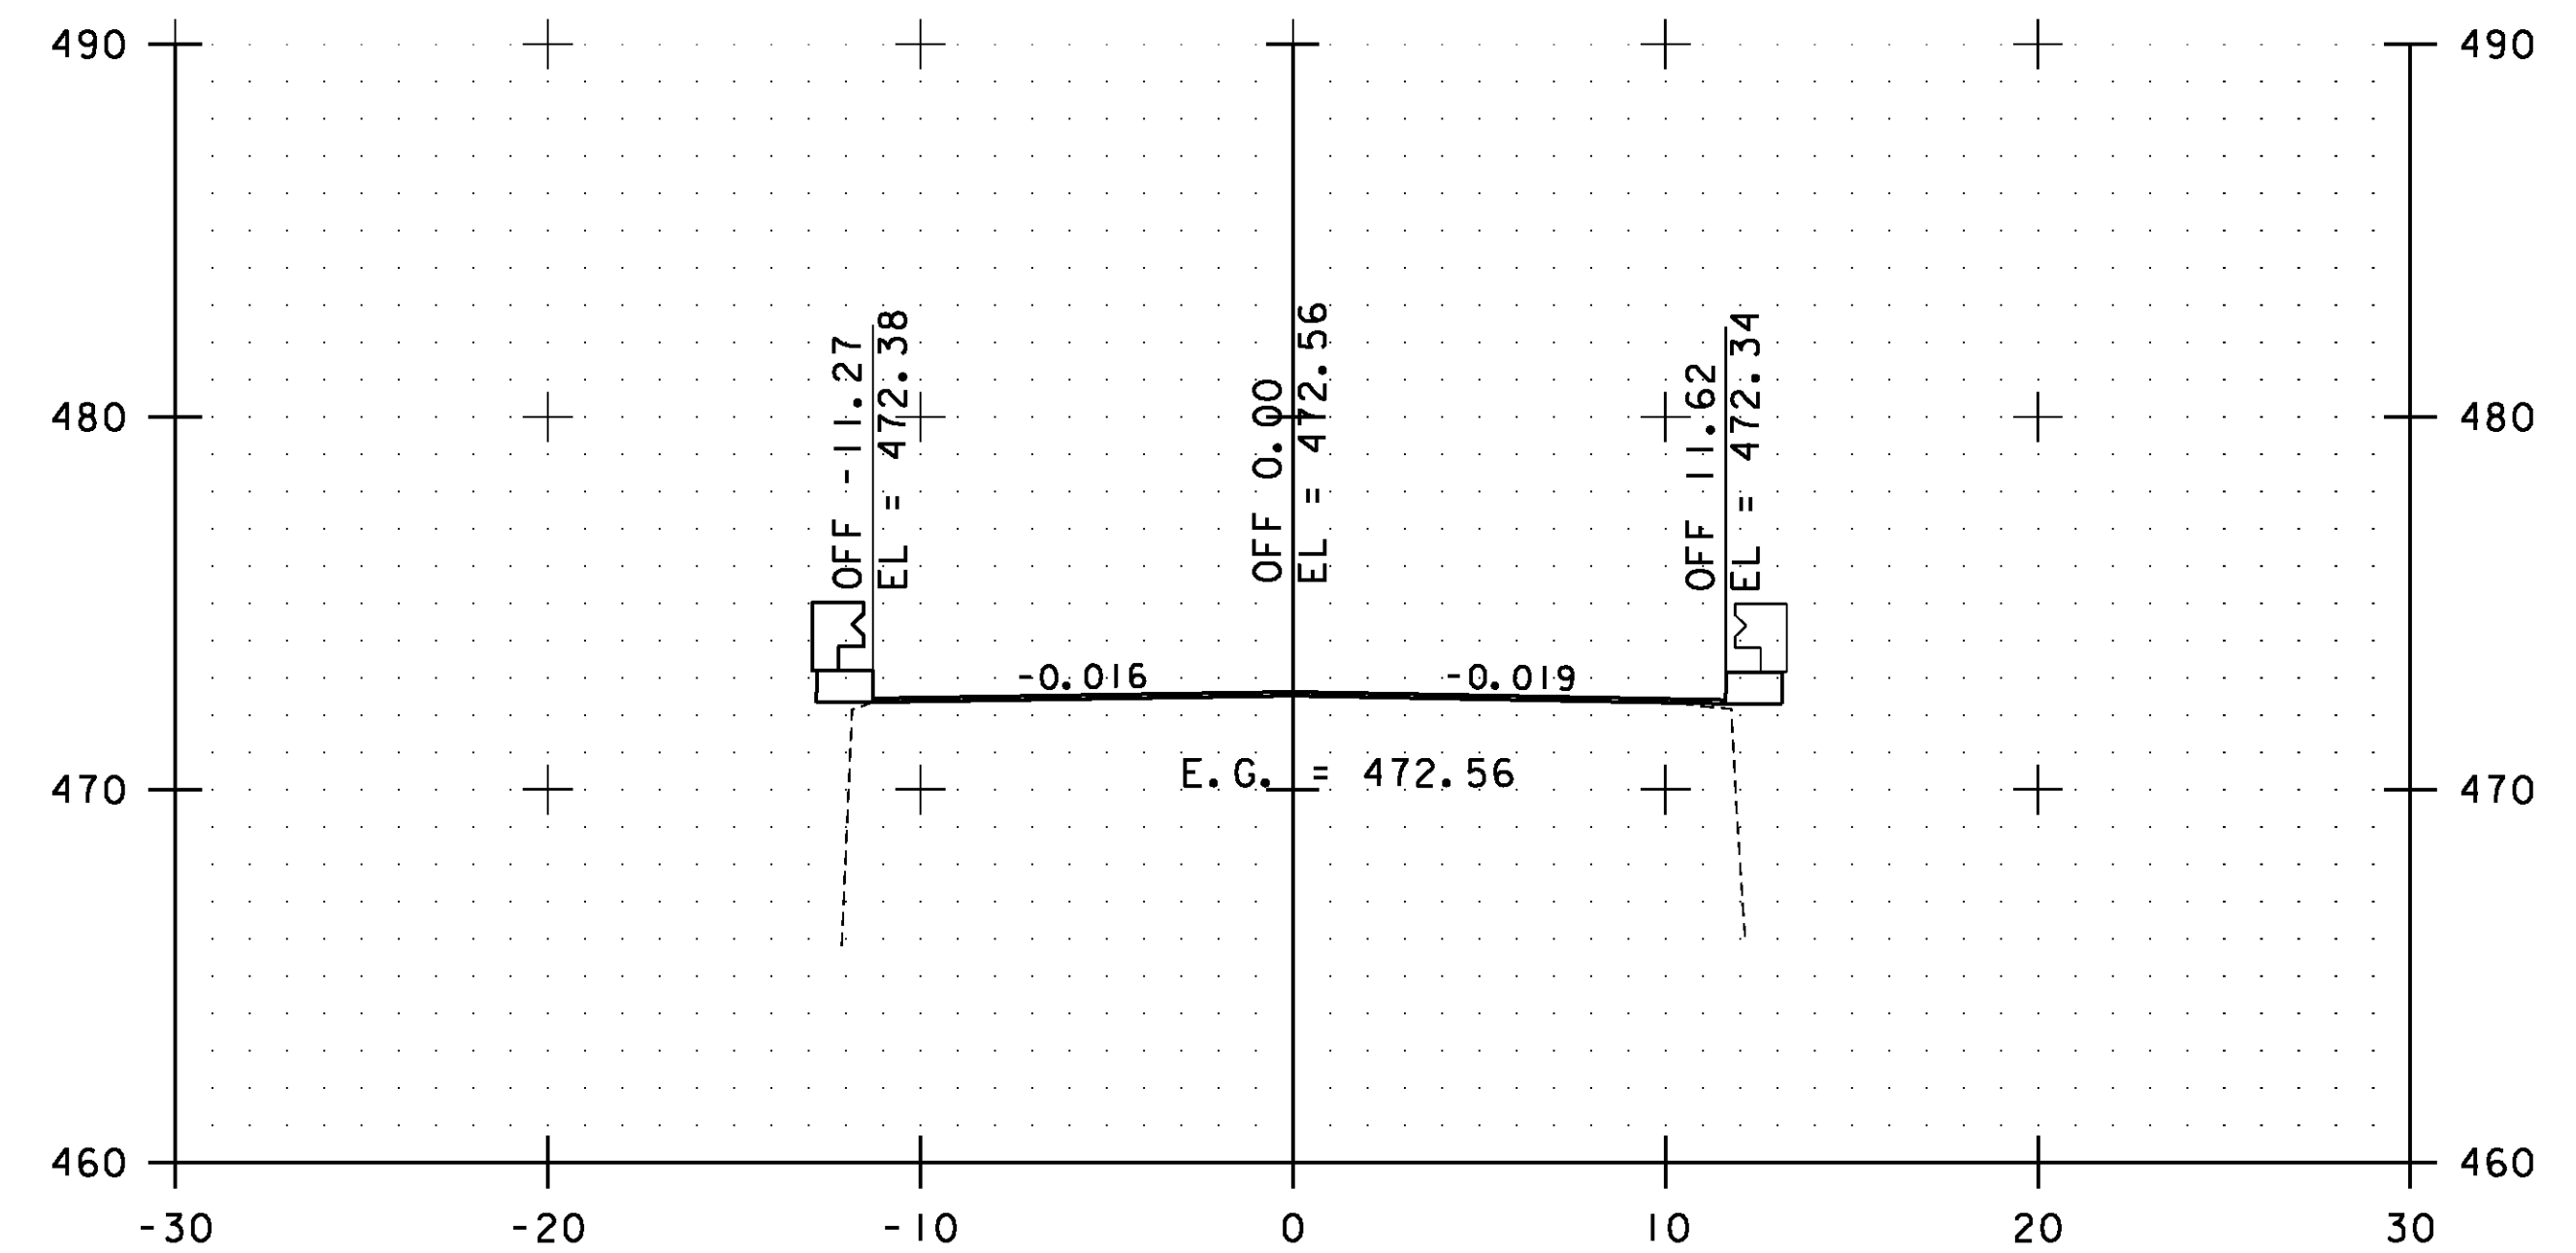

42+50.00

STA. 41+50.00 TO STA. 43+00.00

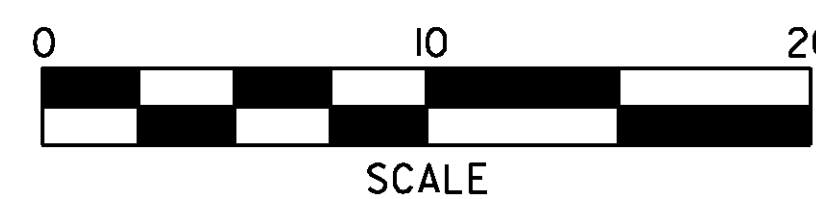

**ESSEX  
CROSS  
SECTIONS  
SHEET #16**

PROJECT NAME: ESSEX-WESTFORD  
PROJECT NUMBER: STP 2912(I)

FILE NAME: p10c226.dgn  
PROJECT LEADER: JLL  
DESIGNED BY: STANTEC  
IPARM FILE: p10c226xs016.i

PLOT DATE: 2/20/2013  
DRAWN BY: STANTEC  
CHECKED BY: STANTEC  
SHEET 107 OF 239