




50+00.00

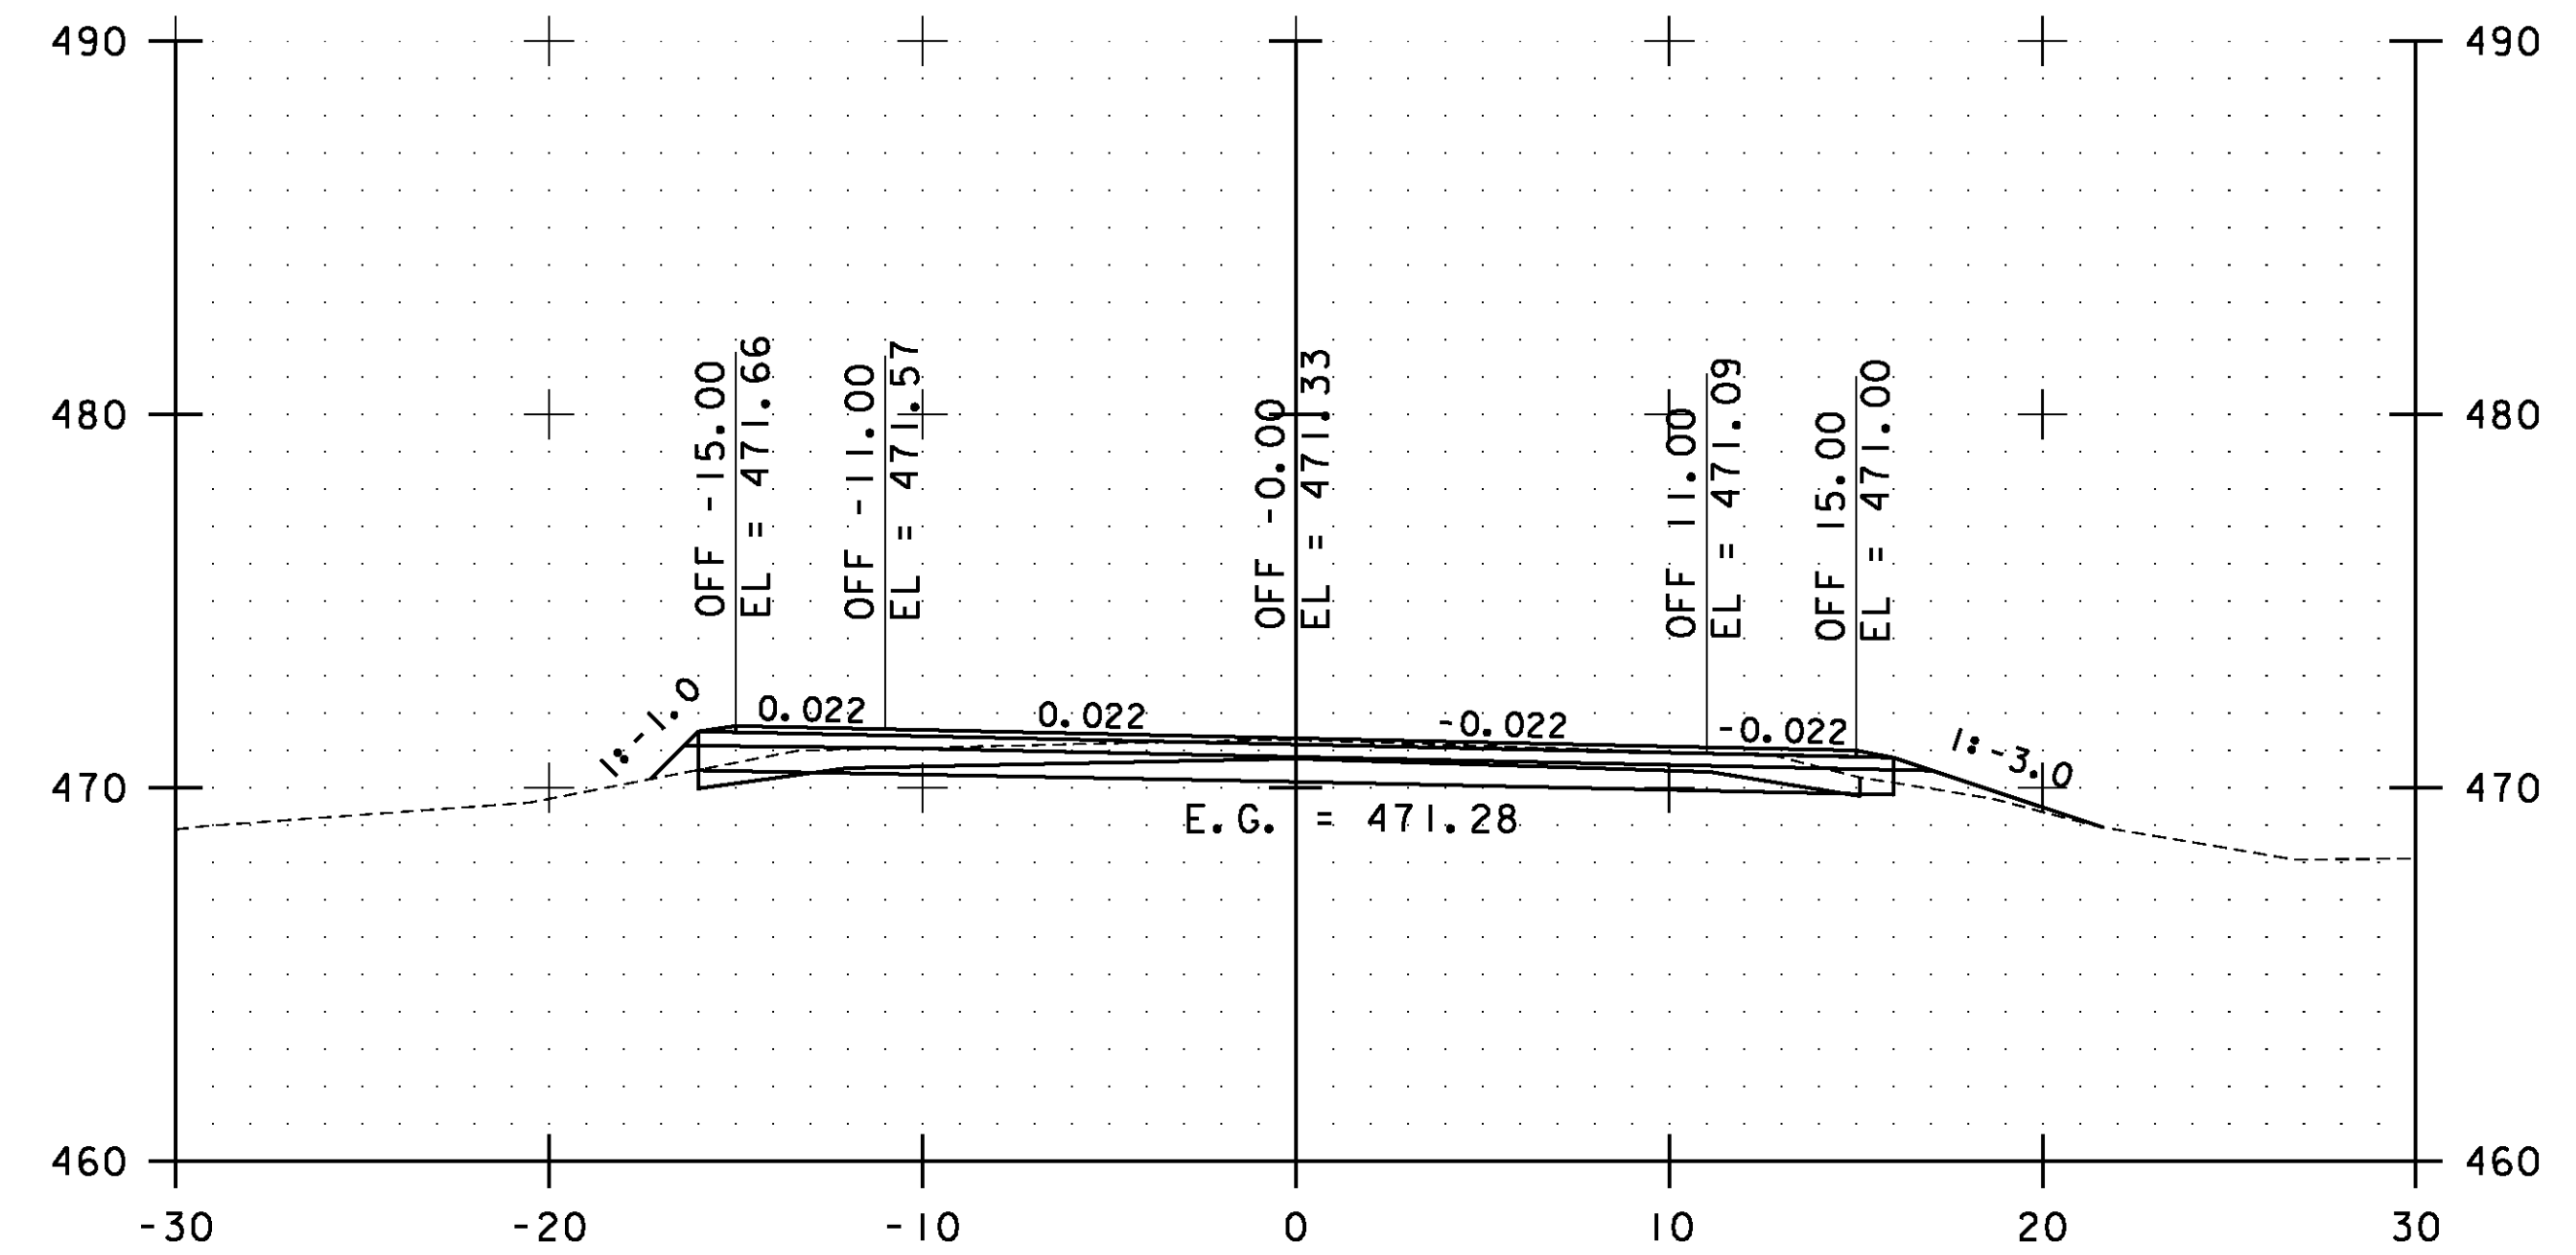

51+00.00

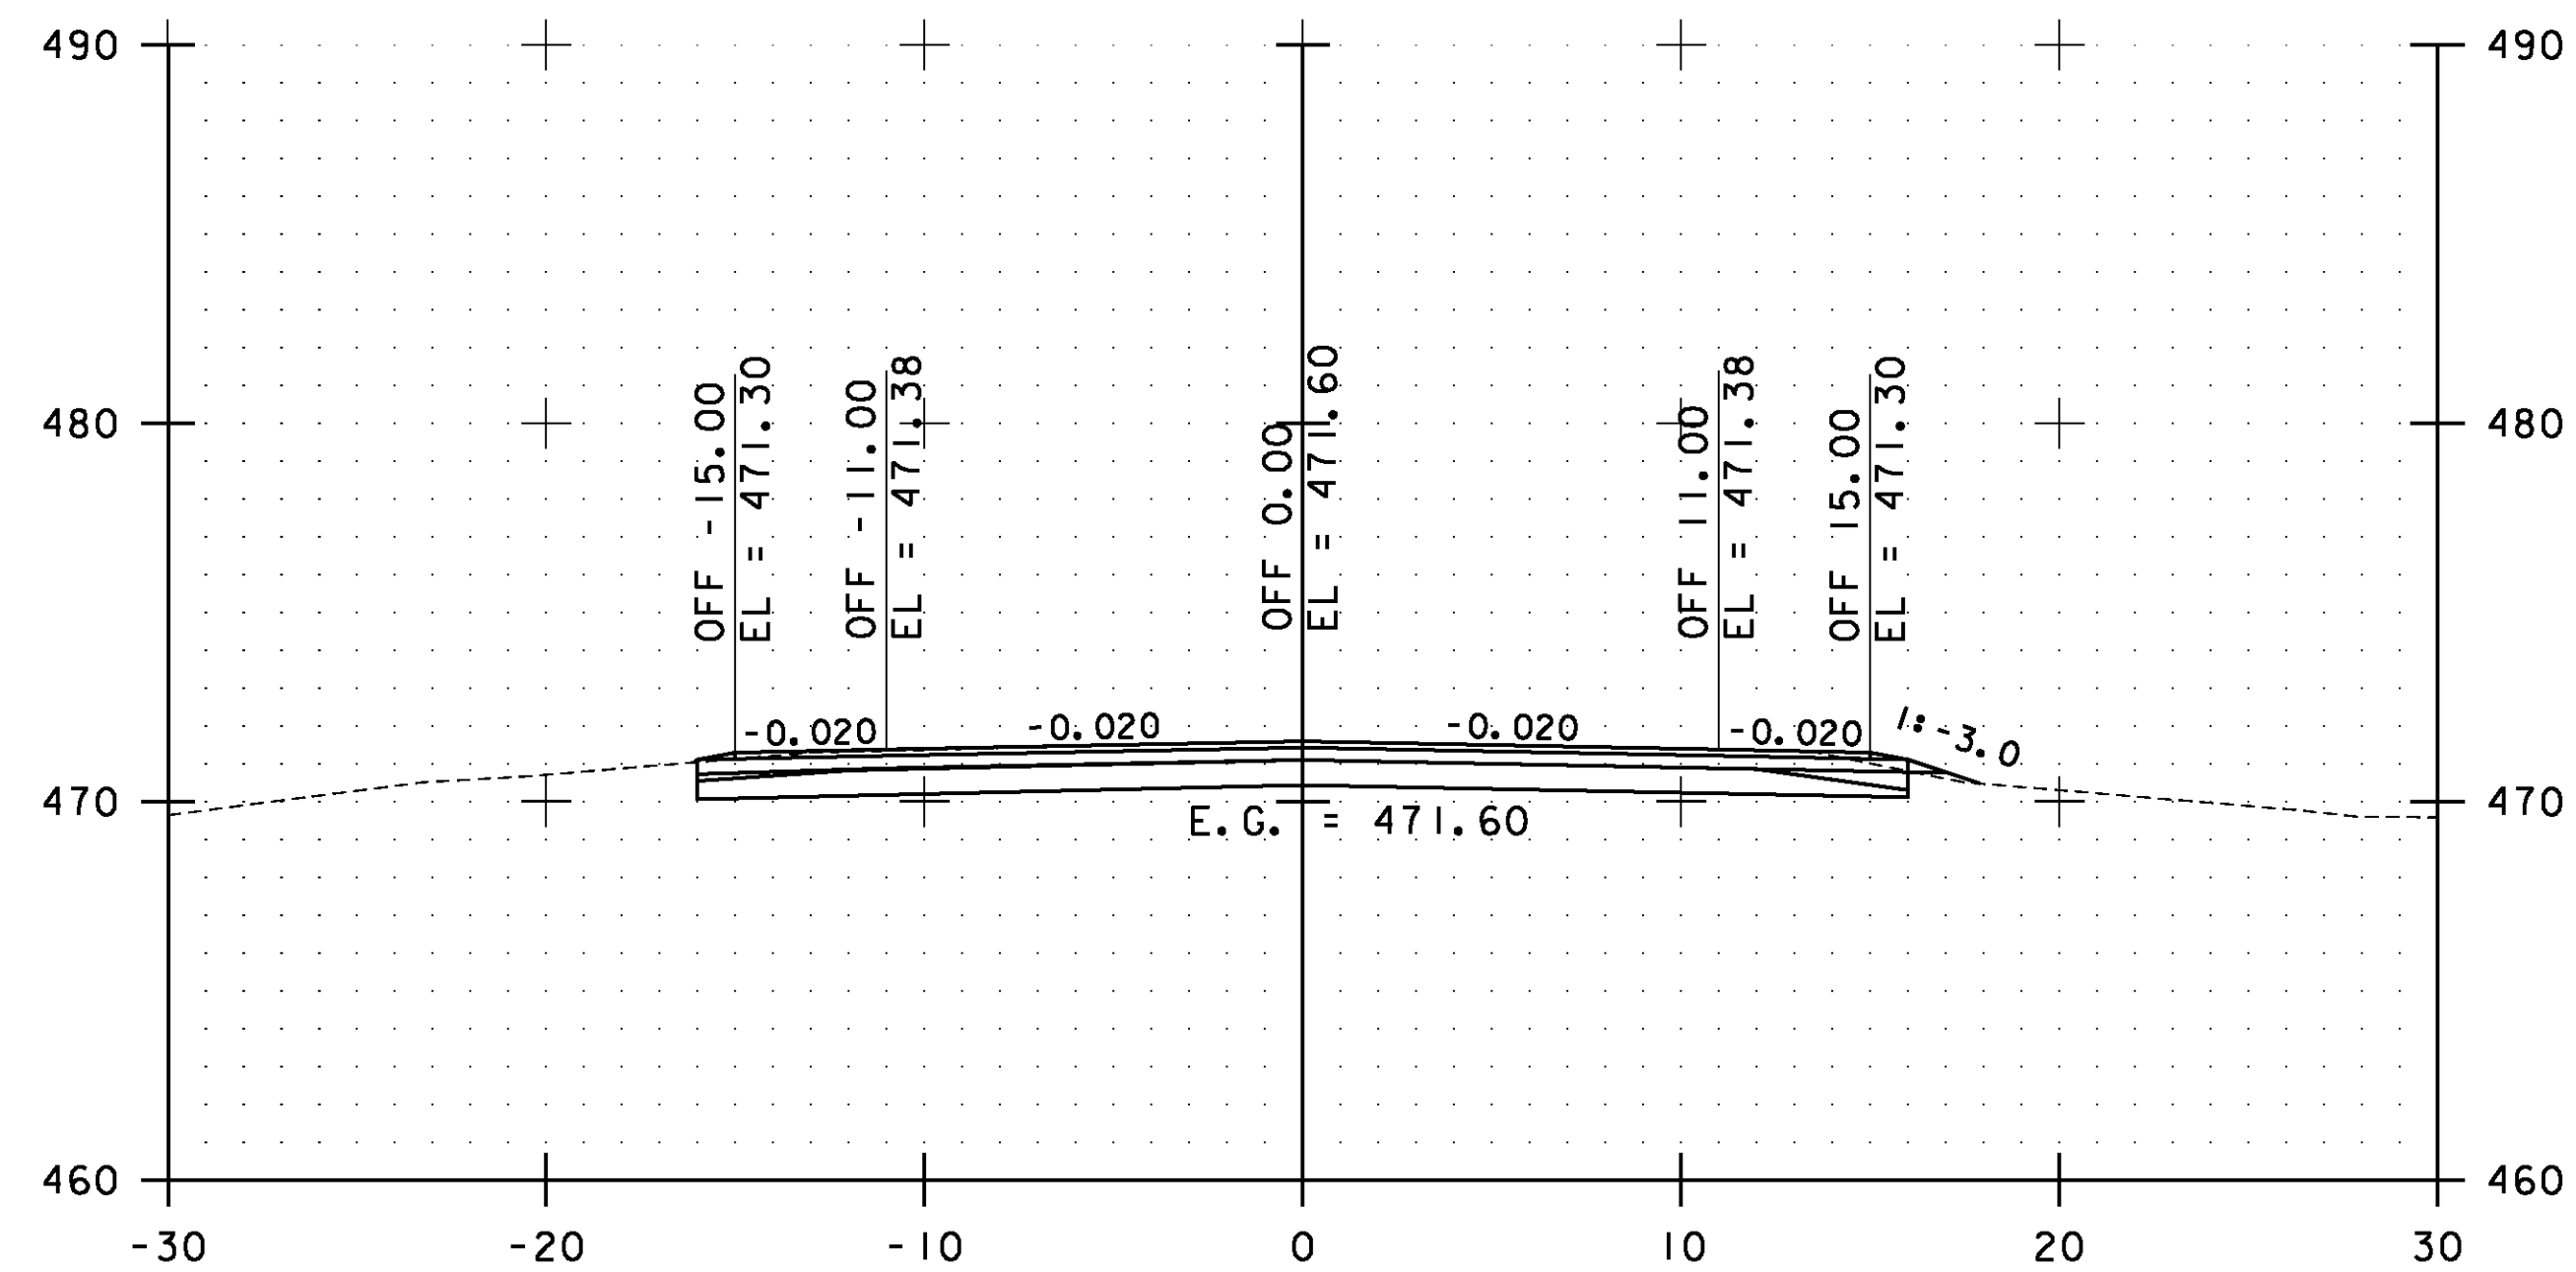

49+50.00

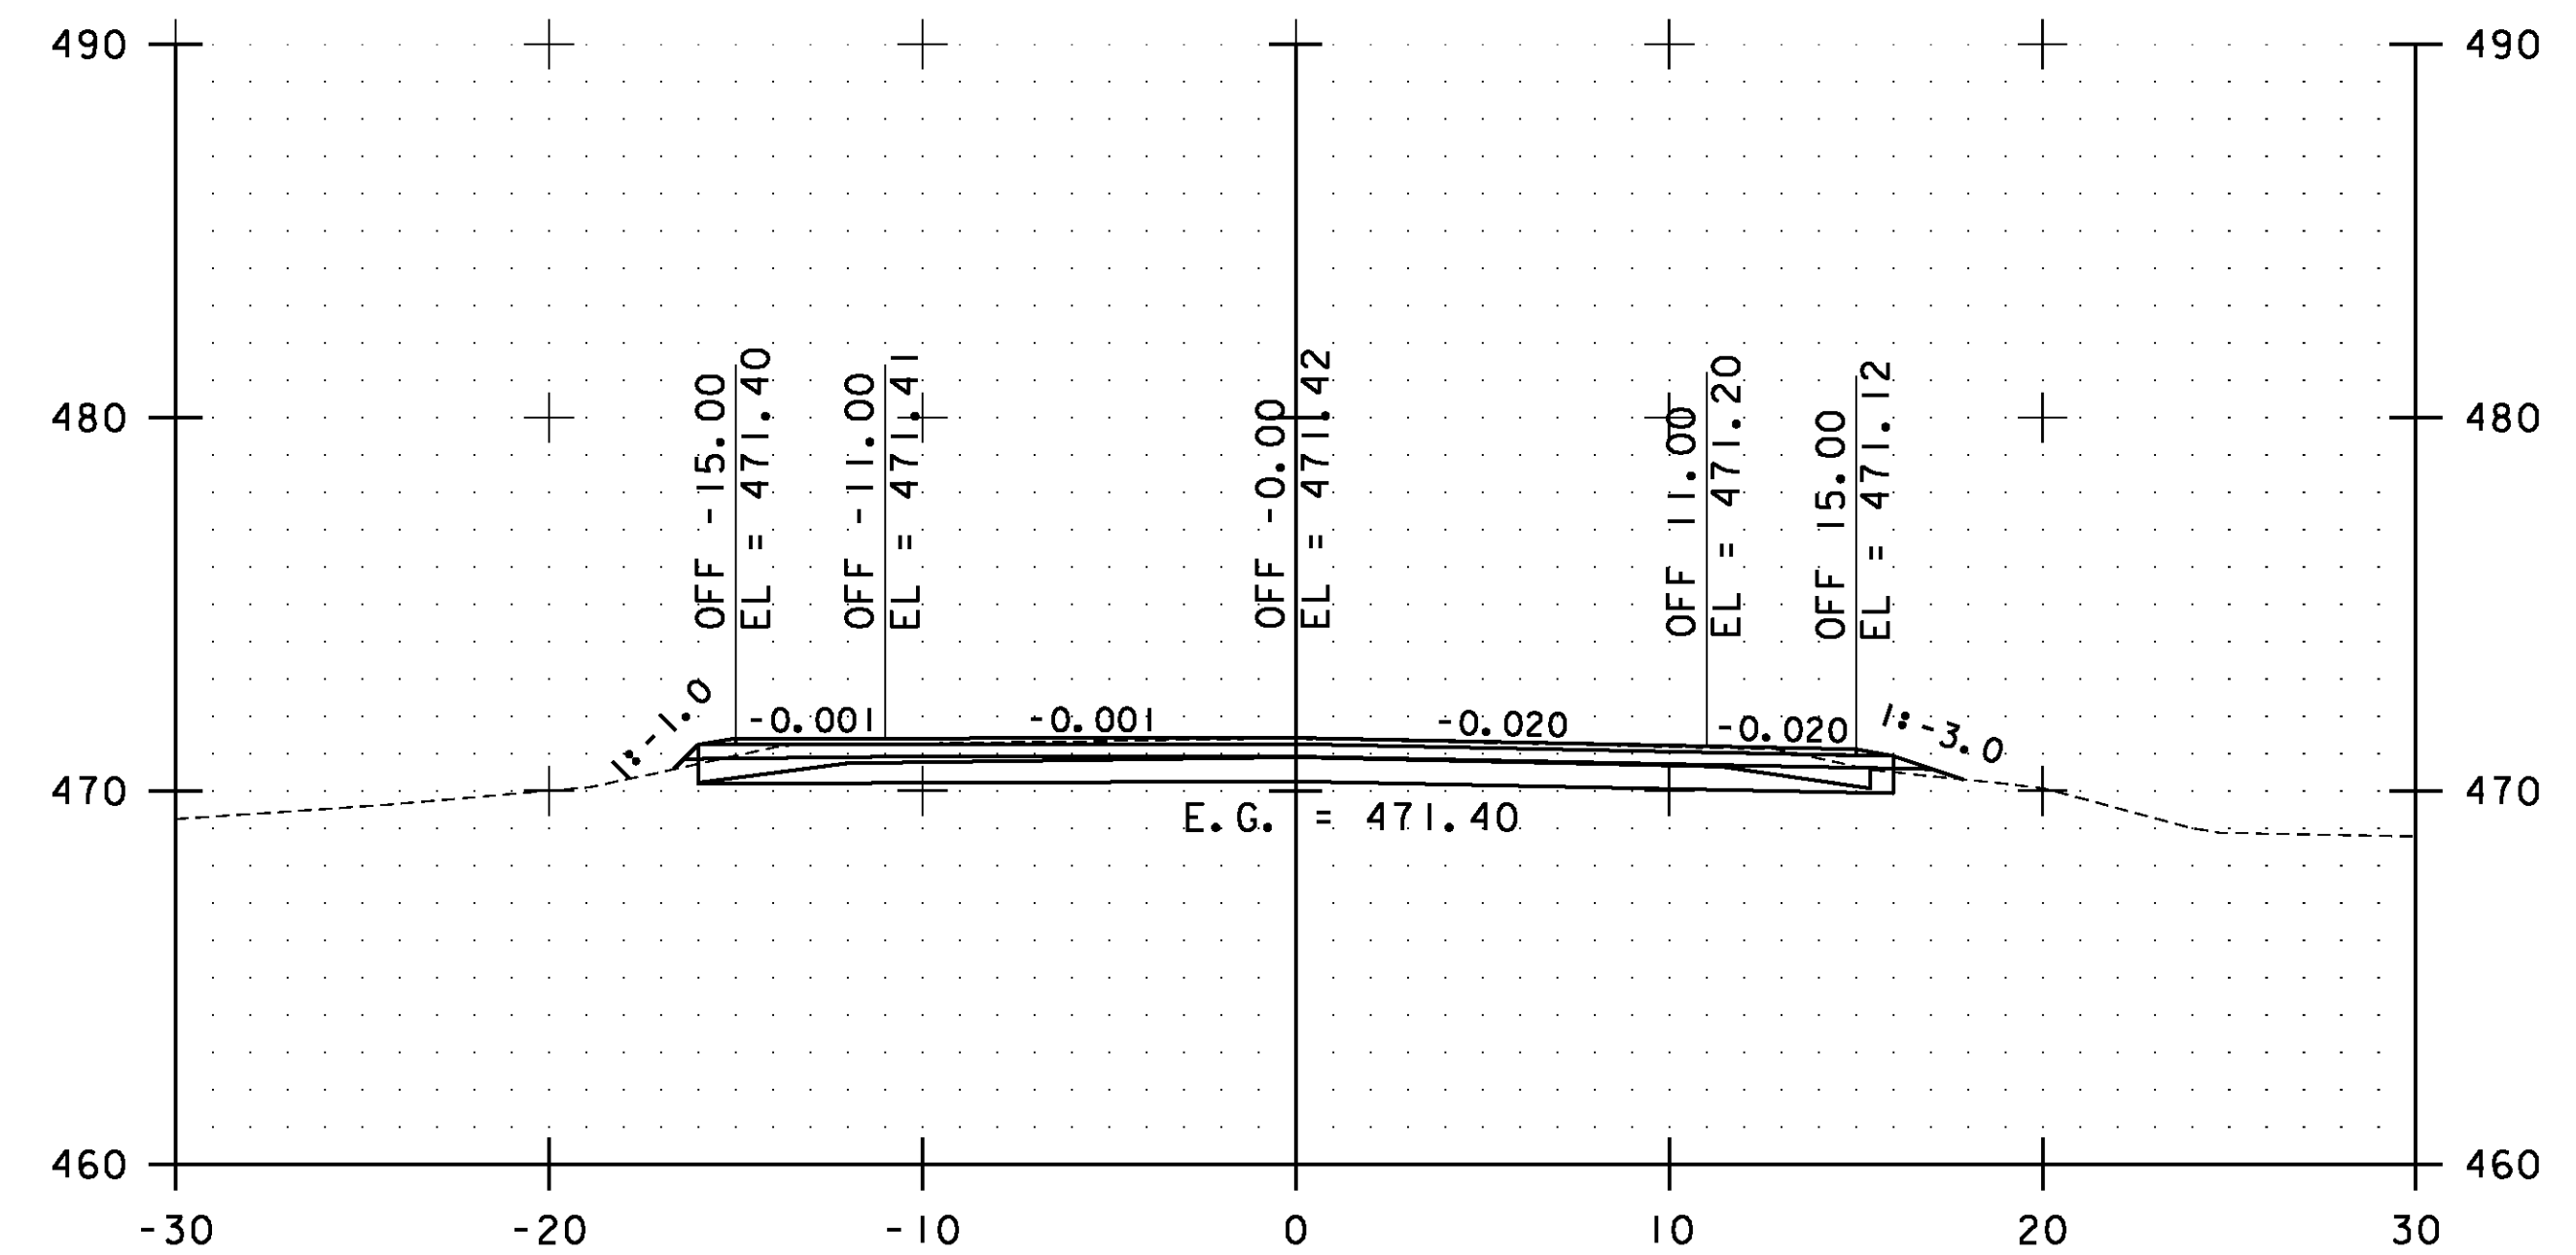

50+50.00

STA. 49+50.00 TO STA. 51+00.00



**ESSEX
CROSS
SECTIONS
SHEET #20**

PROJECT NAME: ESSEX-WESTFORD
PROJECT NUMBER: STP 2912(I)

FILE NAME: p10c226.dgn
PROJECT LEADER: JLL
DESIGNED BY: STANTEC
IPARM FILE: p10c226xs020.i

PLOT DATE: 2/20/2013
DRAWN BY: STANTEC
CHECKED BY: STANTEC
SHEET III OF 239