




60+00.00

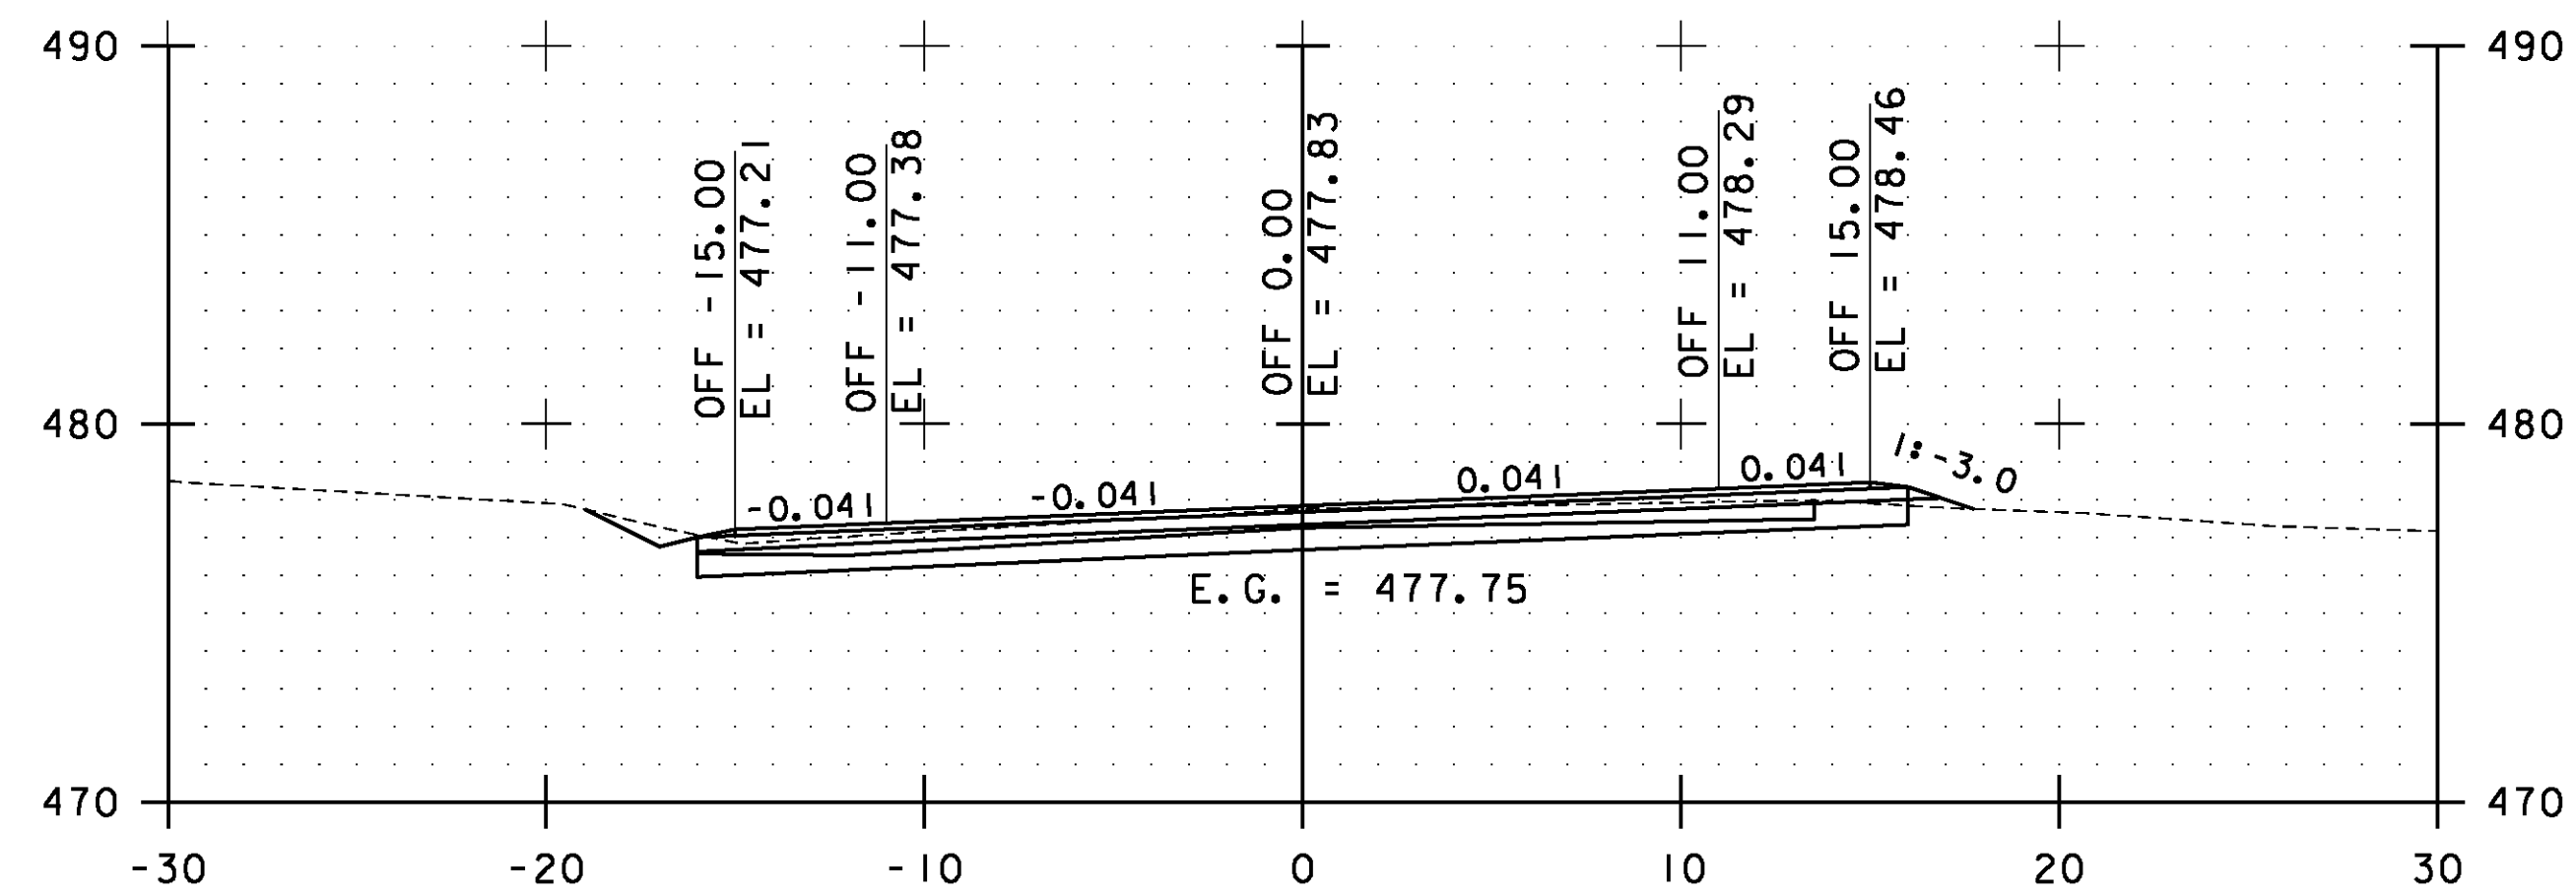

59+50.00

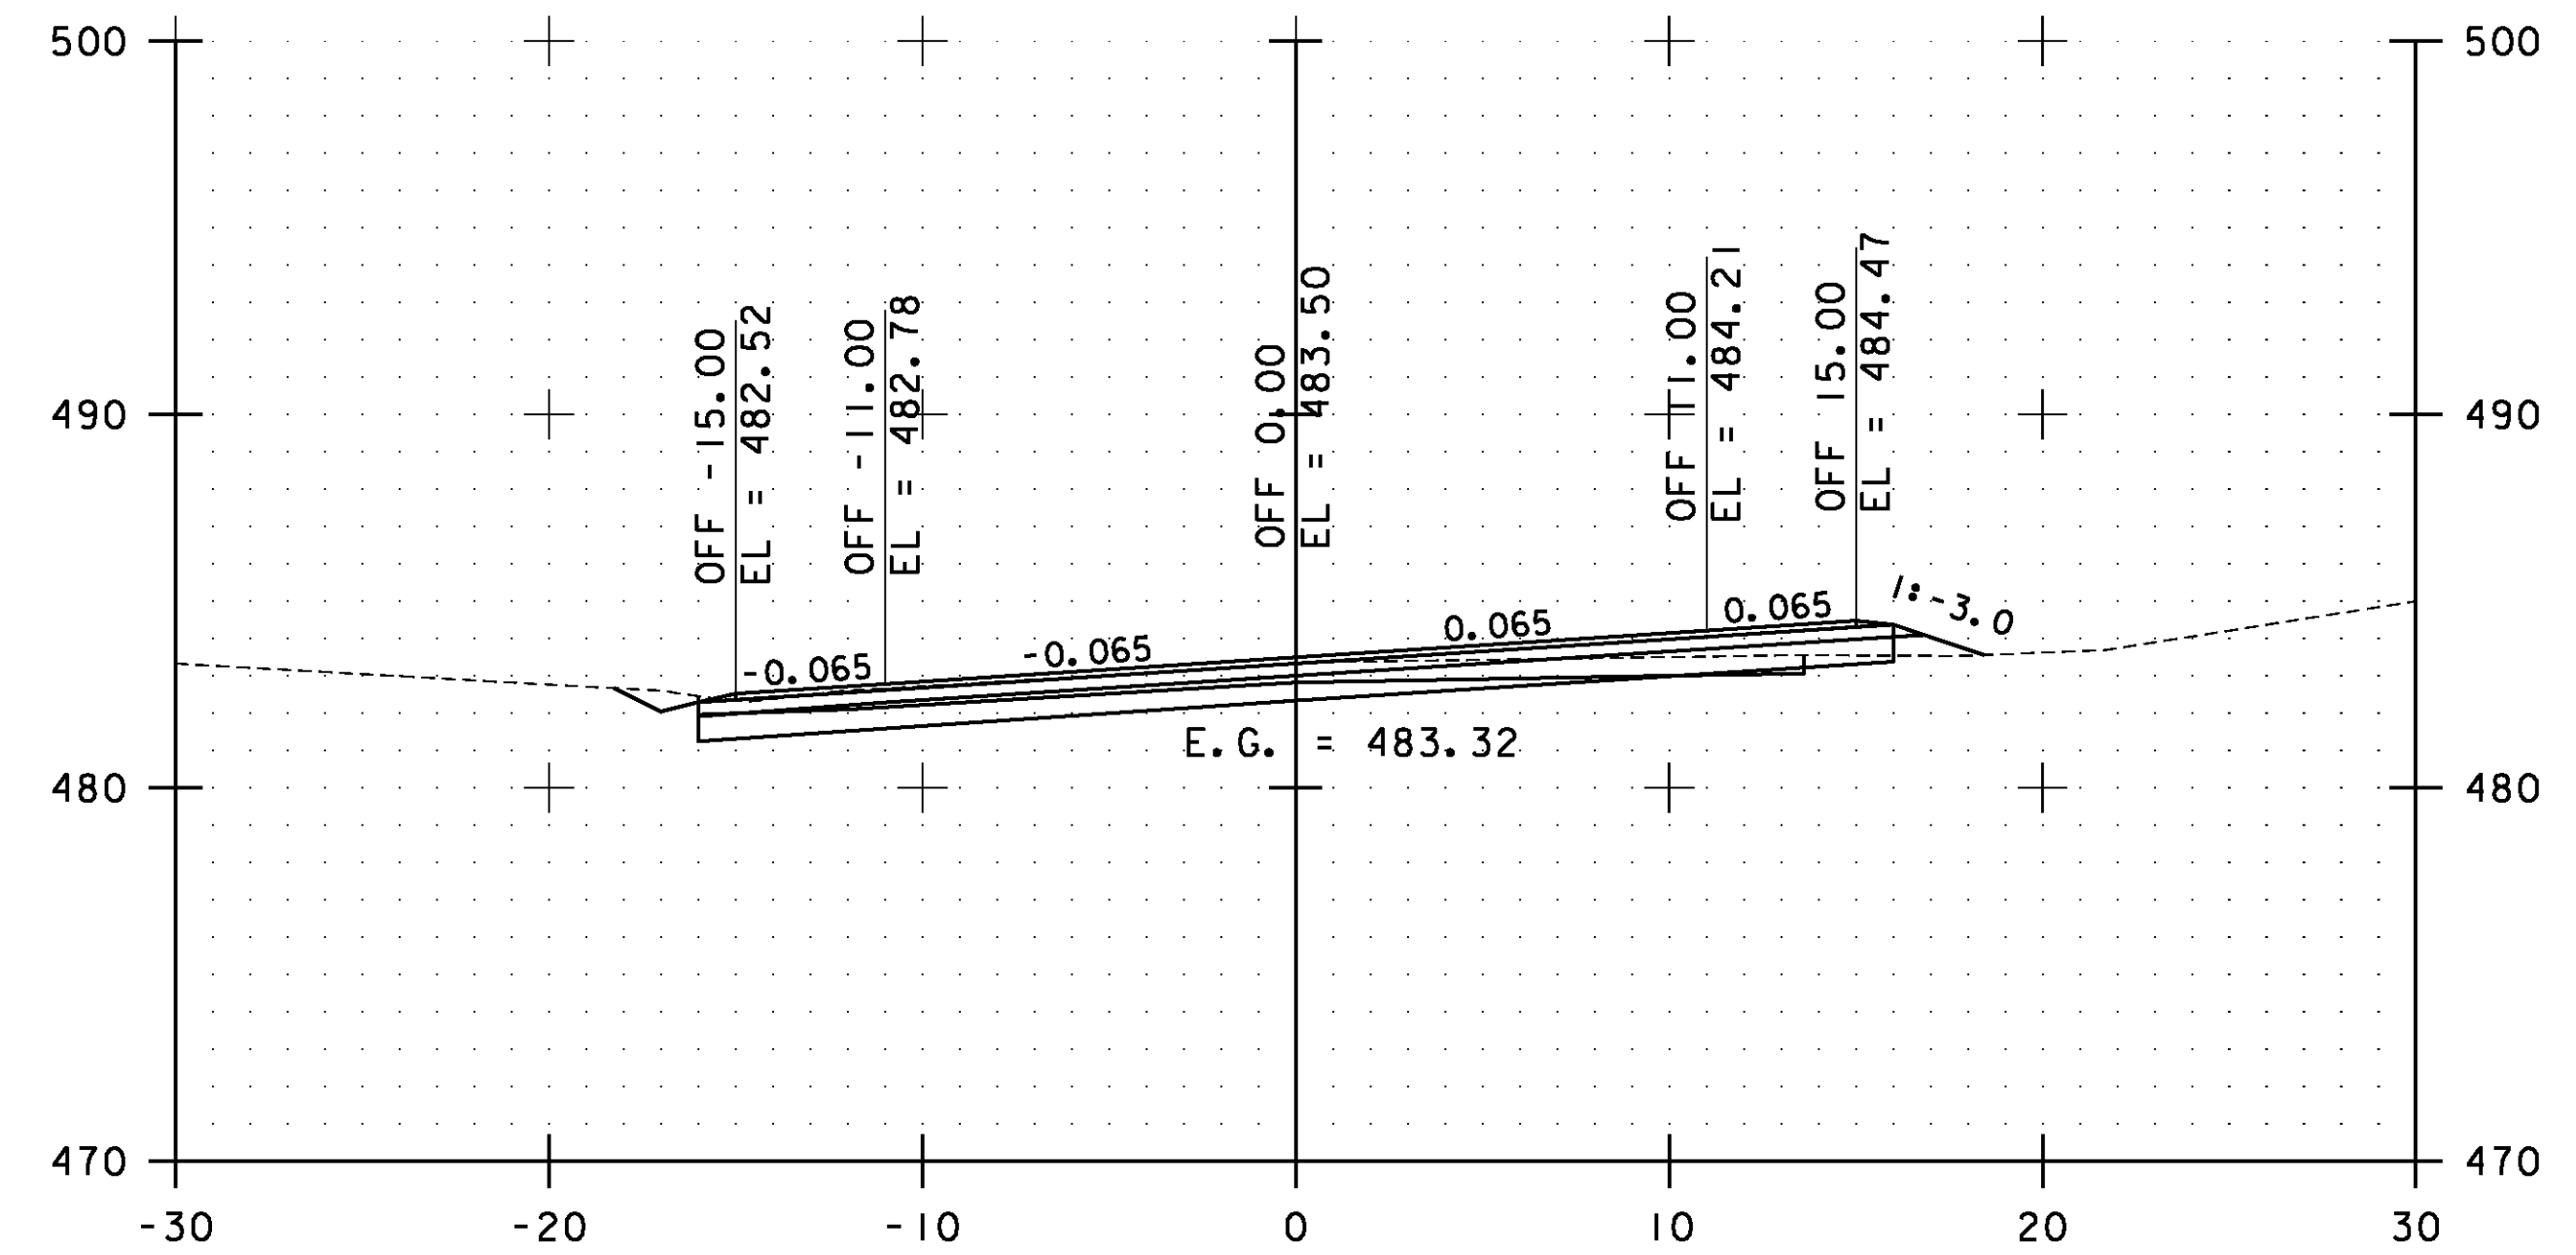


61+00.00

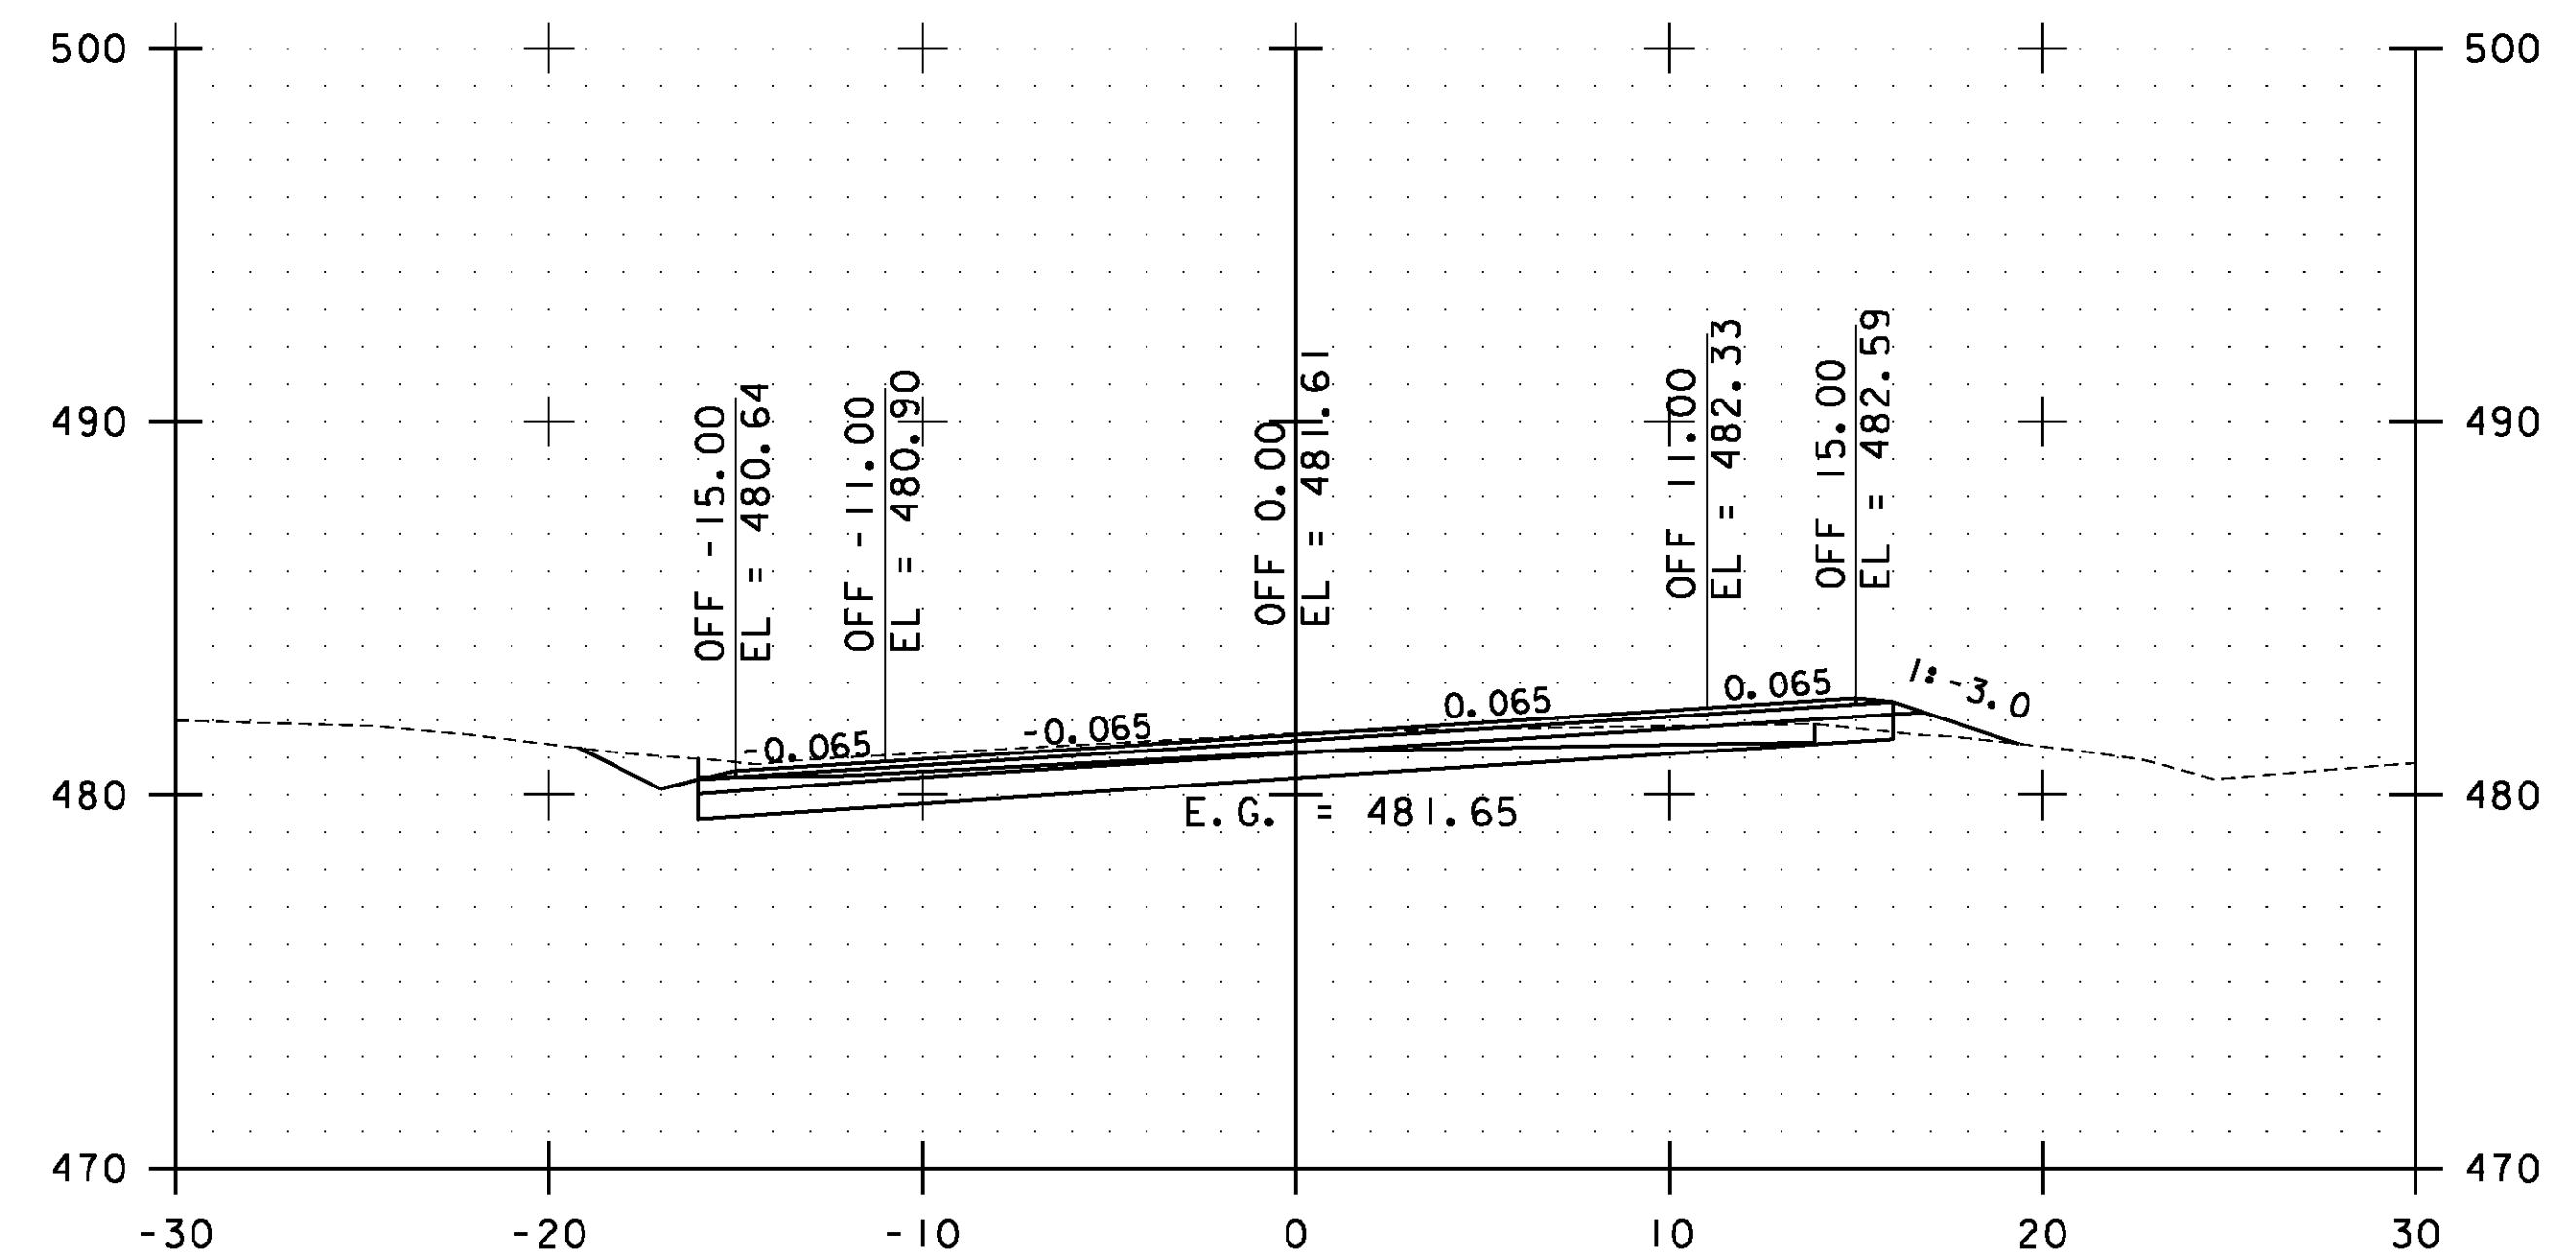

60+50.00

STA. 59+50.00 TO STA. 61+00.00

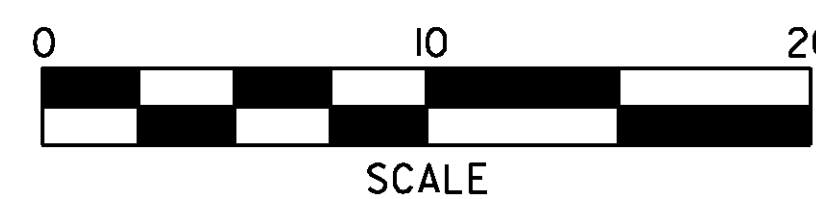

**ESSEX
CROSS
SECTIONS
SHEET #25**

PROJECT NAME: ESSEX-WESTFORD
PROJECT NUMBER: STP 2912(I)

FILE NAME: p10c226.dgn
PROJECT LEADER: JLL
DESIGNED BY: STANTEC
IPARM FILE: p10c226xs025.i

PLOT DATE: 2/20/2013
DRAWN BY: STANTEC
CHECKED BY: STANTEC
SHEET 116 OF 239