




72+00.00

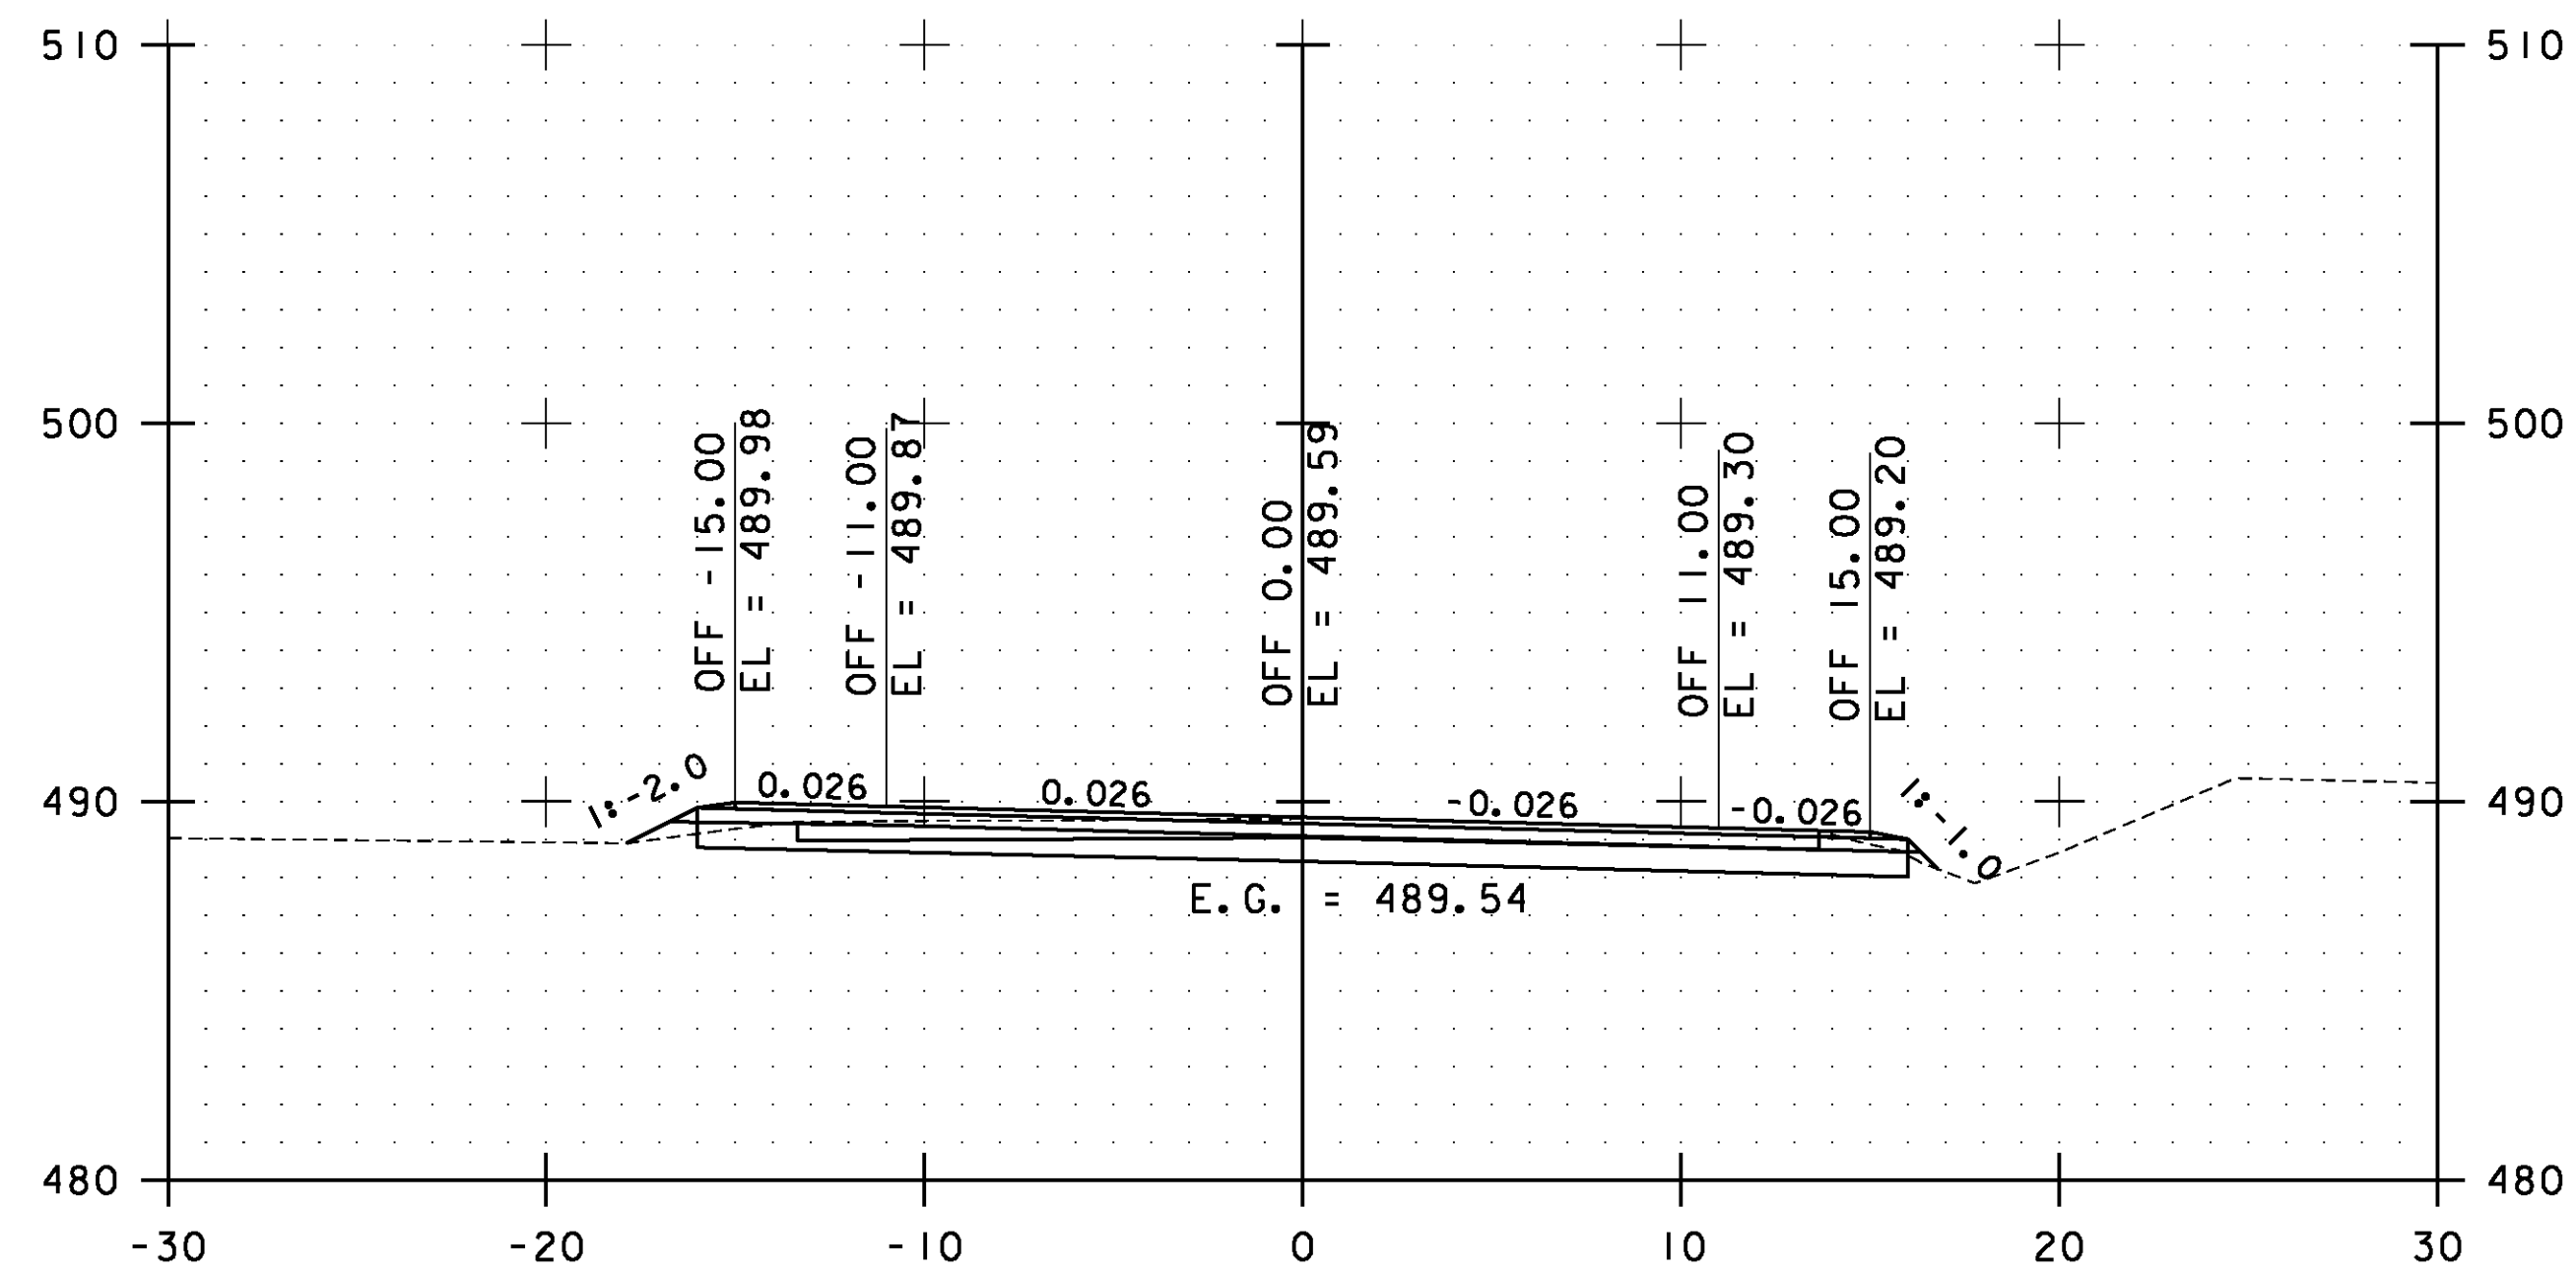


71+50.00

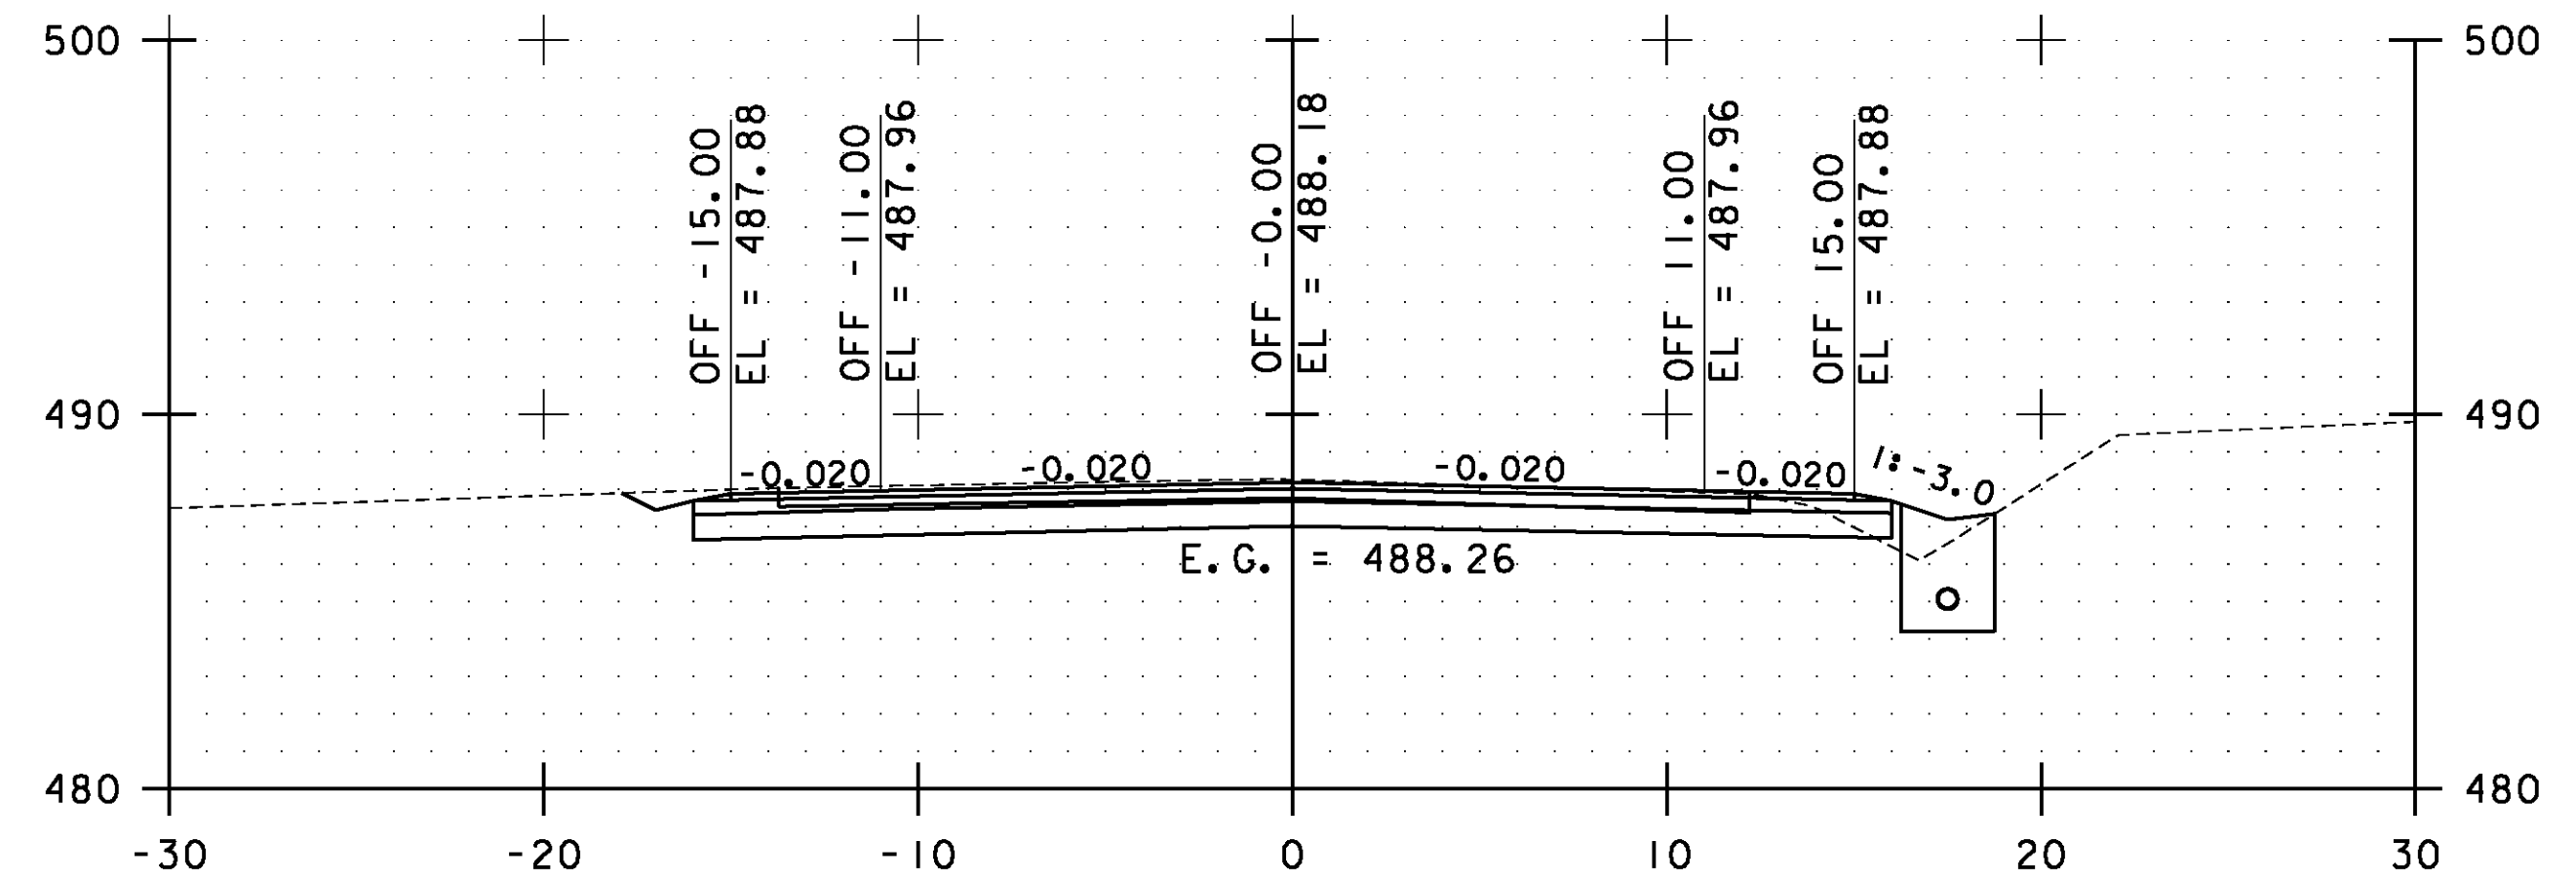

73+50.00

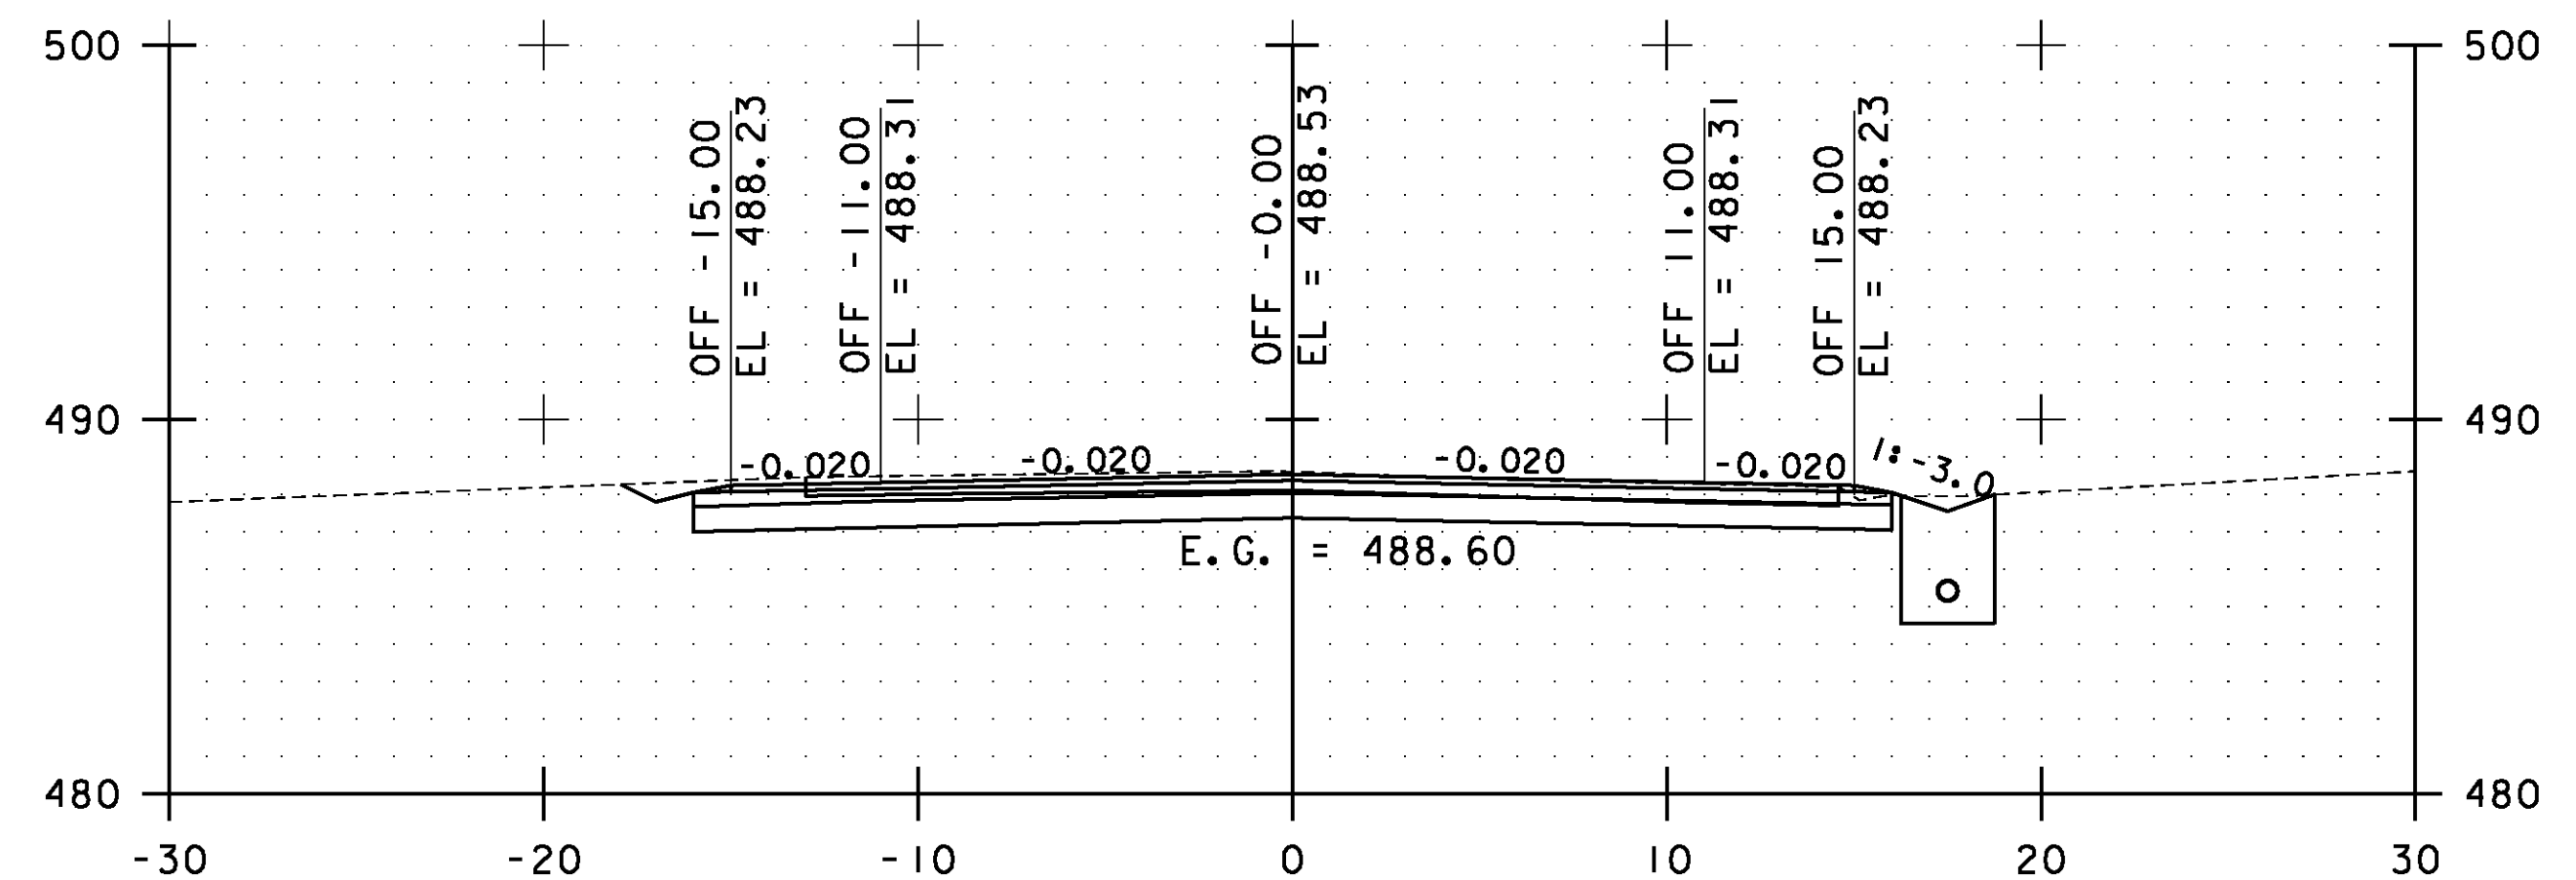


73+00.00

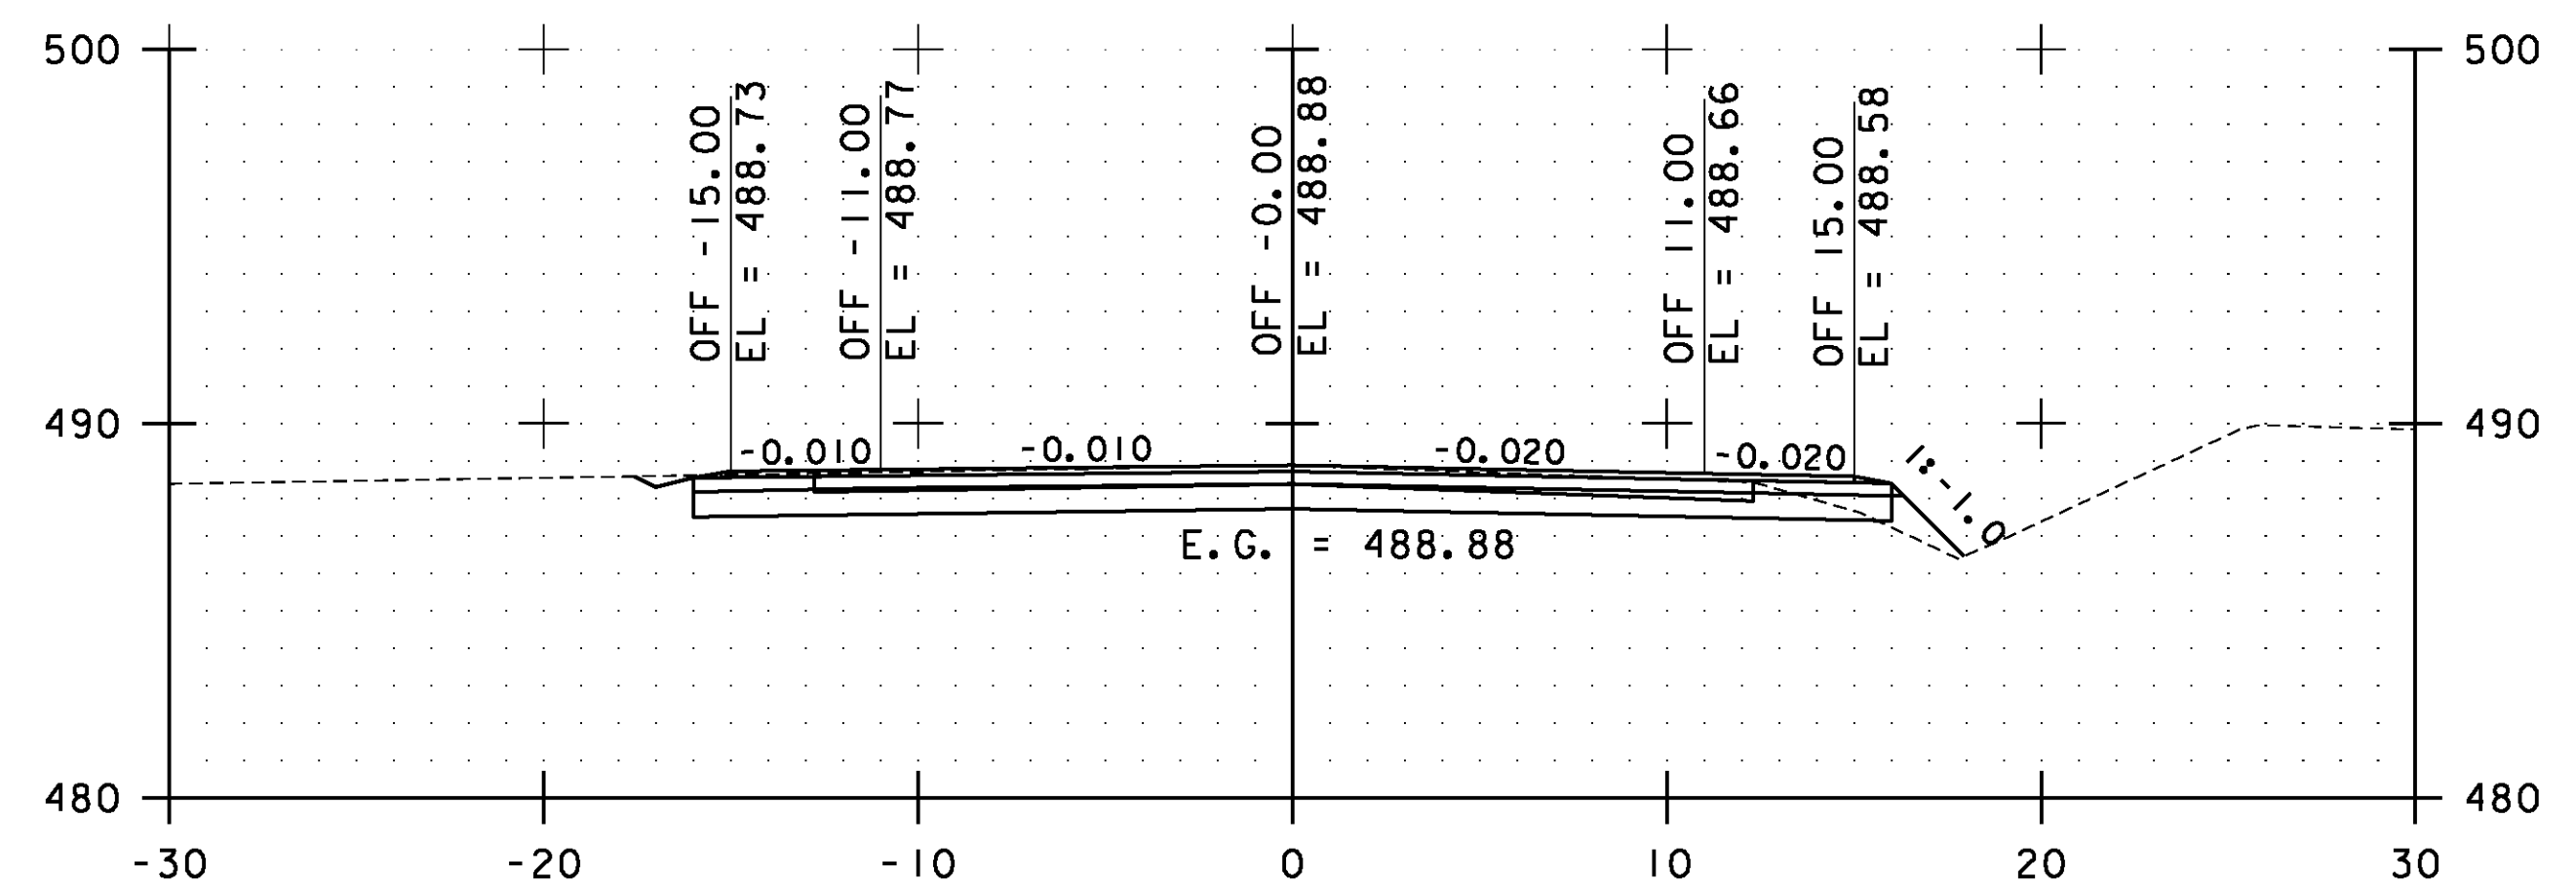

72+50.00

STA. 71+50.00 TO STA. 73+50.00

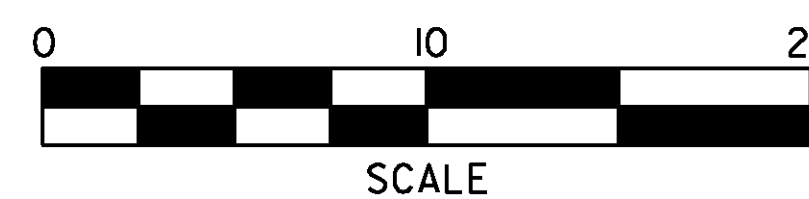

**ESSEX
CROSS
SECTIONS
SHEET #31**

PROJECT NAME: ESSEX-WESTFORD
PROJECT NUMBER: STP 2912(I)

FILE NAME: p10c226.dgn
PROJECT LEADER: JLL
DESIGNED BY: STANTEC
IPARM FILE: p10c226xs031.i

PLOT DATE: 2/20/2013
DRAWN BY: STANTEC
CHECKED BY: STANTEC
SHEET 122 OF 239