




74+50.00

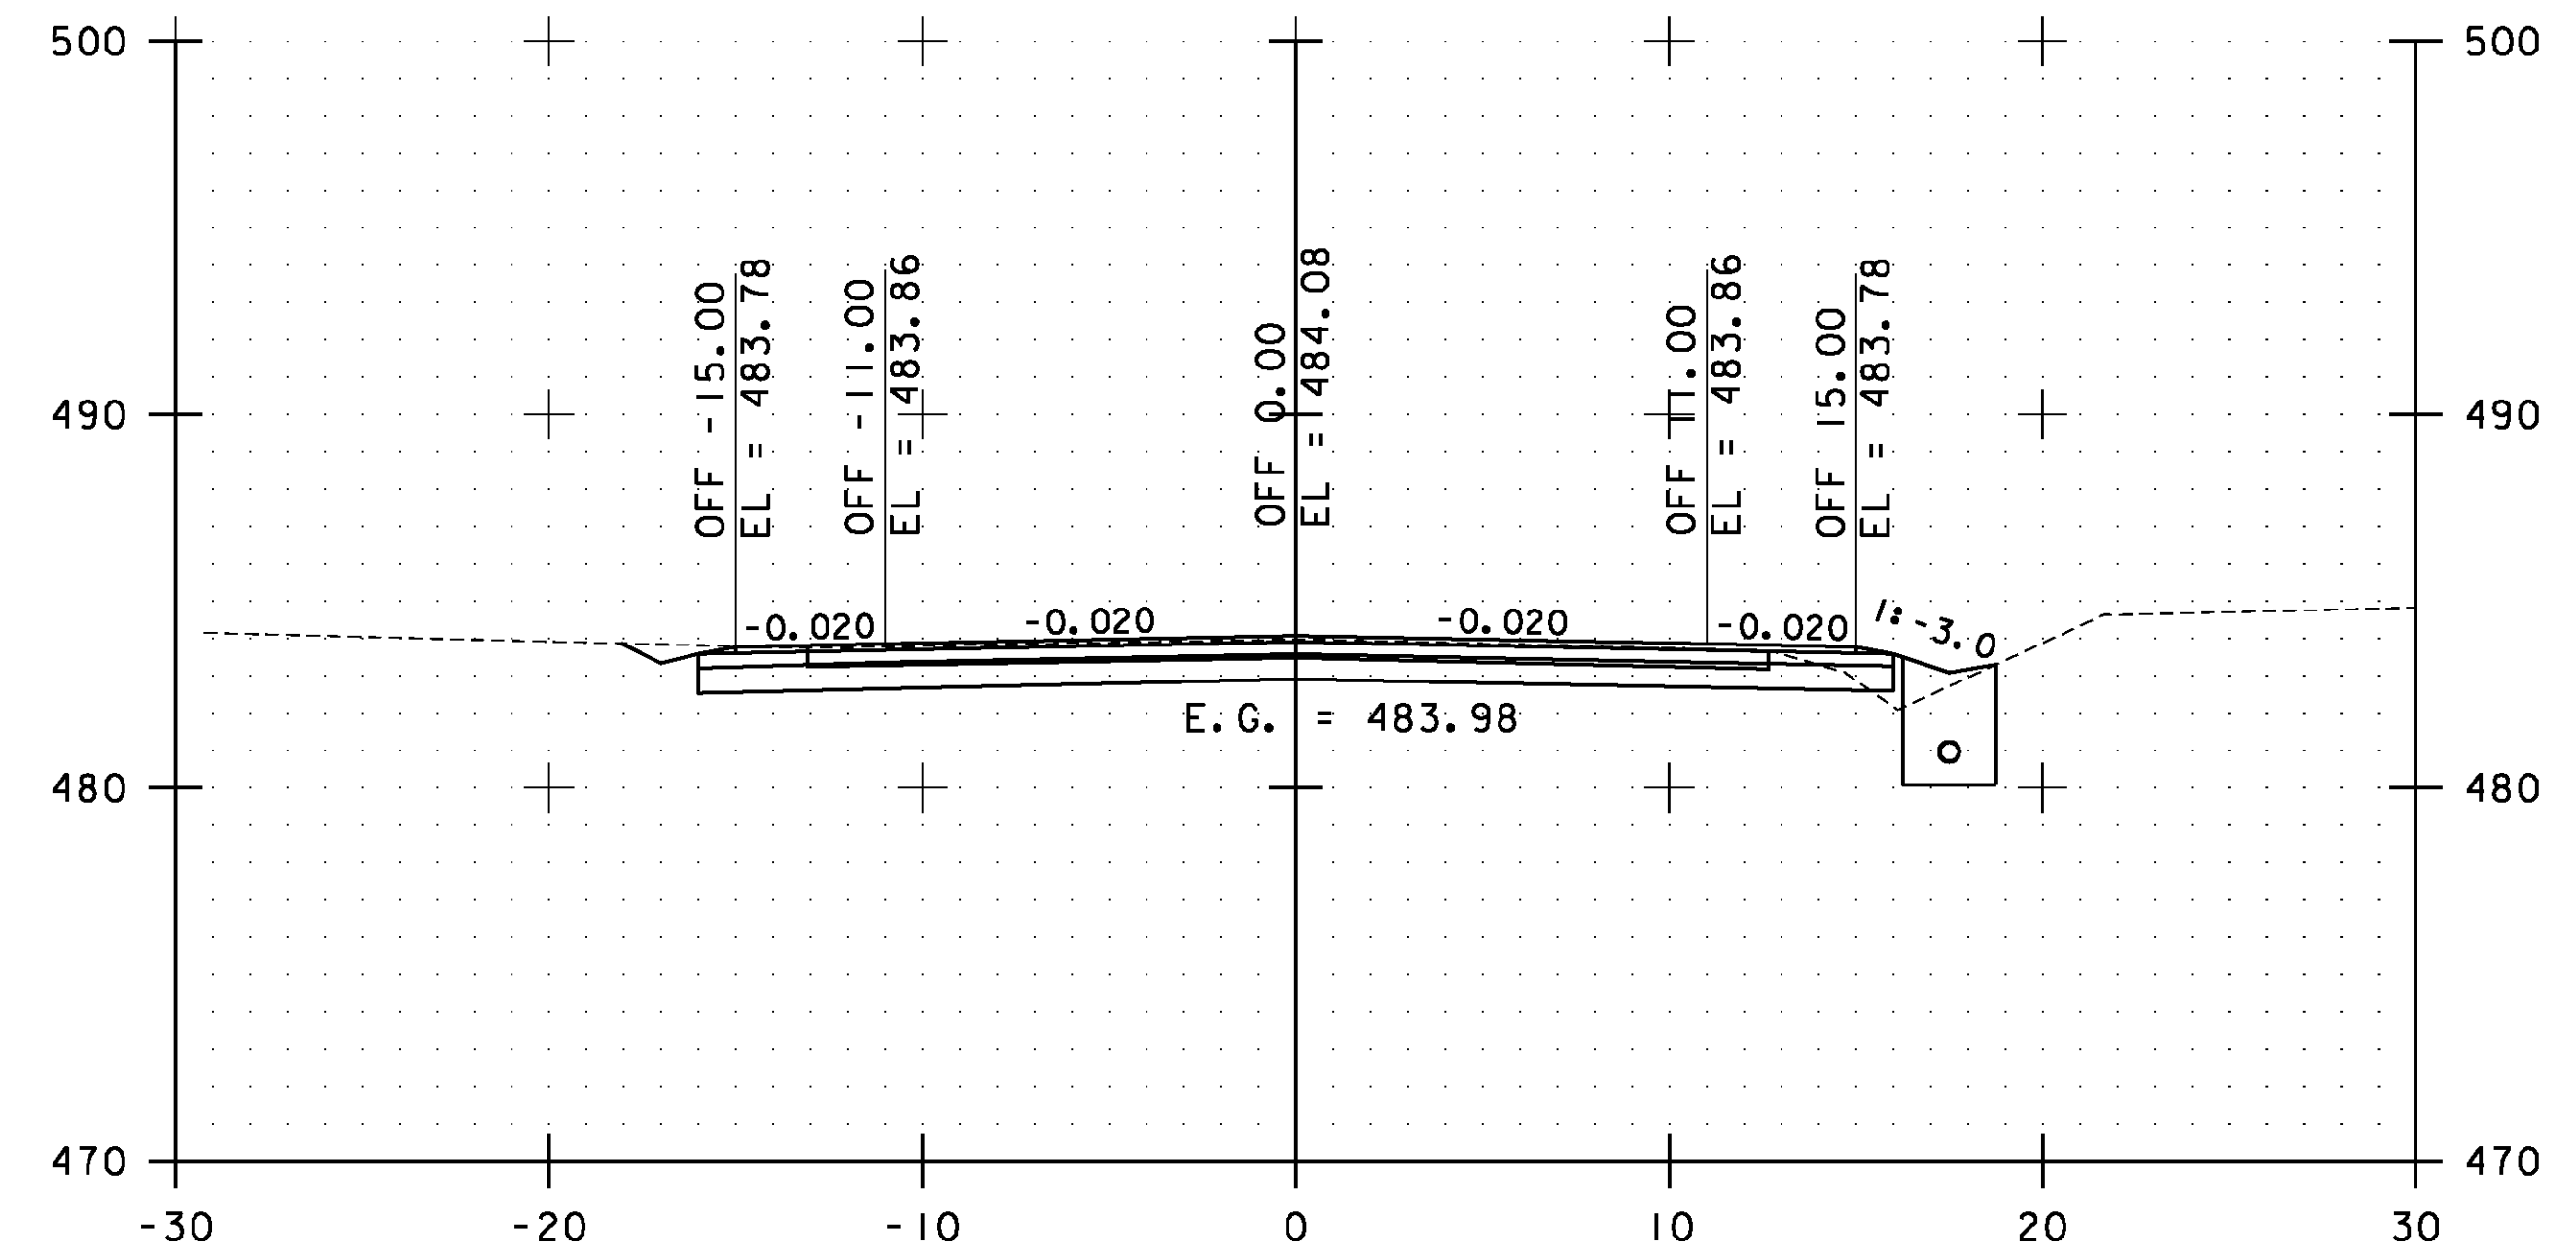

75+50.00

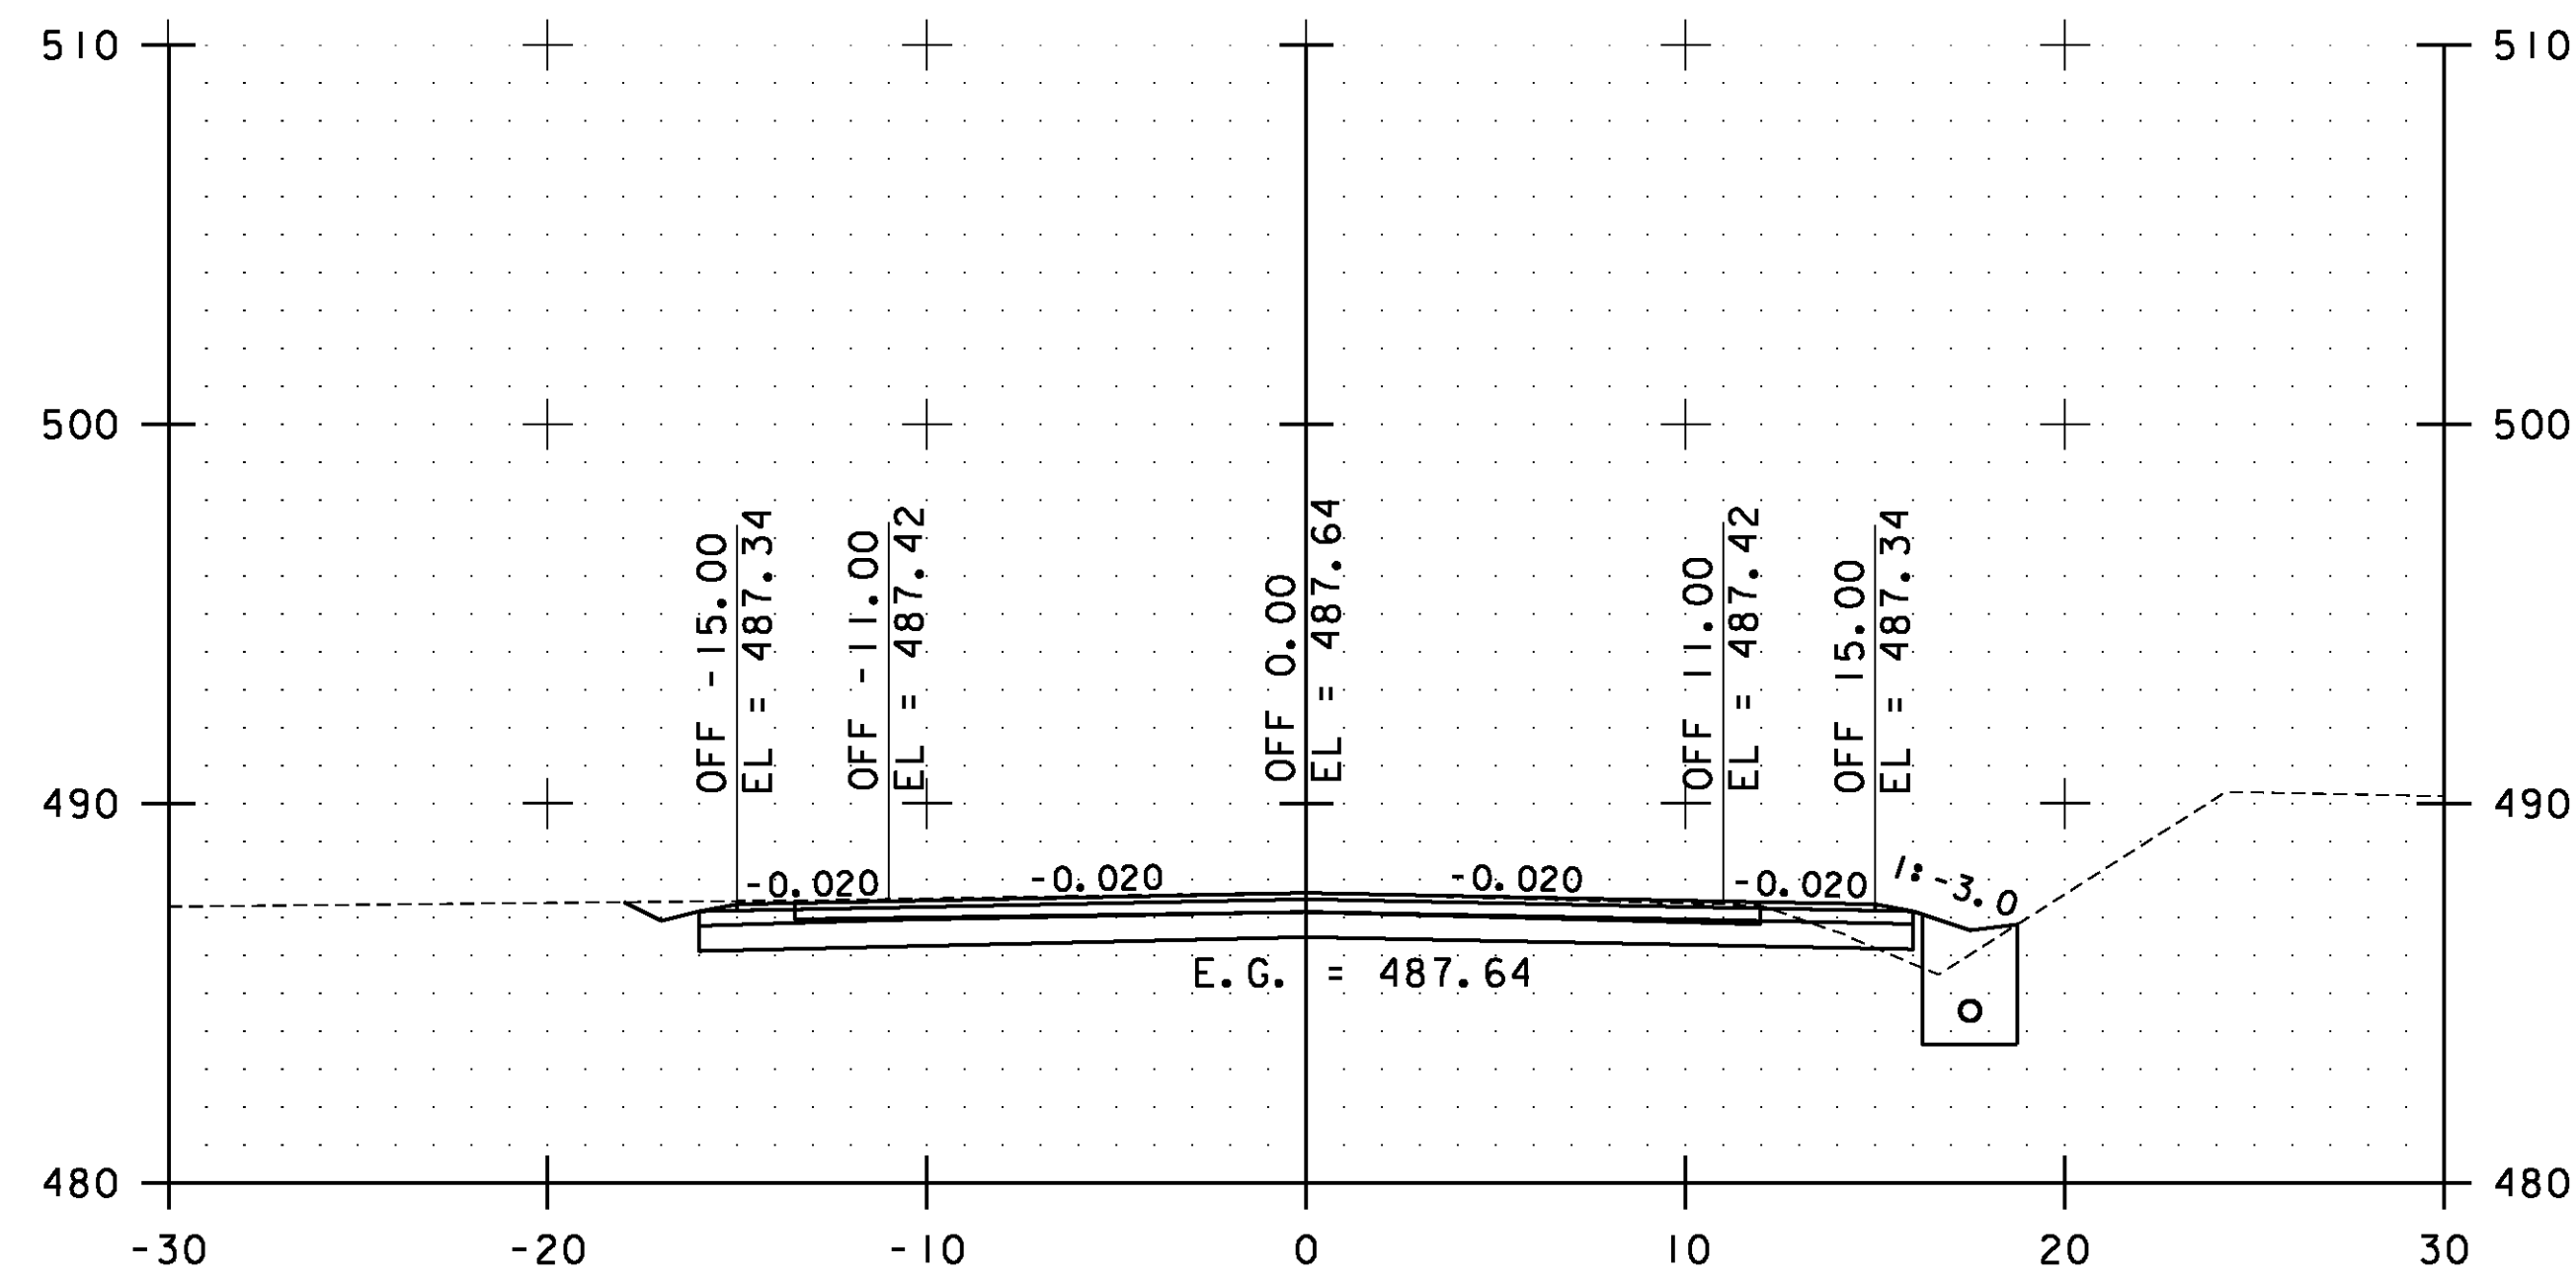


74+00.00

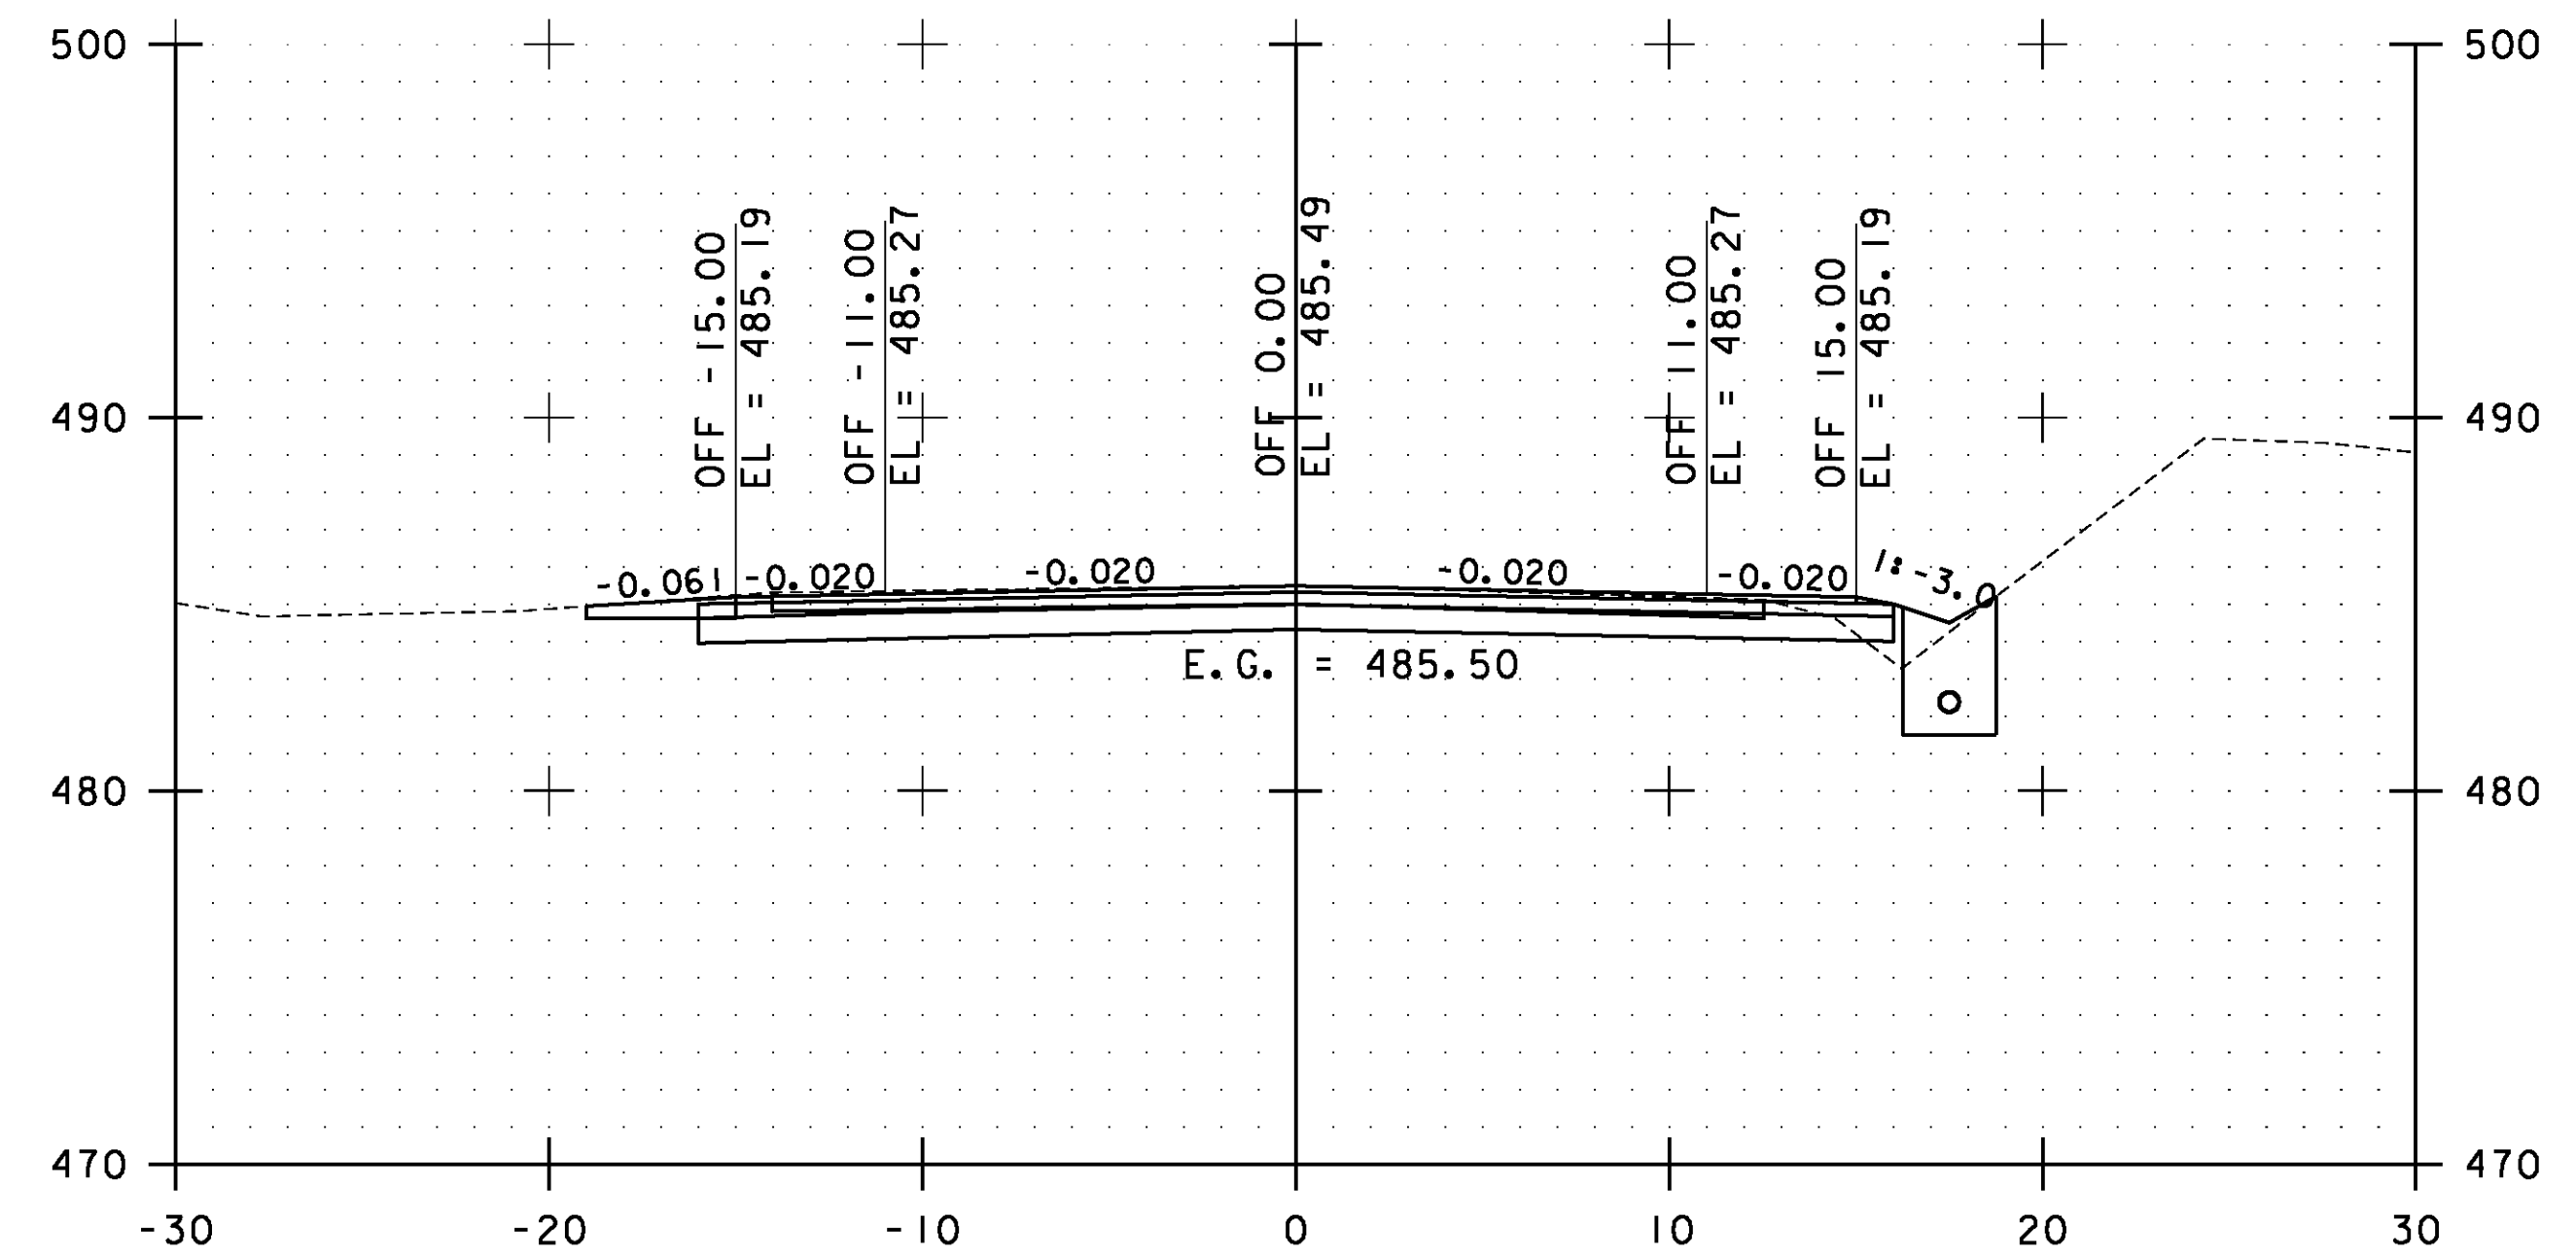

75+00.00

STA. 74+00.00 TO STA. 75+50.00

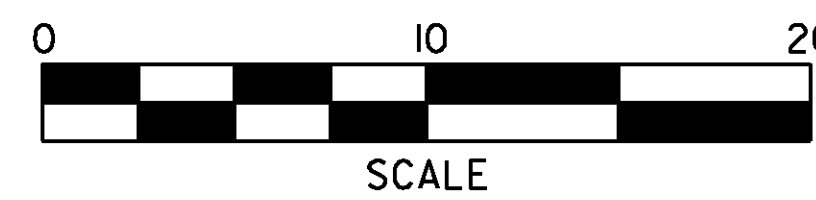

**ESSEX  
CROSS  
SECTIONS  
SHEET #32**

PROJECT NAME: ESSEX-WESTFORD  
PROJECT NUMBER: STP 2912(I)

FILE NAME: p10c226.dgn  
PROJECT LEADER: JLL  
DESIGNED BY: STANTEC  
IPARM FILE: p10c226xs032.i

PLOT DATE: 2/20/2013  
DRAWN BY: STANTEC  
CHECKED BY: STANTEC  
SHEET 123 OF 239