




80+00.00

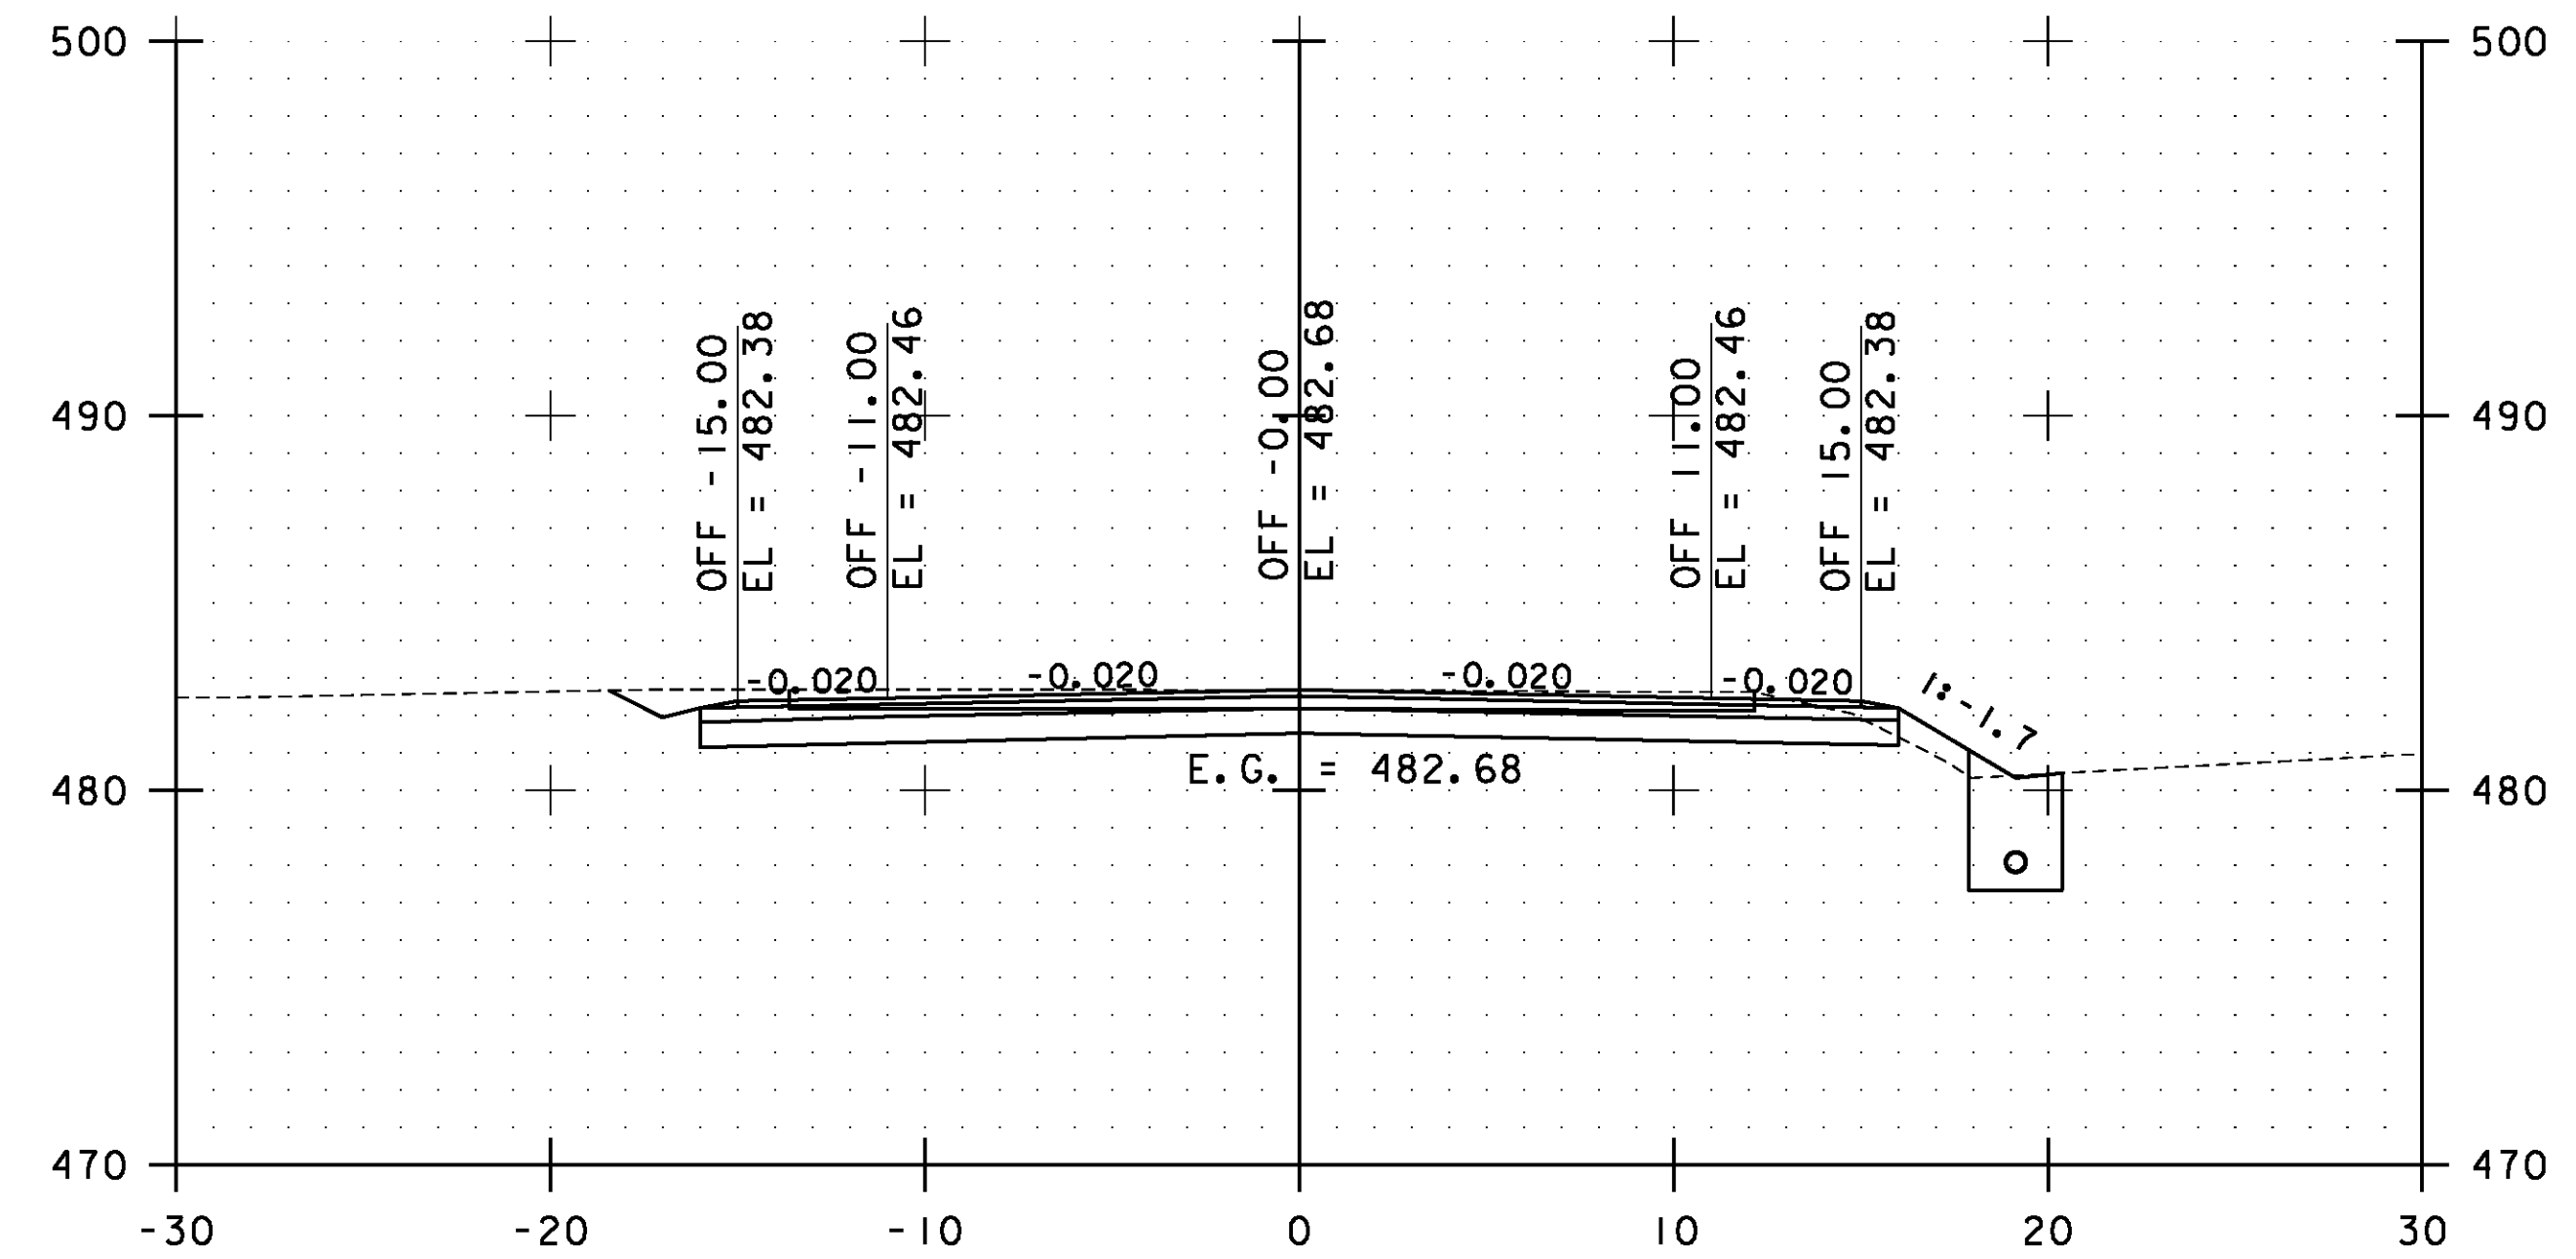

81+00.00

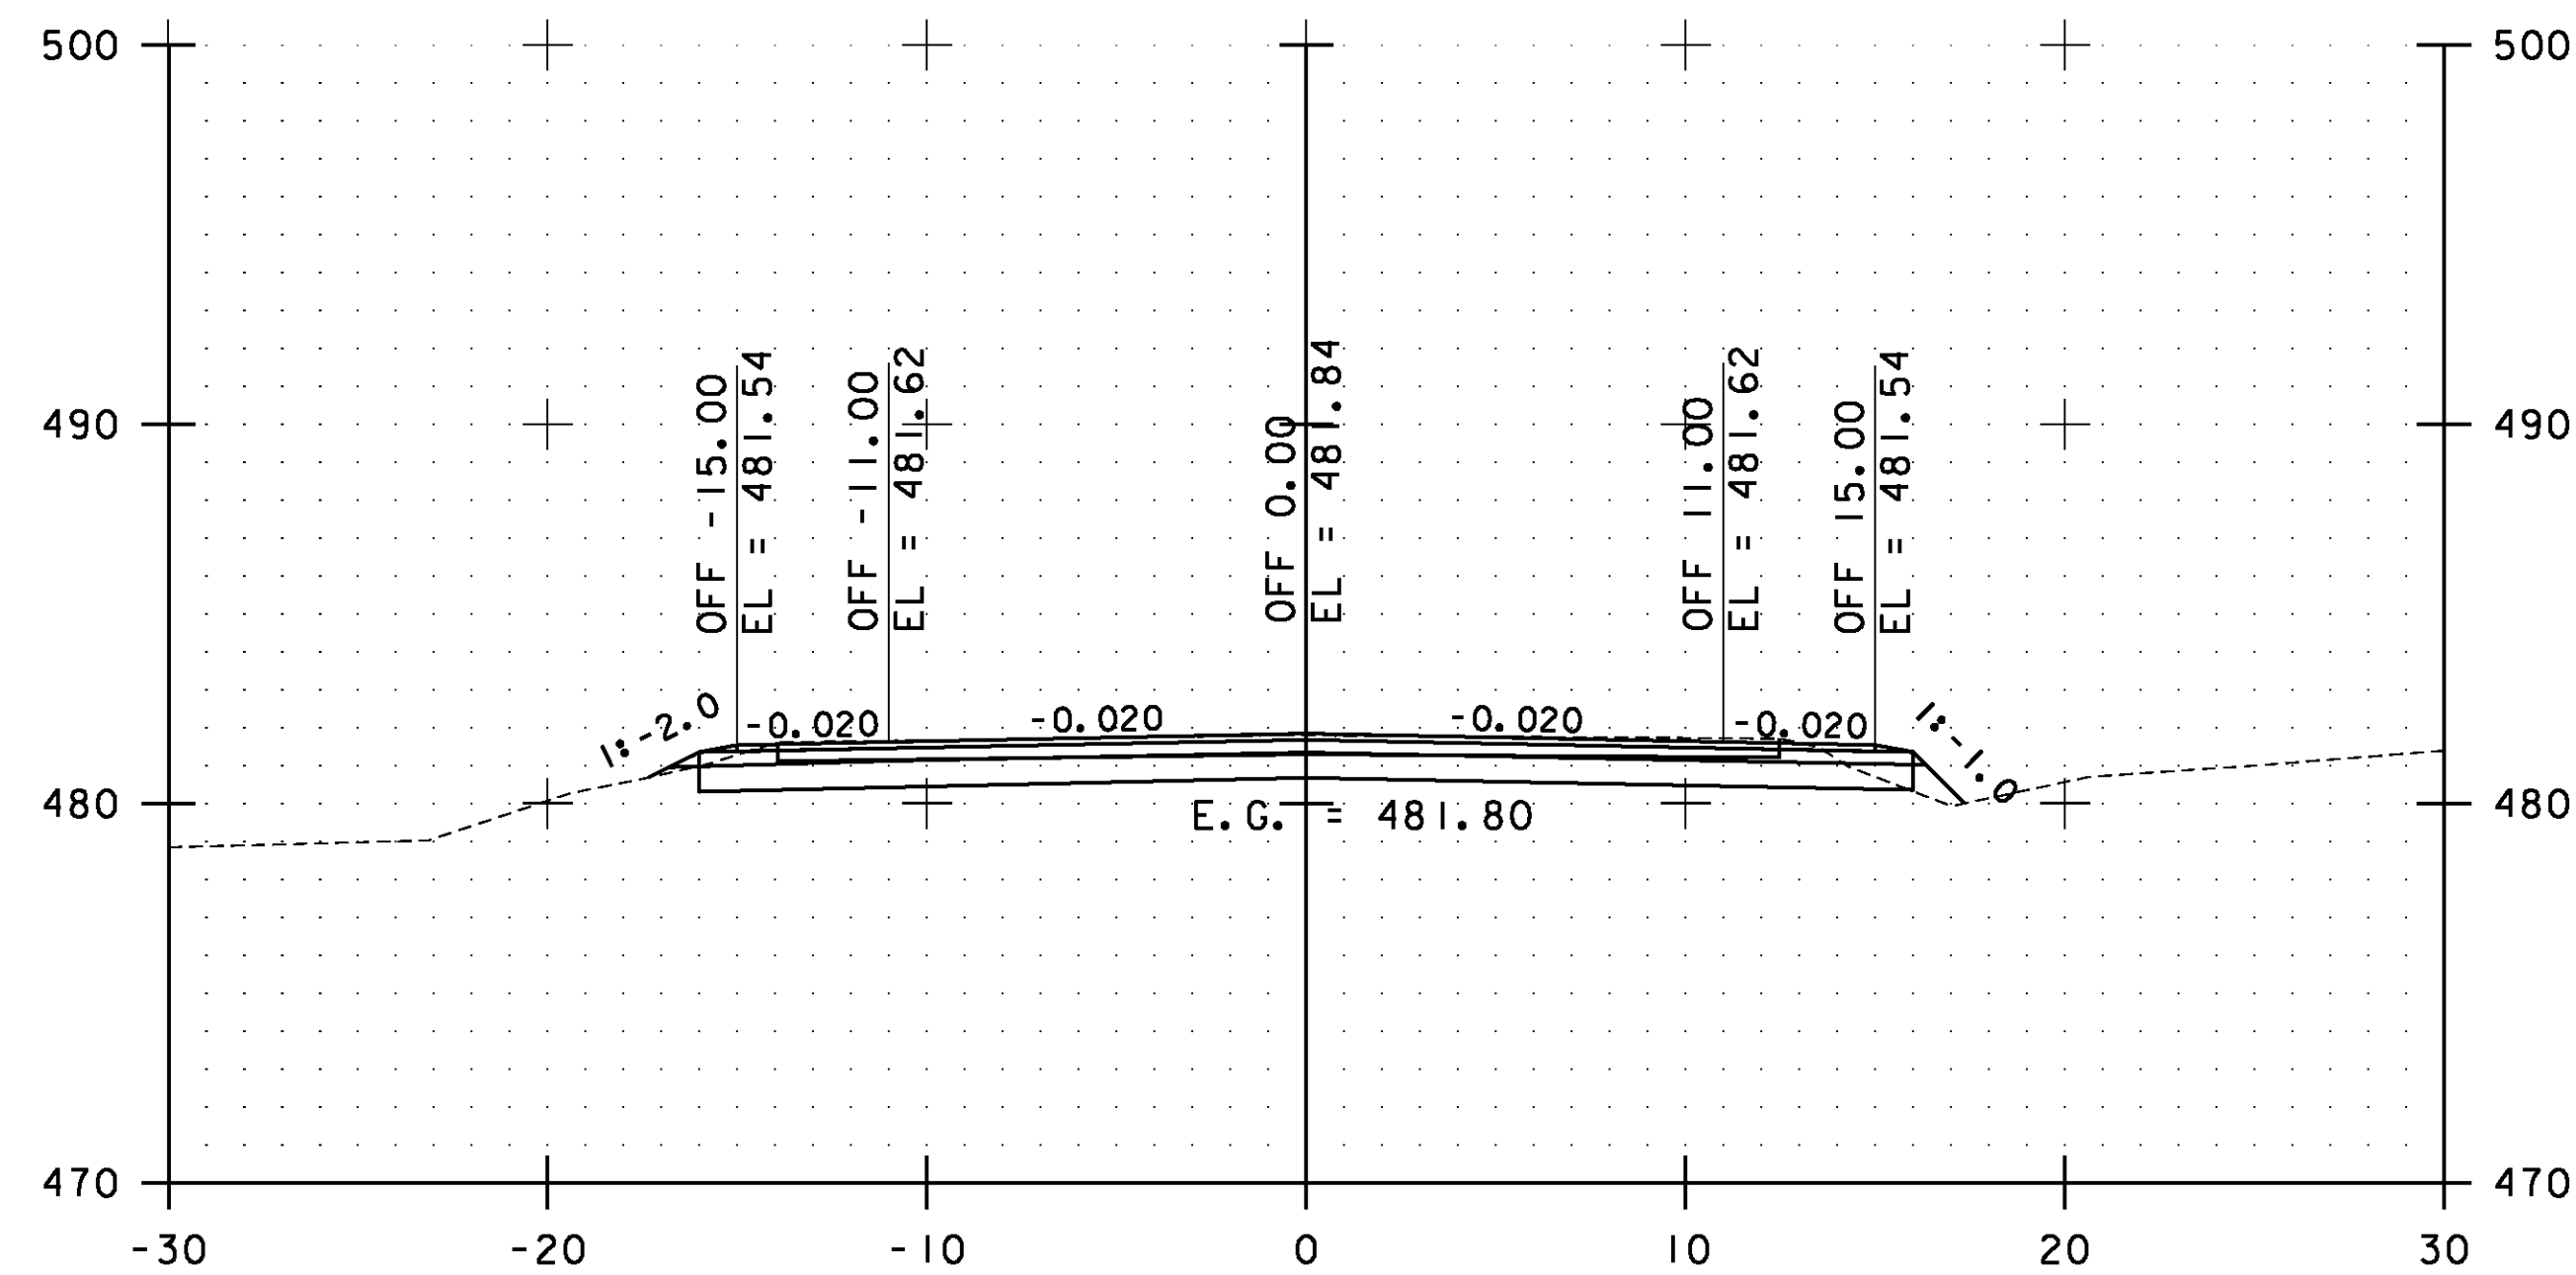


79+50.00

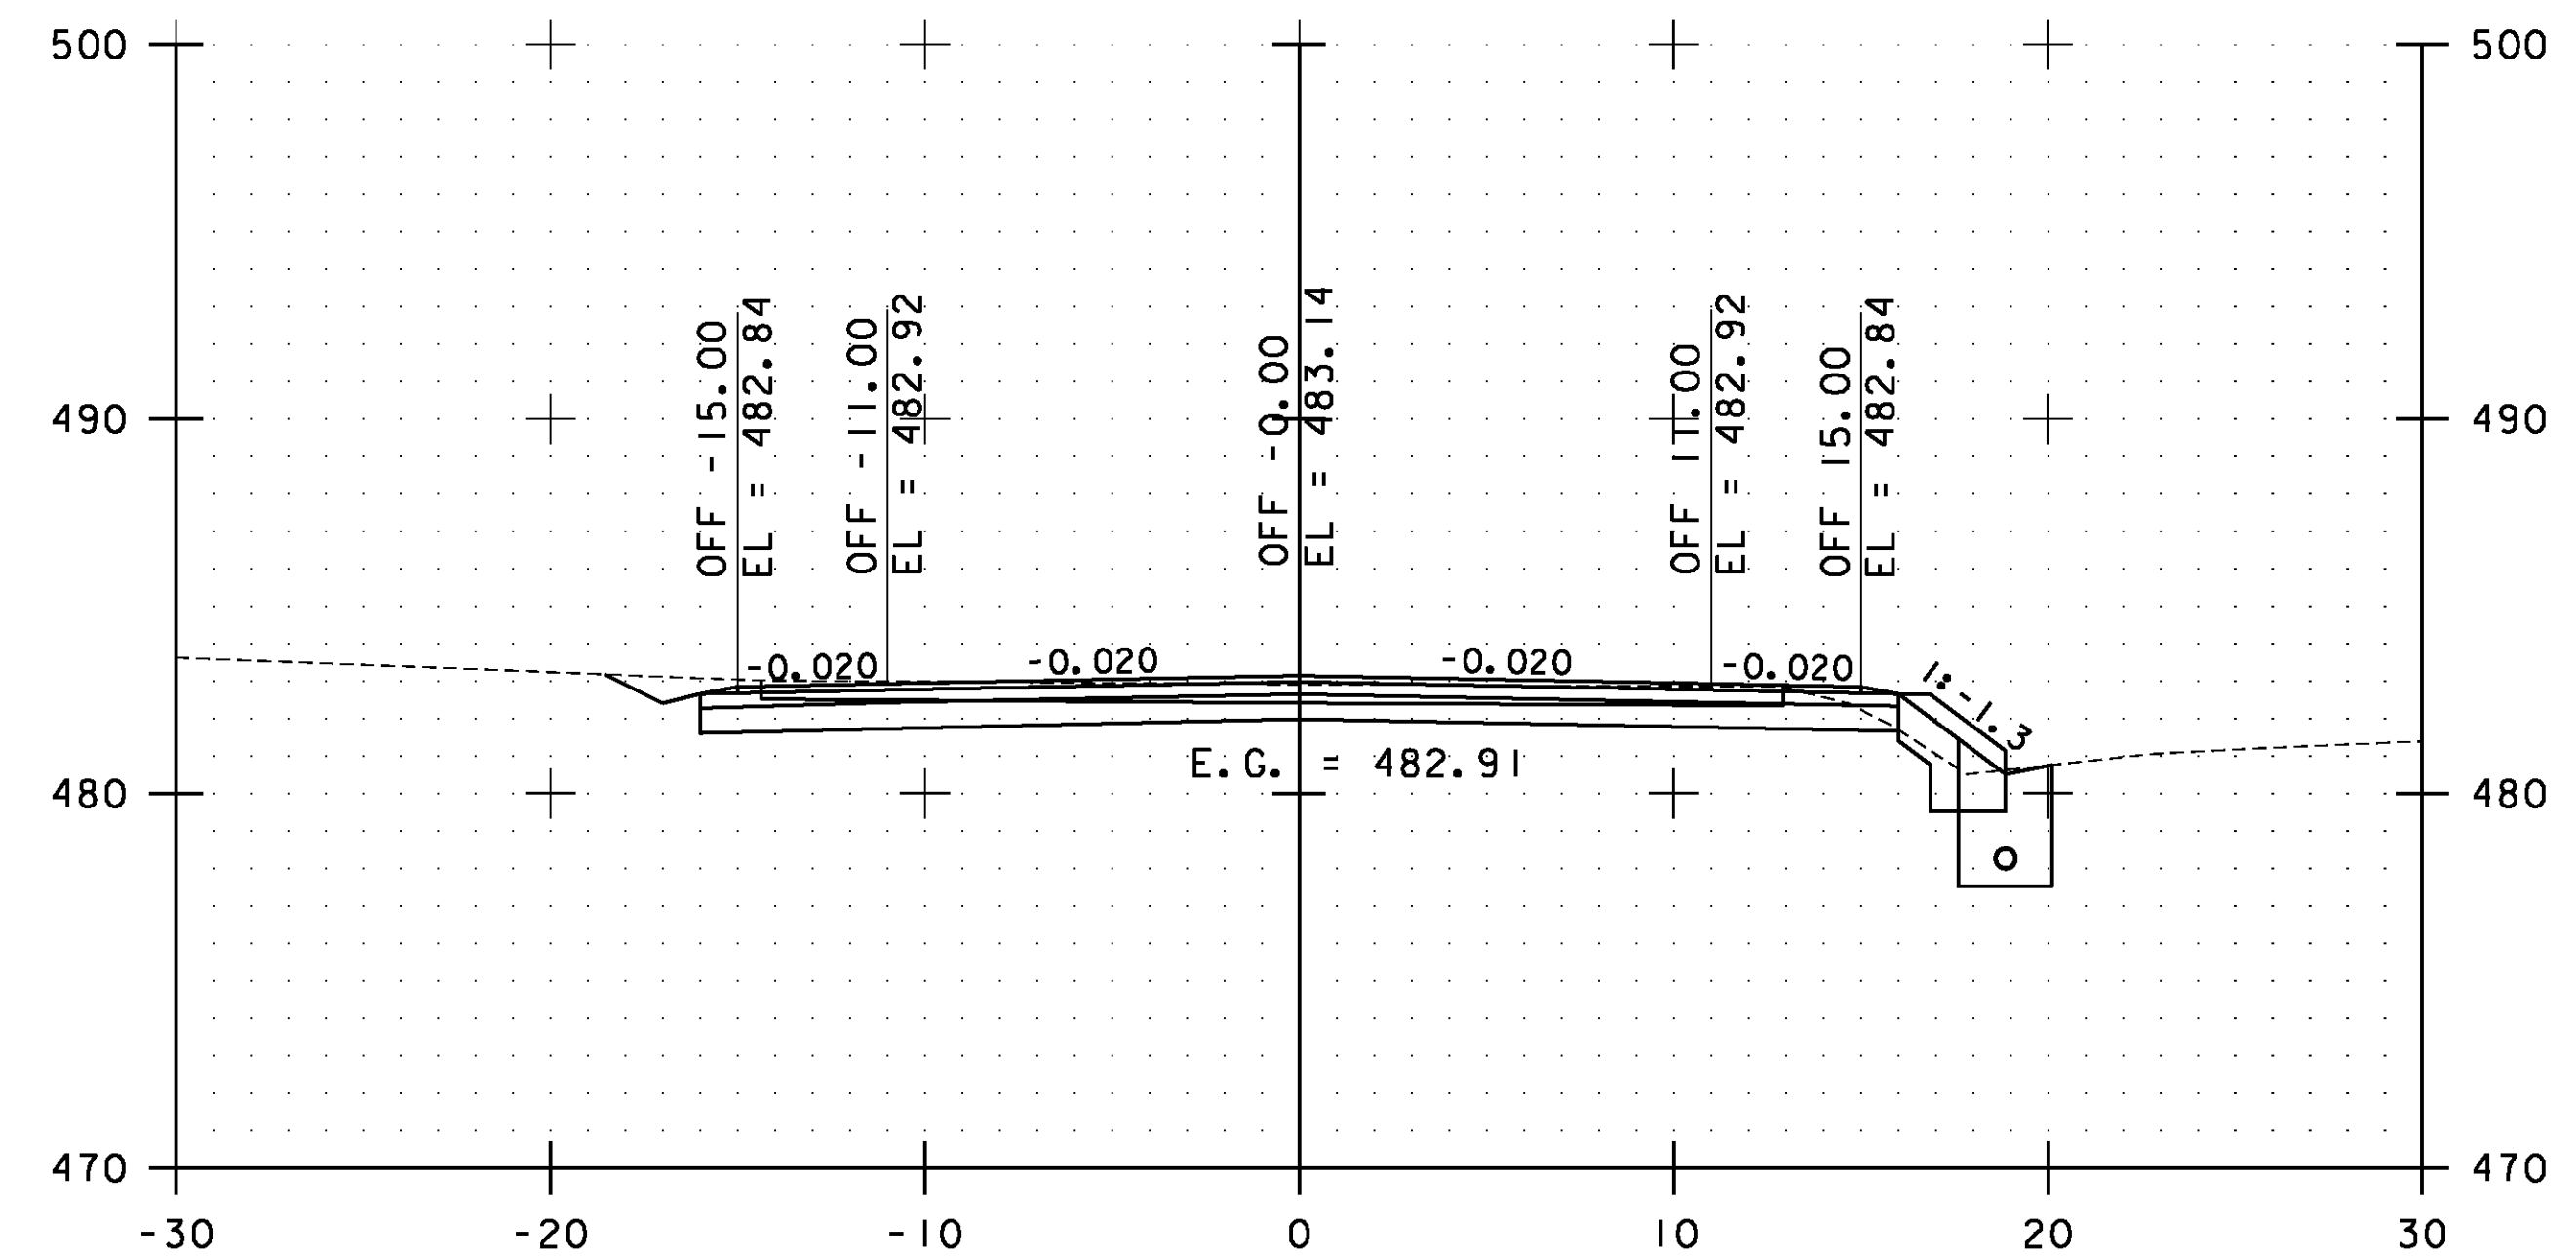

80+50.00

STA. 79+50.00 TO STA. 81+00.00

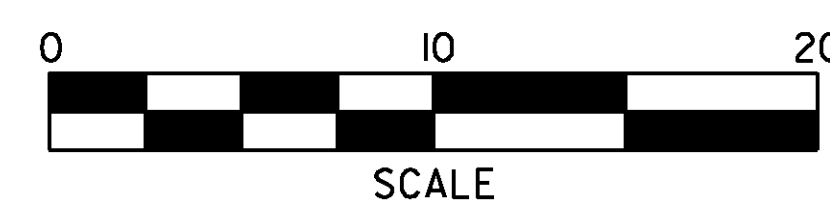

**ESSEX
CROSS
SECTIONS
SHEET #35**

PROJECT NAME:	ESSEX-WESTFORD	PLOT DATE:	2/20/2013
PROJECT NUMBER:	STP 2912(I)	DRAWN BY:	STANTEC
FILE NAME:	p10c226.dgn	DESIGNED BY:	STANTEC
PROJECT LEADER:	JLL	CHECKED BY:	STANTEC
IPARM FILE:	p10c226xs035.i	SHEET	126 OF 239