




86+50.00

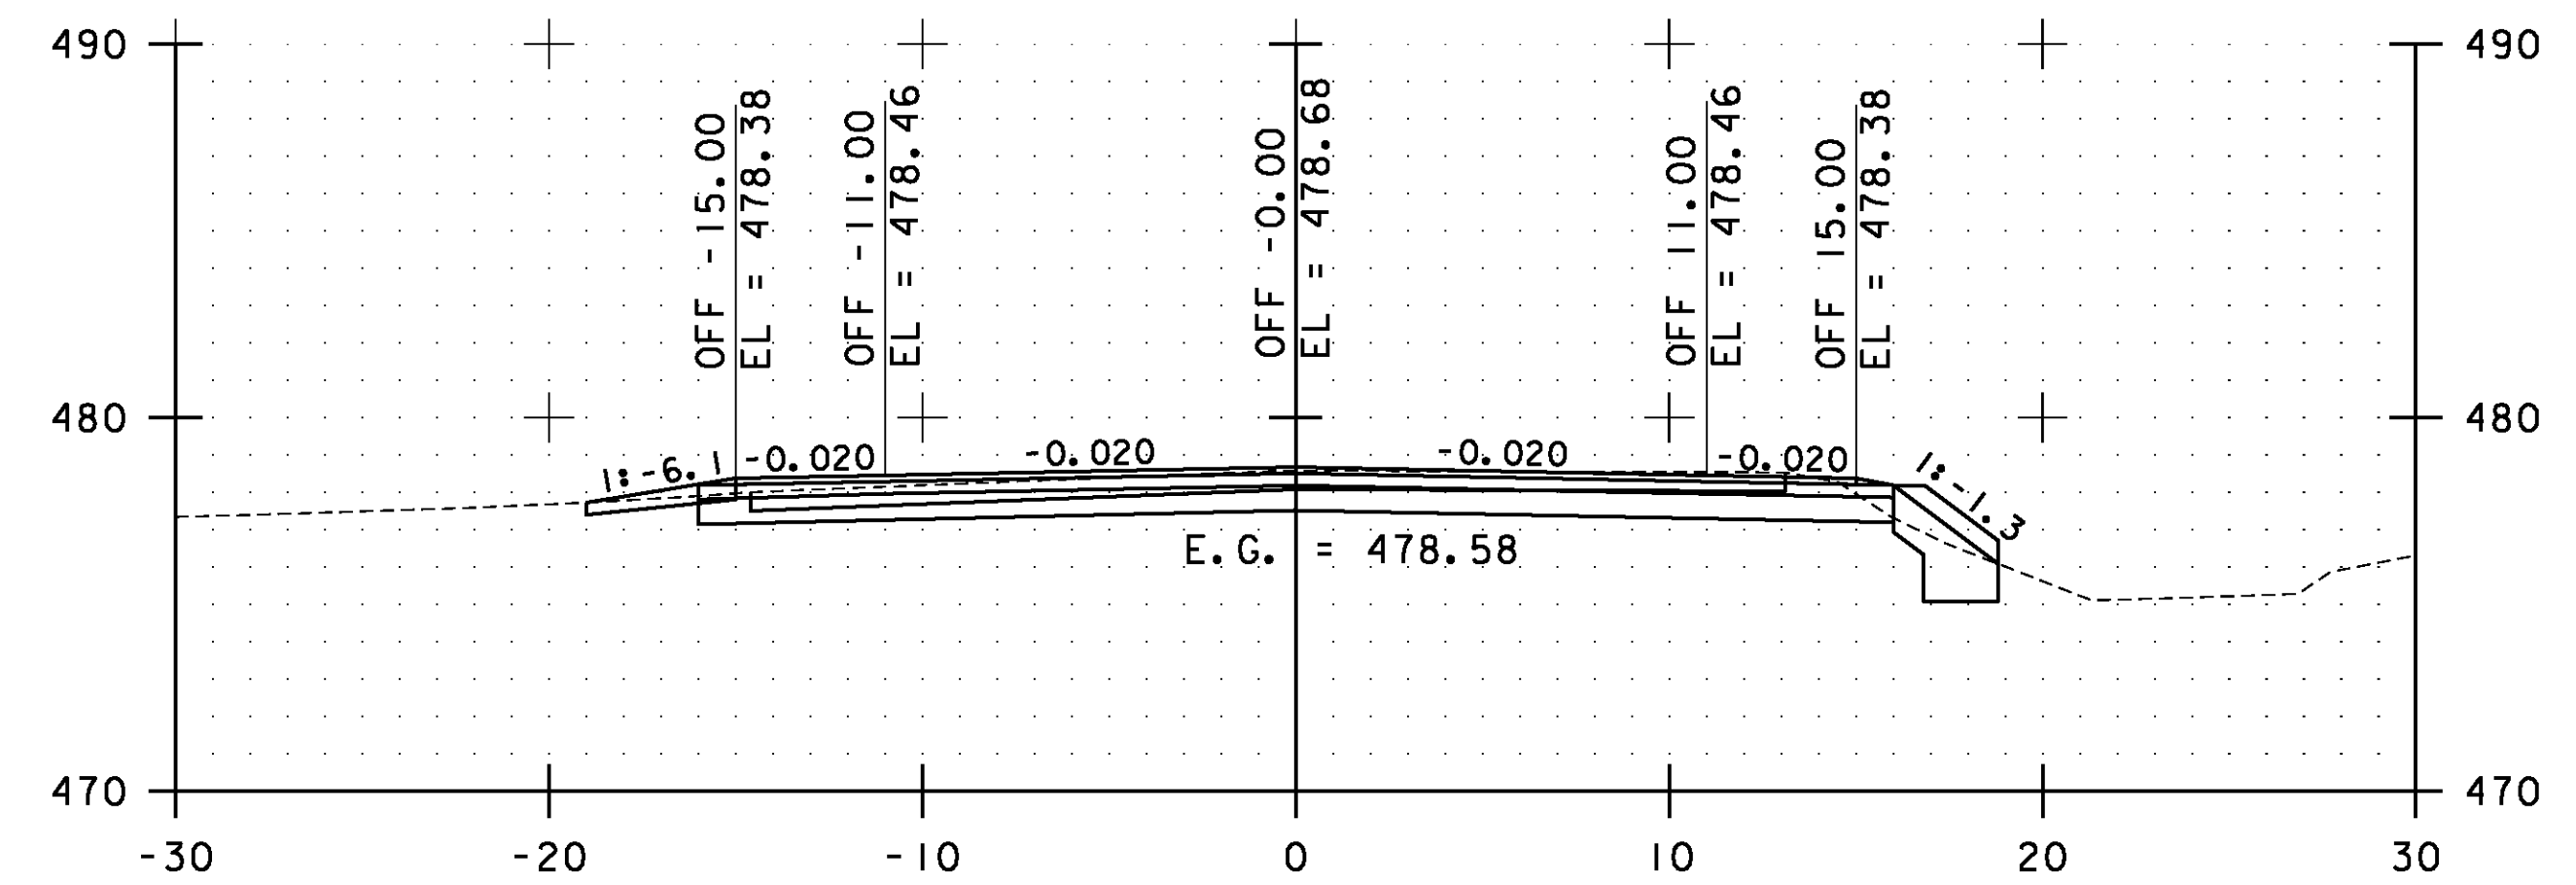

87+50.00

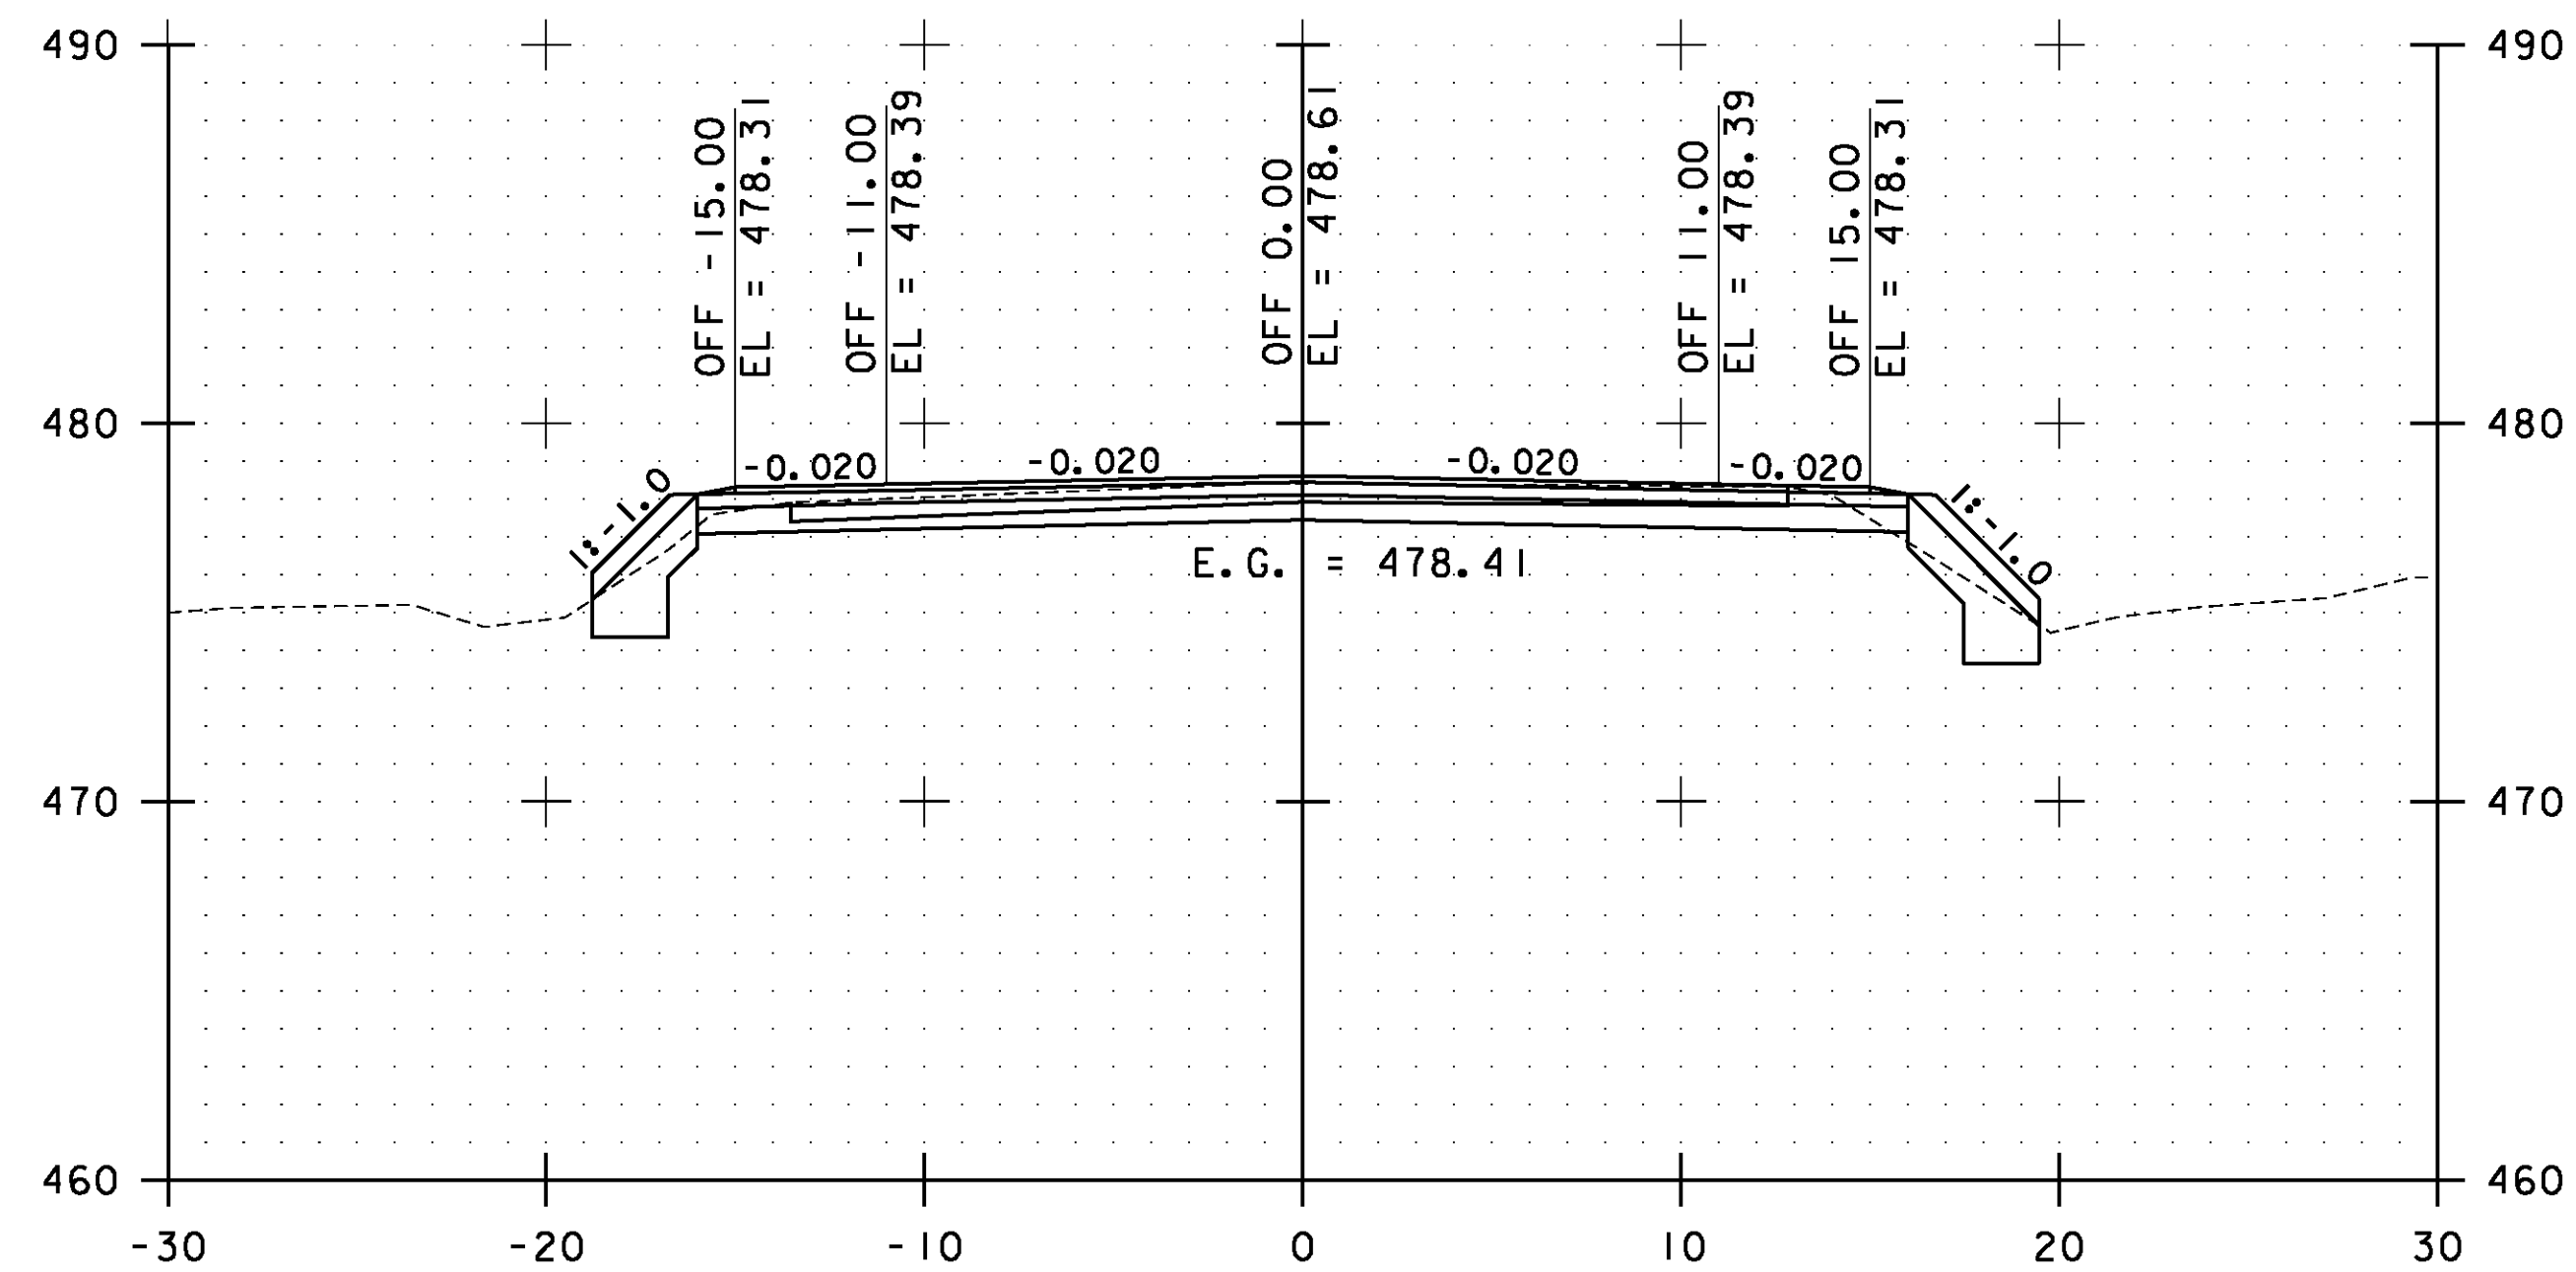


86+00.00

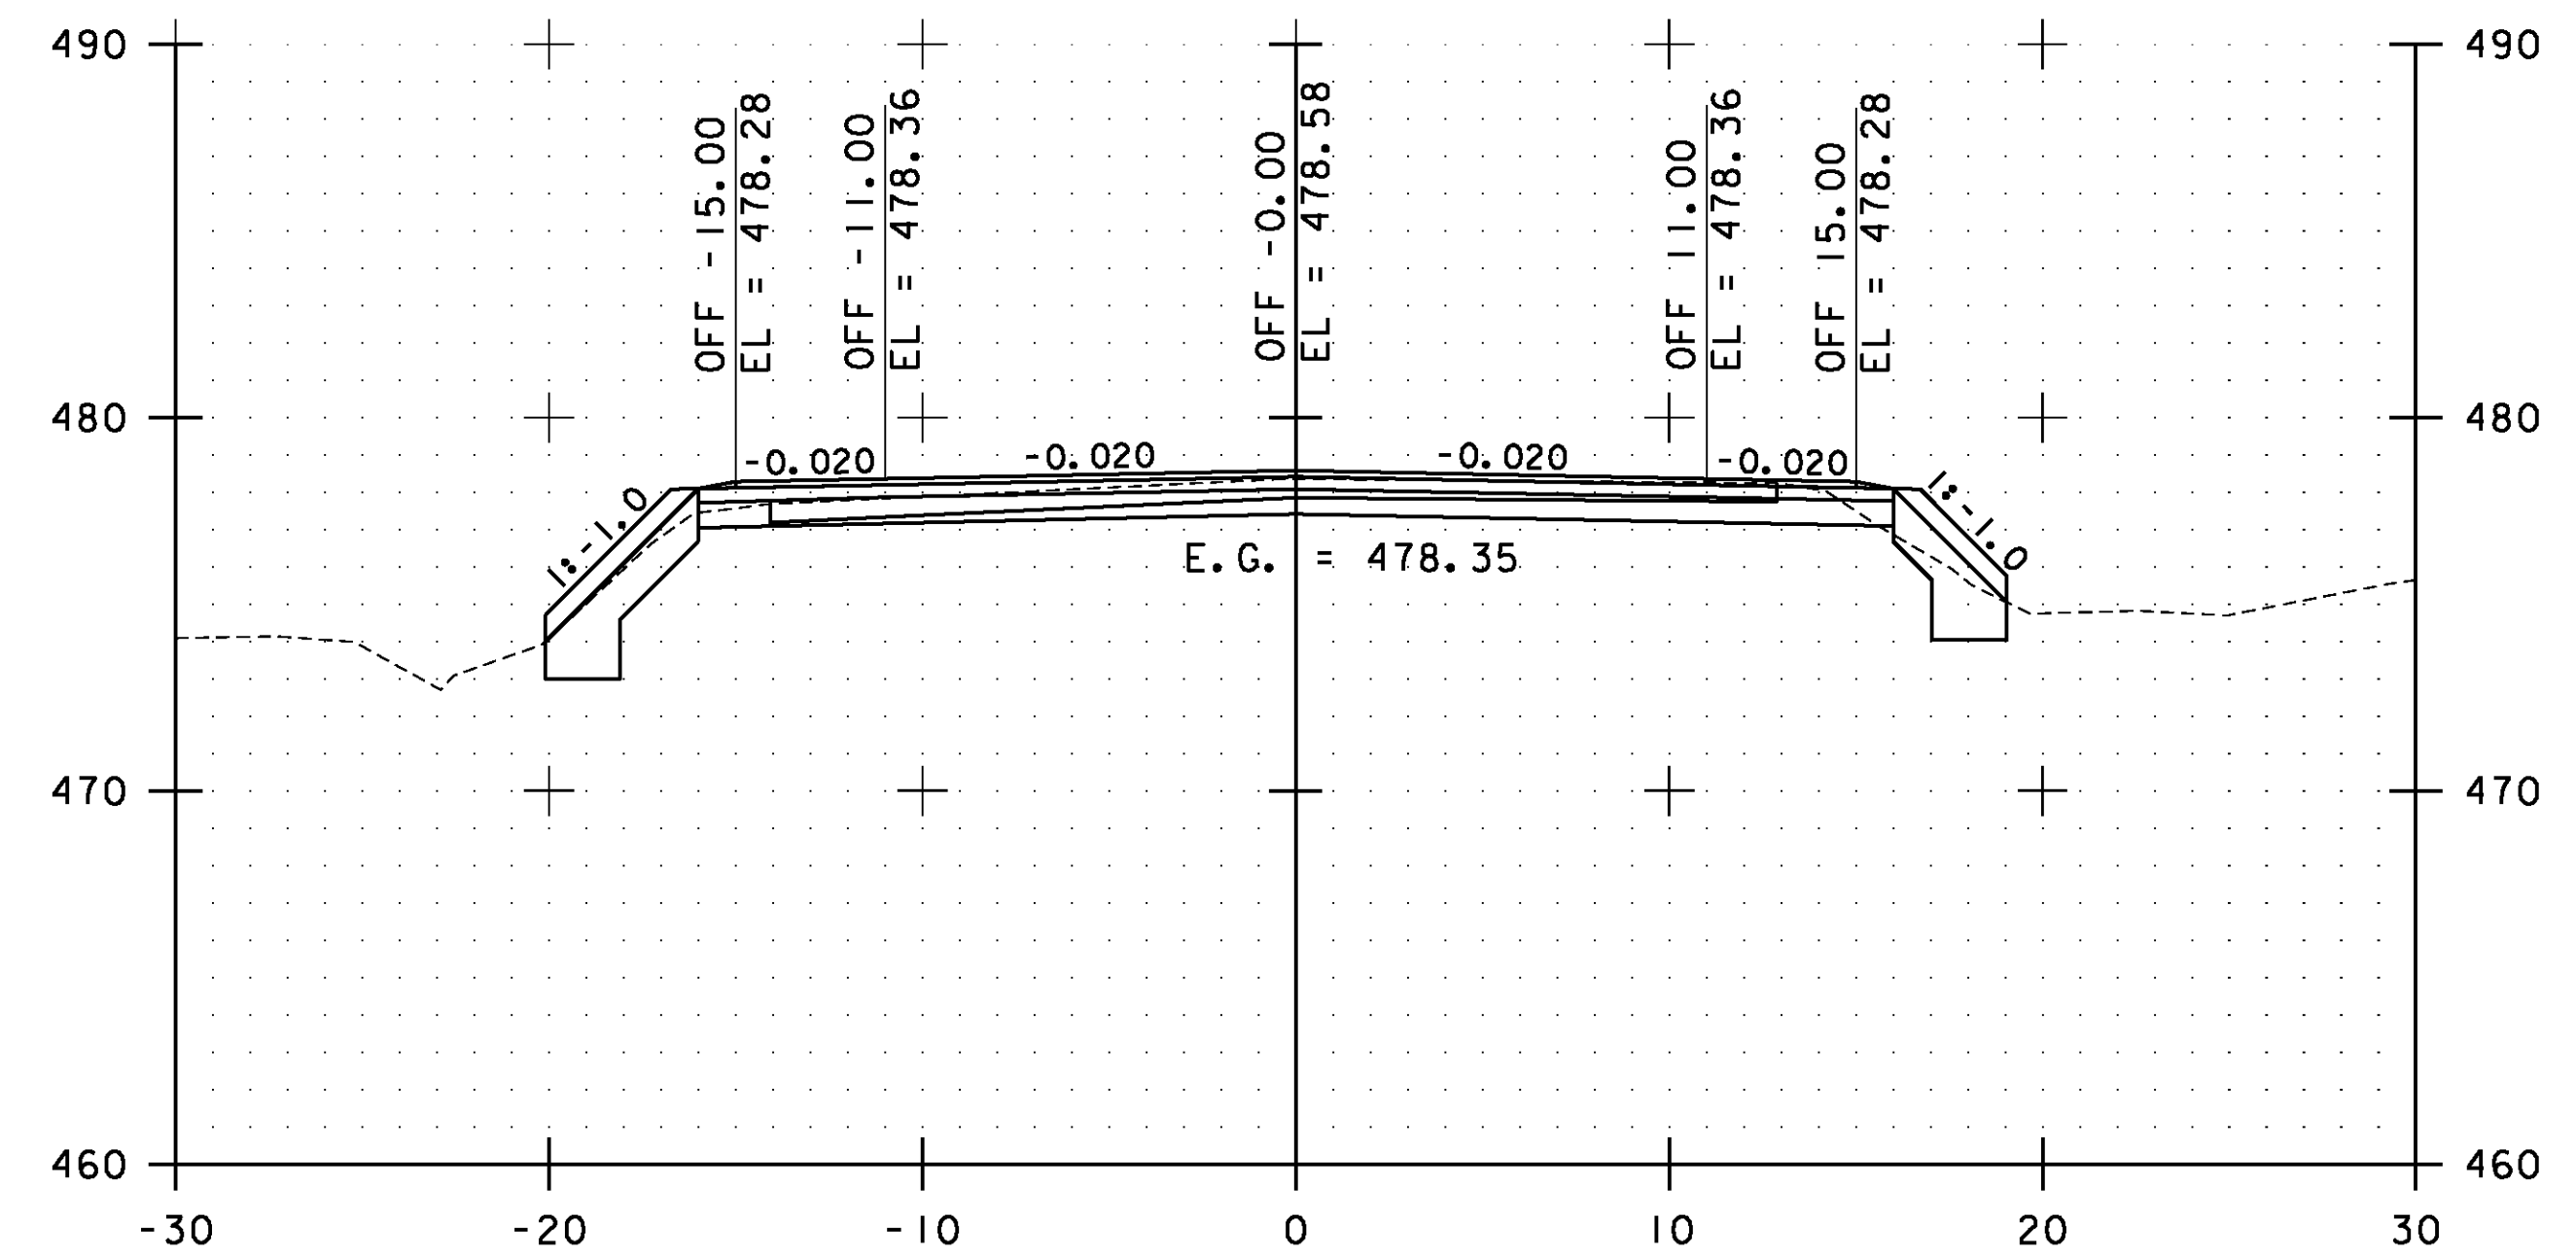

87+00.00

STA. 86+00.00 TO STA. 87+50.00

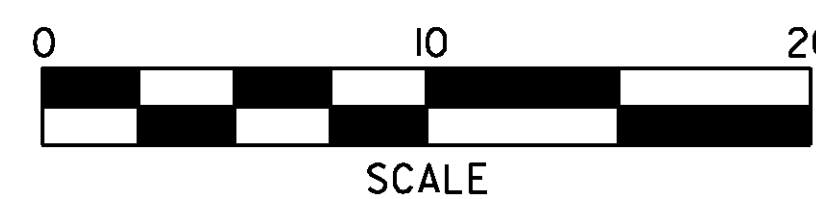

**ESSEX
CROSS
SECTIONS
SHEET #38**

PROJECT NAME: ESSEX-WESTFORD
PROJECT NUMBER: STP 2912(I)

FILE NAME: p10c226.dgn
PROJECT LEADER: JLL
DESIGNED BY: STANTEC
IPARM FILE: p10c226xs038.i

PLOT DATE: 2/20/2013
DRAWN BY: STANTEC
CHECKED BY: STANTEC
SHEET 129 OF 239