




91+00.00

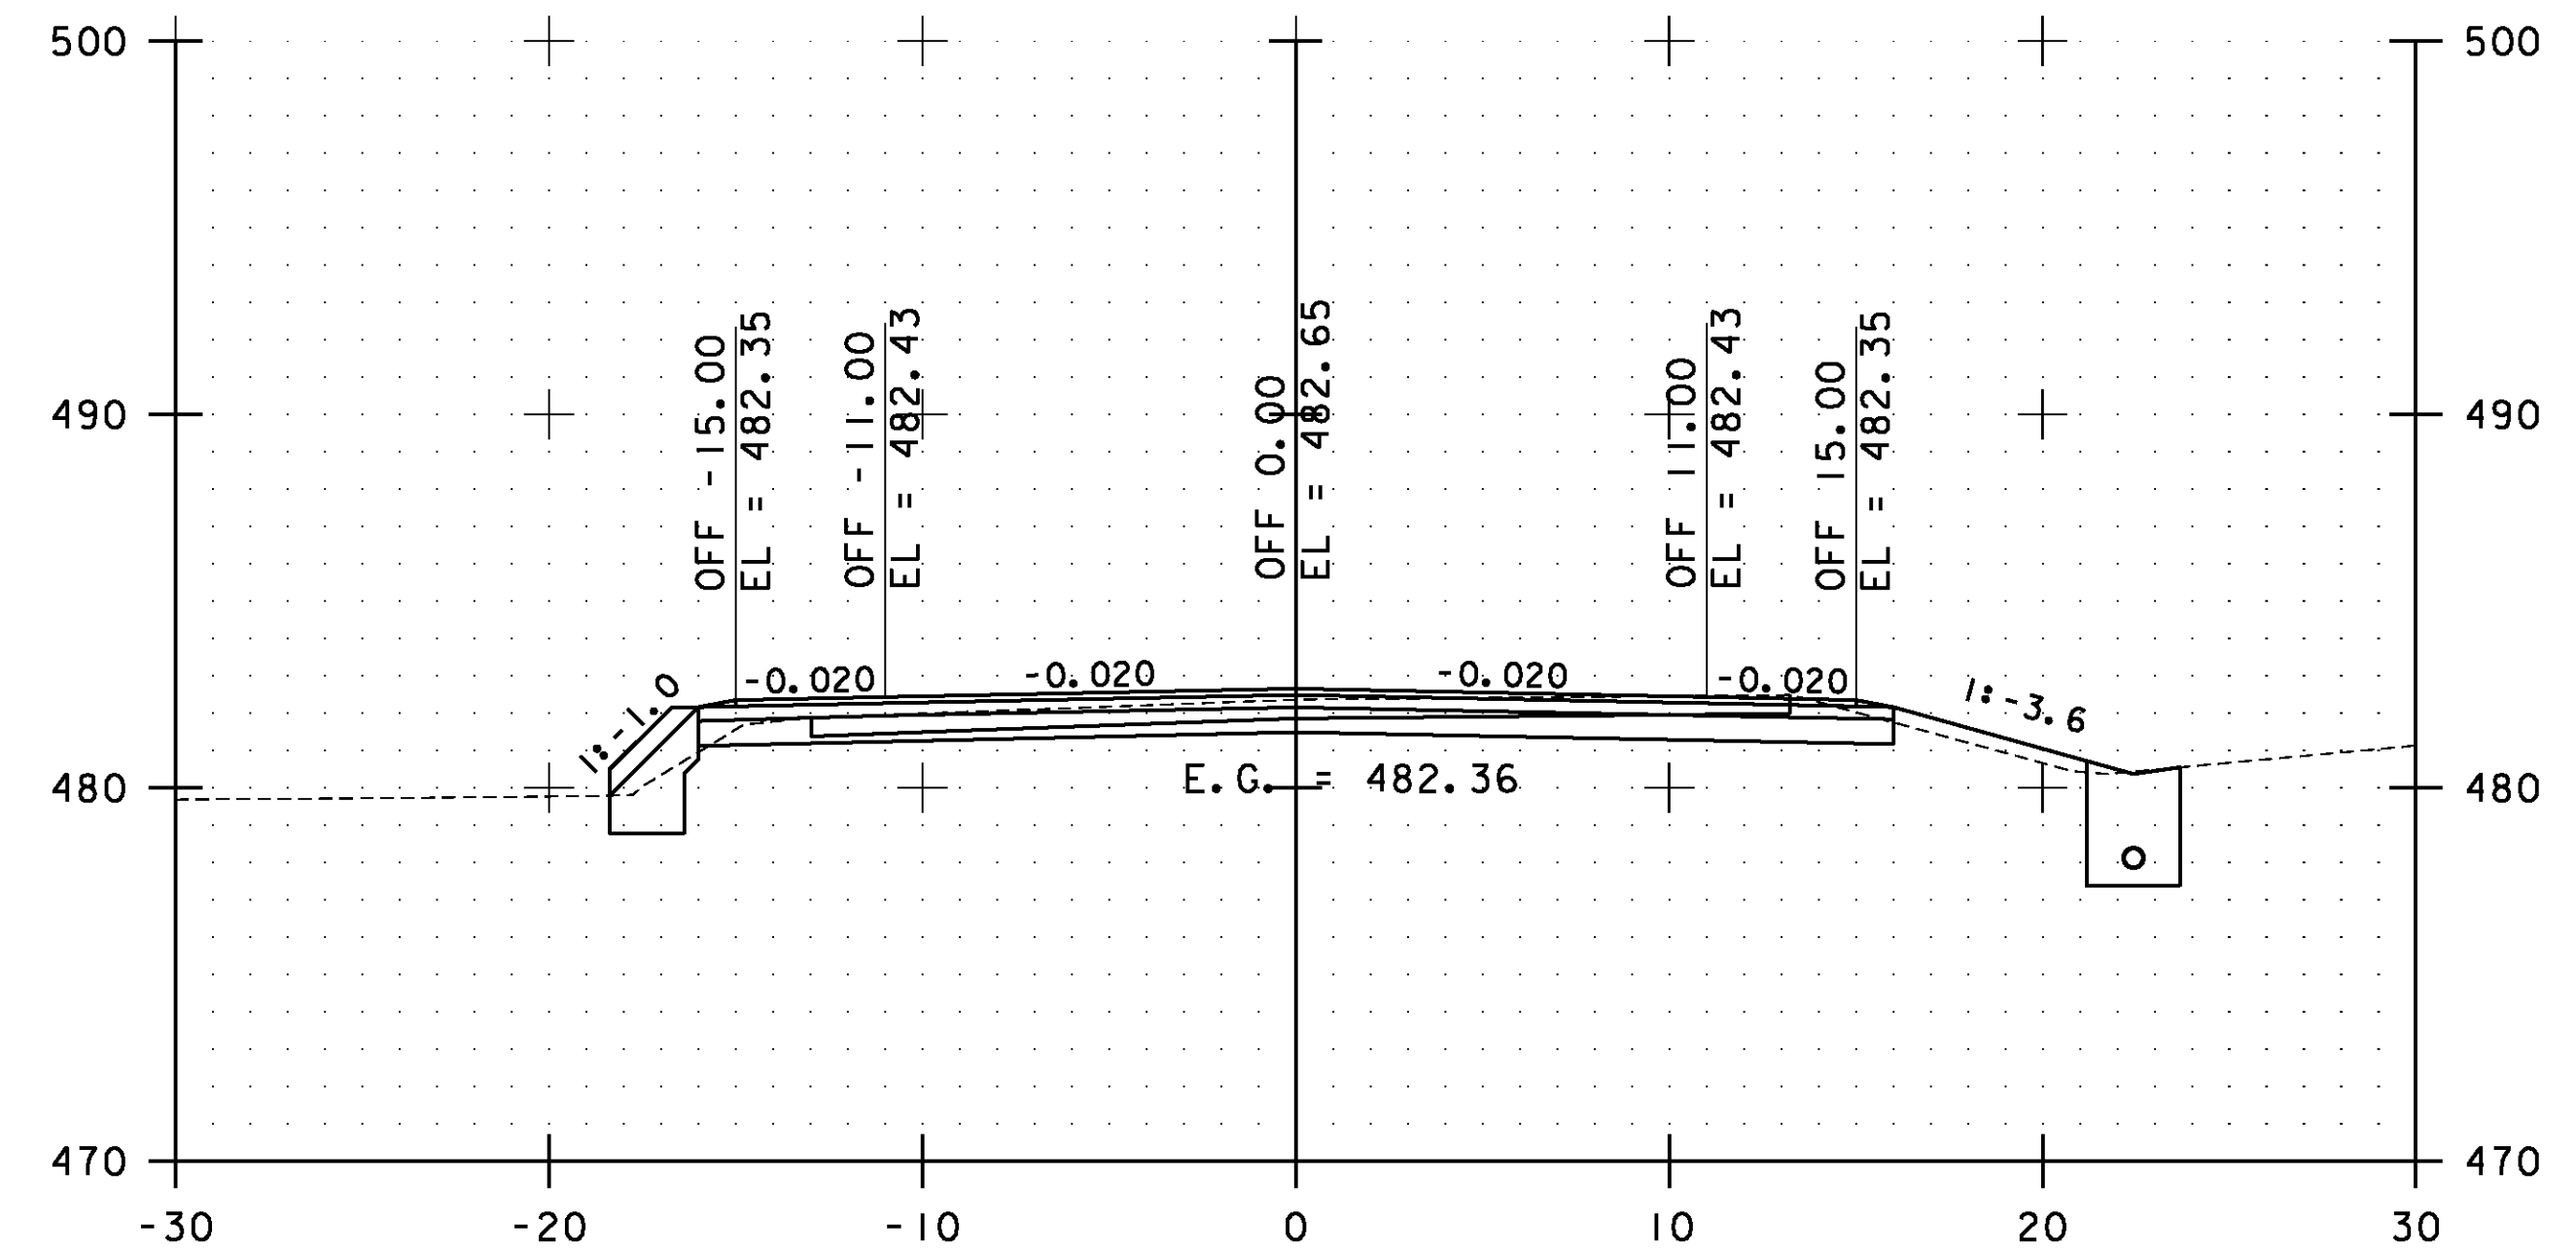

92+00.00

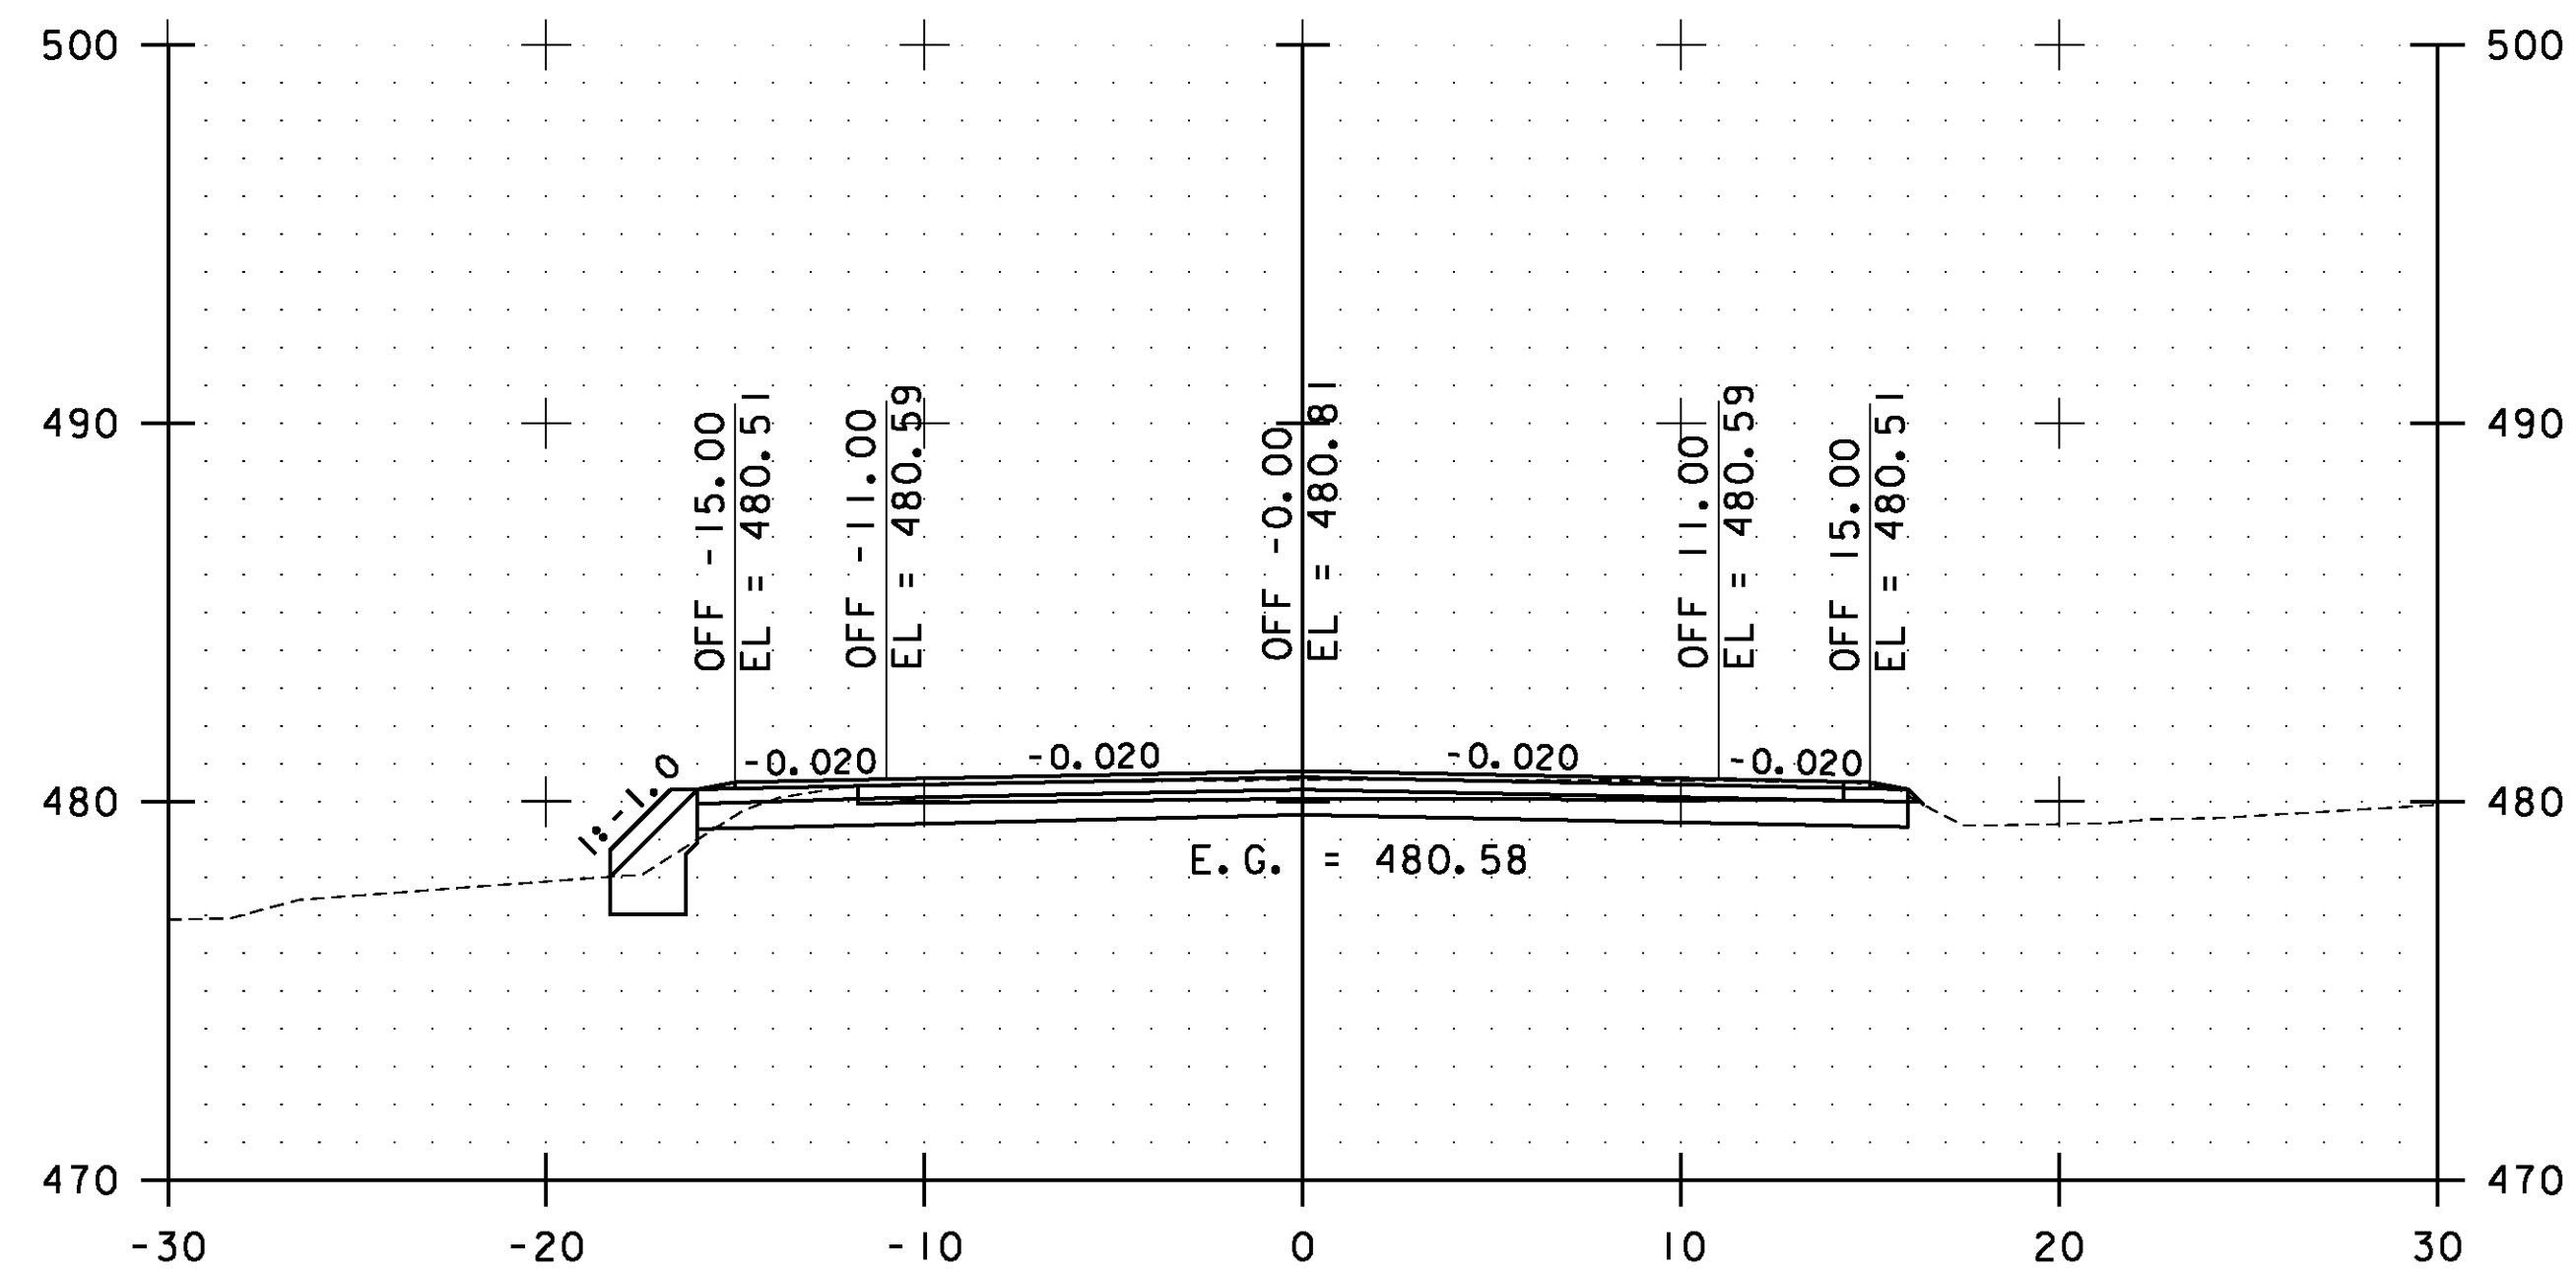


90+50.00

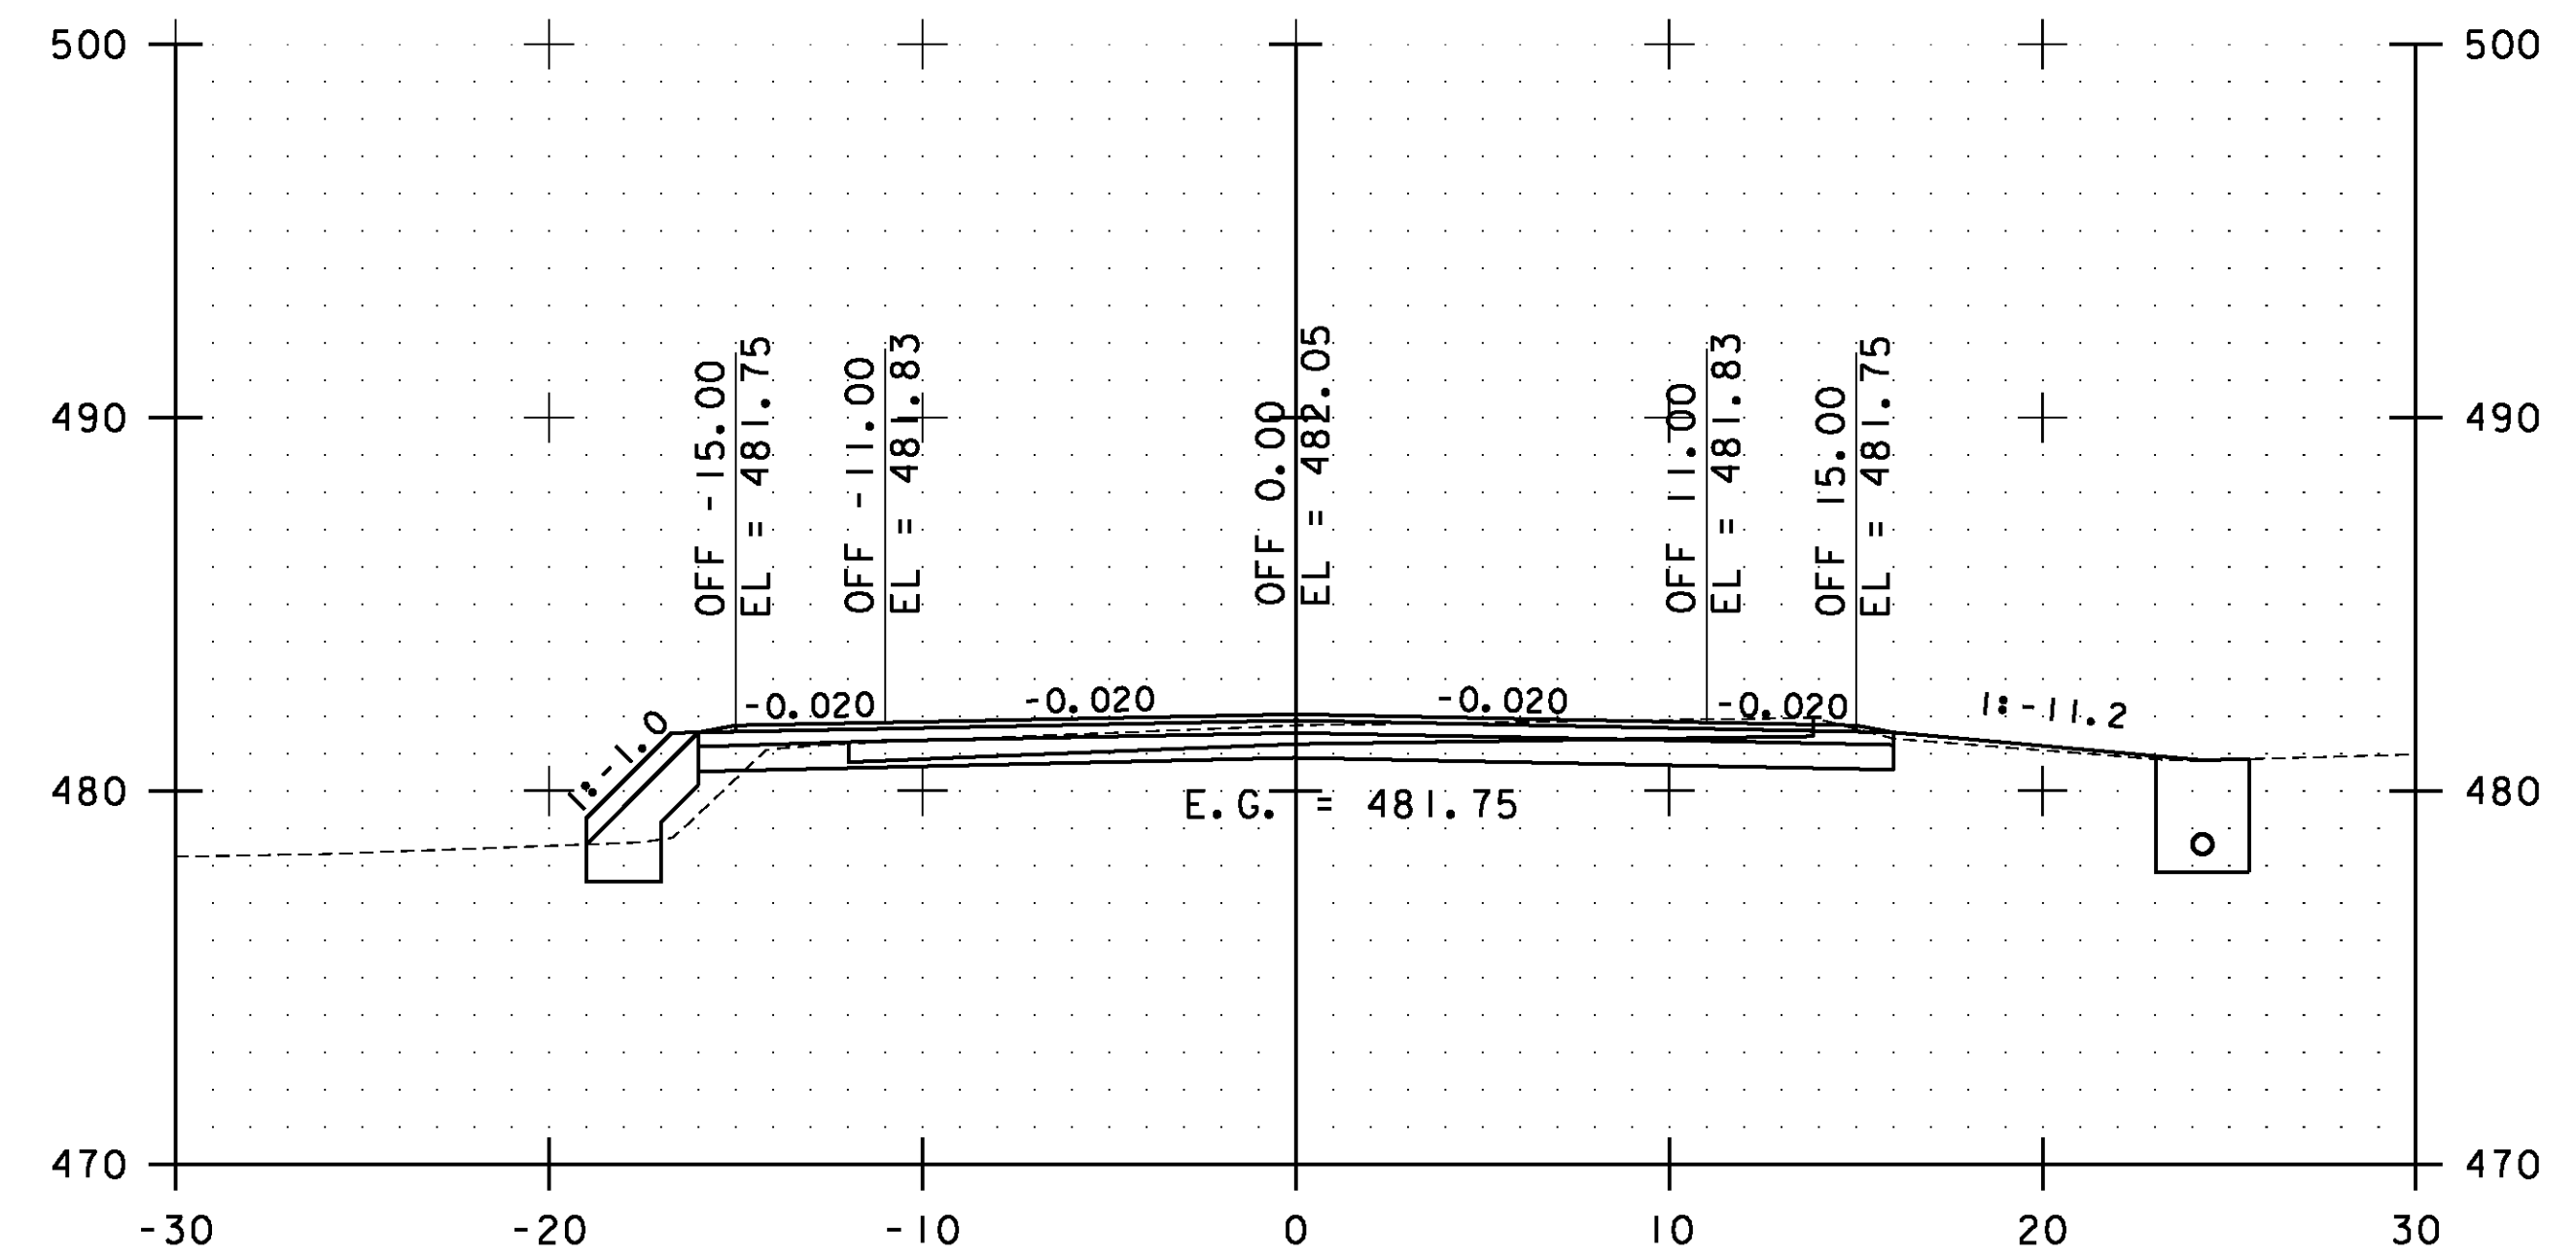

91+50.00

STA. 90+50.00 TO STA. 92+00.00

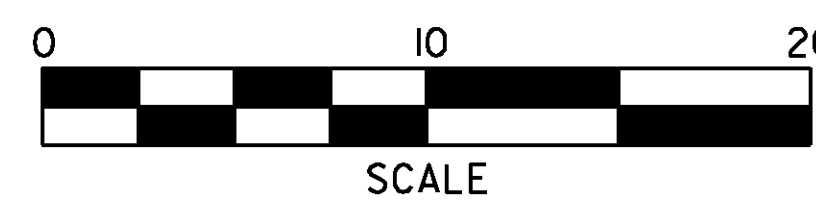

**ESSEX  
CROSS  
SECTIONS  
SHEET #40**

PROJECT NAME: ESSEX-WESTFORD  
PROJECT NUMBER: STP 2912(I)

FILE NAME: p10c226.dgn  
PROJECT LEADER: JLL  
DESIGNED BY: STANTEC  
IPARM FILE: p10c226xs040.i

PLOT DATE: 2/20/2013  
DRAWN BY: STANTEC  
CHECKED BY: STANTEC  
SHEET 131 OF 239