




93+00.00

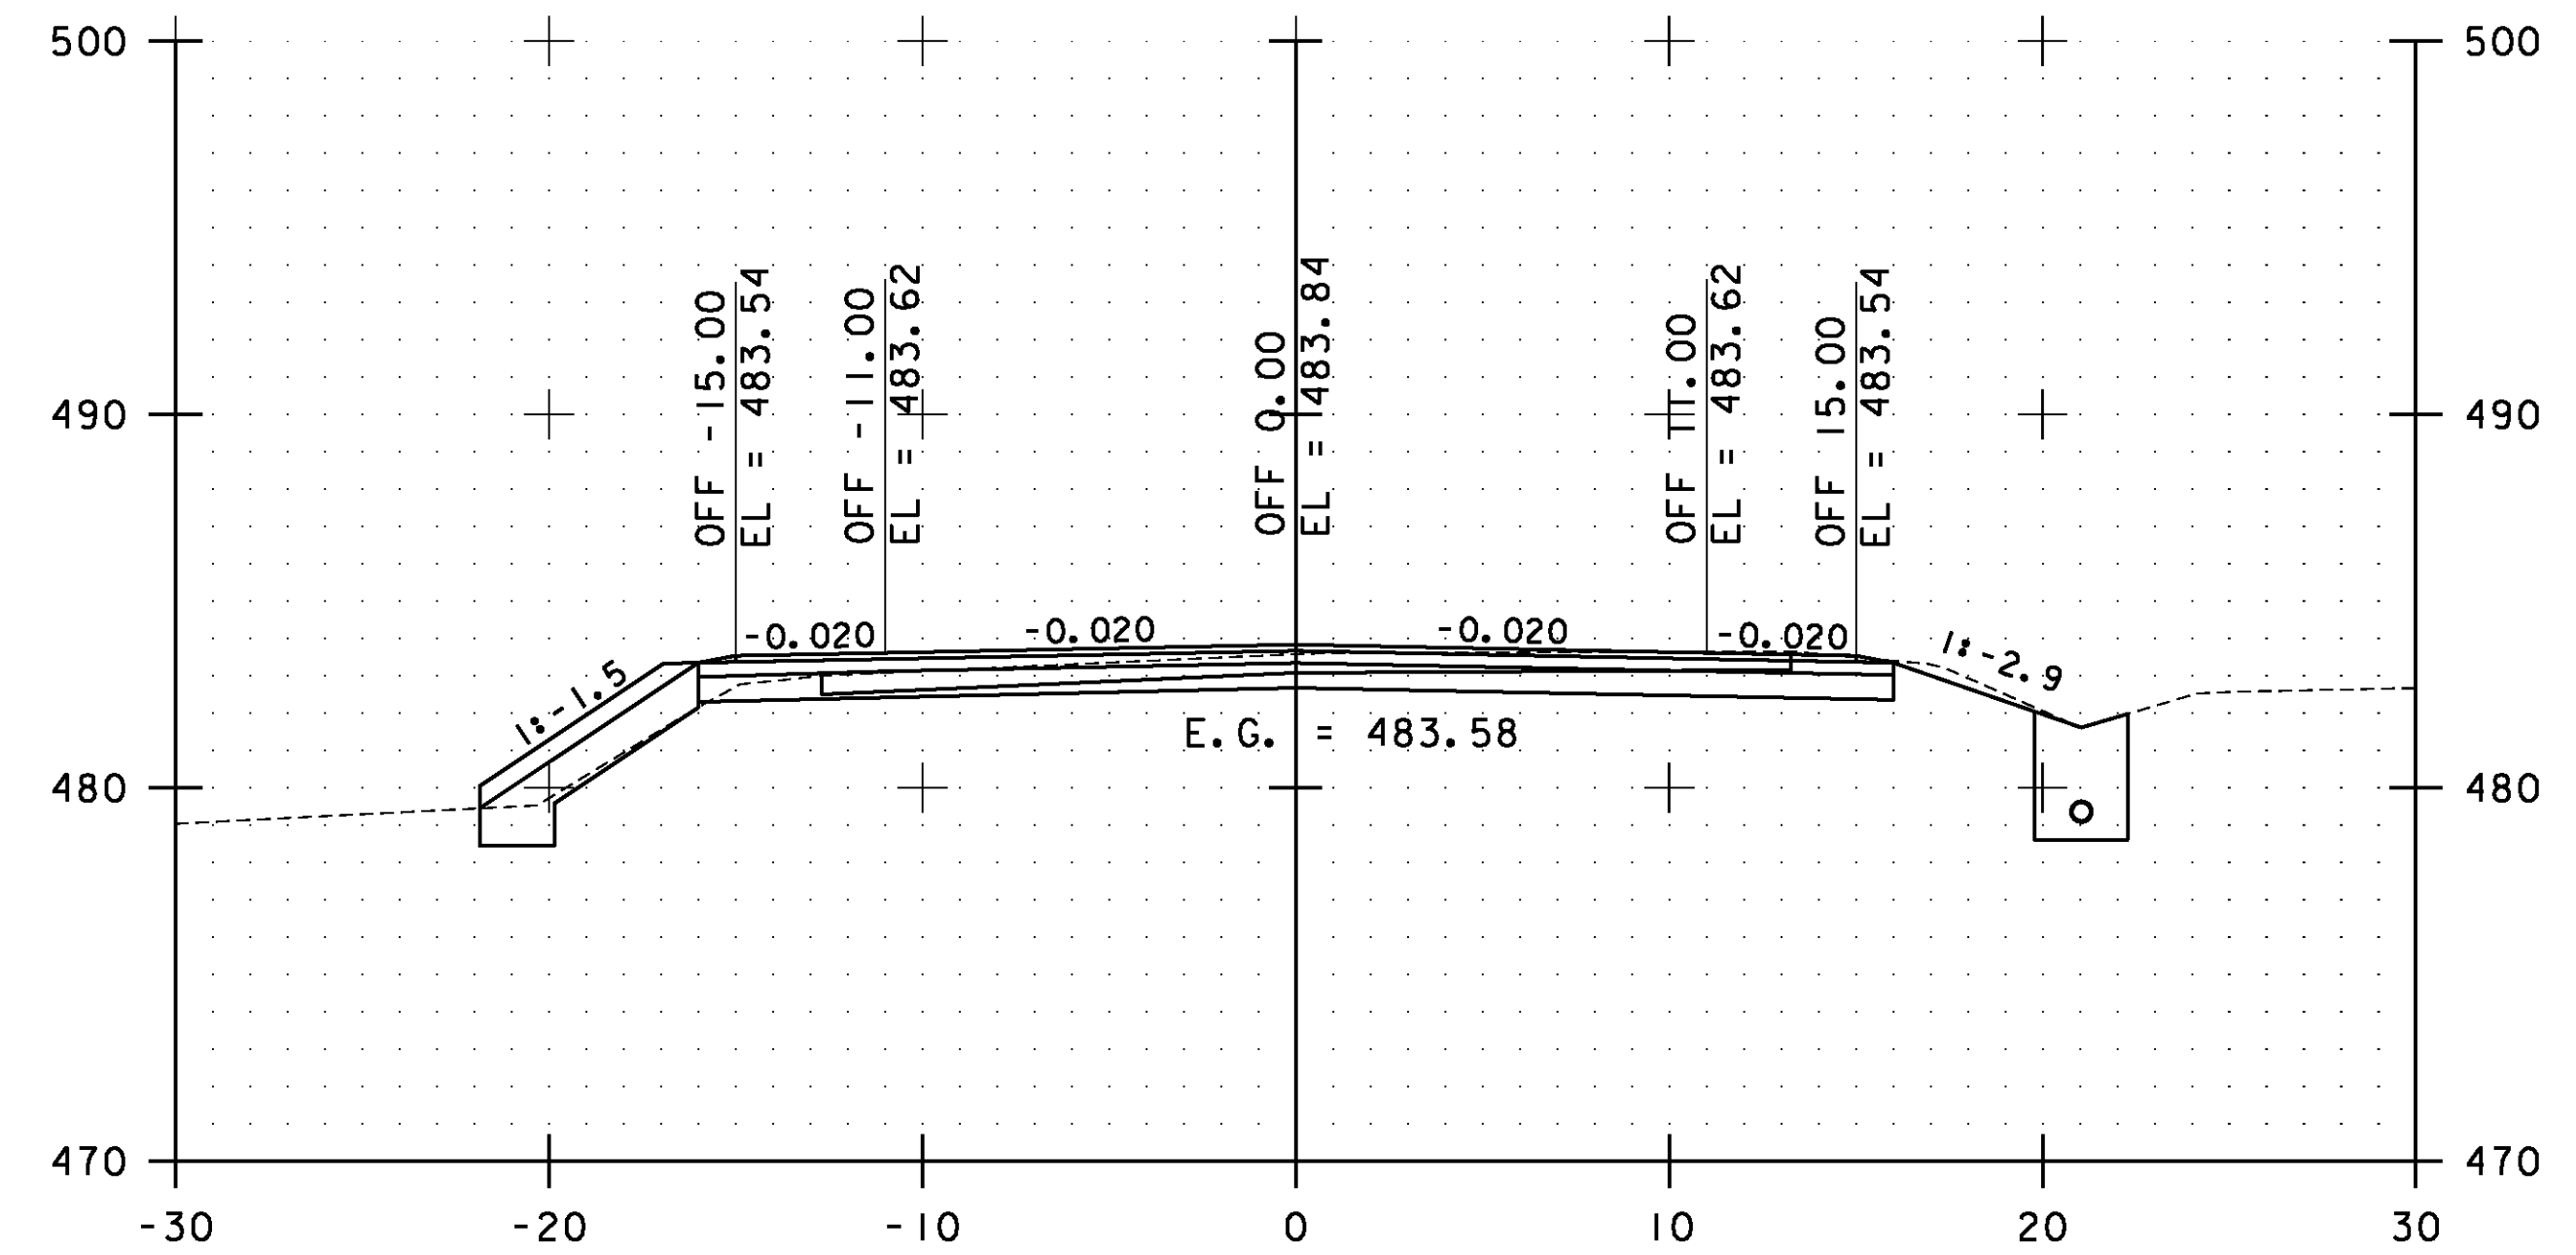

94+00.00

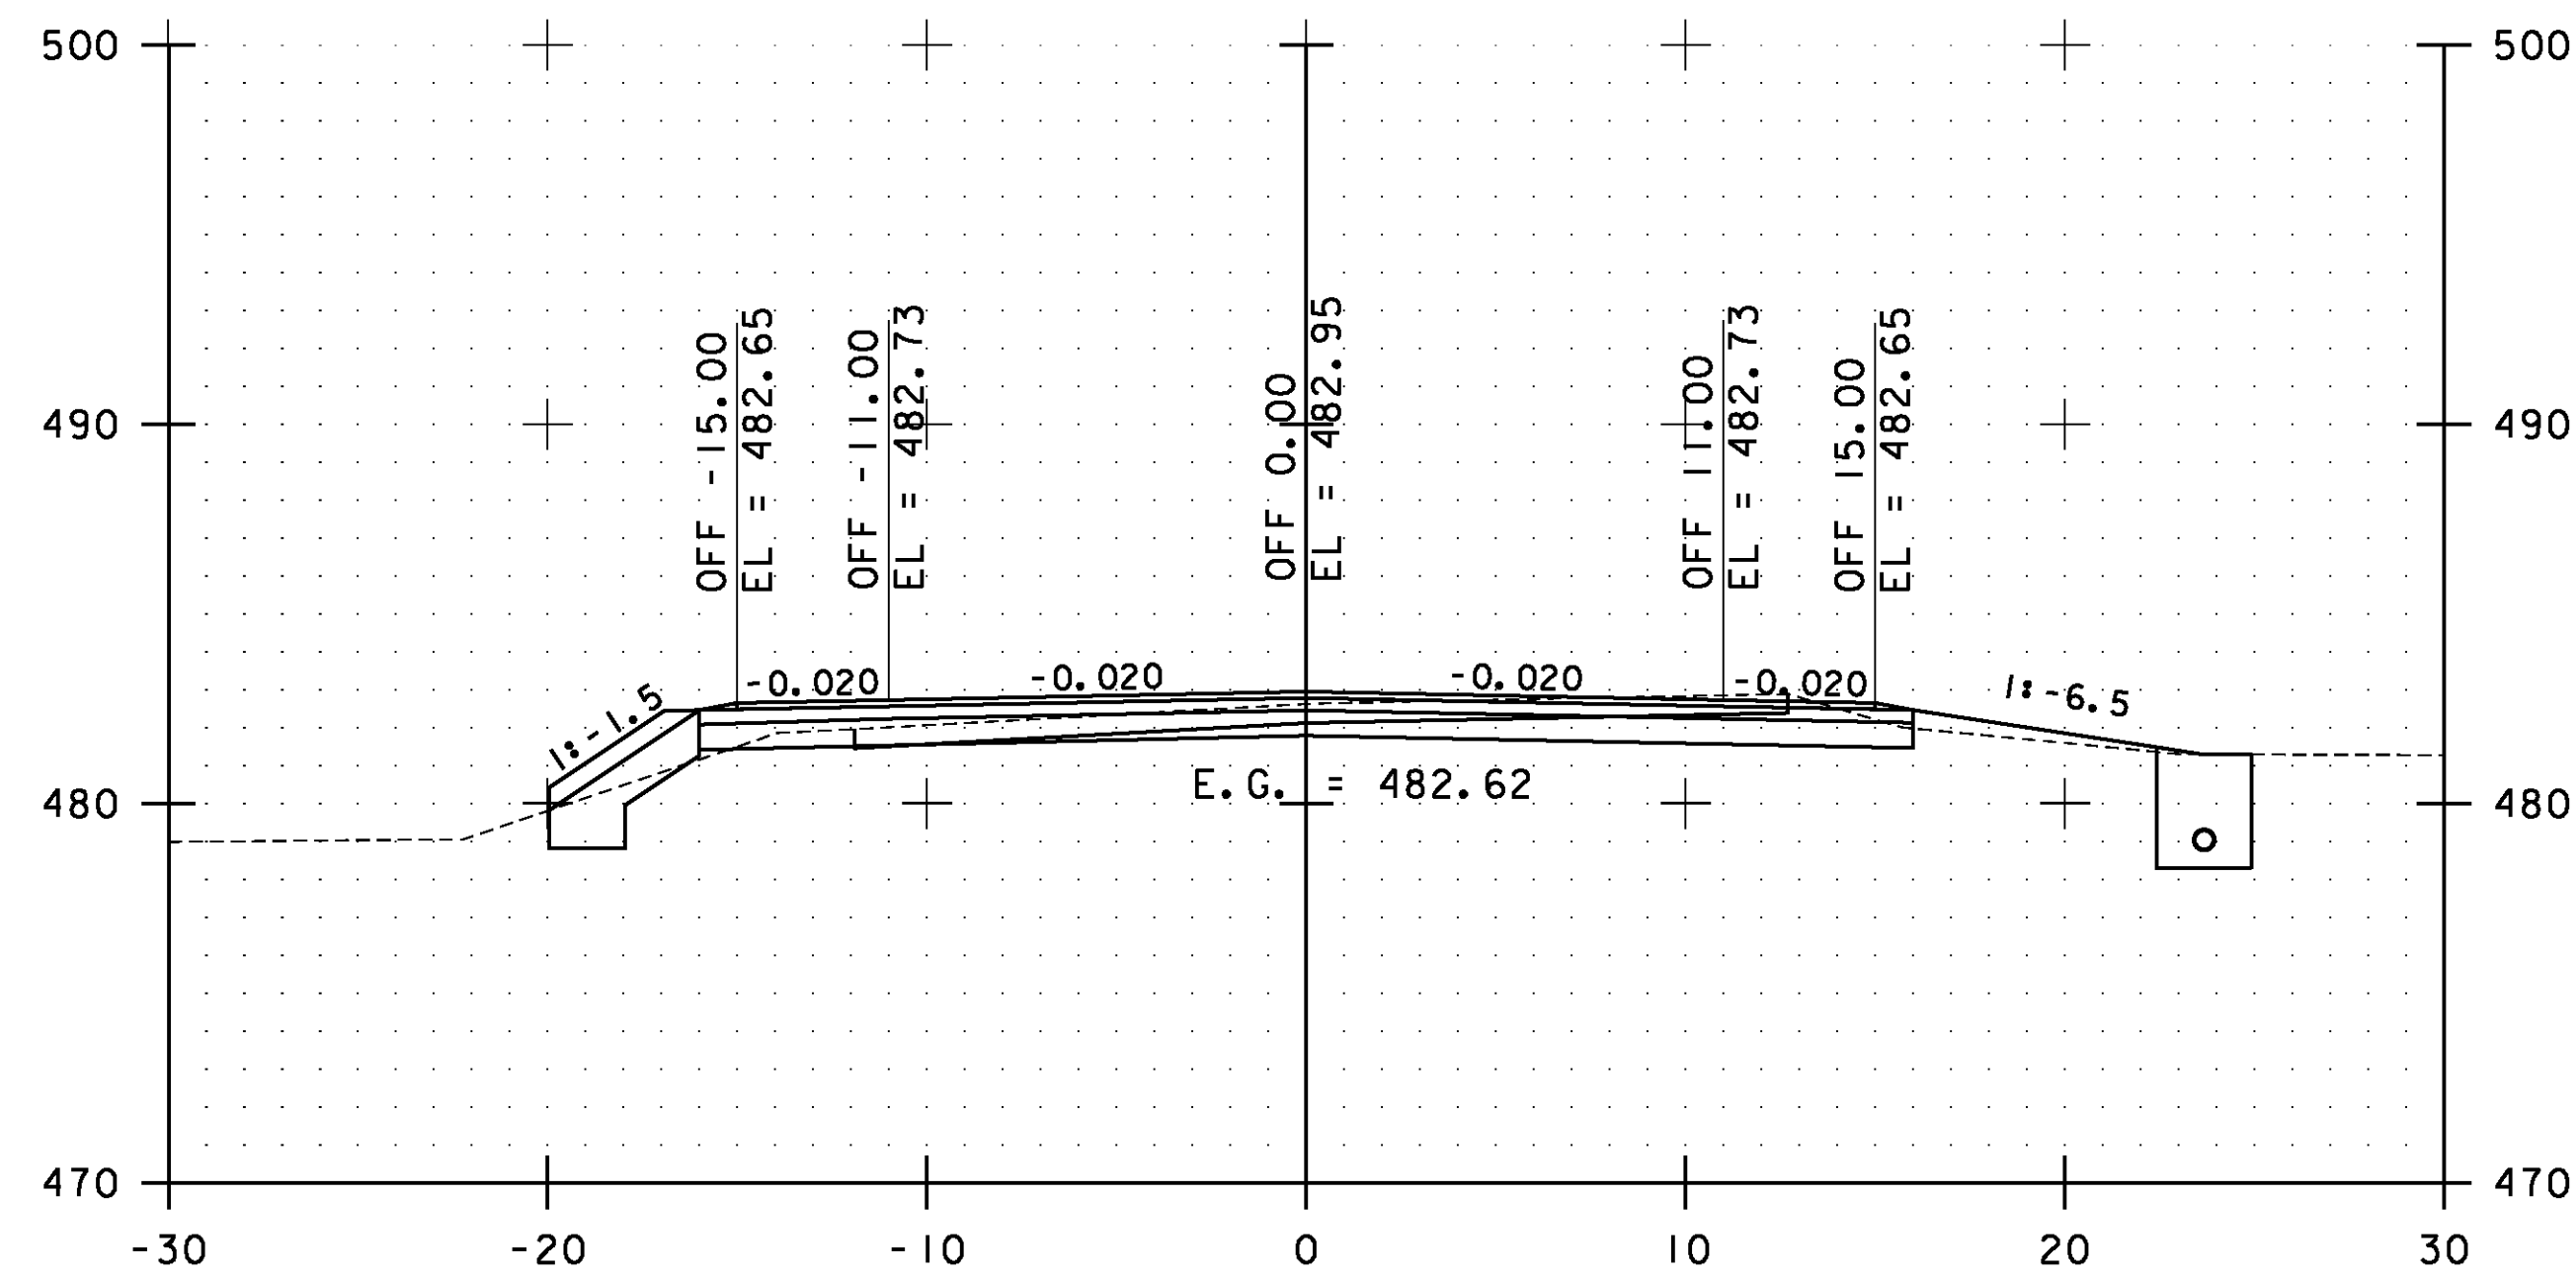


92+50.00

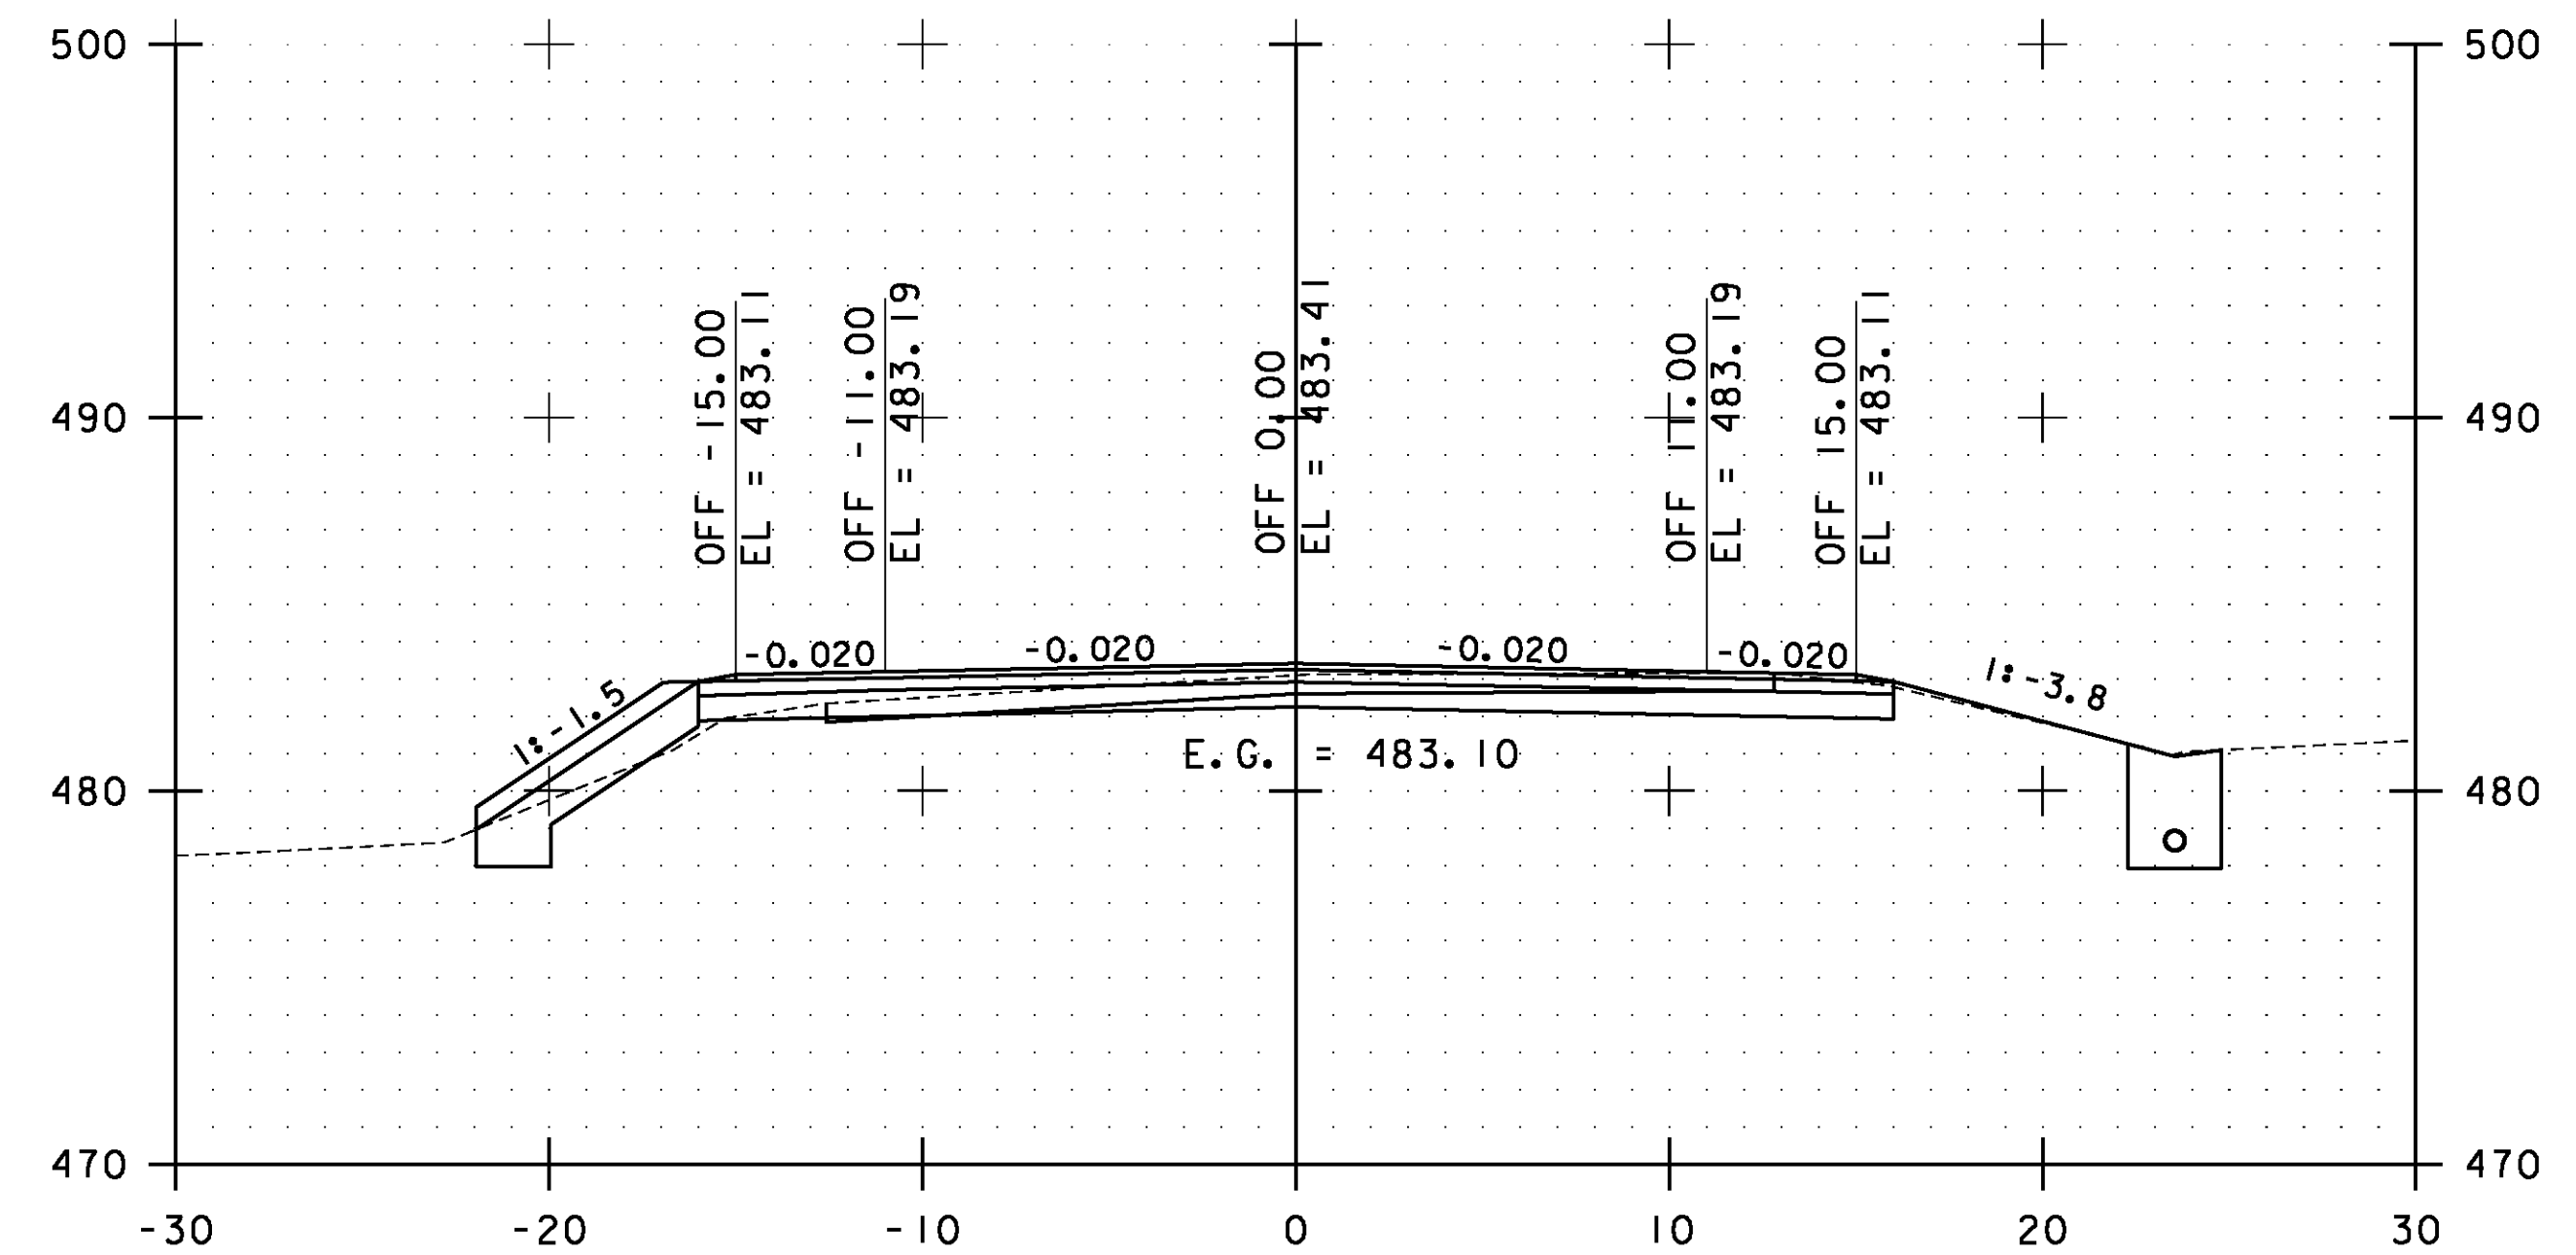

93+50.00

STA. 92+50.00 TO STA. 94+00.00

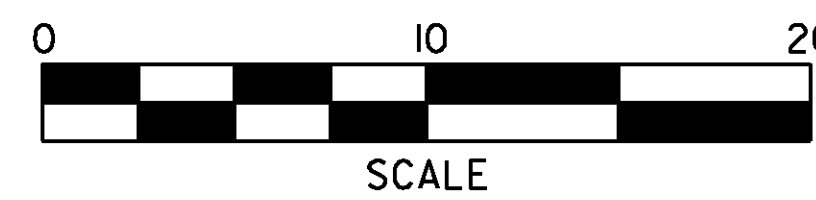

**ESSEX
CROSS
SECTIONS
SHEET #41**

PROJECT NAME: ESSEX-WESTFORD
PROJECT NUMBER: STP 2912(I)

FILE NAME: p10c226.dgn
PROJECT LEADER: JLL
DESIGNED BY: STANTEC
IPARM FILE: p10c226xs041.i

PLOT DATE: 2/20/2013
DRAWN BY: STANTEC
CHECKED BY: STANTEC
SHEET 132 OF 239