


STA. 94+50.00 TO STA. 96+00.00

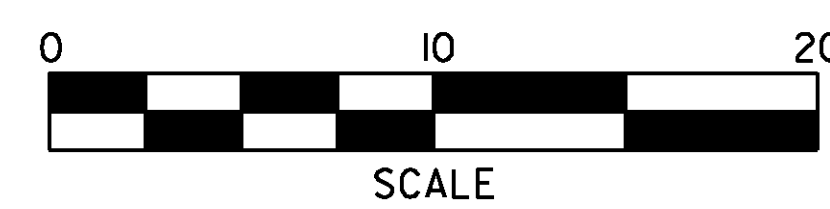

**ESSEX
CROSS
SECTIONS
SHEET #42**

PROJECT NAME: ESSEX-WESTFORD	PLOT DATE: 2/20/2013
PROJECT NUMBER: STP 2912(I)	DRAWN BY: STANTEC
FILE NAME: p10c226.dgn	CHECKED BY: STANTEC
DESIGNED BY: STANTEC	SHEET 133 OF 239
IPARM FILE: p10c226xs042.i	