




99+00.00

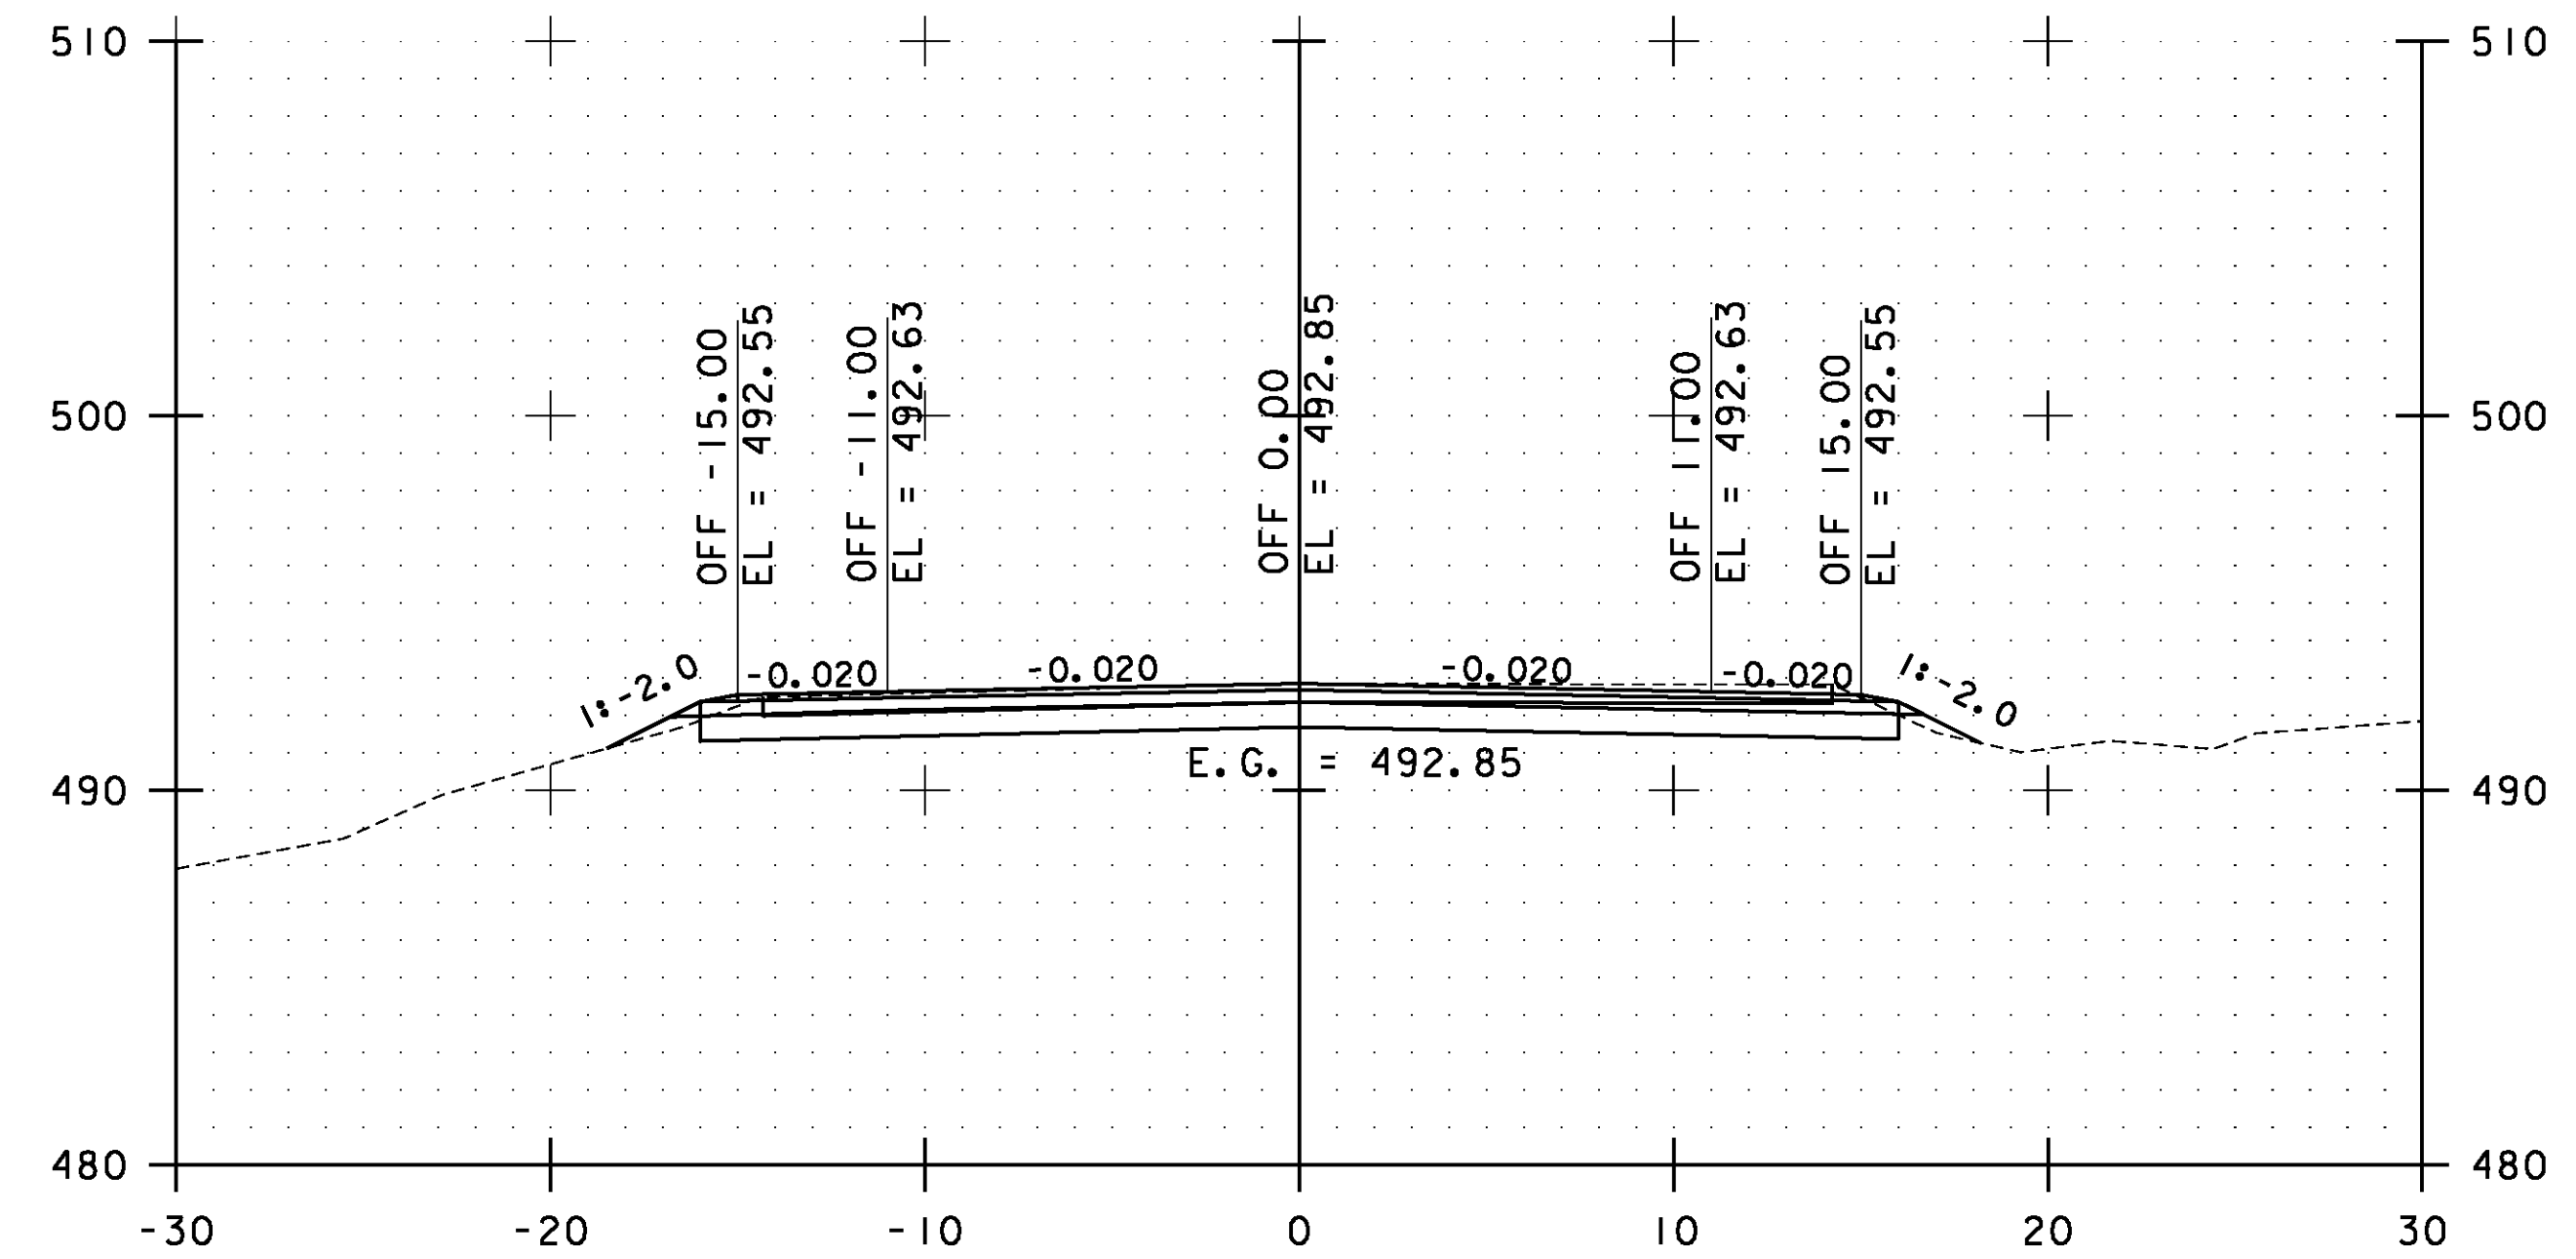

100+00.00

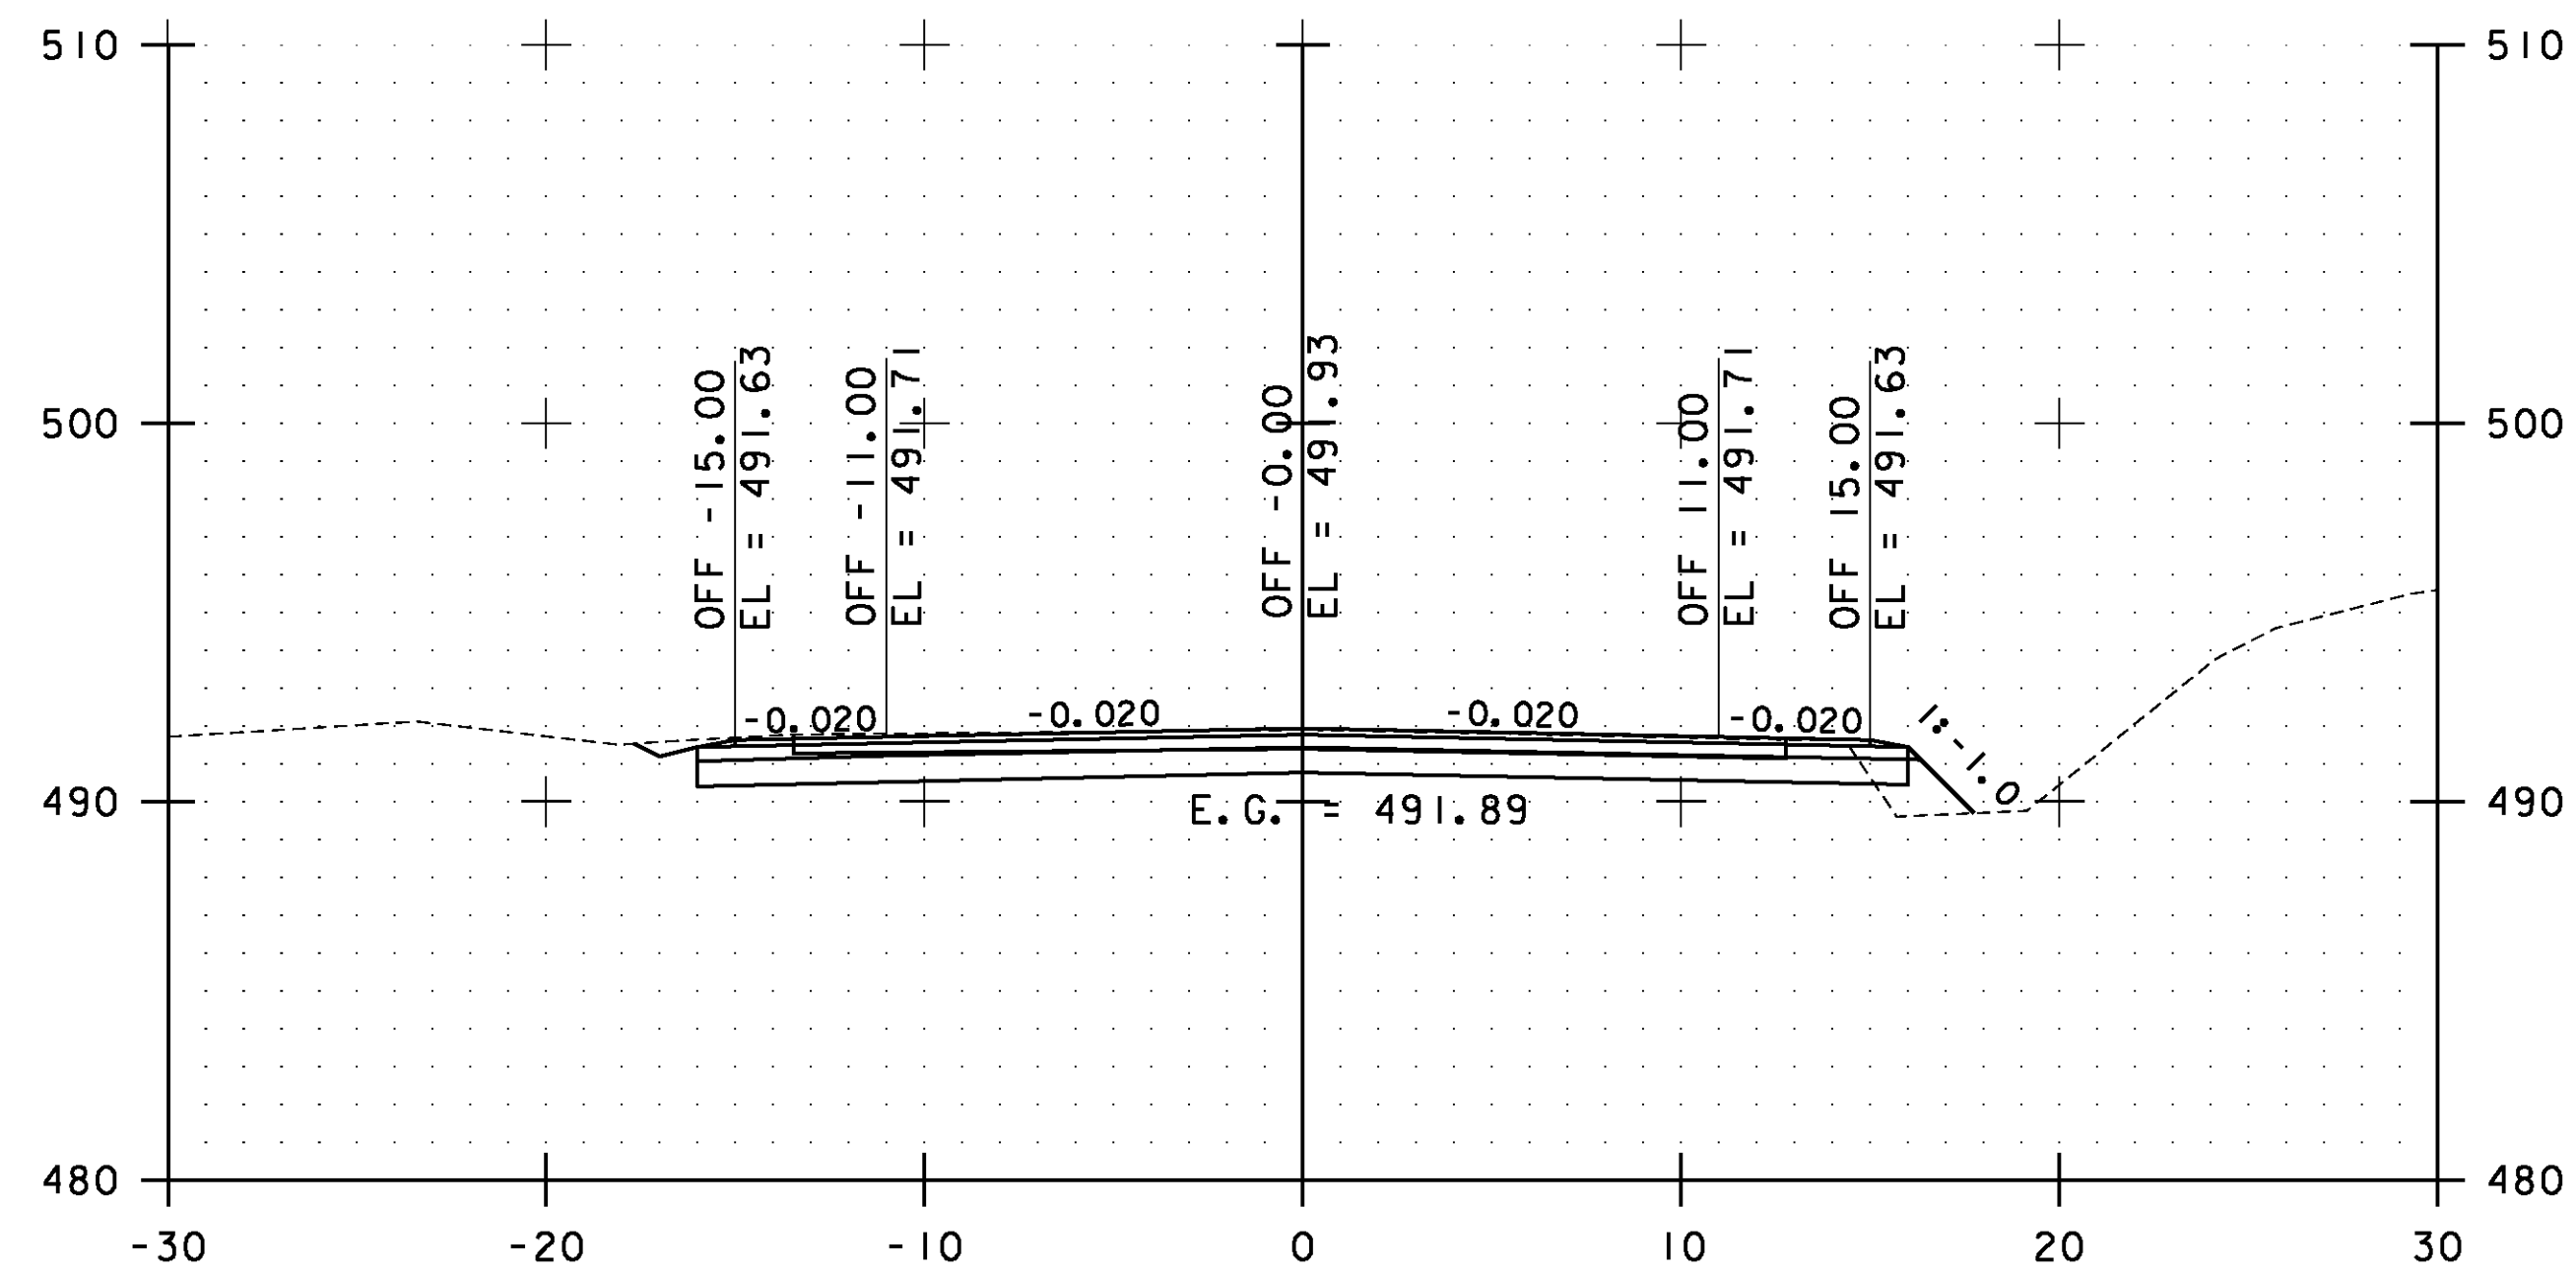


98+50.00

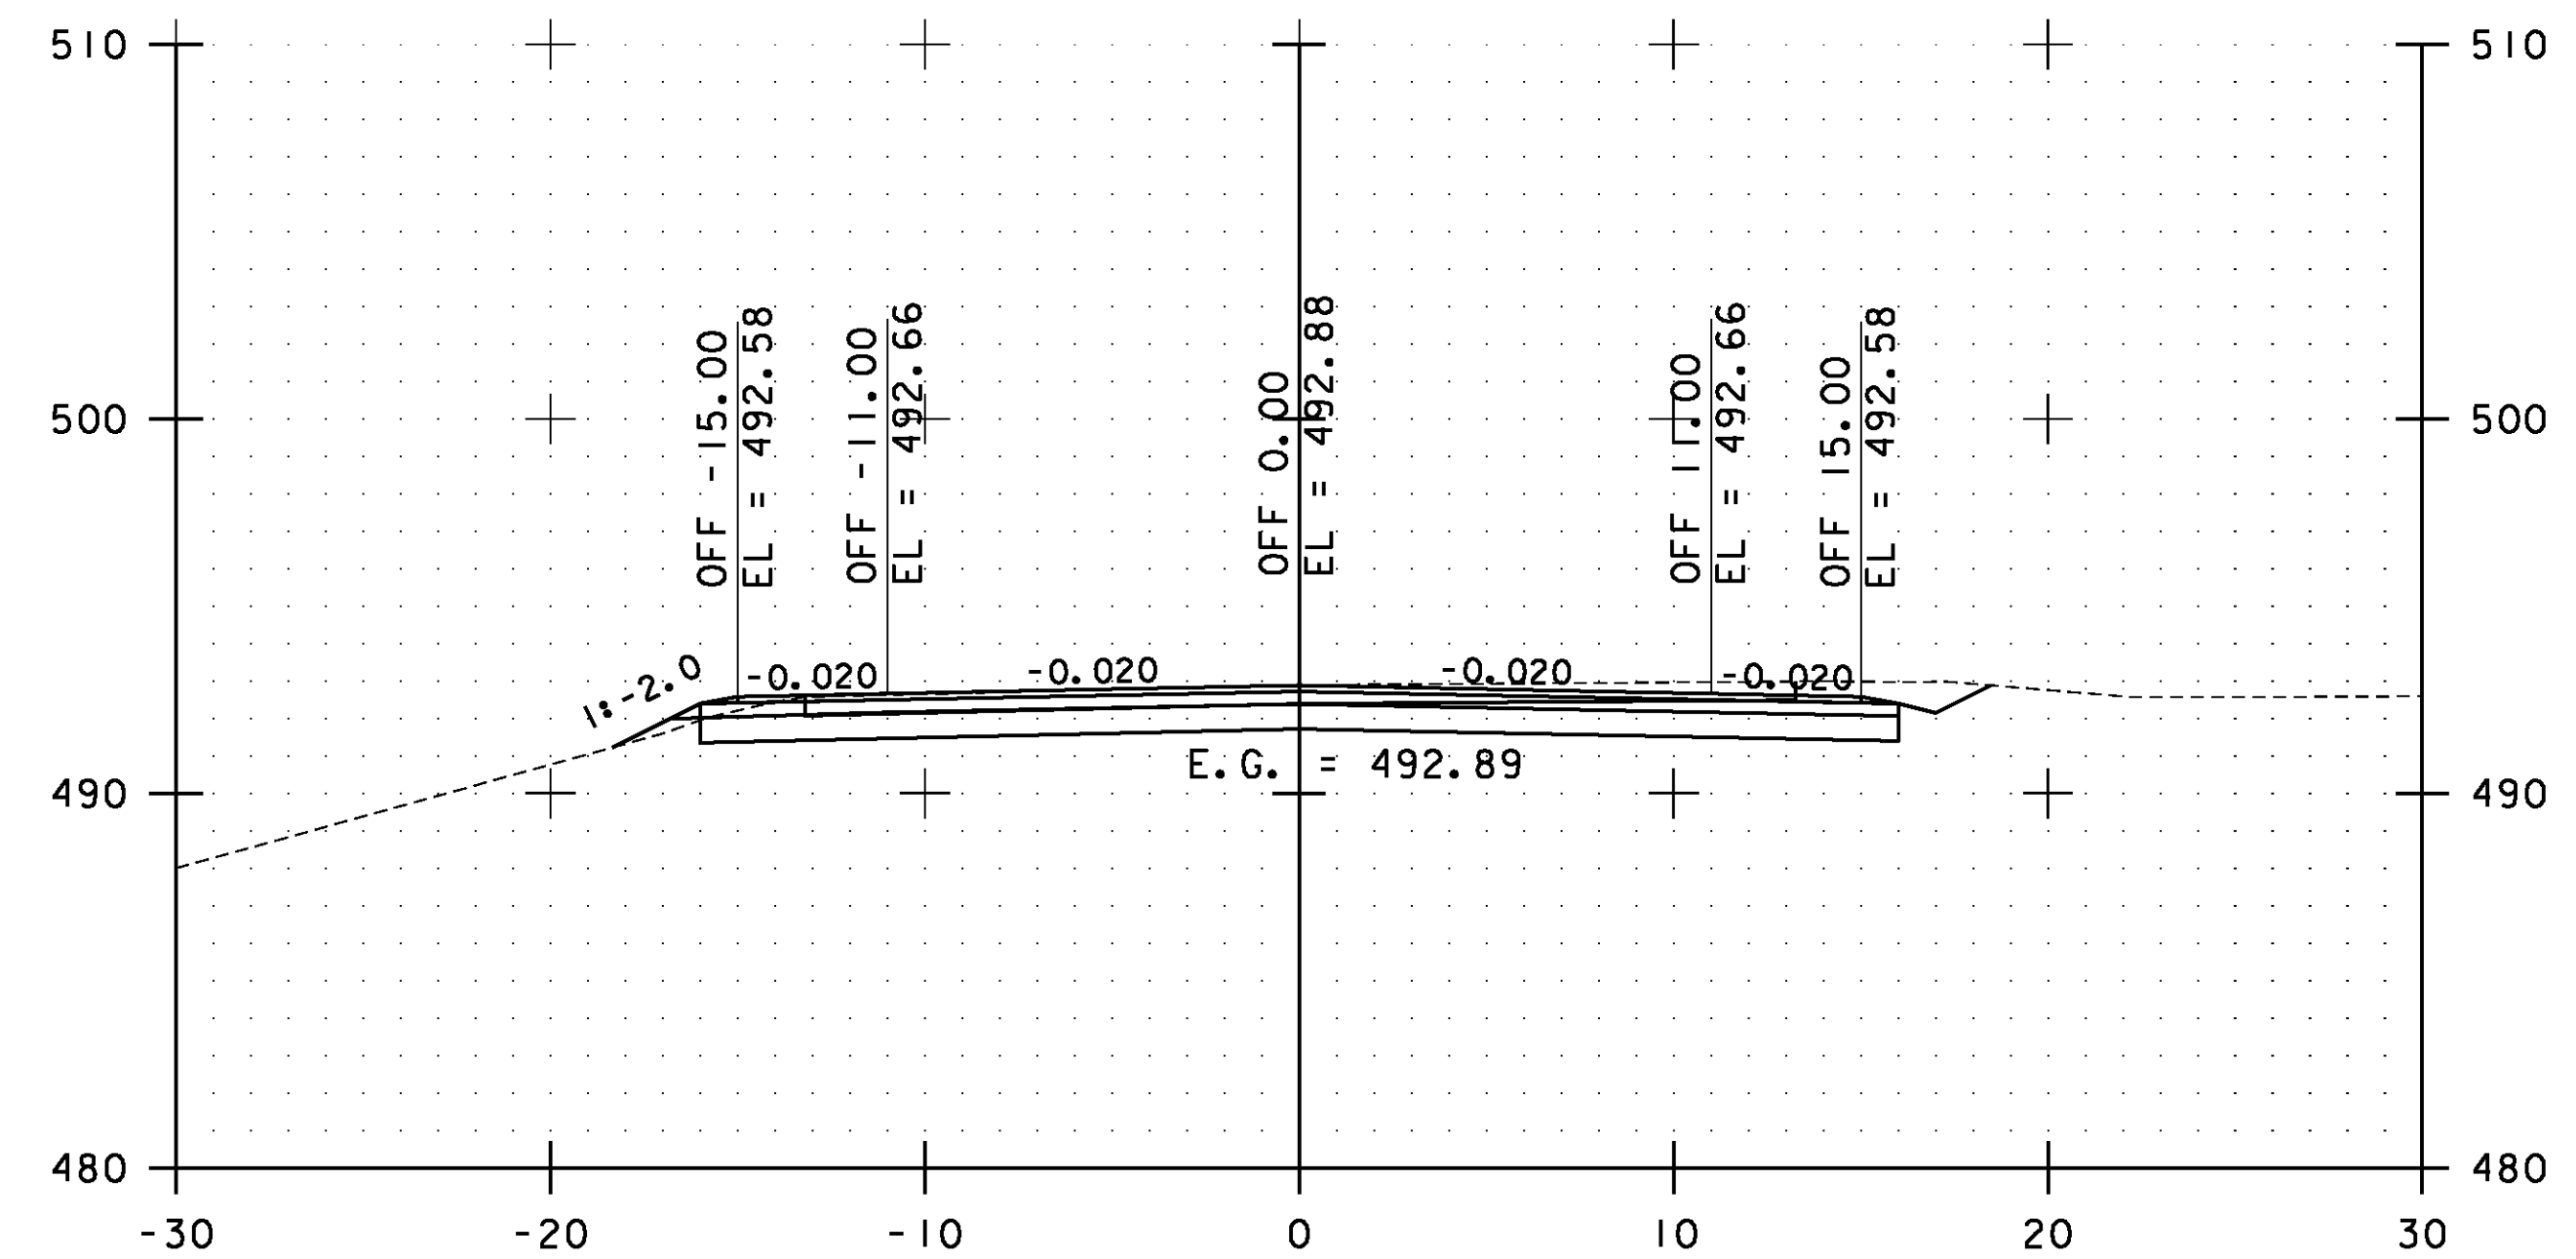

99+50.00

STA. 98+50.00 TO STA. 100+00.00

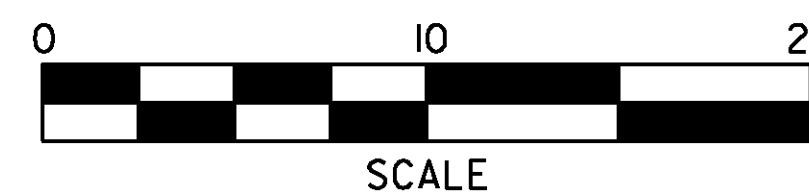

**ESSEX
CROSS
SECTIONS
SHEET #44**

PROJECT NAME: ESSEX-WESTFORD
PROJECT NUMBER: STP 2912(I)

FILE NAME: p10c226.dgn
PROJECT LEADER: JLL
DESIGNED BY: STANTEC
IPARM FILE: p10c226xs044.i

PLOT DATE: 2/20/2013
DRAWN BY: STANTEC
CHECKED BY: STANTEC
SHEET 135 OF 239