




105+00.00

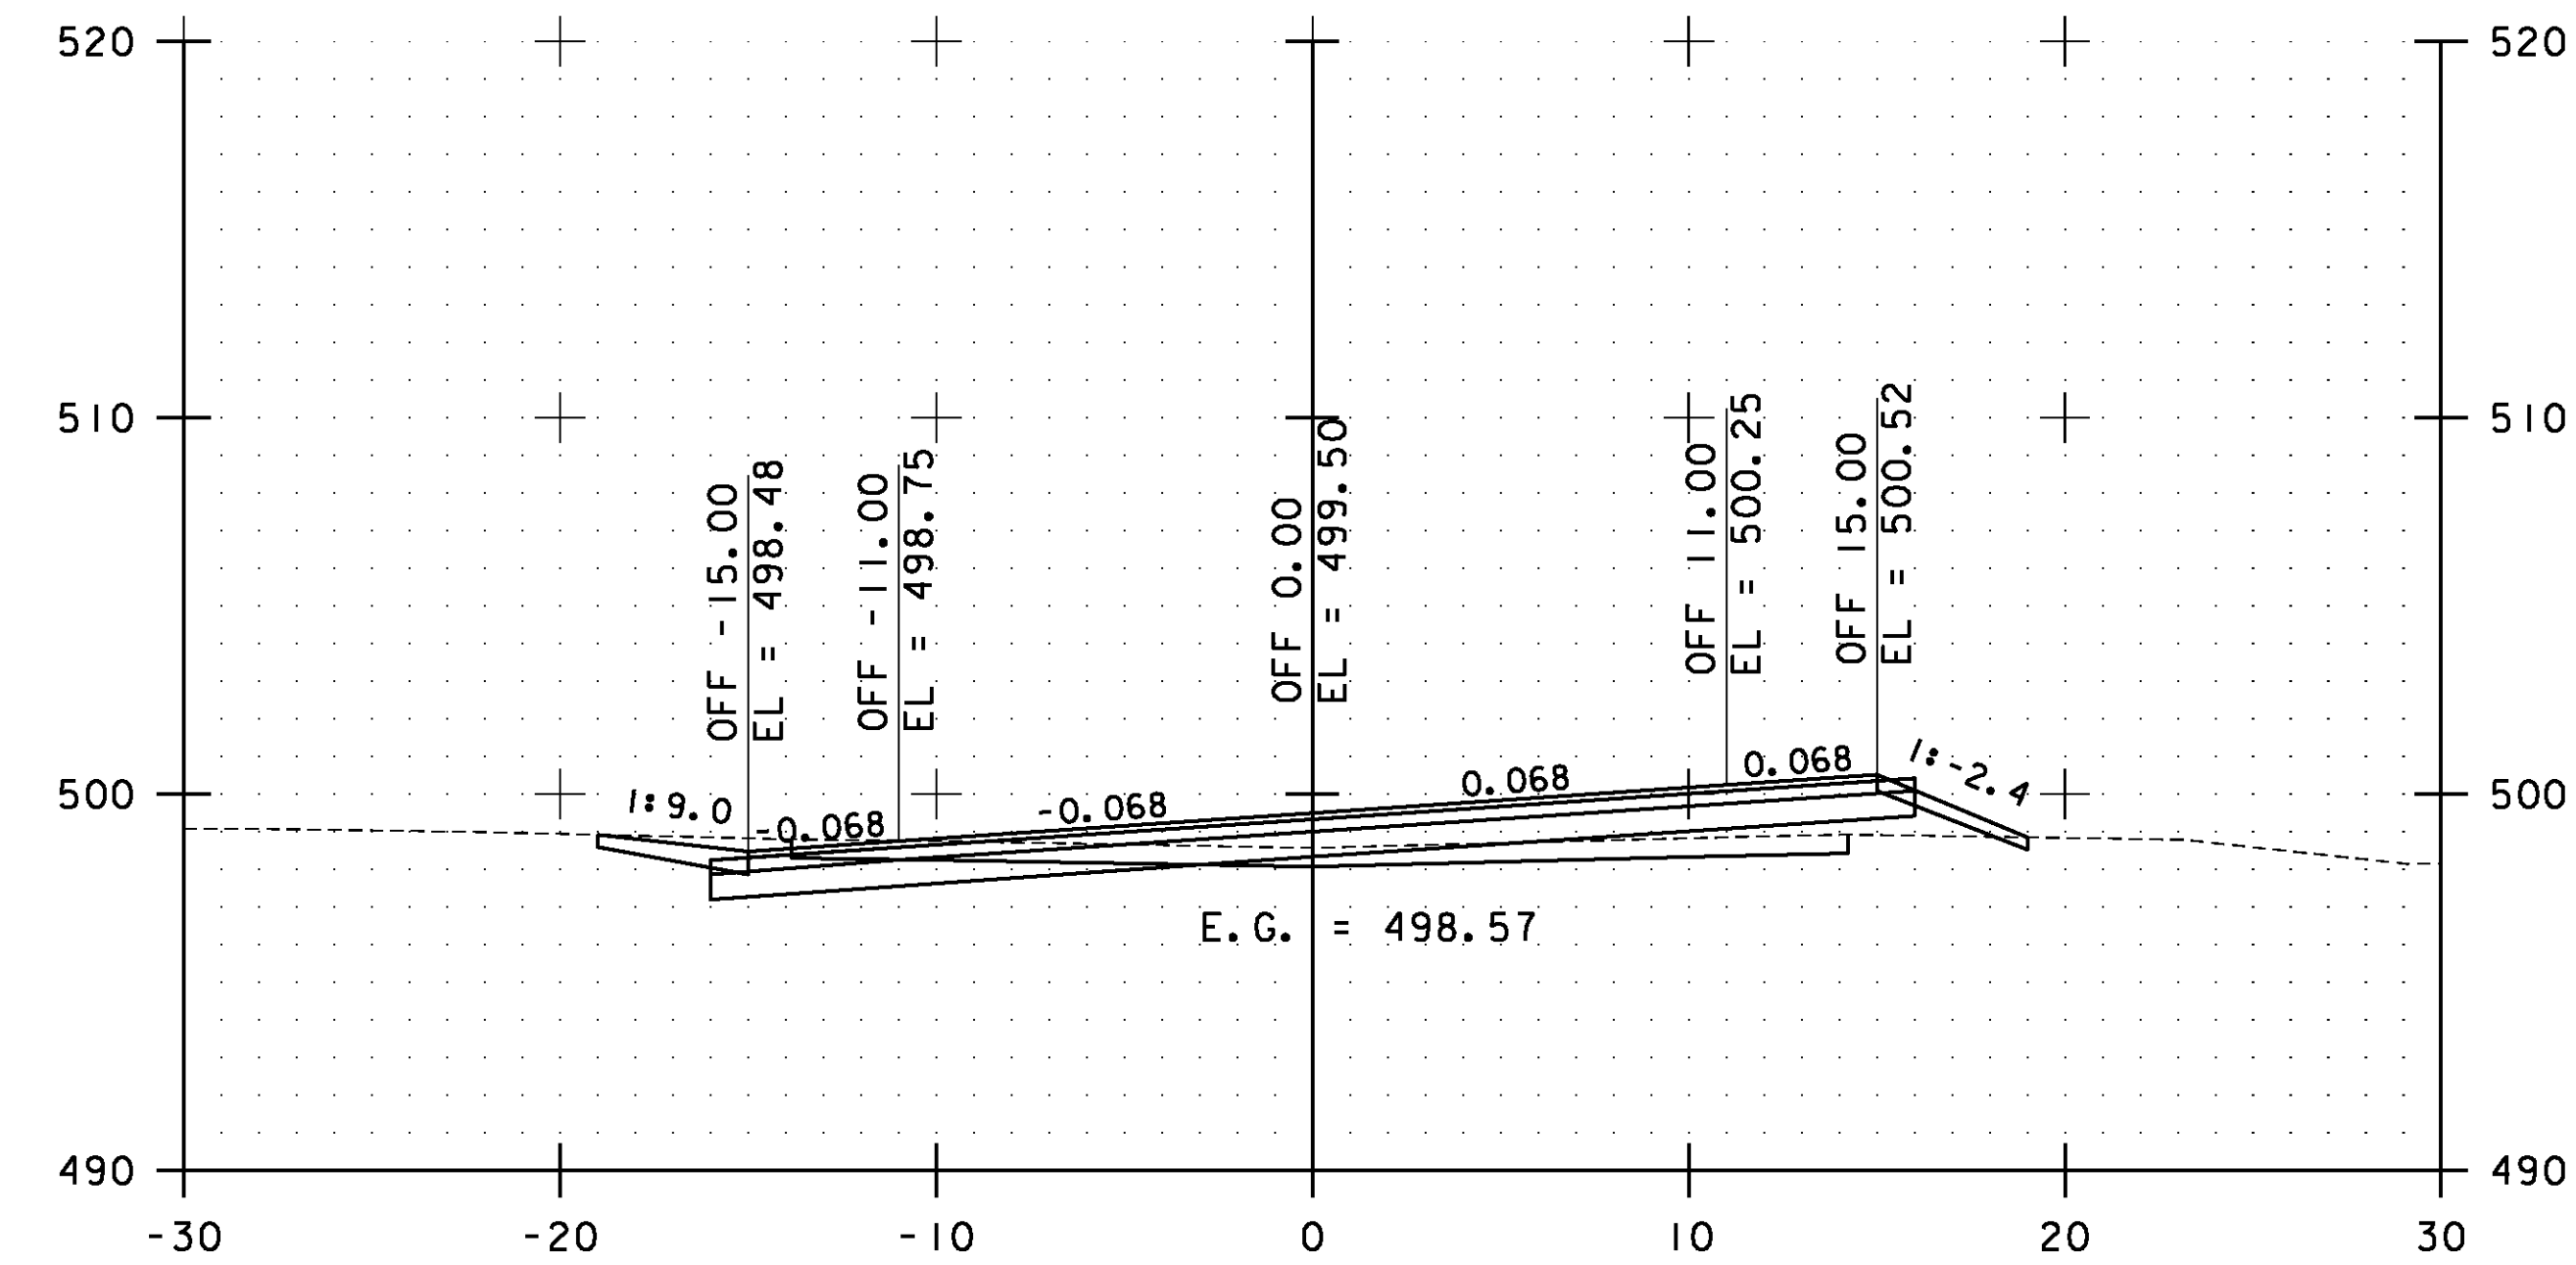

106+00.00

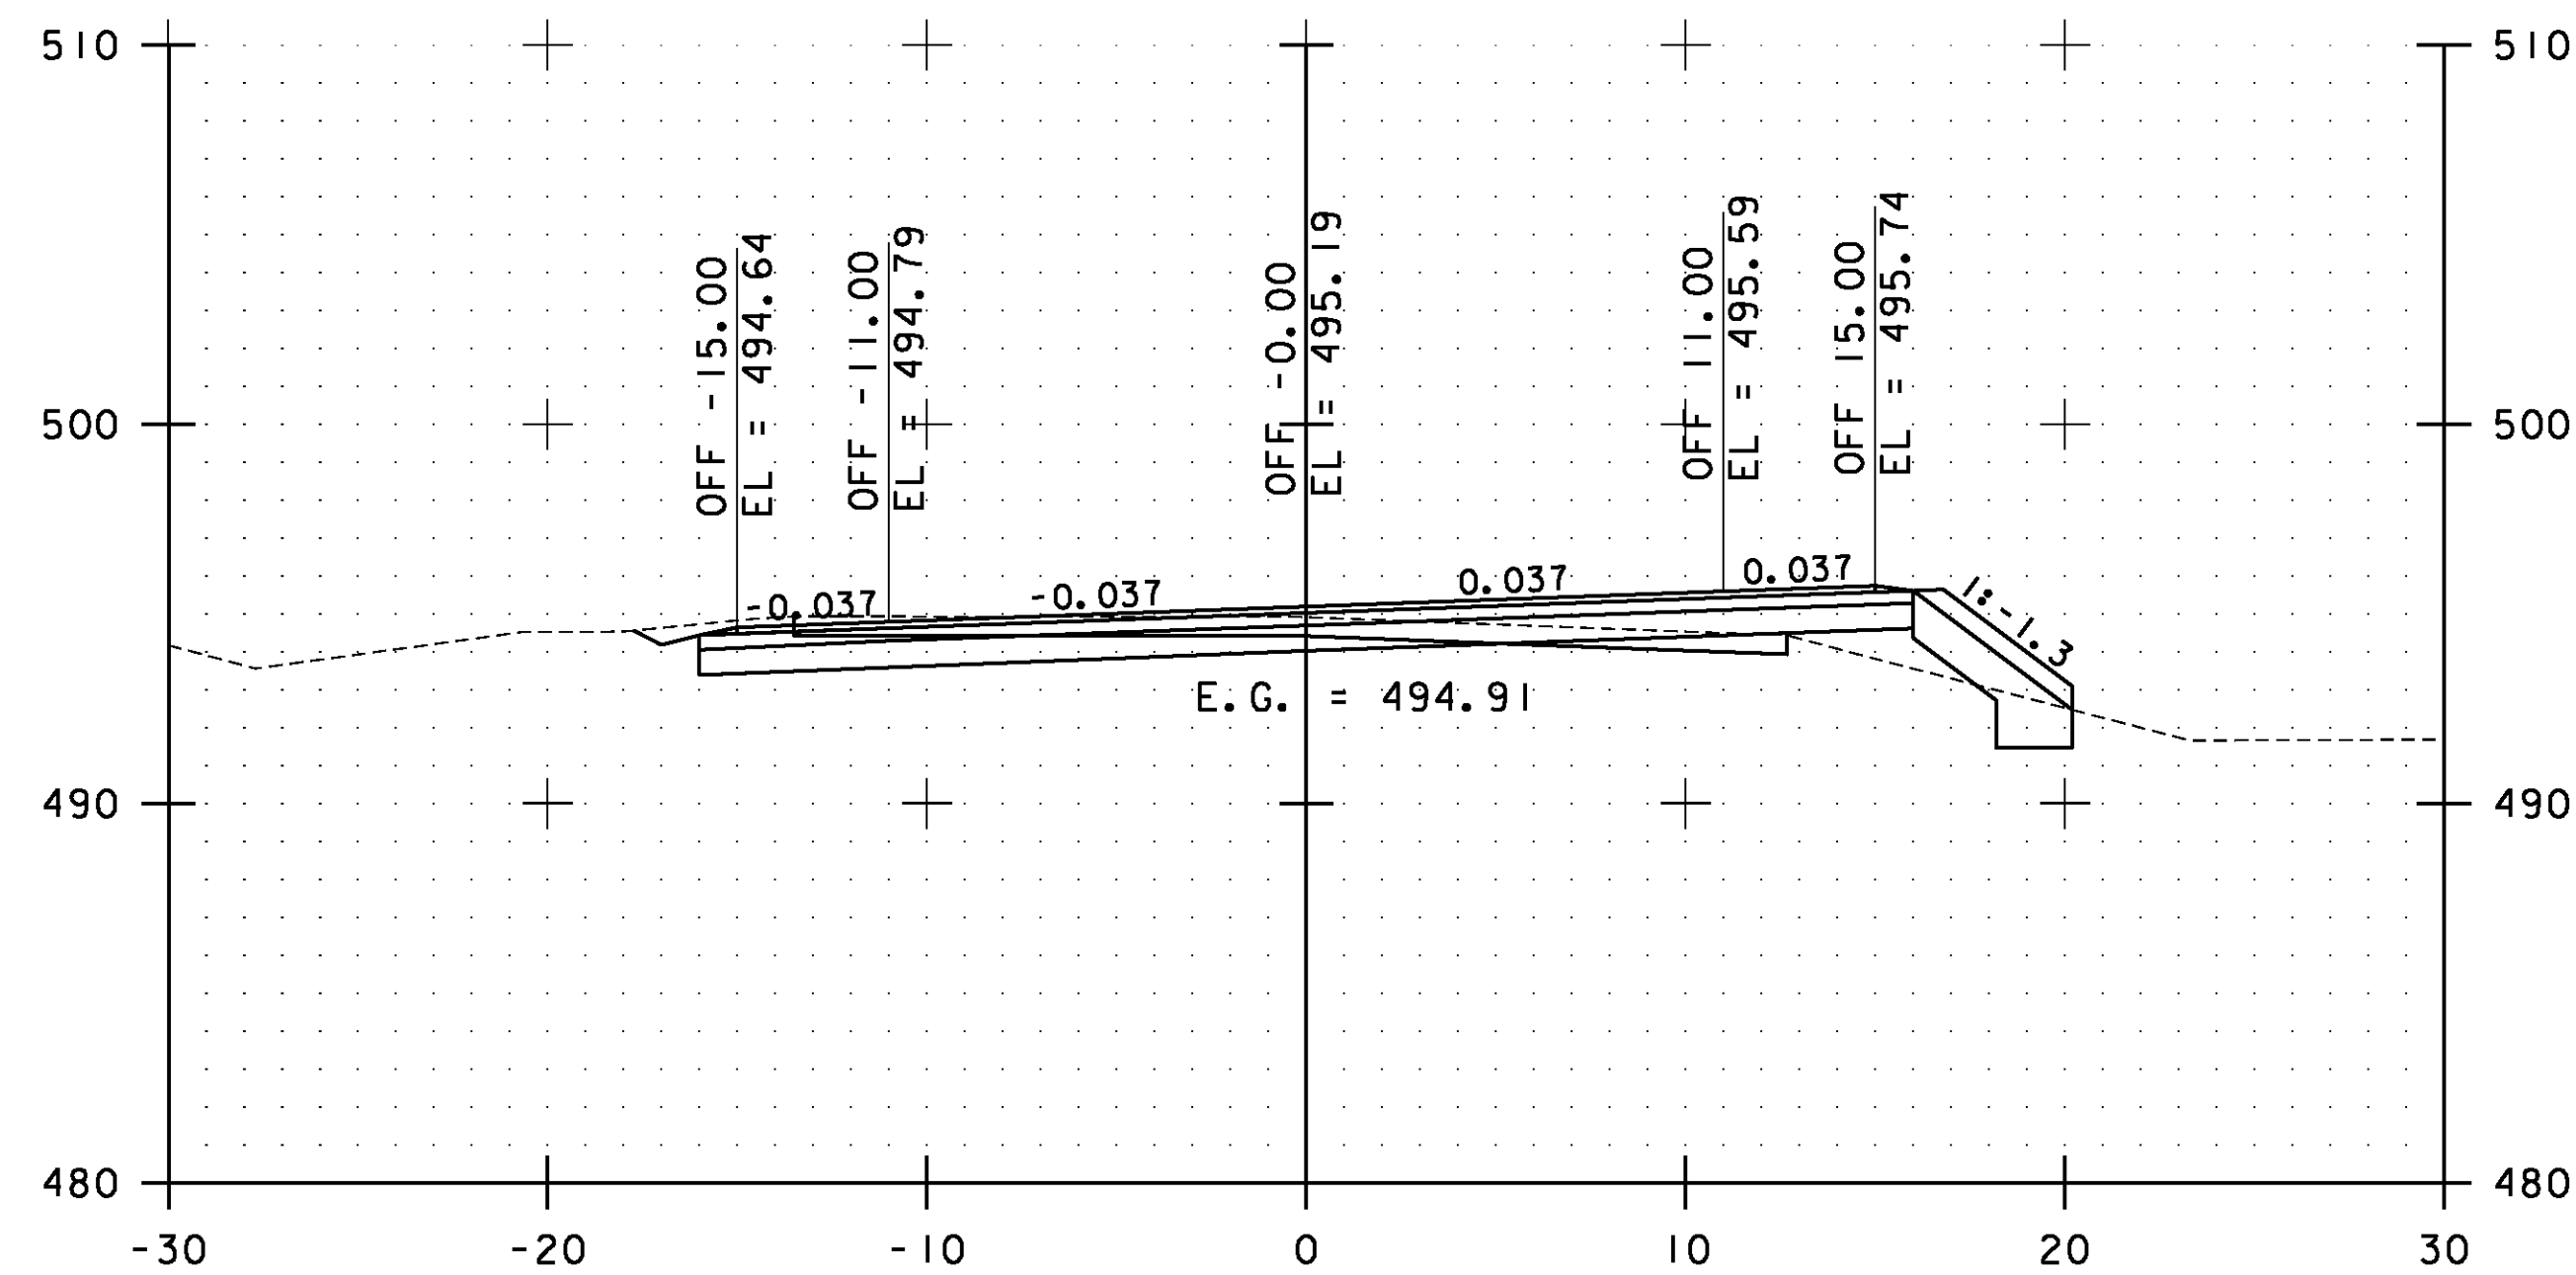


104+50.00

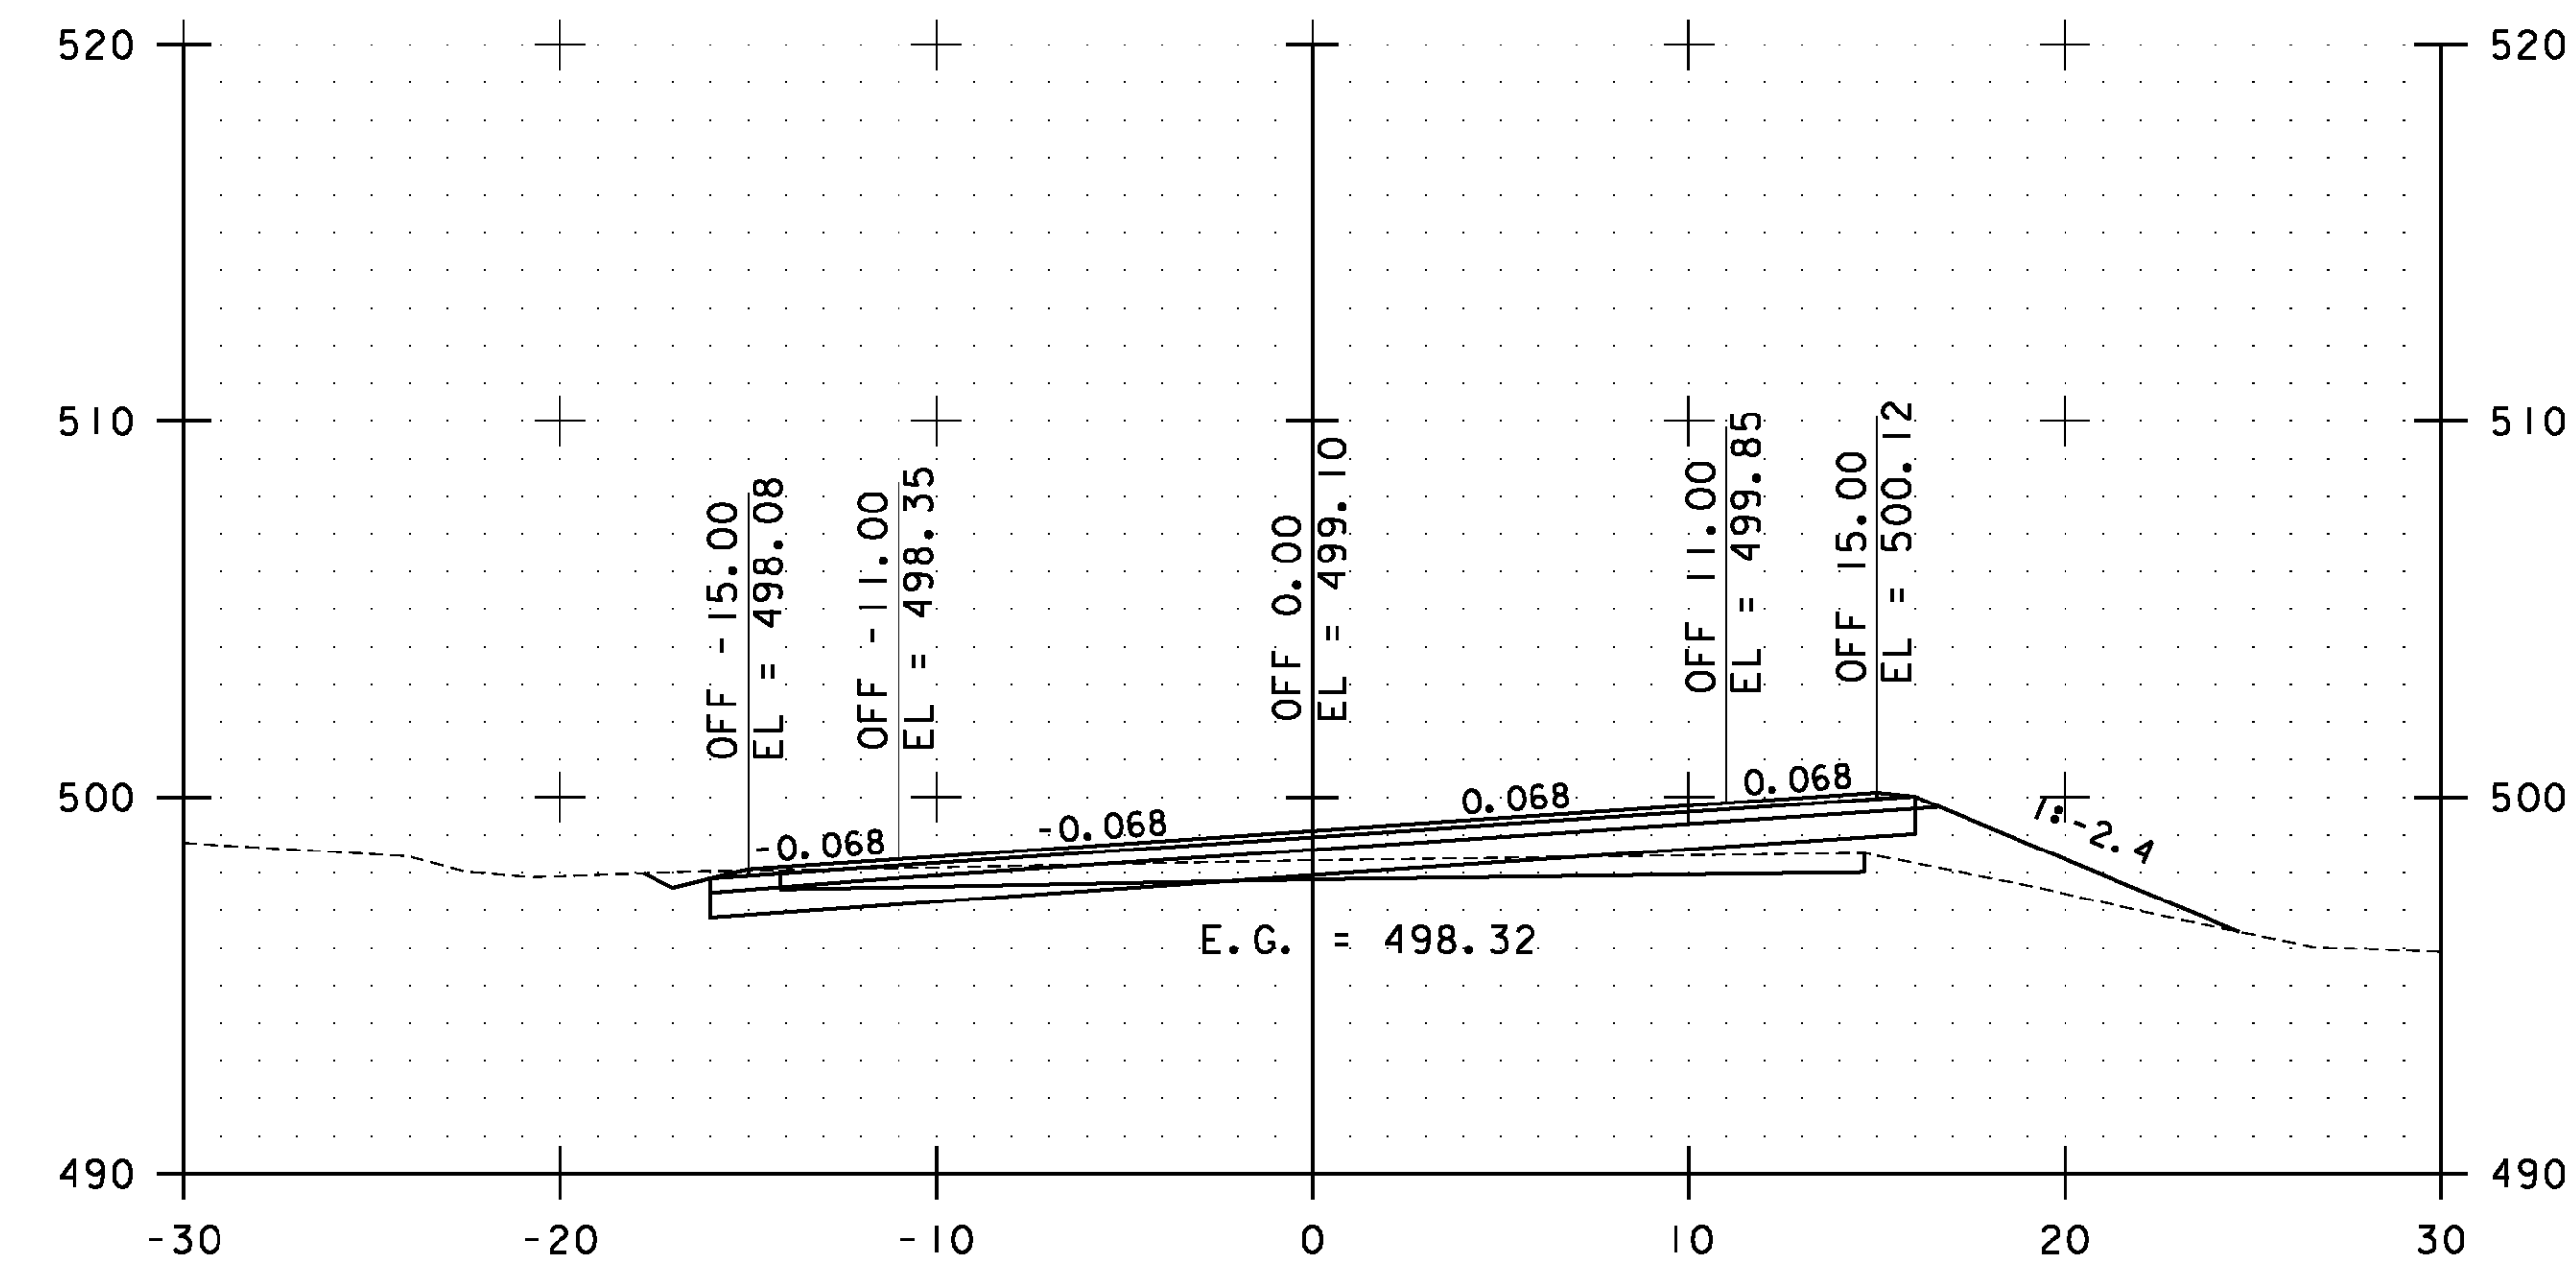

105+50.00

STA. 104+50.00 TO STA. 106+00.00

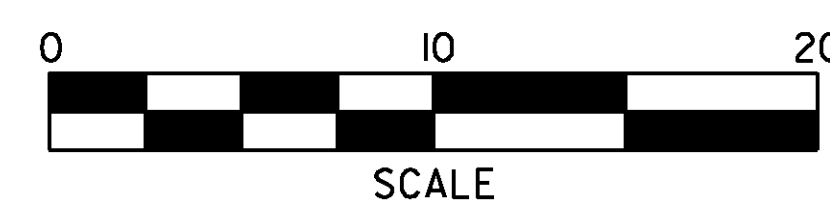

**ESSEX  
CROSS  
SECTIONS  
SHEET #47**

PROJECT NAME: ESSEX-WESTFORD	PLOT DATE: 2/20/2013
PROJECT NUMBER: STP 2912(I)	DRAWN BY: STANTEC
FILE NAME: p10c226.dgn	CHECKED BY: STANTEC
PROJECT LEADER: JLL	SHEET 138 OF 239
DESIGNED BY: STANTEC	
IPARM FILE: p10c226xs047.i	