




113+00.00

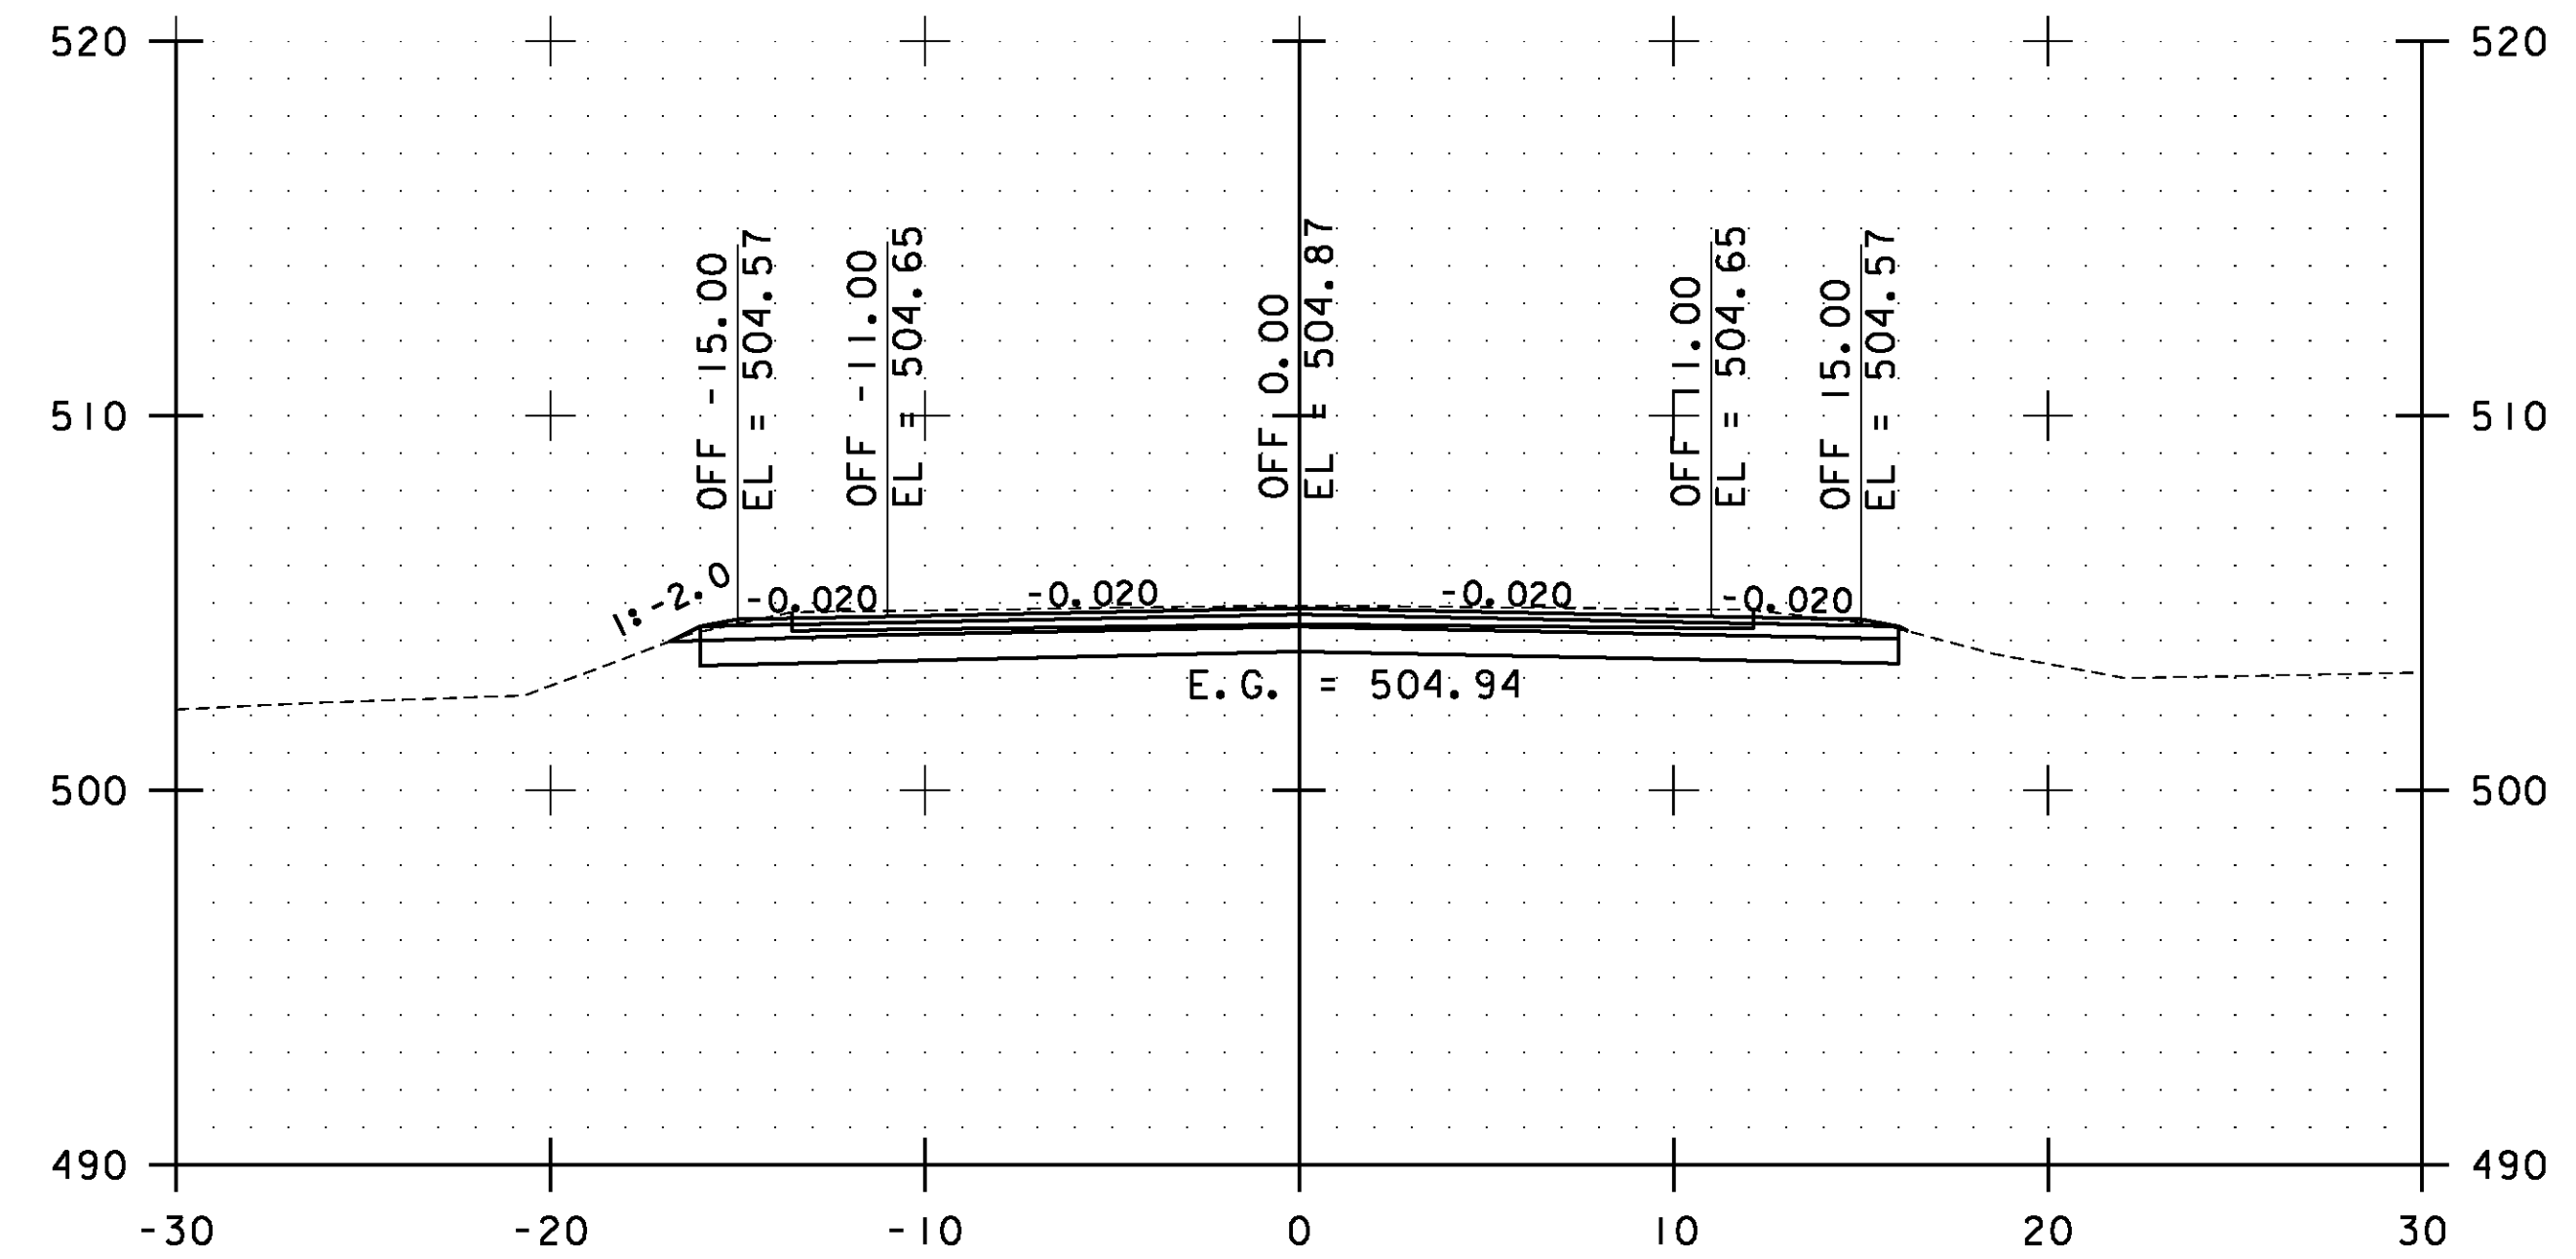

114+00.00

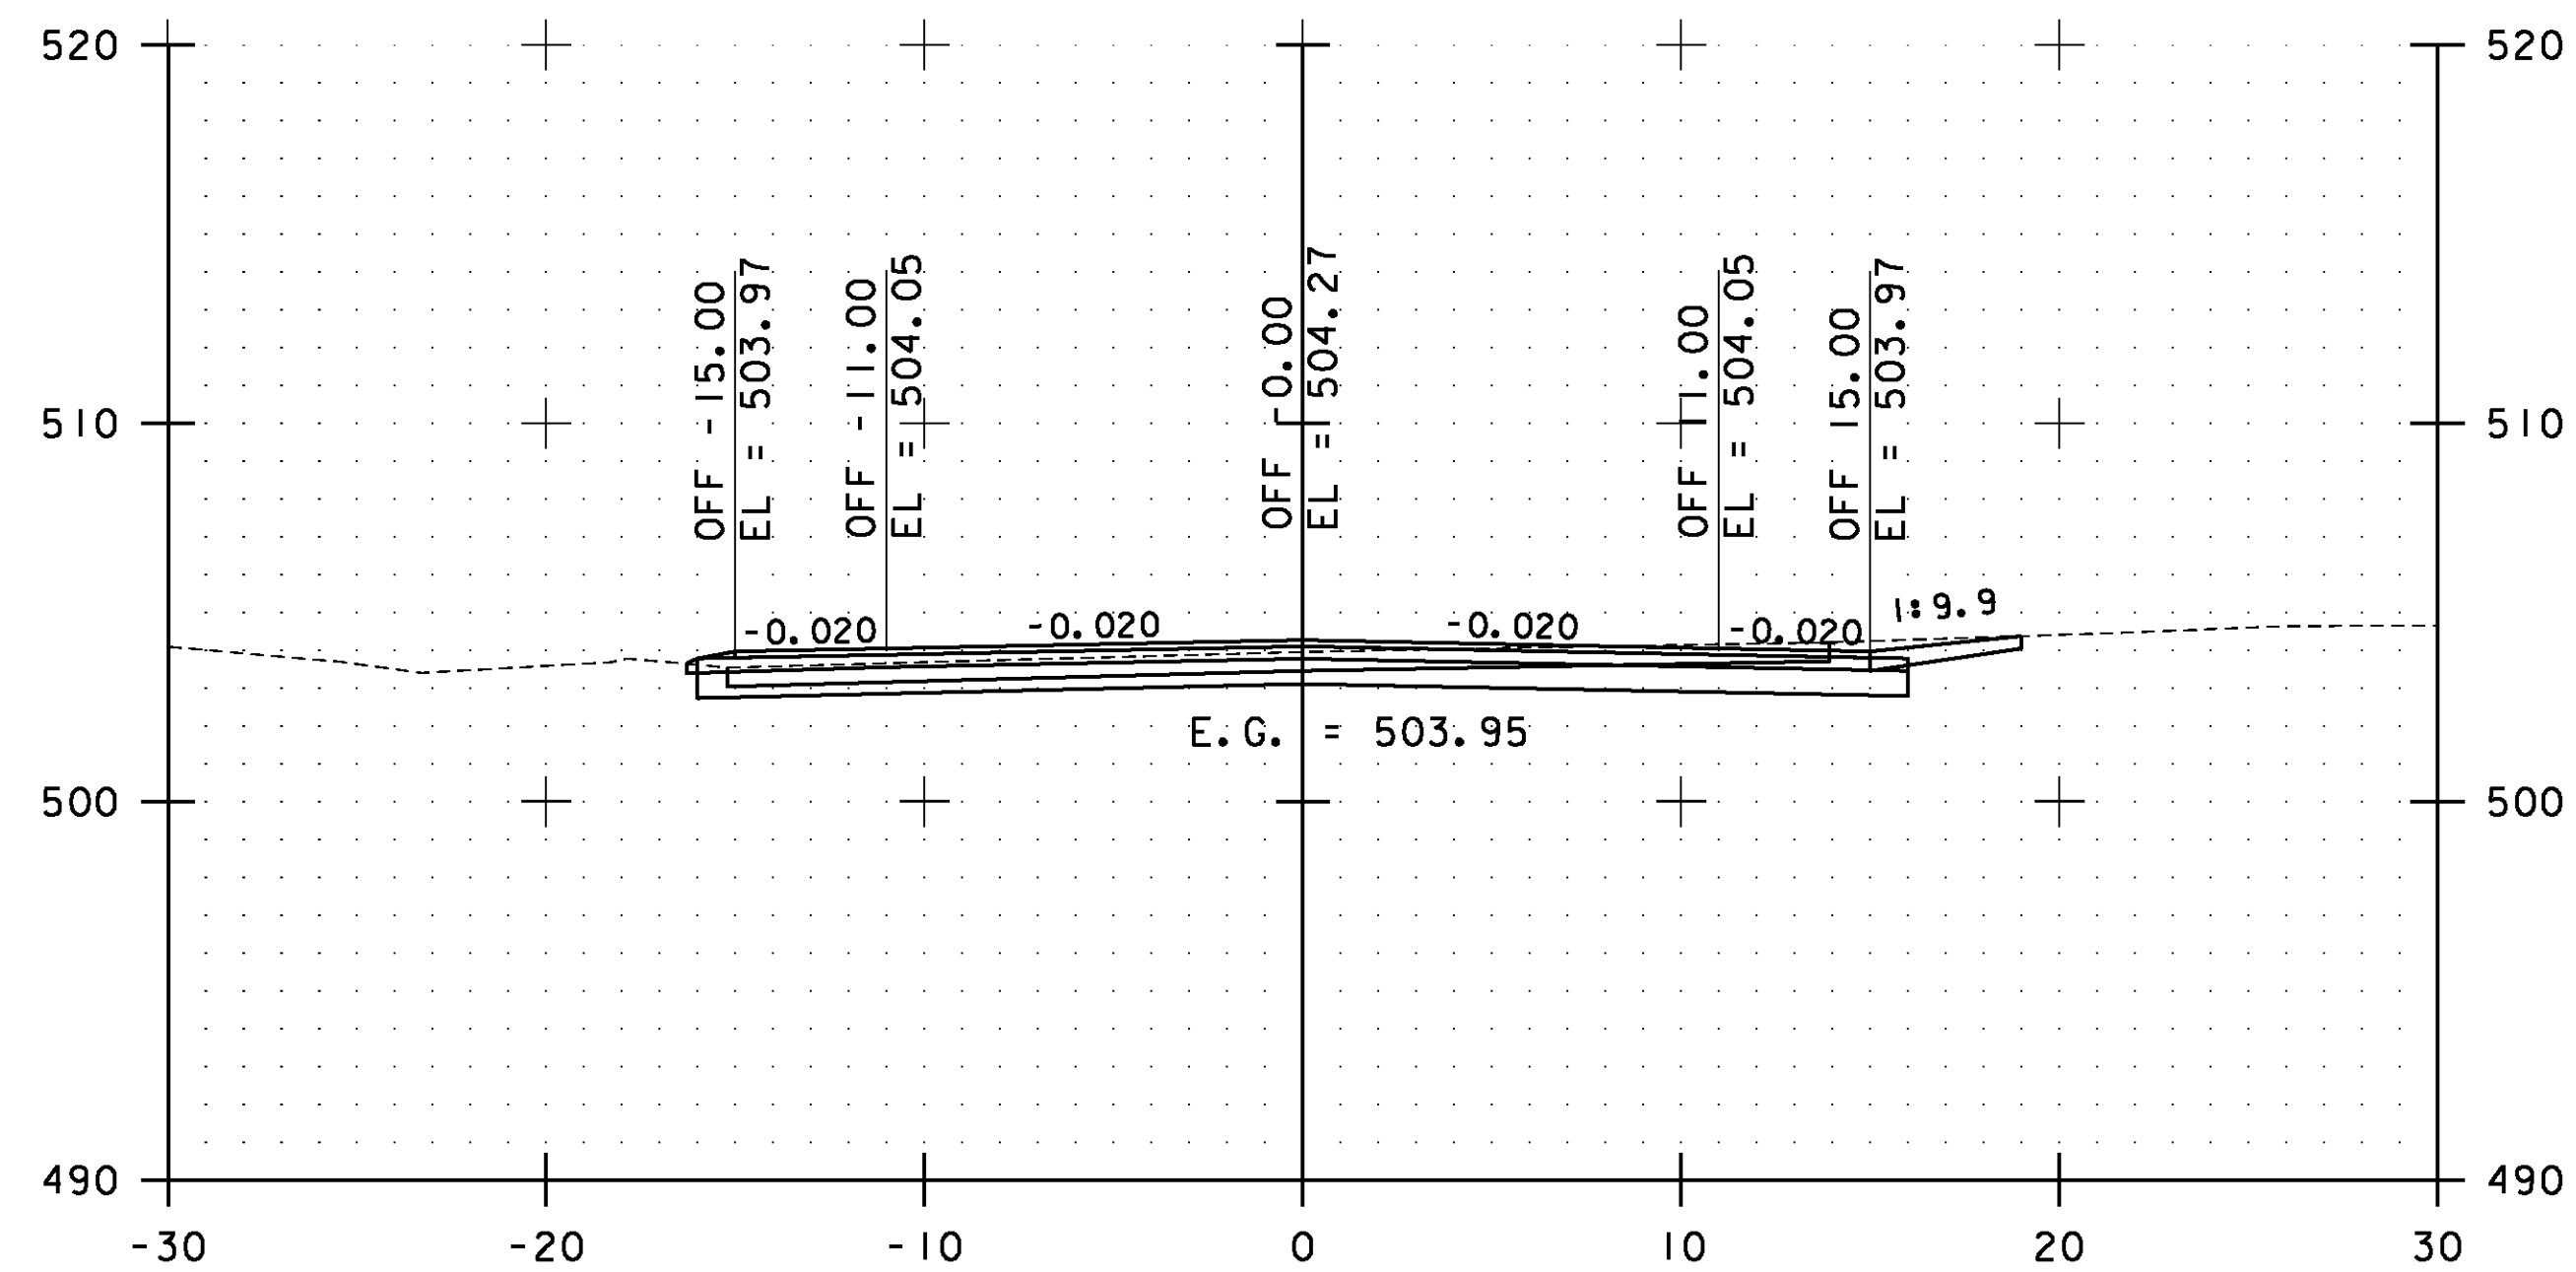


112+50.00

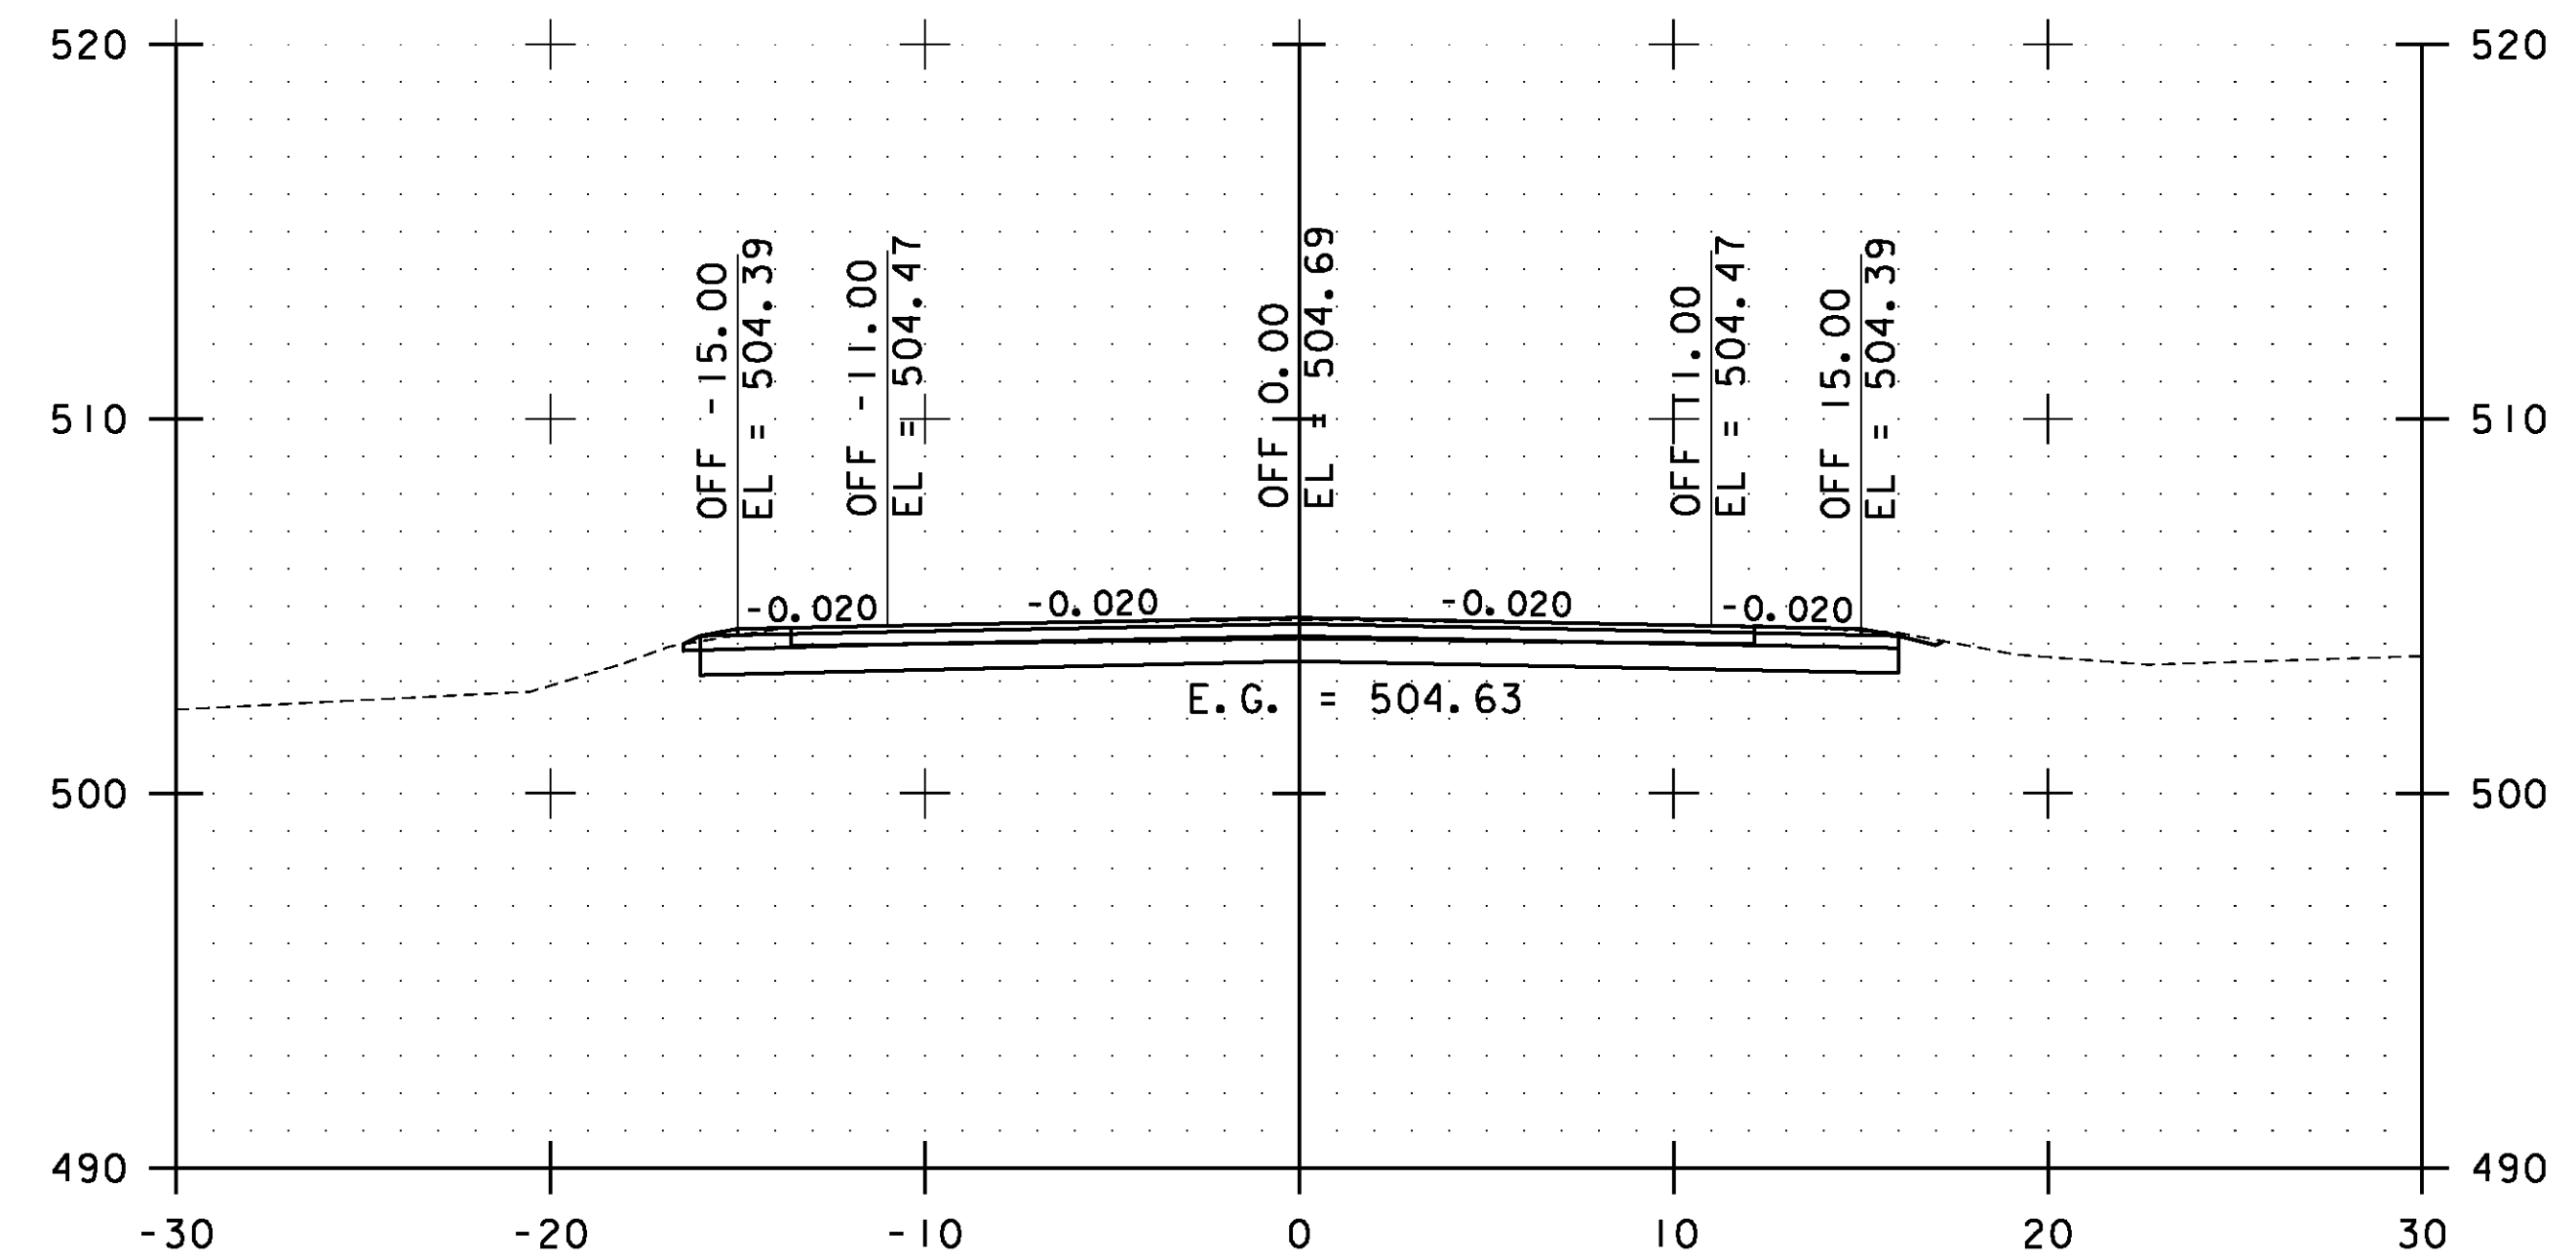

113+50.00

STA. 112+50.00 TO STA. 114+00.00

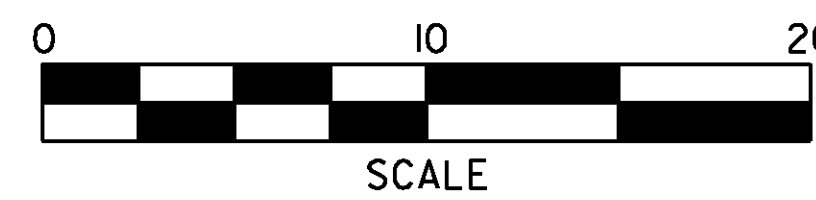

**ESSEX
CROSS
SECTIONS
SHEET #51**

PROJECT NAME: ESSEX-WESTFORD
PROJECT NUMBER: STP 2912(I)

FILE NAME: p10c226.dgn
PROJECT LEADER: JLL
DESIGNED BY: STANTEC
IPARM FILE: p10c226xs051.i

PLOT DATE: 2/20/2013
DRAWN BY: STANTEC
CHECKED BY: STANTEC
SHEET 142 OF 239